
DRAWING NO. 123A90-DDL-EL-DG-20159

REV. 03

GRAPHICAL SYMBOLS	DESCRIPTION	GRAPHICAL SYMBOLS	DESCRIPTION	GRAPHICAL SYMBOLS	DESCRIPTION	GRAPHICAL SYMBOLS	DESCRIPTION
	CIRCUIT BREAKER WITH AUTOMATIC RELEASE		CAPACITOR (GENERAL SYMBOL)		BISTABLE RELAY		CHANGE-OVER BREAK BEFORE MAKE CONTACT
	CIRCUIT BREAKER WITH AUTOMATIC RELEASE AND BUILT-IN THERMOMAGNETIC RELEASE		CAPACITIVE VOLTAGE DIVIDER		COIL OF A MECHANICALLY LATCHED RELAY		DELAYED ACTION (IN THE DIRECTION OF MOVEMENT FROM THE ARC TOWARDS ITS CENTRE)
			CURRENT TRANSFORMER		INDICATOR, ELECTROMECHANICAL ELEMENT		POSITION SWITCH (LIMIT SWITCH), MAKE CONTACT
	SWITCH DISCONNECTOR		RING CURRENT TRANSFORMER		LAMP (GENERAL SYMBOL)		POSITION SWITCH (LIMIT SWITCH), MAKE CONTACT
	CONTACTOR		INDICATING INSTRUMENT GENERAL SYMBOL		SEMICONDUCTOR DIODE		POSITION SWITCH (LIMIT SWITCH), BREAK CONTACT
	LOCK WITH FREE KEY WHEN THE DEVICE IS IN OPEN POSITION		INTEGRATING INSTRUMENT (GENERAL SYMBOL)		LED		OPERATED BY TURNING
	LOCK WITH FREE KEY WHEN THE DEVICE IS IN CLOSE POSITION		DISCONNECTING FUSE, NOT WITH LIVE CIRCUIT AND WITH MECHANICAL LINKAGE (STRIKER FUSE))		TRANSDUCER OF ALTERNATING CURRENT MEASURE INTO DIRECT CURRENT SIGNAL		THREE HELD POSITIONS TURNING SWITCH
	PLUG AND SOCKET (MALE AND FEMALE)		OPERATING DEVICE (GENERAL SYMBOL)		EARTH, GROUND (GENERAL SYMBOL)		THREE POSITIONS TURNING SWITCH, WITH SPRING THROWBACK TO THE CENTRAL POSITION
	VOLTAGE TRANSFORMER WITH TWO WINDINGS		COIL OF A TIME DELAYED OPERATING RELAY		MAKE CONTACT		MECHANICAL INTERLOCK BETWEEN TWO DEVICES
	VOLTAGE TRANSFORMER WITH THREE WINDINGS		COIL OF A TIME DELAYED RELEASING RELAY		BREAK CONTACT		
	RESISTOR (GENERAL SYMBOL)		AMPEROMETRIC TEST SOCKET				
	THERMISTOR (GENERAL SYMBOL)		3 PHASES LINE				
	HEATING ELEMENT		3 PHASES + NEUTRAL				
	INTERCONNECTION TERMINAL		CIRCUIT BREAKER SWITCH-DISCONNECTOR				
	WITHDRAWABLE TERMINAL SHORT-CIRCUITABLE ON C.T. SECONDARY CIRCUITS						
	WITHDRAWABLE TERMINAL FOR V.T. SECONDARY CIRCUITS						
	SWITCHBOARD TERMINAL						
	ON - OFF SWITCH						
	SURGE ARRESTER						
	VOLTMETRIC TEST SOCKET						

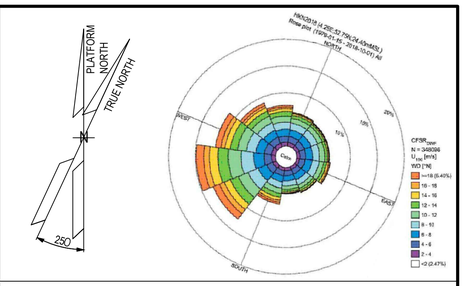

NOTES

REFERENCES

1) 123A90-DDL-EL-DG-20158: Overall/ Key Single Line Diagram
2) 123A90-DDL-EL-LIS-20016: Electrical Load List & Balance (CCS MODE 'CHARGING')
3) 123A90-DDL-EL-LIS-20167: Electrical Schedule - LV Switchgear
4) 123A90-DDL-EL-DG-20014 - Control, Protection and Metering Diagrams
5) 1723002197-EL-DG-00011: "SG-200N1" LV SWBD 400/230V Electrical Single Line Diagram
6) 1723002197-EL-DG-00012: "SG-200D2" LV SWBD 800V Electrical Single Line Diagram

LEGEND

HOLDS

REV.	DATE	DRN	CHKD	APPD	DESCRIPTION
3	15.09.25	SPS	LMA/AMA	CGI	AS-BUILT (ASB)
2	03.09.24	GPA	LM/AMA	MDO	ACCEPTED FOR CONSTRUCTION (AFC)
1	15.04.24	GPA	LM/AMA	MDO	ACCEPTED FOR CONSTRUCTION (AFC)
0	24.01.24	JAH	CB/AMA	OYFO/MDO	ISSUED FOR REVIEW (IFR)

CROSSWIND

ROSETTI MARINO


TITLE :
Electrical Single Line Diagram LV Systems


CONTRACT NO./TITLE CW-I-WP4-2023-05/HOLLANDSE KUST NOORD WIND PARK			SCALE 11:20
DRAWN SPS	CHECKED LM/AMA	APPROVED CGI	DATE 15.09.25
A1	DRAWING NO. 123A90-DDL-EL-DG-20159	SHEET 1	REV. 03

File Name : 123A90-DDL-EL-DG-20159 REV.03

DRAWING NO. 123A90-DDL-EL-DG-20159

REV. 03

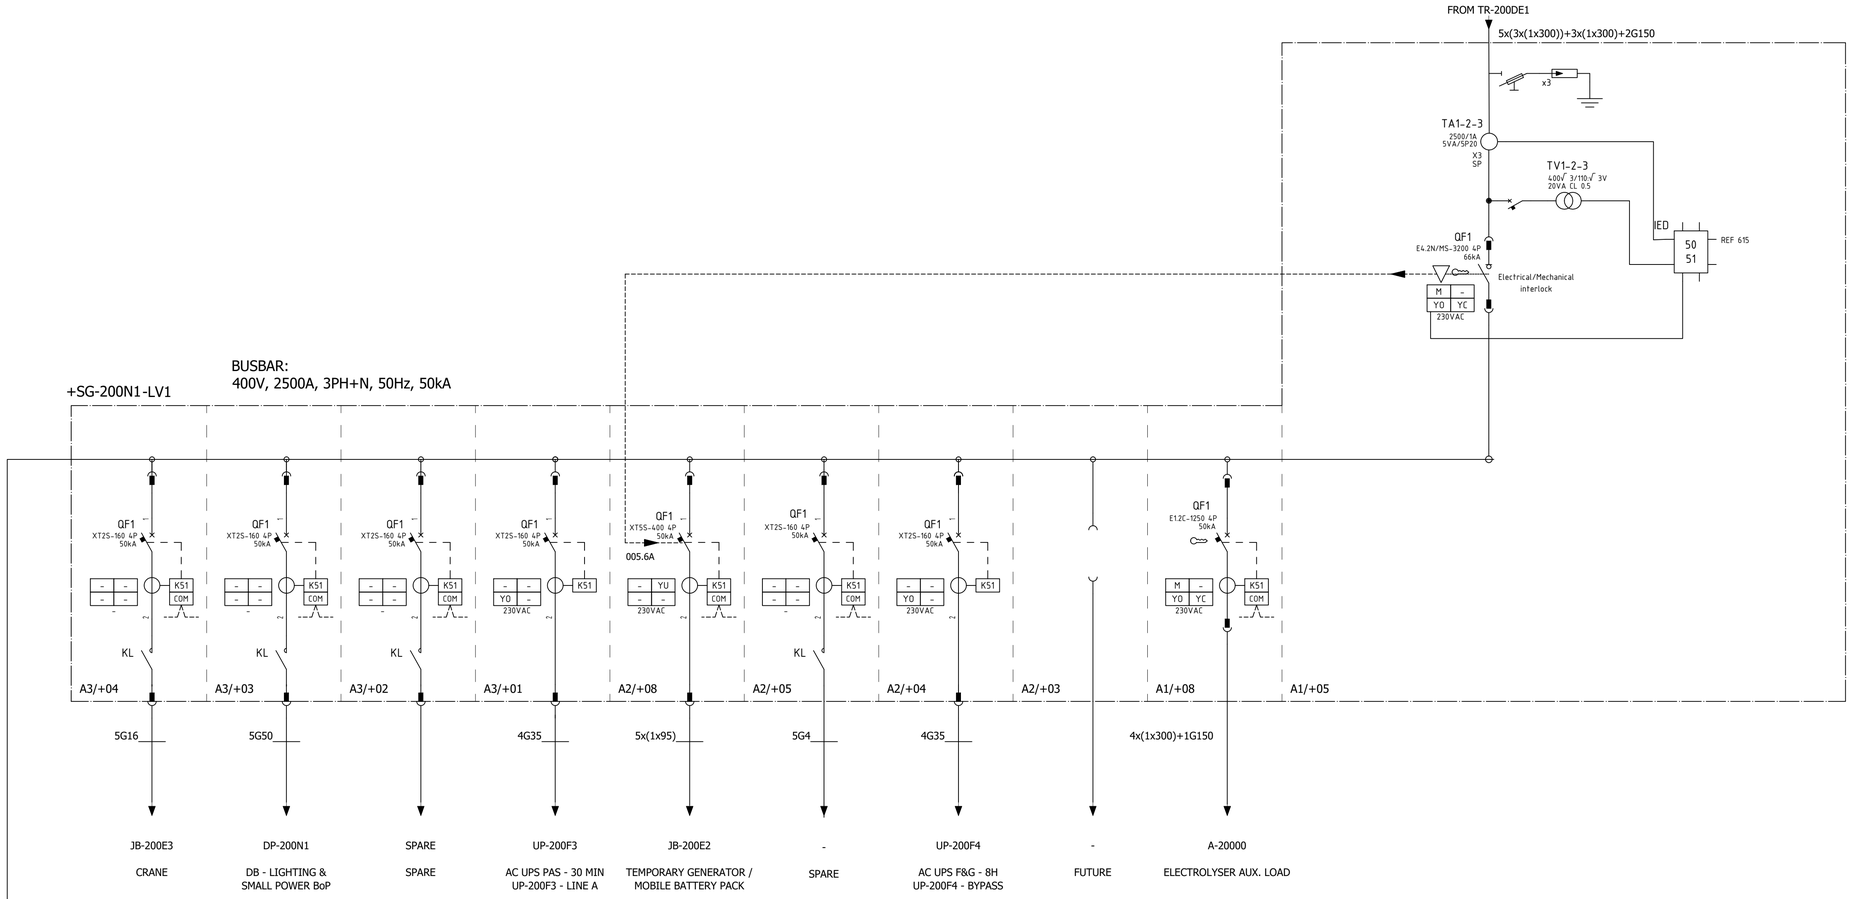

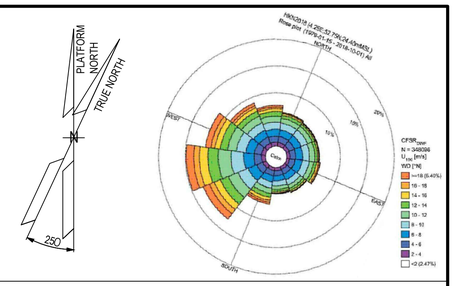

NOTES

REFERENCES

1) 123A90-DDL-EL-DG-20158: Overall/ Key Single Line Diagram
2) 123A90-DDL-EL-LIS-20016: Electrical Load List & Balance (CCS MODE 'CHARGING')
3) 123A90-DDL-EL-LIS-20167: Electrical Schedule - LV Switchgear
4) 123A90-DDL-EL-DG-20014 - Control, Protection and Metering Diagrams
5) 1723002197-EL-DG-00011: "SG-200N1" LV SWBD 400/230V Electrical Single Line Diagram
6) 1723002197-EL-DG-00012: "SG-200D2" LV SWBD 800V Electrical Single Line Diagram

LEGEND

HOLDS

REV.	DATE	DRN	CHKD	APPD	DESCRIPTION
3	15.09.25	SPS	LMA/AMA	CGI	AS-BUILT (ASB)
2	03.09.24	GPA	LM/AMA	MDO	ACCEPTED FOR CONSTRUCTION (AFC)
1	15.04.24	GPA	LM/AMA	MDO	ACCEPTED FOR CONSTRUCTION (AFC)
0	24.01.24	JAH	CB/AMA	OYFO/MDO	ISSUED FOR REVIEW (IFR)

CROSSWIND

ROSETTI MARINO

TITLE :

Electrical Single Line Diagram LV Systems


CONTRACT NO./TITLE CW-I-WP4-2023-05/HOLLANDSE KUST NOORD WIND PARK			SCALE 11:20
DRAWN SPS	CHECKED LM/AMA	APPROVED CGI	DATE 15.09.25
A1	DRAWING NO. 123A90-DDL-EL-DG-20159	SHEET 2	REV. 03

File Name : 123A90-DDL-EL-DG-20159 REV.03

DRAWING NO. 123A90-DDL-EL-DG-20159 | REV. 03

BUSBAR:
400V, 2500A, 3PH+N, 50Hz, 50kA

+SG-200N1 -LV1

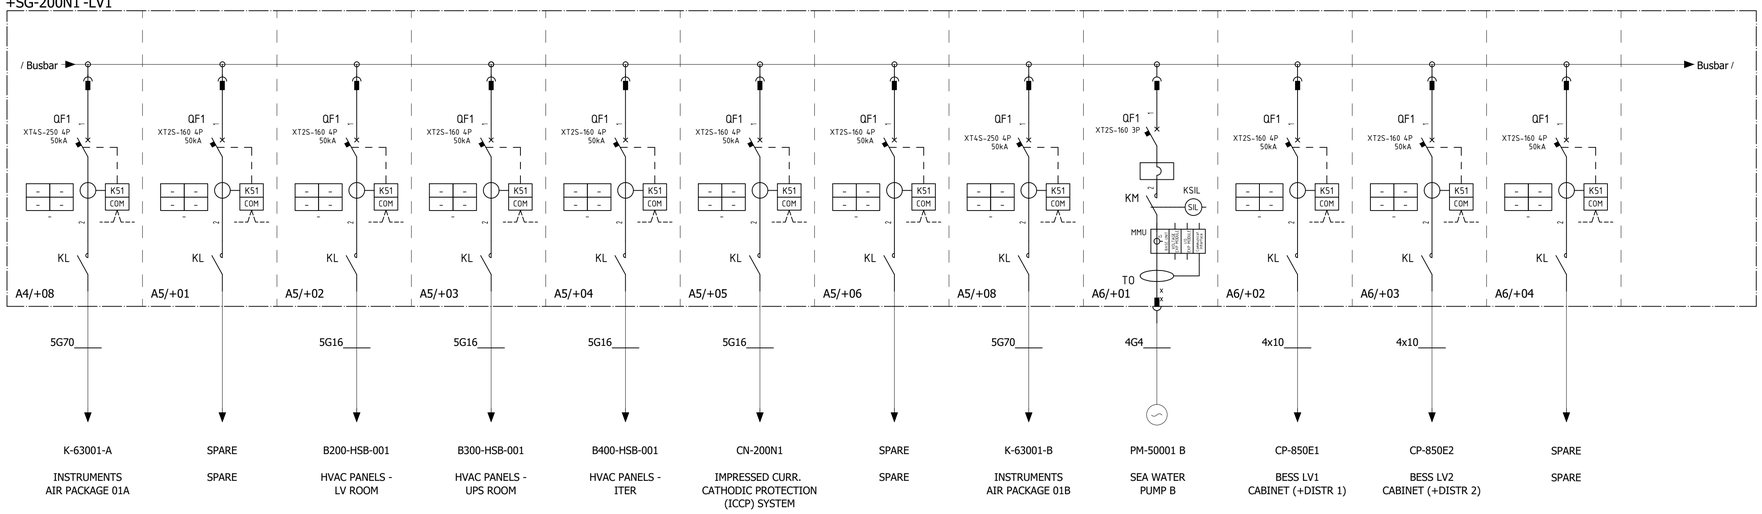

K-63001-A	SPARE	B200-HSB-001	B300-HSB-001	B400-HSB-001	CN-200N1	SPARE	K-63001-B	PM-50001 B	CP-850E1	CP-850E2	SPARE
INSTRUMENTS AIR PACKAGE 01A	SPARE	HVAC PANELS - LV ROOM	HVAC PANELS - UPS ROOM	HVAC PANELS - ITER	IMPRESSED CURR. CATHODIC PROTECTION (ICCP) SYSTEM	SPARE	INSTRUMENTS AIR PACKAGE 01B	SEA WATER PUMP B	BESS LV1 CABINET (+DISTR 1)	BESS LV2 CABINET (+DISTR 2)	SPARE

+SG-200N1 -LV1

UP-200F4	UP-200F4	ESW-200N1	PM-50001 A	UP-200F3	UP-200F1	UP-200F1	UP-200F2	UP-200F2	ESW-200N2
AC UPS F&G - 8 H UP-200F4 - LINE A	AC UPS F&G - 8 H UP-200F4 - LINE B	WELDING SOCKETS (TOP DECK)	SEA WATER PUMP A	AC UPS PAS - 30 min. UP-200F3 - BYPASS	DC BATTERY SYSTEM SWTG CONTROL FEEDER - A	DC BATTERY SYSTEM SWTG CONTROL FEEDER - B	NAVAID SYSTEM FEEDER A	NAVAID SYSTEM FEEDER B	WELDING SOCKETS (LOWER DECK)


FROM TR-200ED1

BUSBAR:
800V, 630A, 3PH+N, 50Hz, 30kA

+SG-200D2



INCOMING FROM SOLAR FARM	EARTHING SWITCH

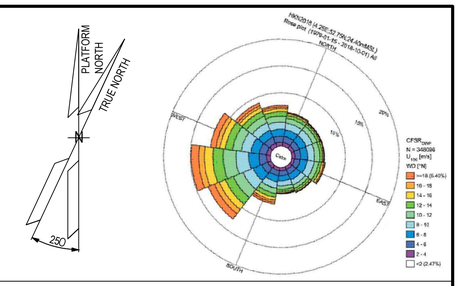

NOTES

REFERENCES

1) 123A90-DDL-EL-DG-20158: Overall/ Key Single Line Diagram
2) 123A90-DDL-EL-LIS-20016: Electrical Load List & Balance (CCS MODE 'CHARGING')
3) 123A90-DDL-EL-LIS-20167: Electrical Schedule - LV Switchgear
4) 123A90-DDL-EL-DG-20014 - Control, Protection and Metering Diagrams
5) 1723002197-EL-DG-00011: "SG-200N1" LV SWBD 400/230V Electrical Single Line Diagram
6) 1723002197-EL-DG-00012: "SG-200D2" LV SWBD 800V Electrical Single Line Diagram

LEGEND

HOLDS

REV.	DATE	DRN	CHKD	APPD	DESCRIPTION
3	15.09.25	SPS	LMA/AMA	CGI	AS-BUILT (ASB)
2	03.09.24	GPA	LMA/AMA	MDO	ACCEPTED FOR CONSTRUCTION (AFC)
1	15.04.24	GPA	LMA/AMA	MDO	ACCEPTED FOR CONSTRUCTION (AFC)
0	24.01.24	JAH	CB/AMA	OYFO/MOD	ISSUE FOR REVIEW (IFR)

CROSSWIND | ROSETTI MARINO

TITLE : Electrical Single Line Diagram LV Systems

CONTRACT NO./TITLE CW-I-WP4-2023-05/HOLLANDSE KUST NOORD WIND PARK			SCALE 11:20
DRAWN SPS	CHECKED LMA/AMA	APPROVED CGI	DATE 15.09.25
A1	DRAWING NO. 123A90-DDL-EL-DG-20159	SHEET 3	REV. 03

File Name : 123A90-DDL-EL-DG-20159 REV.03