

DRAWING NO. 123A90-DDL-IN-DL-40012 REV. 04

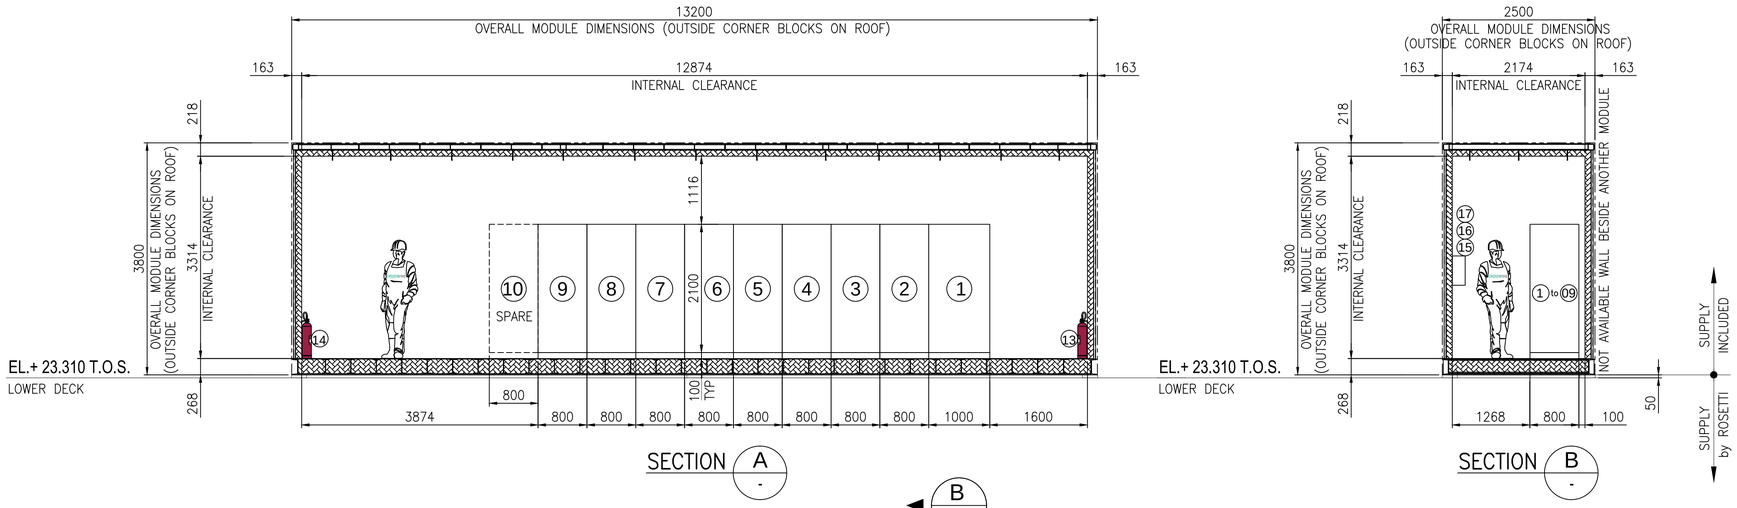

SECTION A -


SECTION B -

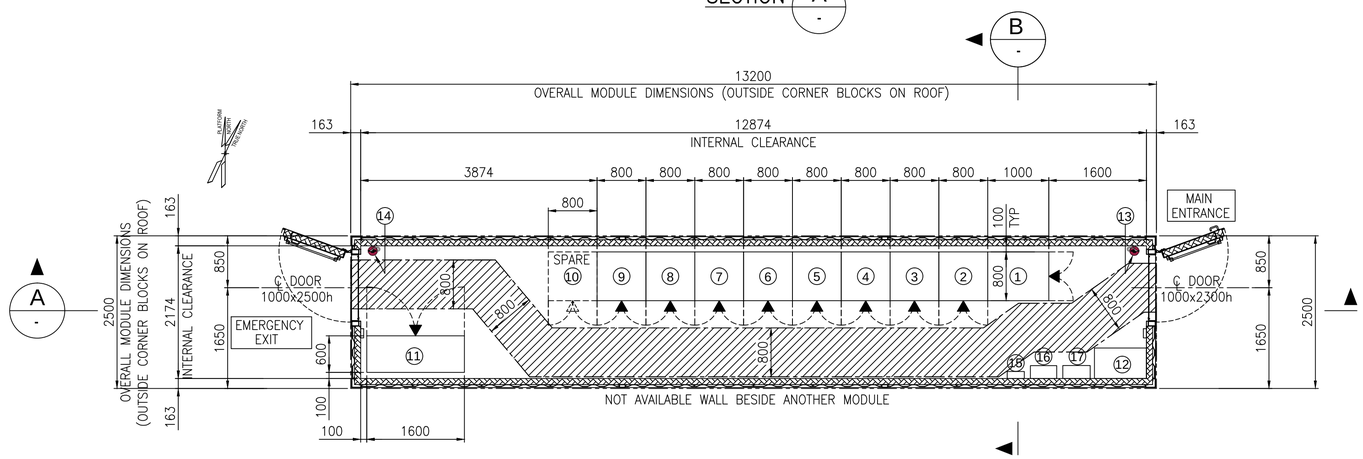

EQUIPMENT LIST

REF.	TAG No.	DESCRIPTION	LENGTH (mm)	WIDTH (mm)	HEIGHT (mm)	NOTE
1	B400-SRV-001	SERVER CABINET	1000	800	2100	
2	B400-NET-001	NETWORK CABINET	800	800	2100	
3	B400-EMCS-001	EMCS SYSTEM CABINET	800	800	2100	
4	B400-PCS-002	PCS MARSHALLING CABINET	800	800	2100	
5	B400-PCS-001	PCS SYSTEM CABINET	800	800	2100	
6	B400-FGS-003	FGS MARSHALLING CABINET 2	800	800	2100	
7	B400-FGS-002	FGS MARSHALLING CABINET 1	800	800	2100	
8	B400-FGS-001	FGS SYSTEM CABINET	800	800	2100	
9	B400-SIS-001	SIS SYSTEM/MARSHALLING CABINET	800	800	2100	
10	-	SPARE				
11	B400-HSB-001	DISTRIBUTION & HVAC PANEL - I&T ROOM	1600	600	2300	
12	-	TABLE	850	500	750	
13	-	PORTABLE EXTINGUISHER (CO2) 5 Kg.	150	150	750	
14	-	PORTABLE EXTINGUISHER (CO2) 5 Kg.	150	150	750	
15	-	FIRST AID KIT	280	115	200	
16	-	RESUSCITATION UNIT	430	210	480	
17	-	CABINET INCLUDED N.10 ESCAPE MASK	448	213	422	

EQUIPMENT LAYOUT
"B-400" I&T EQUIPMENT ROOM
BOTTOM PLAN

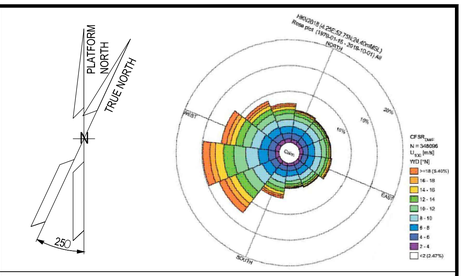

NOTES

1. U.N.O. ALL DIMENSIONS ARE IN MILLIMETERS.
2. DOCUMENT VALID ONLY FOR INSTRUMENT COMPONENT, FOR OTHER SCOPE LOCATION AND INFORMATION, PLEASE REFER TO VENDORS AND PROJECT DOCUMENTS.

LEGEND


U.N.O. _____ UNLESS NOTED OTHERWISE
T.O.S. _____ TOP OF STEEL
_____ ESCAPE CORRIDOR – WIDTH 800mm.
_____ EQUIPMENT ROOM ENCLOSURE
_____ FRONT OF EQUIPMENT

HOLDS

REFERENCE

DOCUMENT TITLE	DOCUMENT NUMBER
Control System Architecture Detailed Drawings	123A90-DDL-IN-DD-40096
Data Network Architecture Drawings	123A90-DDL-IN-DD-40019
Earthing layouts drawings (CCR, ITER)	123A90-DDL-IN-DL-40013
Instrument and Telecom MCT Layout – Lower Deck	123A90-DDL-IN-DL-40086
"B-400" I&T Equipment Room – Architectural Layout	123A90-DDL-AR-DL-10015
"B-400" ARCHITECTURAL GENERAL LAYOUT PLAN, WIEW, SECTIONS & TYP. DETAILS	123A90-DDL-AR-DL-10015
"B-400" GENERAL ARRANGEMENT DRAWING	1724000049-AR-DA-00017
"B-400" GENERAL ARRANGEMENT DRAWING	1724000049-AR-DD-00021
"B-400" HVAC SYSTEM G.A. and DETAILS	1724000049-HV-DA-00067

KEY PLAN

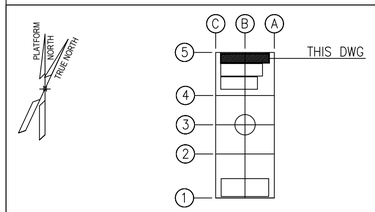

REV.	DATE	DRN	CHKD	APPD	DESCRIPTION
04	29/09/25	SPS	LCA	CGI	AS-BUILT (ASB)
03	04/10/24	VBA	LCA	DLO	ACCEPTED FOR CONSTRUCTION (AFC)
02	27/05/24	MGA	LCA	DLO	ACCEPTED FOR CONSTRUCTION (AFC)
01	22/01/24	VBA	LCA	DLO	ISSUE FOR REVIEW (IFR)
00	07/11/23	VBA	LCA	DLO	ISSUE FOR REVIEW (IFR)

CROSSWIND | ROSETTI MARINO

TITLE :
BASE LOAD POWER HUB (BLPH)
OFF-SHORE ITER
EQUIPMENT LAYOUT

CONTRACT NO./TITLE CW-I-WP4-2023-05/HOLLANDSE KUST NOORD WIND PARK | SCALE 1:33,3
DRAWN SPS | CHECKED LCA | APPROVED CGI | DATE 29/09/25
A1 | DRAWING NO. 123A90-DDL-IN-DL-40012 | SHEET 001 | REV. 04

File Name : 123A90-DDL-IN-DL-40012 Rev.04.dwg