

DRAWING NO. 123A90-DDL-IN-DL-40082 REV. 03

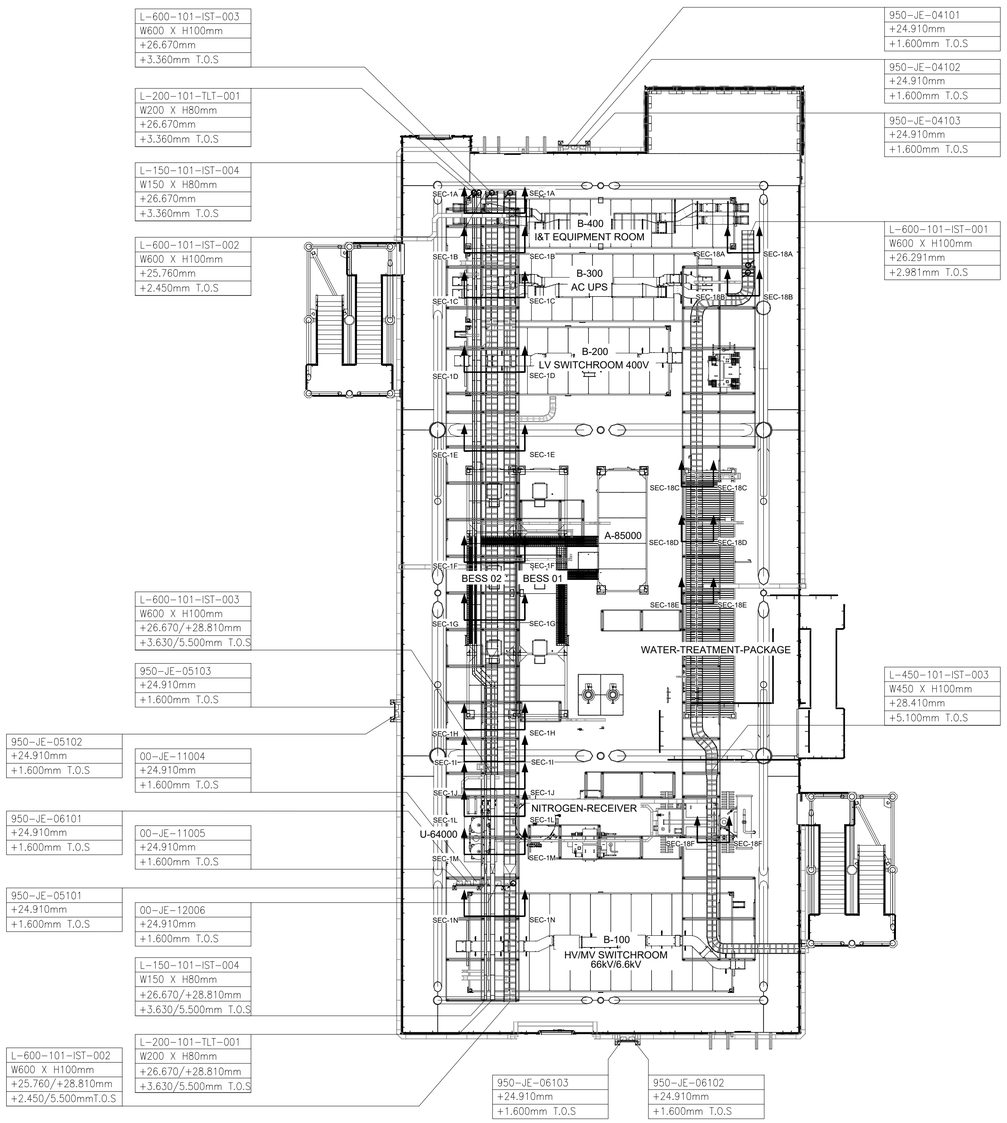

PRIMARY CABLETRAY
LOWER DECK
SCALE: 1:100

VIEW EL. 23310mm to 30310mm

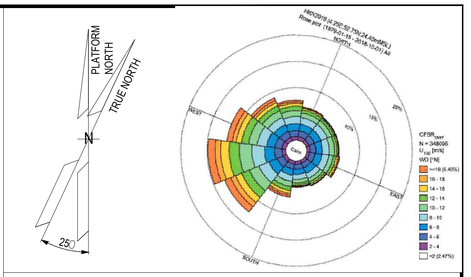

NOTES

1. ALL DIMENSIONS AND ELEVATIONS ARE GIVEN IN mm UNLESS OTHERWISE NOTED.
2. ELEVATIONS REFER TO T.O.S.
3. THIS DRAWING IS VALID ONLY FOR INSTRUMENT CABLE ROUTING LAYOUT.

LEGEND

- MAIN CABLE TRAY
- SECONDARY CABLE TRAY
- CABLE TRAY ELEVATION CHANGE
- INSTRUMENT CABLE TRAY VERTICAL RAISE
- INSTRUMENT CABLE TRAY VERTICAL DROP
- SEC-1A — CABLE TRAY SECTION
- TAG
- SIZE
- ELEVATION
- ELEVATION(T.O.S)

HOLDS

REFERENCE DOCUMENTS

123A90-DDL-PP-DL-70070	PLOT PLAN - LOWER & UPPER DECK
123A90-DDL-IN-DL-40080	INSTRUMENT LAYOUT - LOWER DECK
123A90-DDL-IN-DL-40081	INSTRUMENT LAYOUT - LOWER DECK
123A90-DDL-IN-LIS-40091	INSTRUMENT CABLE LIST
123A90-DDL-IN-DG-40015	INSTRUMENT-CCS WIRING DIAGRAMS
123A90-DDL-IN-DG-40016	INSTRUMENT-SAFETY SYSTEM WIRING DIAGRAMS
123A90-DDL-IN-DL-40082	INSTRUMENT MAIN CABLE ROUTING-UPPER DECK

INSERT SUBCONTRACTOR / VENDOR LOGO HERE

REV.	DATE	DRN	CHKD	APPD	DESCRIPTION
03	29/09/25	SPS	LCA	CGI	AS-BUILT (ASB)
02	04/10/24	VBA	LCA	DLO	ACCEPTED FOR CONSTRUCTION (AFC)
01	26/07/24	VBA	LCA	DLO	ACCEPTED FOR CONSTRUCTION (AFC)
00	22/12/23	VBA	LCA	DLO	ISSUE FOR REVIEW (IFR)


CROSSWIND — ROSETTI MARINO

TITLE :
BASE LOAD POWER HUB (BLPH)
INSTRUMENT MAIN CABLE ROUTING-LOWER DECK
TOS EL. 23.310M

CONTRACT NO./TITLE CW-I-WP4-2023-05/HOLLANDSE KUST NOORD WIND PARK			SCALE 1:150
DRAWN SPS	CHECKED LCA	APPROVED CGI	DATE 29/09/25
A1	DRAWING NO. 123A90-DDL-IN-DL-40082	SHEET 001	REV. 03

File Name : 123A90-DDL-IN-DL-40082 REV03.dwg

DRAWING NO. 123A90-DDL-IN-DL-40082 REV. 03

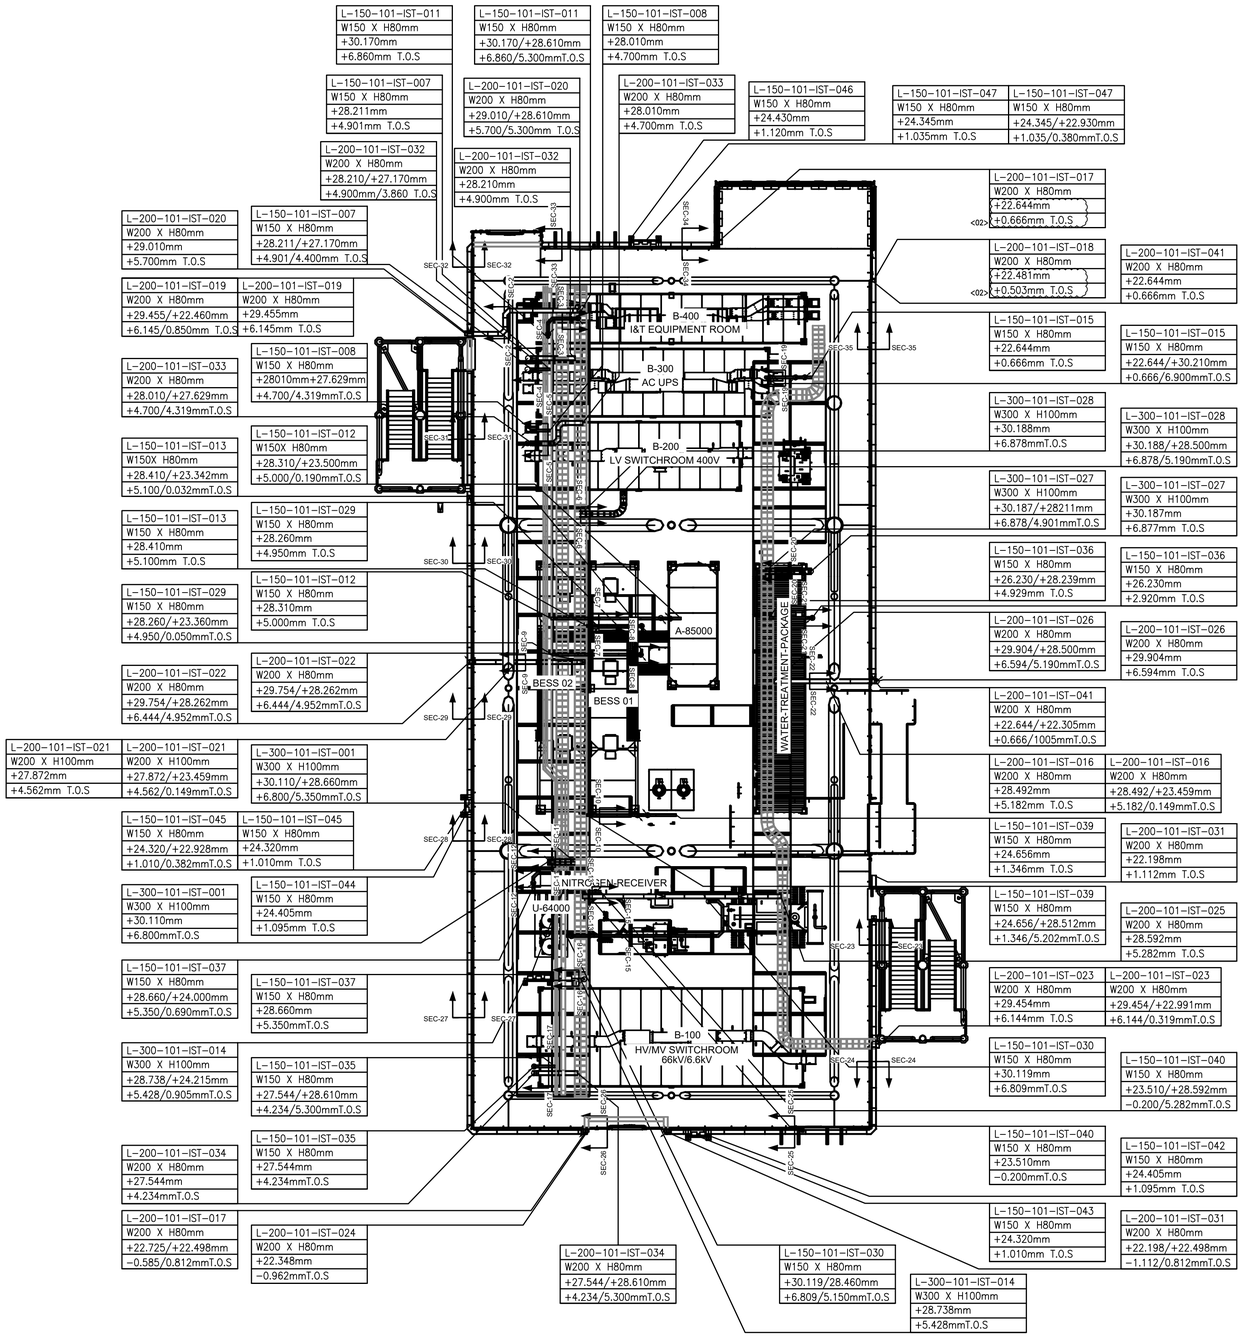


SECONDARY CABLETRAY

LOWER DECK

SCALE: 1:100

VIEW EL. 23310mm to 30310mm

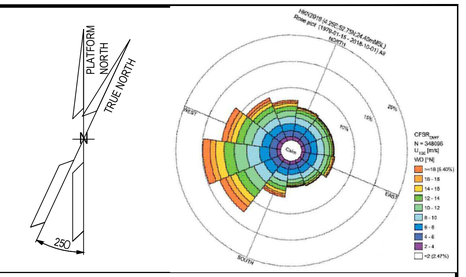

NOTES

1. ALL DIMENSIONS AND ELEVATIONS ARE GIVEN IN mm UNLESS OTHERWISE NOTED.
2. ELEVATIONS REFER TO T.O.S.
3. THIS DRAWING IS VALID ONLY FOR INSTRUMENT CABLE ROUTING LAYOUT.

LEGEND

- MAIN CABLE TRAY
- SECONDARY CABLE TRAY
- CABLE TRAY ELEVATION CHANGE
- INSTRUMENT CABLE TRAY VERTICAL RAISE
- INSTRUMENT CABLE TRAY VERTICAL DROP
- SEC-1A — CABLE TRAY SECTION

TAG
SIZE
ELEVATION
ELEVATION(T.O.S)

HOLDS

REFERENCE DOCUMENTS

123A90-DDL-PP-DL-70070	PLOT PLAN - LOWER & UPPER DECK
123A90-DDL-IN-DL-40080	INSTRUMENT LAYOUT - LOWER DECK
123A90-DDL-IN-DL-40081	INSTRUMENT LAYOUT - LOWER DECK
123A90-DDL-IN-LIS-40091	INSTRUMENT CABLE LIST
123A90-DDL-IN-DG-40015	INSTRUMENT-CCS WIRING DIAGRAMS
123A90-DDL-IN-DG-40016	INSTRUMENT-SAFETY SYSTEM WIRING DIAGRAMS
123A90-DDL-IN-DL-40082	INSTRUMENT MAIN CABLE ROUTING-UPPER DECK

INSERT SUBCONTRACTOR / VENDOR LOGO HERE

REV.	DATE	DRN	CHKD	APPD	DESCRIPTION
03	29/09/25	SPS	LCA	CGI	AS-BUILT (ASB)
02	04/10/24	VBA	LCA	DLO	ACCEPTED FOR CONSTRUCTION (AFC)
01	26/07/24	VBA	LCA	DLO	ACCEPTED FOR CONSTRUCTION (AFC)
00	22/12/23	VBA	LCA	DLO	ISSUE FOR REVIEW (IFR)

CROSSWIND

ROSETTI MARINO

TITLE :
BASE LOAD POWER HUB (BLPH)
INSTRUMENT MAIN CABLE ROUTING-LOWER DECK
TOS EL. 23.310M

CONTRACT NO./TITLE CW-I-WP4-2023-05/HOLLANDSE KUST NOORD WIND PARK			SCALE 1:150
DRAWN SPS	CHECKED LCA	APPROVED CGI	DATE 29/09/25

A1	DRAWING NO. 123A90-DDL-IN-DL-40082	SHEET 002	REV. 03

File Name : 123A90-DDL-IN-DL-40082 REV03.dwg

DRAWING NO. 123A90-DDL-IN-DL-40082

REV. 03

L-150-100-IST-005	L-150-100-IST-005
W150 X H80mm	W150 X H80mm
-23.242/22.910mm	-23.242mm
-0.068/0.400mmT.O.S	-0.068mm T.O.S

L-150-100-IST-006	L-150-100-IST-006
W150 X H80mm	W150 X H80mm
-21.780mm	-21.780/23.230mm
-1.530mm T.O.S	-1.530/0.080mmT.O.S

L-200-100-IST-003	L-200-100-IST-003
W200 X H80mm	W200 X H80mm
-23.110/22.754mm	-23.110mm
-0.200/0.556mmT.O.S	-0.200mm T.O.S

L-150-100-IST-007	L-150-100-IST-007
W150 X H80mm	W150 X H80mm
-17.244/21.600mm	-17.244mm
-6.066/1.710mmT.O.S	-6.066mm T.O.S

JB-200E1
-21.110mm
-2.200mm T.O.S

L-150-100-IST-009
W150 X H80mm
-16.790mm
-6.520mm T.O.S

L-150-100-IST-010	L-150-100-IST-010
W150 X H80mm	W150 X H80mm
-17.330mm	-17.330/20.268mm
-5.980mm T.O.S	-5.980/3.042mmT.O.S


L-150-100-IST-008
W150 X H80mm
-17.997mm
-5.313mm T.O.S

950-JE-07101
-18.507mm
-4.803mm T.O.S

L-200-100-IST-004
W200 X H100mm
-22.088mm
-1.222mm T.O.S

L-200-100-IST-002	L-200-100-IST-002
W200 X H100mm	W200 X H100mm
-23.272mm	-23.272/20.418mm
-0.038mm T.O.S	-0.038/2.892mmT.O.S

L-150-100-IST-001
W150 X H80mm
-20.268mm
-3.042mm T.O.S

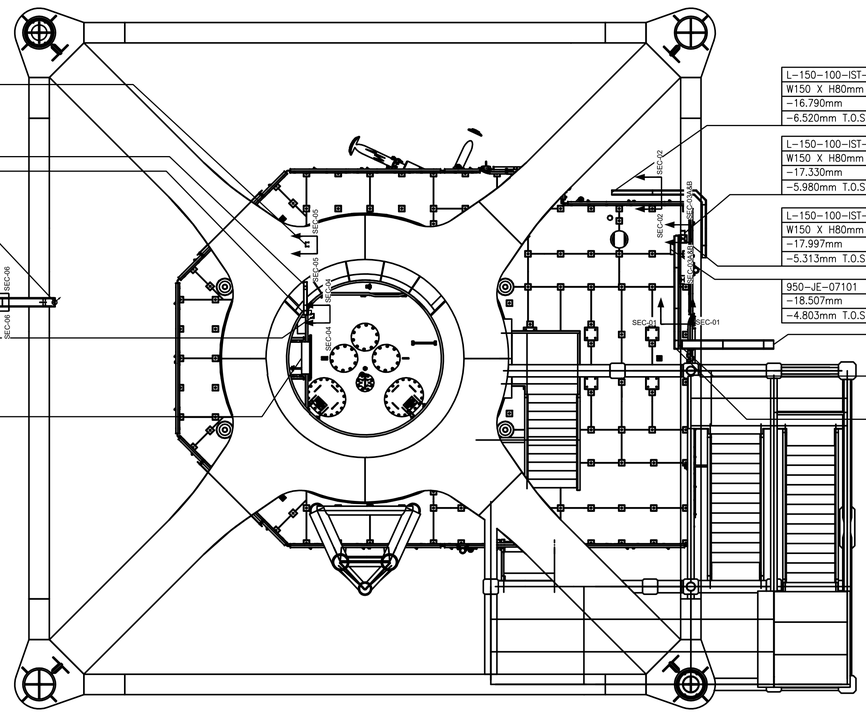


SECONDARY CABLETRAY

TRANSITION PIECE

SCALE: 1:50

VIEW EL. 6000mm to 23310mm

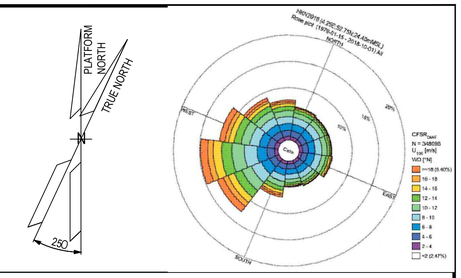

NOTES

1. ALL DIMENSIONS AND ELEVATIONS ARE GIVEN IN mm UNLESS OTHERWISE NOTED.
2. ELEVATIONS REFER TO T.O.S.
3. THIS DRAWING IS VALID ONLY FOR INSTRUMENT CABLE ROUTING LAYOUT.

LEGEND

- MAIN CABLE TRAY
- SECONDARY CABLE TRAY
- CABLE TRAY ELEVATION CHANGE
- INSTRUMENT CABLE TRAY VERTICAL RAISE
- INSTRUMENT CABLE TRAY VERTICAL DROP
- SEC-1A — CABLE TRAY SECTION
- TAG
- SIZE
- ELEVATION
- ELEVATION(T.O.S)

HOLDS

REFERENCE DOCUMENTS

123A90-DDL-PP-DL-70070	PLOT PLAN - LOWER & UPPER DECK
123A90-DDL-IN-DL-40080	INSTRUMENT LAYOUT - LOWER DECK
123A90-DDL-IN-DL-40081	INSTRUMENT LAYOUT - LOWER DECK
123A90-DDL-IN-LIS-40091	INSTRUMENT CABLE LIST
123A90-DDL-IN-DG-40015	INSTRUMENT-CCS WIRING DIAGRAMS
123A90-DDL-IN-DG-40016	INSTRUMENT-SAFETY SYSTEM WIRING DIAGRAMS
123A90-DDL-IN-DL-40082	INSTRUMENT MAIN CABLE ROUTING-UPPER DECK

INSERT SUBCONTRACTOR / VENDOR LOGO HERE

REV.	DATE	DRN	CHKD	APPD	DESCRIPTION
03	29/09/25	SPS	LCA	CGI	AS-BUILT (ASB)
02	04/10/24	VBA	LCA	DLO	ACCEPTED FOR CONSTRUCTION (AFC)
01	26/07/24	VBA	LCA	DLO	ACCEPTED FOR CONSTRUCTION (AFC)
00	22/12/23	VBA	LCA	DLO	ISSUE FOR REVIEW (IFR)

CROSSWIND

ROSETTI MARINO

TITLE :

BASE LOAD POWER HUB (BLPH)
INSTRUMENT MAIN CABLE ROUTING-TRANSITION PIECE


CONTRACT NO./TITLE CW-I-WP4-2023-05/HOLLANDSE KUST NOORD WIND PARK			SCALE 1:150
DRAWN SPS	CHECKED LCA	APPROVED CGI	DATE 29/09/25
A1	DRAWING NO. 123A90-DDL-IN-DL-40082	SHEET 003	REV. 03

File Name : 123A90-DDL-IN-DL-40082 REV03.dwg

DRAWING NO. 123A90-DDL-IN-DL-40082


REV. 03

L-SEC-1A-L-600-101-IST-002

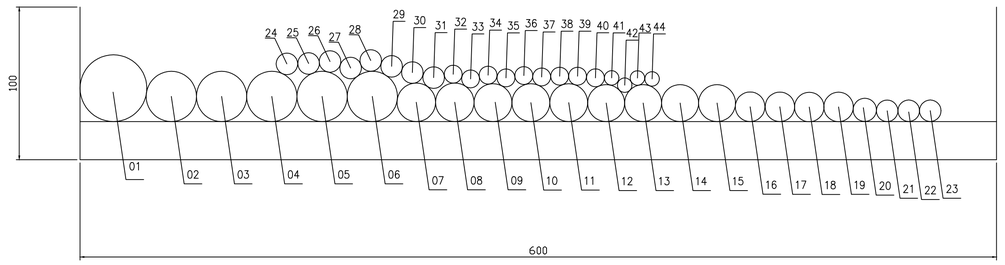


L-SEC-1A-L-600-101-IST-002				
POS	CABLENAME	FROM	TO	FORMATION
1	950-JE-05101/B400-FGS-002	950-JE-05101	B400-FGS-002	12x3x2,5mm2
2	950-JE-01101/B400-FGS-002	950-JE-01101	B400-FGS-002	6x3x2,5mm2
3	950-JE-04101/B400-FGS-002	950-JE-04101	B400-FGS-002	6x3x2,5mm2
4	950-JE-06101/B400-FGS-002	950-JE-06101	B400-FGS-002	6x3x2,5mm2
5	950-JE-06201/B400-FGS-002	950-JE-06201	B400-FGS-002	6x3x2,5mm2
6	950-JE-01102/B400-FGS-002	950-JE-01102	B400-FGS-002	6x3x2,5mm2
7	B100-HSB-001/B400-FGS-002	950-JE-06202	B400-FGS-002	6x2x0,75mm2
8	950-JE-01103/B400-FGS-002	950-JE-01103	B400-FGS-002	6x2x0,75mm2
9	00-JE-11004/B400-PCS-002	00-JE-11004	B400-PCS-002	12x2x0,75mm2
10	00-JE-12006_1/B400-PCS-002	00-JE-12006_1	B400-PCS-002	12x2x0,75mm2
11	00-JE-12006_2/B400-PCS-002	00-JE-12006_2	B400-PCS-002	12x2x0,75mm2
12	950-JE-01104/B400-FGS-002	950-JE-01104	B400-FGS-002	12x2,5mm2
13	950-JE-04103/B400-FGS-002	950-JE-04103	B400-FGS-002	12x2,5mm2
14	950-JE-05103/B400-FGS-002	950-JE-05103	B400-FGS-002	12x2,5mm2
15	950-JE-06203/B400-FGS-002	950-JE-06203	B400-FGS-002	12x2,5mm2
16	00-JE-11005/B400-PCS-002	00-JE-11005	B400-PCS-002	6x2x0,75mm2
17	20-UCP-001/B400-FGS-002	20-UCP-001	B400-FGS-002	2x2x0,75mm2
18	P320PLC/B400-FGS-002	P320PLC	B400-FGS-002	2x2x0,75mm2
19	P320PLC/B400-SIS-001	P320PLC	B400-SIS-001	2x2x0,75mm2
20	C-B100-TIR-001/B400-PCS-002	B100-TIR-001	B400-PCS-002	2x2x0,75mm2
21	C-950-FDZ-04101/950-JE-04101	C-950-FDZ-04101	950-JE-04101	3x2.5mm2
22	C-950-GDZ-04201/B400-FGS-002	C-950-GDZ-04201	B400-FGS-002	3x2.5mm2
23	C-950-GDZ-04202/B400-FGS-002	C-950-GDZ-04202	B400-FGS-002	3x2.5mm2
24	C-950-GDZ-04203/B400-FGS-002	C-950-GDZ-04203	B400-FGS-002	3x2.5mm2
25	C-85-XS-001/B400-SIS-001	85-XS-001	B400-SIS-001	2x2,5mm2
26	C-20-XS-001/B400-SIS-001	20-XS-001	B400-SIS-001	2x2,5mm2
27	C-63-XS-001/B400-SIS-001	63-XS-001	B400-SIS-001	2x2,5mm2
28	C-64-XS-001/B400-SIS-001	64-XS-001	B400-SIS-001	2x2,5mm2
29	C-77-XS-001/B400-SIS-001	77-XS-001	B400-SIS-001	2x2,5mm2
30	C-CP-100E1/B400-SIS-001	CP-100E1	B400-SIS-001	2x2,5mm2
31	C-SG-100D1-001/B400-SIS-001	SG-100D1-001	B400-SIS-001	2x2,5mm2
32	C-SG-100D1-002/B400-SIS-001	SG-100D1-002	B400-SIS-001	2x2,5mm2
33	C-SG-100D1-003/B400-SIS-001	SG-100D1-003	B400-SIS-001	2x2,5mm2
34	C-CB-200F1/B400-SIS-001	CB-200F1	B400-SIS-001	2x2,5mm2
35	C-UP-200F1/B400-SIS-001	UP-200F1	B400-SIS-001	2x2,5mm2
36	C-77-XA-001/B400-SIS-001	77-XA-001	B400-SIS-001	1x2x0,75mm2
37	C-63-PT-004/B400-SIS-001	63-PT-004	B400-SIS-001	1x2x0,75mm2
38	C-20-XA-003/B400-SIS-001	20-XA-003	B400-SIS-001	1x2x0,75mm2
39	C-63-XA-003/B400-SIS-001	63-XA-003	B400-SIS-001	1x2x0,75mm2
40	C-64-XA-003/B400-SIS-001	64-XA-003	B400-SIS-001	1x2x0,75mm2
41	C-950-MFA-06201/B400-FGS-002	950-MFA-06201	B400-FGS-002	1x2x0,75mm2
42	C-63-PT-003/B400-PCS-002	63-PT-003	B400-PCS-002	1x2x0,75mm2
43	C-B100-TDC-001/B400-PCS-002	B100-TDC001	B400-PCS-002	1x2x0,75mm2
44	C-B100-TDC-002/B400-PCS-002	B100-TDC002	B400-PCS-002	1x2x0,75mm2

L-SEC-1A-L-150-101-IST-004

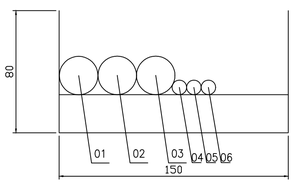


L-SEC-1A-L-150-101-IST-004				
POS	CABLENAME	FROM	TO	FORMATION
1	950-JE-06204/B400-FGS-002	950-JE-06204	B400-FGS-002	6x2x0,75mm2
2	950-JE-04204/B400-FGS-002	950-JE-04204	B400-FGS-002	6x2x0,75mm2
3	950-JE-04208/B400-FGS-002	950-JE-04208	B400-FGS-002	6x2x0,75mm2
4	C-950-SDZ-04201/B400-FGS-002	950-SDZ-04201	B400-FGS-002	1x2x0.75mm2
5	C-950-SDZ-04202/B400-FGS-002	950-SDZ-04202	B400-FGS-002	1x2x0.75mm2
6	C-950-SDZ-04203/B400-FGS-002	950-SDZ-04203	B400-FGS-002	1x2x0.75mm2

L-SEC-1A-L-200-101-TLT-001

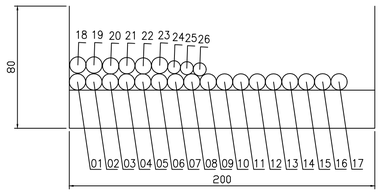

L-SEC-1A-L-200-101-TLT-001				
POS	CABLENAME	FROM	TO	FORMATION
1	TR-100AD1AVR/B400-NET-001	TR-100AD1AVR	B400-NET-001	CAT.6A4x2xAWG23
2	B100-HSB-001/B400-NET-001	B100-HSB-001	B400-NET-001	CAT.6A4x2xAWG23
3	B200-HSB-001/B400-NET-001	B200-HSB-001	B400-NET-001	CAT.6A4x2xAWG23
4	SG-100D1/B400-NET-001.01	SG-100D1	B400-NET-001	CAT.6A4x2xAWG23
5	SG-100D1/B400-NET-001.02	SG-100D1	B400-NET-001	CAT.6A4x2xAWG23
6	SG-100D1/B400-NET-001.03	SG-100D1	B400-NET-001	CAT.6A4x2xAWG23
7	SG-200N1/B400-NET-001.01	SG-200N1	B400-NET-001	CAT.6A4x2xAWG23
8	SG-200N1/B400-NET-001.02	SG-200N1	B400-NET-001	CAT.6A4x2xAWG23
9	SG-200N1/B400-NET-001.03	SG-200N1	B400-NET-001	CAT.6A4x2xAWG23
10	SG-200D2/B400-NET-001	SG-200D2	B400-NET-001	CAT.6A4x2xAWG23
11	B300-HSB-001/B400-NET-001	B300-HSB-001	B400-NET-001	CAT.6A4x2xAWG23
12	UP-200F1/B400-NET-001.01	UP-200F1	B400-NET-001	CAT.6A4x2xAWG23
13	UP-200F1/B400-NET-001.02	UP-200F1	B400-NET-001	CAT.6A4x2xAWG23
14	UP-200F3/B400-NET-001.01	UP-200F3	B400-NET-001	CAT.6A4x2xAWG23
15	UP-200F3/B400-NET-001.02	UP-200F3	B400-NET-001	CAT.6A4x2xAWG23
16	UP-200F4/B400-NET-001.01	UP-200F4	B400-NET-001	CAT.6A4x2xAWG23
17	UP-200F4/B400-NET-001.02	UP-200F4	B400-NET-001	CAT.6A4x2xAWG23
18	P320PLC/B400-NET-001.01	P320PLC	B400-NET-001	CAT.6A4x2xAWG23
19	P320PLC/B400-NET-001.02	P320PLC	B400-NET-001	CAT.6A4x2xAWG23
20	20-UCP-001/B400-NET-001.01	20-UCP-001	B400-NET-001	CAT.6A4x2xAWG23
21	20-UCP-001/B400-NET-001.02	20-UCP-001	B400-NET-001	CAT.6A4x2xAWG23
22	63-LP-001/B400-NET-001	63-LP-001	B400-NET-001	CAT.6A4x2xAWG23
23	64-LP-001/B400-NET-001	64-LP-001	B400-NET-001	CAT.6A4x2xAWG23
24	CP-100E1/B400-NET-001.01	CP-100E1	B400-NET-001	FO12OM2
25	CP-100E1/B400-NET-001.02	CP-100E1	B400-NET-001	FO12OM2
26	HNA6/B400-NET-001	HNA6	B400-NET-001	FO12OS2
27	C-GPSANT/B400-NET-001	GPSANT	B400-NET-001	STD-VENDOR

L-SEC-1A-L-600-101-IST-003

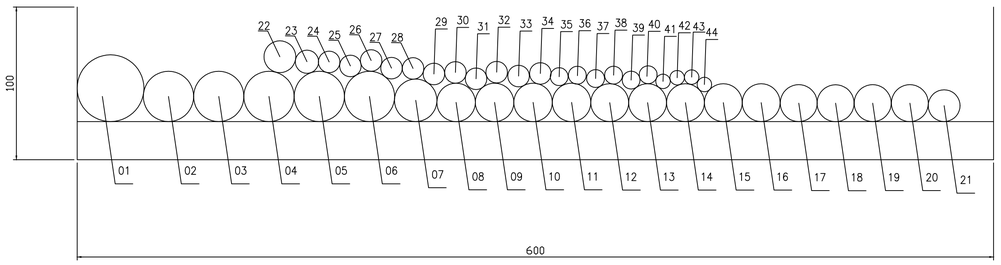

L-SEC-1A-L-600-101-IST-003				
POS	CABLENAME	FROM	TO	FORMATION
1	950-JE-03101/B400-FGS-002	950-JE-03101	B400-FGS-002	12x3x2,5mm2
2	950-JE-04201/B400-FGS-002	950-JE-04201	B400-FGS-002	6x3x2,5mm2
3	950-JE-04205/B400-FGS-002	950-JE-04205	B400-FGS-002	6x3x2,5mm2
4	950-JE-02103/B400-FGS-002	950-JE-02103	B400-FGS-002	6x3x2,5mm2
5	00-JE-21002/B400-SIS-001	00-JE-21002	B400-SIS-001	12x2x0,75mm2
6	00-JE-22002_1/B400-SIS-001	00-JE-22002_1	B400-SIS-001	12x2x0,75mm2
7	00-JE-22002_2/B400-SIS-001	00-JE-22002_2	B400-SIS-001	12x2x0,75mm2
8	00-JE-13002/B400-PCS-002	00-JE-13002	B400-PCS-002	24x2,5mm2
9	950-JE-04102/B400-FGS-002	950-JE-04102	B400-FGS-002	6x2x0,75mm2
10	950-JE-05102/B400-FGS-002	950-JE-05102	B400-FGS-002	6x2x0,75mm2
11	B200-HSB-001/B400-FGS-002	950-JE-04202	B400-FGS-002	6x2x0,75mm2
12	B300-HSB-001/B400-FGS-002	950-JE-04206	B400-FGS-002	6x2x0,75mm2
13	00-JE-11003_1/B400-PCS-002	00-JE-11003_1	B400-PCS-002	12x2x0,75mm2
14	00-JE-11003_2/B400-PCS-002	00-JE-11003_2	B400-PCS-002	12x2x0,75mm2
15	00-JE-12004_1/B400-PCS-002	00-JE-12004_1	B400-PCS-002	12x2x0,75mm2
16	00-JE-12004_2/B400-PCS-002	00-JE-12004_2	B400-PCS-002	12x2x0,75mm2
17	00-JE-12005/B400-PCS-002	00-JE-12005	B400-PCS-002	12x2x0,75mm2
18	00-JE-23002/B400-SIS-001	00-JE-23002	B400-SIS-001	12x2,5mm2
19	UP-200F3/B400-SIS-001	UP-200F3	B400-SIS-001	12x2,5mm2
20	950-JE-04207/B400-FGS-002	950-JE-04207	B400-FGS-002	12x2,5mm2
21	950-JE-04203/B400-FGS-002	950-JE-04203	B400-FGS-002	12x2,5mm2
22	00-JE-13003/B400-PCS-002	00-JE-13003	B400-PCS-002	12x2,5mm2
23	C-B200-TIR-001/B400-PCS-002	B200-TIR-001	B400-PCS-002	2x2x0,75mm2
24	C-B300-TIR-001/B400-PCS-002	B300-TIR-001	B400-PCS-002	2x2x0,75mm2
25	C-77-XS-002/B400-SIS-001	77-XS-002	B400-SIS-001	2x2,5mm2
26	C-77-XS-003/B400-SIS-001	77-XS-003	B400-SIS-001	2x2,5mm2
27	C-SG-200N1-001/B400-SIS-001	SG-200N1-001	B400-SIS-001	2x2,5mm2
28	C-SG-200N1-002/B400-SIS-001	SG-200N1-002	B400-SIS-001	2x2,5mm2
29	C-CB-200F3A/B400-SIS-001	CB-200F3A	B400-SIS-001	2x2,5mm2
30	C-CB-200F3B/B400-SIS-001	CB-200F3B	B400-SIS-001	2x2,5mm2
31	C-CB-200F4A/B400-SIS-001	CB-200F4A	B400-SIS-001	2x2,5mm2
32	C-CB-200F4B/B400-SIS-001	CB-200F4B	B400-SIS-001	2x2,5mm2
33	C-UP-200F4/B400-SIS-001	UP-200F4	B400-SIS-001	2x2,5mm2
34	C-NC-200F2/B400-FGS-002.01	N200F2	B400-FGS-002.01	1x2x0,75mm2
35	C-NC-200F2/B400-FGS-002.02	N200F2	B400-FGS-002.02	2x2,5mm2
36	C-NC-200F2/B400-SIS-001	N200F2	B400-SIS-001	2x2,5mm2
37	C-77-XA-002/B400-SIS-001	77-XA-002	B400-SIS-001	1x2x0,75mm2
38	C-77-XA-003/B400-SIS-001	77-XA-003	B400-SIS-001	1x2x0,75mm2
39	C-950-MFA-04203/B400-FGS-002	950-MFA-04203	B400-FGS-002	1x2x0,75mm2
40	C-950-MFA-04202/B400-FGS-002	950-MFA-04202	B400-FGS-002	1x2x0,75mm2
41	C-B200-TDC-001/B400-PCS-002	B200-TD001	B400-PCS-002	1x2x0,75mm2
42	C-B200-TDC-002/B400-PCS-002	B200-TD002	B400-PCS-002	1x2x0,75mm2
43	C-B300-TDC-001/B400-PCS-002	B300-TD001	B400-PCS-002	1x2x0,75mm2
44	C-B300-TDC-002/B400-PCS-002	B300-TD002	B400-PCS-002	1x2x0,75mm2

INSERT SUBCONTRACTOR / VENDOR LOGO HERE

REV.	DATE	DRN	CHKD	APPD	DESCRIPTION
03	29/09/25	SPS	LCA	CGI	AS-BUILT (ASB)
02	04/10/24	VBA	LCA	DLO	ACCEPTED FOR CONSTRUCTION (AFC)
01	26/07/24	VBA	LCA	DLO	ACCEPTED FOR CONSTRUCTION (AFC)
00	22/12/23	VBA	LCA	DLO	ISSUE FOR REVIEW (IFR)

CROSSWIND

ROSETTI MARINO

TITLE :
BASE LOAD POWER HUB (BLPH)
INSTRUMENT MAIN CABLE ROUTING-LOWER DECK
TOS EL. TOS EL. 23.310M

CONTRACT NO./TITLE CW-I-WP4-2023-05/HOLLANDSE KUST NOORD WIND PARK | SCALE 1:150

DRAWN SPS | CHECKED LCA | APPROVED CGI | DATE 29/09/25


A1 | DRAWING NO. 123A90-DDL-IN-DL-40082 | SHEET 004 | REV. 03

File Name : 123A90-DDL-IN-DL-40082 REV:03.dwg

DRAWING NO. 123A90-DDL-IN-DL-40082


REV. 03

L-SEC-2-L-200-101-IST-020

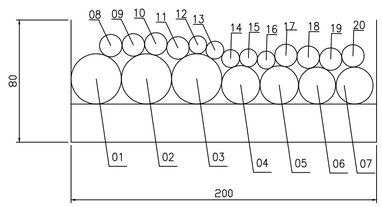


L-SEC-2-L-200-101-IST-020				
POS	CABLENAME	FROM	TO	FORMATION
1	950-JE-04101/B400-FGS-002	950-JE-04101	B400-FGS-002	6x3x2,5mm2
2	950-JE-01101/B400-FGS-002	950-JE-01101	B400-FGS-002	6x3x2,5mm2
3	950-JE-01102/B400-FGS-002	950-JE-01102	B400-FGS-002	6x3x2,5mm2
4	950-JE-04102/B400-FGS-002	950-JE-04102	B400-FGS-002	6x2x0,75mm2
5	950-JE-01103/B400-FGS-002	950-JE-01103	B400-FGS-002	6x2x0,75mm2
6	950-JE-04103/B400-FGS-002	950-JE-04103	B400-FGS-002	12x2,5mm2
7	950-JE-01104/B400-FGS-002	950-JE-01104	B400-FGS-002	12x2,5mm2
8	C-950-FDZ-02101/950-JE-02101	950-FDZ-02101	950-JE-02101	3x2.5mm2
9	C-950-ASD-01101/00-JE-22001	950-ASD-01101	00-JE-22001	1x2x0,75mm2
10	C-950-MOB-01101/00-JE-22001	950-MOB-01101	00-JE-22001	1x2x0,75mm2
11	C-950-ESD-01101/00-JE-22001	950-ESD-01101	00-JE-22001	1x2x0,75mm2
12	C-950-ESDD-01101/00-JE-22001	950-ESDD-01101	00-JE-22001	1x2x0,75mm2
13	C-950-ASD-04101/00-JE-22001	950-ASD-04101	00-JE-22001	1x2x0,75mm2
14	C-950-MOB-04101/00-JE-22001	950-MOB-04101	00-JE-22001	1x2x0,75mm2
15	C-950-ESD-04101/00-JE-22001	950-ESD-04101	00-JE-22001	1x2x0,75mm2
16	C-950-ESDD-04101/00-JE-22001	950-ESDD-04101	00-JE-22001	1x2x0,75mm2
17	C-950-FDZ-04101/950-JE-04101	950-FDZ-04101	950-JE-04101	3x2.5 mm2
18	C-950-FDZ-04102/950-JE-04101	950-FDZ-04102	950-JE-04101	3x2.5 mm2
19	C-950-FDZ-04103/950-JE-04101	950-FDZ-04103	950-JE-04101	3x2.5 mm2
20	C-950-FDZ-04104/950-JE-04101	950-FDZ-04104	950-JE-04101	3x2.5 mm2
21	C-GPSANT/B400-NET-001	GPSANT	B400-NET-001	STD-VENDOR

L-SEC-1B-L-600-101-IST-002

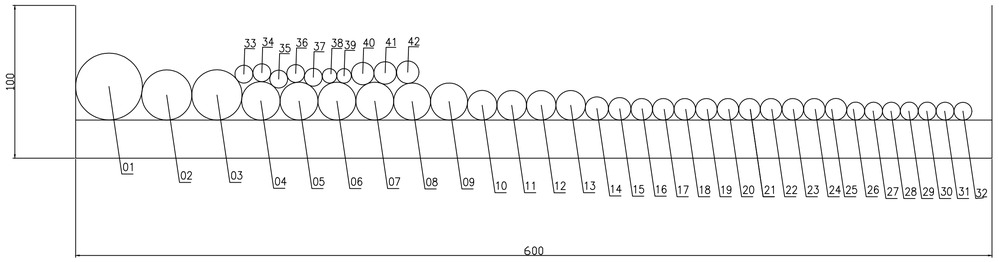


L-SEC-1B-L-600-101-IST-002				
POS	CABLENAME	FROM	TO	FORMATION
1	950-JE-05101/B400-FGS-002	950-JE-05101	B400-FGS-002	12x3x2,5mm2
2	950-JE-06101/B400-FGS-002	950-JE-06101	B400-FGS-002	6x3x2,5mm2
3	950-JE-06201/B400-FGS-002	950-JE-06201	B400-FGS-002	6x3x2,5mm2
4	B100-HSB-001/B400-FGS-002	950-JE-06202	B400-FGS-002	6x2x0,75mm2
5	00-JE-11004/B400-PCS-002	00-JE-11004	B400-PCS-002	12x2x0,75mm2
6	00-JE-12006_1/B400-PCS-002	00-JE-12006_1	B400-PCS-002	12x2x0,75mm2
7	00-JE-12006_2/B400-PCS-002	00-JE-12006_2	B400-PCS-002	12x2x0,75mm2
8	950-JE-05103/B400-FGS-002	950-JE-05103	B400-FGS-002	12x2,5mm2
9	950-JE-06203/B400-FGS-002	950-JE-06203	B400-FGS-002	12x2,5mm2
10	00-JE-11005/B400-PCS-002	00-JE-11005	B400-PCS-002	6x2x0,75mm2
11	P320PLC/B400-FGS-002	P320PLC	B400-FGS-002	2x2x0,75mm2
12	20-UCP-001/B400-FGS-002	20-UCP-001	B400-FGS-002	2x2x0,75mm2
13	P320PLC/B400-SIS-001	P320PLC	B400-SIS-001	2x2x0,75mm2
14	C-B100-TIR-001/B400-PCS-002	B100-TIR-001	B400-PCS-002	2x2x0,75mm2
15	C-950-FDZ-02101/950-JE-02101	950-FDZ-02101	950-JE-02101	3x2.5mm2
16	C-85-XS-001/B400-SIS-001	85-XS-001	B400-SIS-001	2x2,5mm2
17	C-20-XS-001/B400-SIS-001	20-XS-001	B400-SIS-001	2x2,5mm2
18	C-64-XS-001/B400-SIS-001	64-XS-001	B400-SIS-001	2x2,5mm2
19	C-77-XS-001/B400-SIS-001	77-XS-001	B400-SIS-001	2x2,5mm2
20	C-CP-100E1/B400-SIS-001	CP-100E1	B400-SIS-001	2x2,5mm2
21	C-SG-100D1-001/B400-SIS-001	SG-100D1-001	B400-SIS-001	2x2,5mm2
22	C-SG-100D1-002/B400-SIS-001	SG-100D1-002	B400-SIS-001	2x2,5mm2
23	C-SG-100D1-003/B400-SIS-001	SG-100D1-003	B400-SIS-001	2x2,5mm2
24	C-CB-200F1/B400-SIS-001	CB-200F1	B400-SIS-001	2x2,5mm2
25	C-UP-200F1/B400-SIS-001	UP-200F1	B400-SIS-001	2x2,5mm2
26	C-77-XA-001/B400-SIS-001	77-XA-001	B400-SIS-001	1x2x0,75mm2
27	C-20-XA-003/B400-SIS-001	20-XA-003	B400-SIS-001	1x2x0,75mm2
28	C-64-XA-003/B400-SIS-001	64-XA-003	B400-SIS-001	1x2x0,75mm2
29	C-950-MFA-06201/B400-FGS-002	950-MFA-06201	B400-FGS-002	1x2x0,75mm2
30	C-950-ASD-01101/00-JE-22001	950-ASD-01101	00-JE-22001	1x2x0,75mm2
31	C-950-MOB-01101/00-JE-22001	950-MOB-01101	00-JE-22001	1x2x0,75mm2
32	C-950-ESD-01101/00-JE-22001	950-ESD-01101	00-JE-22001	1x2x0,75mm2
33	C-950-ESDD-01101/00-JE-22001	950-ESDD-01101	00-JE-22001	1x2x0,75mm2
34	C-950-ASD-04101/00-JE-22001	950-ASD-04101	00-JE-22001	1x2x0,75mm2
35	C-950-MOB-04101/00-JE-22001	950-MOB-04101	00-JE-22001	1x2x0,75mm2
36	C-950-ESD-04101/00-JE-22001	950-ESD-04101	00-JE-22001	1x2x0,75mm2
37	C-950-ESDD-04101/00-JE-22001	950-ESDD-04101	00-JE-22001	1x2x0,75mm2
38	C-B100-TDC-001/B400-PCS-002	B100-TDC001	B400-PCS-002	1x2x0,75mm2
39	C-B100-TDC-002/B400-PCS-002	B100-TDC002	B400-PCS-002	1x2x0,75mm2
40	C-950-FDZ-04102/950-JE-04101	950-FDZ-04102	950-JE-04101	3x2.5 mm2
41	C-950-FDZ-04103/950-JE-04101	950-FDZ-04103	950-JE-04101	3x2.5 mm2
42	C-950-FDZ-04104/950-JE-04101	950-FDZ-04104	950-JE-04101	3x2.5 mm2

L-SEC-1B-L-200-101-TLT-001

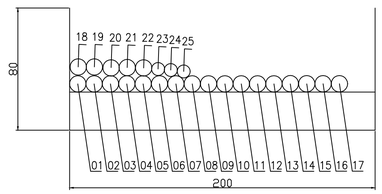


L-SEC-1B-L-200-101-TLT-001				
POS	CABLENAME	FROM	TO	FORMATION
1	TR-100AD1AVR/B400-NET-001	TR-100AD1AVR	B400-NET-001	CAT.6A4x2xAWG23
2	B100-HSB-001/B400-NET-001	B100-HSB-001	B400-NET-001	CAT.6A4x2xAWG23
3	B200-HSB-001/B400-NET-001	B200-HSB-001	B400-NET-001	CAT.6A4x2xAWG23
4	SG-100D1/B400-NET-001.01	SG-100D1	B400-NET-001	CAT.6A4x2xAWG23
5	SG-100D1/B400-NET-001.02	SG-100D1	B400-NET-001	CAT.6A4x2xAWG23
6	SG-100D1/B400-NET-001.03	SG-100D1	B400-NET-001	CAT.6A4x2xAWG23
7	SG-200N1/B400-NET-001.01	SG-200N1	B400-NET-001	CAT.6A4x2xAWG23
8	SG-200N1/B400-NET-001.02	SG-200N1	B400-NET-001	CAT.6A4x2xAWG23
9	SG-200N1/B400-NET-001.03	SG-200N1	B400-NET-001	CAT.6A4x2xAWG23
10	SG-200D2/B400-NET-001	SG-200D2	B400-NET-001	CAT.6A4x2xAWG23
11	B300-HSB-001/B400-NET-001	B300-HSB-001	B400-NET-001	CAT.6A4x2xAWG23
12	UP-200F1/B400-NET-001.01	UP-200F1	B400-NET-001	CAT.6A4x2xAWG23
13	UP-200F1/B400-NET-001.02	UP-200F1	B400-NET-001	CAT.6A4x2xAWG23
14	UP-200F3/B400-NET-001.01	UP-200F3	B400-NET-001	CAT.6A4x2xAWG23
15	UP-200F3/B400-NET-001.02	UP-200F3	B400-NET-001	CAT.6A4x2xAWG23
16	UP-200F4/B400-NET-001.01	UP-200F4	B400-NET-001	CAT.6A4x2xAWG23
17	UP-200F4/B400-NET-001.02	UP-200F4	B400-NET-001	CAT.6A4x2xAWG23
18	P320PLC/B400-NET-001.01	P320PLC	B400-NET-001	CAT.6A4x2xAWG23
19	P320PLC/B400-NET-001.02	P320PLC	B400-NET-001	CAT.6A4x2xAWG23
20	20-UCP-001/B400-NET-001.01	20-UCP-001	B400-NET-001	CAT.6A4x2xAWG23
21	20-UCP-001/B400-NET-001.02	20-UCP-001	B400-NET-001	CAT.6A4x2xAWG23
22	64-LP-001/B400-NET-001	64-LP-001	B400-NET-001	CAT.6A4x2xAWG23
23	CP-100E1/B400-NET-001.01	CP-100E1	B400-NET-001	FO12OM2
24	CP-100E1/B400-NET-001.02	CP-100E1	B400-NET-001	FO12OM2
25	HNA6/B400-NET-001	HNA6	B400-NET-001	FO12OS2

L-SEC-3-L-150-101-IST-011

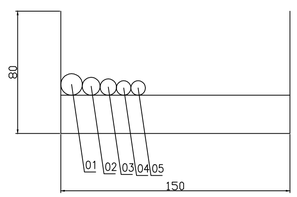

L-SEC-3-L-150-101-IST-011				
POS	CABLENAME	FROM	TO	FORMATION
1	C-63-XS-001/B400-SIS-001	63-XS-001	B400-SIS-001	2x2,5mm2
2	C-63-XA-003/B400-SIS-001	63-XA-003	B400-SIS-001	1x2x0,75mm2
3	63-LP-001/B400-NET-001	63-LP-001	B400-NET-001	CAT.6A4x2xAWG23
4	C-63-PT-003/B400-PCS-002	63-PT-003	B400-PCS-002	1x2x0,75mm2
5	C-63-PT-004/B400-SIS-001	63-PT-004	B400-SIS-001	1x2x0,75mm2

L-SEC-1B-L-150-101-IST-004

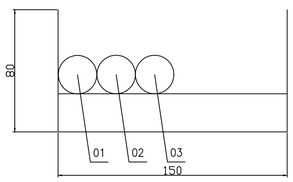

L-SEC-1B-L-150-101-IST-004				
POS	CABLENAME	FROM	TO	FORMATION
1	950-JE-06204/B400-FGS-002	950-JE-06204	B400-FGS-002	6x2x0,75mm2
2	950-JE-04204/B400-FGS-002	950-JE-04204	B400-FGS-002	6x2x0,75mm2
3	950-JE-04208/B400-FGS-002	950-JE-04208	B400-FGS-002	6x2x0,75mm2

INSERT SUBCONTRACTOR / VENDOR LOGO HERE

REV.	DATE	DRN	CHKD	APPD	DESCRIPTION
03	29/09/25	SPS	LCA	CGI	AS-BUILT (ASB)
02	04/10/24	VBA	LCA	DLO	ACCEPTED FOR CONSTRUCTION (AFC)
01	26/07/24	VBA	LCA	DLO	ACCEPTED FOR CONSTRUCTION (AFC)
00	22/12/23	VBA	LCA	DLO	ISSUE FOR REVIEW (IFR)

CROSSWIND

ROSETTI MARINO

TITLE :
BASE LOAD POWER HUB (BLPH)
INSTRUMENT MAIN CABLE ROUTING-LOWER DECK
TOS EL. TOS EL. 23.310M

CONTRACT NO./TITLE CW-I-WP4-2023-05/HOLLANDSE KUST NOORD WIND PARK | SCALE 1:150

DRAWN SPS | CHECKED LCA | APPROVED CGI | DATE 29/09/25


A1 | DRAWING NO. 123A90-DDL-IN-DL-40082 | SHEET 005 | REV. 03

File Name : 123A90-DDL-IN-DL-40082 REV03.dwg

DRAWING NO.: 123A90-DDL-IN-DL-40082


REV.: 03

L-SEC-1B-L-600-101-IST-003

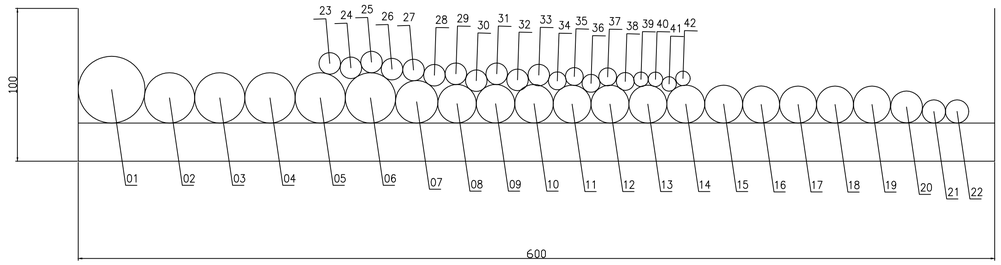


L-SEC-1B-L-600-101-IST-003				
POS	CABLENAME	FROM	TO	FORMATION
1	950-JE-03101/B400-FGS-002	950-JE-03101	B400-FGS-002	12x3x2.5 mm2
2	950-JE-04201/B400-FGS-002	950-JE-04201	B400-FGS-002	6x3x2,5mm2
3	950-JE-04205/B400-FGS-002	950-JE-04205	B400-FGS-002	6x3x2,5mm2
4	950-JE-02103/B400-FGS-002	950-JE-02103	B400-FGS-002	6x3x2,5mm2
5	00-JE-21002/B400-SIS-001	00-JE-21002	B400-SIS-001	12x2x0,75mm2
6	00-JE-22002_1/B400-SIS-001	00-JE-22002_1	B400-SIS-001	12x2x0,75mm2
7	00-JE-22002_2/B400-SIS-001	00-JE-22002_2	B400-SIS-001	12x2x0,75mm2
8	00-JE-13002/B400-PCS-002	00-JE-13002	B400-PCS-002	24x2,5mm2
9	950-JE-05102/B400-FGS-002	950-JE-05102	B400-FGS-002	6x2x0,75mm2
10	B200-HSB-001/B400-FGS-002	950-JE-04202	B400-FGS-002	6x2x0,75mm2
11	B300-HSB-001/B400-FGS-002	950-JE-04206	B400-FGS-002	6x2x0,75mm2
12	00-JE-11003_1/B400-PCS-002	00-JE-11003_1	B400-PCS-002	12x2x0,75mm2
13	00-JE-11003_2/B400-PCS-002	00-JE-11003_2	B400-PCS-002	12x2x0,75mm2
14	00-JE-12004_1/B400-PCS-002	00-JE-12004_1	B400-PCS-002	12x2x0,75mm2
15	00-JE-12004_2/B400-PCS-002	00-JE-12004_2	B400-PCS-002	12x2x0,75mm2
16	00-JE-12005/B400-PCS-002	00-JE-12005	B400-PCS-002	12x2x0,75mm2
17	UP-200F3/B400-SIS-001	UP-200F3	B400-SIS-001	12x2,5mm2
18	950-JE-04203/B400-FGS-002	950-JE-04203	B400-FGS-002	12x2,5mm2
19	950-JE-04207/B400-FGS-002	950-JE-04207	B400-FGS-002	12x2,5mm2
20	00-JE-13003/B400-PCS-002	00-JE-13003	B400-PCS-002	12x2,5mm2
21	C-B200-TIR-001/B400-PCS-002	B200-TIR-001	B400-PCS-002	2x2x0,75mm2
22	C-B300-TIR-001/B400-PCS-002	B300-TIR-001	B400-PCS-002	2x2x0,75mm2
23	C-77-XS-002/B400-SIS-001	77-XS-002	B400-SIS-001	2x2,5mm2
24	C-77-XS-003/B400-SIS-001	77-XS-003	B400-SIS-001	2x2,5mm2
25	C-SG-200N1-001/B400-SIS-001	SG-200N1-001	B400-SIS-001	2x2,5mm2
26	C-SG-200N1-002/B400-SIS-001	SG-200N1-002	B400-SIS-001	2x2,5mm2
27	C-CB-200F3A/B400-SIS-001	CB-200F3A	B400-SIS-001	2x2,5mm2
28	C-CB-200F3B/B400-SIS-001	CB-200F3B	B400-SIS-001	2x2,5mm2
29	C-CB-200F4A/B400-SIS-001	CB-200F4A	B400-SIS-001	2x2,5mm2
30	C-CB-200F4B/B400-SIS-001	CB-200F4B	B400-SIS-001	2x2,5mm2
31	C-UP-200F4/B400-SIS-001	UP-200F4	B400-SIS-001	2x2,5mm2
32	C-NC-200F2/B400-FGS-002.01	N200F2	B400-FGS-002.01	1x2x0.75mm2
33	C-NC-200F2/B400-FGS-002.02	N200F2	B400-FGS-002.02	2x2,5mm2
34	C-NC-200F2/B400-SIS-001	N200F2	B400-SIS-001	2x2,5mm2
35	C-77-XA-002/B400-SIS-001	77-XA-002	B400-SIS-001	1x2x0,75mm2
36	C-77-XA-003/B400-SIS-001	77-XA-003	B400-SIS-001	1x2x0,75mm2
37	C-950-MFA-04203/B400-FGS-002	950-MFA-04203	B400-FGS-002	1x2x0,75mm2
38	C-950-MFA-04202/B400-FGS-002	950-MFA-04202	B400-FGS-002	1x2x0,75mm2
39	C-B200-TDC-001/B400-PCS-002	B200-TD001	B400-PCS-002	1x2x0,75mm2
40	C-B200-TDC-002/B400-PCS-002	B200-TD002	B400-PCS-002	1x2x0,75mm2
41	C-B300-TDC-001/B400-PCS-002	B300-TD001	B400-PCS-002	1x2x0,75mm2
42	C-B300-TDC-002/B400-PCS-002	B300-TD002	B400-PCS-002	1x2x0,75mm2

L-SEC-4-L-150-101-IST-007

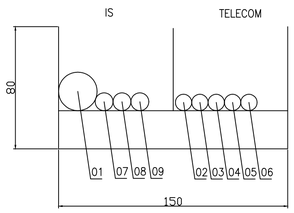


L-SEC-4-L-150-101-IST-007				
POS	CABLENAME	FROM	TO	FORMATION
1	950-JE-04208/B400-FGS-002	950-JE-042008	B400-FGS-002	6x2x0,75mm2
2	B300-HSB-001/B400-NET-001	B300-HSB-001	B400-NET-001	CAT.6A4x2xAWG23
3	UP-200F3/B400-NET-001.01	UP-200F3	B400-NET-001	CAT.6A4x2xAWG23
4	UP-200F3/B400-NET-001.02	UP-200F3	B400-NET-001	CAT.6A4x2xAWG23
5	UP-200F4/B400-NET-001.01	UP-200F4	B400-NET-001	CAT.6A4x2xAWG23
6	UP-200F4/B400-NET-001.02	UP-200F4	B400-NET-001	CAT.6A4x2xAWG23
7	C-950-SDZ-04207/950-JE-04208	950-SDZ-04207	950-JE-04208	1x2x0.75 mm2
8	C-950-SDZ-04208/950-JE-04208	950-SDZ-04208	950-JE-04208	1x2x0.75 mm2
9	C-950-SDZ-04209/950-JE-04208	950-SDZ-04209	950-JE-04208	1x2x0.75 mm2

L-SEC-4-L-200-101-IST-032

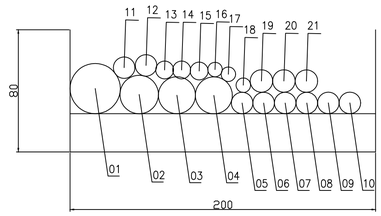


L-SEC-4-L-200-101-IST-032				
POS	CABLENAME	FROM	TO	FORMATION
1	950-JE-04205/B400-FGS-002	950-JE-04205	B400-FGS-002	6x3x2,5mm2
2	B300-HSB-001/B400-FGS-002	950-JE-04206	B400-FGS-002	6x2x0,75mm2
3	UP-200F3/B400-SIS-001	UP-200F3	B400-SIS-001	12x2,5mm2
4	950-JE-04207/B400-FGS-002	950-JE-04207	B400-FGS-002	12x2,5mm2
5	C-77-XS-003/B400-SIS-001	C-77-XS-003	B400-SIS-001	2x2,5mm2
6	C-CB-200F3A/B400-SIS-001	CB-200F3A	B400-SIS-001	2x2,5mm2
7	C-CB-200F3B/B400-SIS-001	CB-200F3B	B400-SIS-001	2x2,5mm2
8	C-CB-200F4A/B400-SIS-001	CB-200F4A	B400-SIS-001	2x2,5mm2
9	C-CB-200F4B/B400-SIS-001	CB-200F4B	B400-SIS-001	2x2,5mm2
10	C-UP-200F4/B400-SIS-001	UP-200F4	B400-SIS-001	2x2,5mm2
11	C-NC-200F2/B400-FGS-002.01	NC-200F2	B400-FGS-002.01	1x2x0.75mm2
12	C-NC-200F2/B400-FGS-002.02	NC-200F2	B400-FGS-002.02	2x2,5mm2
13	C-77-XA-003/B400-SIS-001	C-77-XA-003	B400-SIS-001	1x2x0,75mm2
14	C-NC-200F2/B400-SIS-001	NC-200F2	B400-SIS-001	2x2,5mm2
15	C-950-MFA-04202/B400-FGS-002	C-950-MFA-04202	B400-FGS-002	1x2x0,75mm2
16	C-B300-TIR-001/B400-PCS-002	B300-TIR-001	B400-PCS-002	2x2x0,75mm2
17	C-B300-TDC-001/B400-PCS-002	C-B300-TDC-001	B400-PCS-002	1x2x0,75mm2
18	C-B300-TDC-002/B400-PCS-002	C-B300-TDC-002	B400-PCS-002	1x2x0,75mm2
19	C-950-GDZ-04207/950-JE-04205	950-GDZ-4207	950-JE-04205	3x2.5 mm2
20	C-950-GDZ-04208/950-JE-04205	950-GDZ-4208	950-JE-04205	3x2.5 mm2
21	C-950-GDZ-04209/950-JE-04205	950-GDZ-4209	950-JE-04205	3x2.5 mm2

L-SEC-1C-L-200-101-TLT-001

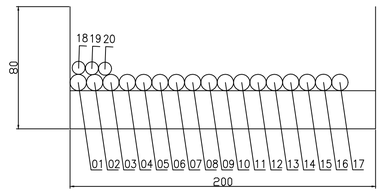


L-SEC-1C-L-200-101-TLT-001				
POS	CABLENAME	FROM	TO	FORMATION
1	TR-100AD1AVR/B400-NET-001	TR-100AD1AVR	B400-NET-001	CAT.6A4x2xAWG23
2	B100-HSB-001/B400-NET-001	B100-HSB-001	B400-NET-001	CAT.6A4x2xAWG23
3	B200-HSB-001/B400-NET-001	B200-HSB-001	B400-NET-001	CAT.6A4x2xAWG23
4	SG-100D1/B400-NET-001.01	SG-100D1	B400-NET-001	CAT.6A4x2xAWG23
5	SG-100D1/B400-NET-001.02	SG-100D1	B400-NET-001	CAT.6A4x2xAWG23
6	SG-100D1/B400-NET-001.03	SG-100D1	B400-NET-001	CAT.6A4x2xAWG23
7	SG-200N1/B400-NET-001.01	SG-200N1	B400-NET-001	CAT.6A4x2xAWG23
8	SG-200N1/B400-NET-001.02	SG-200N1	B400-NET-001	CAT.6A4x2xAWG23
9	SG-200N1/B400-NET-001.03	SG-200N1	B400-NET-001	CAT.6A4x2xAWG23
10	SG-200D2/B400-NET-001	SG-200D2	B400-NET-001	CAT.6A4x2xAWG23
11	UP-200F1/B400-NET-001.01	UP-200F1	B400-NET-001	CAT.6A4x2xAWG23
12	UP-200F1/B400-NET-001.02	UP-200F1	B400-NET-001	CAT.6A4x2xAWG23
13	P320PLC/B400-NET-001.01	P320PLC	B400-NET-001	CAT.6A4x2xAWG23
14	P320PLC/B400-NET-001.02	P320PLC	B400-NET-001	CAT.6A4x2xAWG23
15	20-UCP-001/B400-NET-001.01	20-UCP-001	B400-NET-001	CAT.6A4x2xAWG23
16	20-UCP-001/B400-NET-001.02	20-UCP-001	B400-NET-001	CAT.6A4x2xAWG23
17	64-LP-001/B400-NET-001	64-LP-001	B400-NET-001	CAT.6A4x2xAWG23
18	CP-100E1/B400-NET-001.01	CP-100E1	B400-NET-001	FO12OM2
19	CP-100E1/B400-NET-001.02	CP-100E1	B400-NET-001	FO12OM2
20	HNA6/B400-NET-001	HNA6	B400-NET-001	FO12OS2

L-SEC-5-L-150-101-IST-008

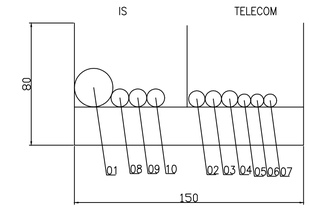

L-SEC-5-L-150-101-IST-008				
POS	CABLENAME	FROM	TO	FORMATION
1	950-JE-04204/B400-FGS-002	950-JE-042004	B400-FGS-002	6x2x0,75mm2
2	B200-HSB-001/B400-NET-001	B200-HSB-001	B400-NET-001	CAT.6A4x2xAWG23
3	SG-200N1/B400-NET-001.01	SG-200N1	B400-NET-001	CAT.6A4x2xAWG23
4	SG-200N1/B400-NET-001.02	SG-200N1	B400-NET-001	CAT.6A4x2xAWG23
5	SG-200N1/B400-NET-001.03	SG-200N1	B400-NET-001	CAT.6A4x2xAWG23
6	SG-200D2/B400-NET-001	SG-200D2	B400-NET-001	CAT.6A4x2xAWG23
7	HNA6/CN-200N1	HNA6	CN-200N1	FO12OS2
8	C-950-SDZ-04213/950-JE-04204	950-SDZ-04213	950-JE-04204	1x2x0.75 mm2
9	C-950-SDZ-04214/950-JE-04204	950-SDZ-04214	950-JE-04204	1x2x0.75 mm2
10	C-950-SDZ-04215/950-JE-04204	950-SDZ-04215	950-JE-04204	1x2x0.75 mm2

L-SEC-1C-L-150-101-IST-004

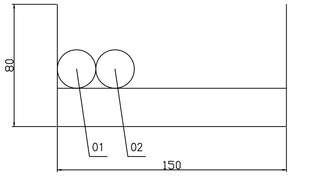

L-SEC-1C-L-150-101-IST-004				
POS	CABLENAME	FROM	TO	FORMATION
1	950-JE-06204/B400-FGS-002	950-JE-06204	B400-FGS-002	6x2x0,75mm2
2	950-JE-04204/B400-FGS-002	950-JE-04204	B400-FGS-002	6x2x0,75mm2

INSERT SUBCONTRACTOR / VENDOR LOGO HERE

REV.	DATE	DRN	CHKD	APPD	DESCRIPTION
03	29/09/25	SPS	LCA	CGI	AS-BUILT (ASB)
02	04/10/24	VBA	LCA	DLO	ACCEPTED FOR CONSTRUCTION (AFC)
01	26/07/24	VBA	LCA	DLO	ACCEPTED FOR CONSTRUCTION (AFC)
00	22/12/23	VBA	LCA	DLO	ISSUE FOR REVIEW (IFR)

CROSSWIND

ROSETTI MARINO

TITLE :
BASE LOAD POWER HUB (BLPH)
INSTRUMENT MAIN CABLE ROUTING-LOWER DECK
TOS EL. TOS EL. 23.310M

CONTRACT NO./TITLE: CW-I-WP4-2023-05/HOLLANDSE KUST NOORD WIND PARK | SCALE: 1:150

DRAWN: SPS | CHECKED: LCA | APPROVED: CGI | DATE: 29/09/25


A1 | DRAWING NO.: 123A90-DDL-IN-DL-40082 | SHEET: 006 | REV.: 03

File Name : 123A90-DDL-IN-DL-40082 REV03.dwg

DRAWING NO.: 123A90-DDL-IN-DL-40082


REV.: 03

L-SEC-1C-L-600-101-IST-002

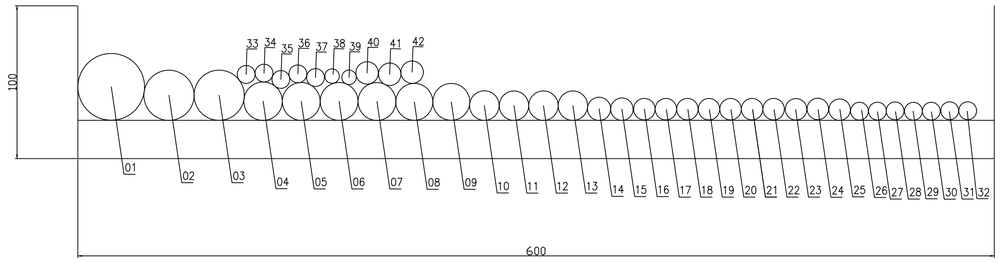


L-SEC-1C-L-600-101-IST-002				
POS	CABLENAME	FROM	TO	FORMATION
1	950-JE-05101/B400-FGS-002	950-JE-05101	B400-FGS-002	12x3x2,5mm2
2	950-JE-06101/B400-FGS-002	950-JE-06101	B400-FGS-002	6x3x2,5mm2
3	950-JE-06201/B400-FGS-002	950-JE-06201	B400-FGS-002	6x3x2,5mm2
4	B100-HSB-001/B400-FGS-002	950-JE-06202	B400-FGS-002	6x2x0,75mm2
5	00-JE-11004/B400-PCS-002	00-JE-11004	B400-PCS-002	12x2x0,75mm2
6	00-JE-12006_1/B400-PCS-002	00-JE-12006_1	B400-PCS-002	12x2x0,75mm2
7	00-JE-12006_2/B400-PCS-002	00-JE-12006_2	B400-PCS-002	12x2x0,75mm2
8	950-JE-05103/B400-FGS-002	950-JE-05103	B400-FGS-002	12x2,5mm2
9	950-JE-06203/B400-FGS-002	950-JE-06203	B400-FGS-002	12x2,5mm2
10	00-JE-11005/B400-PCS-002	00-JE-11005	B400-PCS-002	6x2x0,75mm2
11	P320PLC/B400-FGS-002	P320PLC	B400-FGS-002	2x2x0,75mm2
12	20-UCP-001/B400-FGS-002	20-UCP-001	B400-FGS-002	2x2x0,75mm2
13	P320PLC/B400-SIS-001	P320PLC	B400-SIS-001	2x2x0.75mm2
14	C-B100-TIR-001/B400-PCS-002	B100-TIR-001	B400-PCS-002	2x2x0,75mm2
15	C-950-FDZ-02101/950-JE-02101	950-FDZ-02101	950-JE-02101	3x2,5mm2
16	C-85-XS-001/B400-SIS-001	85-XS-001	B400-SIS-001	2x2,5mm2
17	C-20-XS-001/B400-SIS-001	20-XS-001	B400-SIS-001	2x2,5mm2
18	C-64-XS-001/B400-SIS-001	64-XS-001	B400-SIS-001	2x2,5mm2
19	C-77-XS-001/B400-SIS-001	77-XS-001	B400-SIS-001	2x2,5mm2
20	C-CP-100E1/B400-SIS-001	CP-100E1	B400-SIS-001	2x2,5mm2
21	C-SG-100D1-001/B400-SIS-001	SG-100D1-001	B400-SIS-001	2x2,5mm2
22	C-SG-100D1-002/B400-SIS-001	SG-100D1-002	B400-SIS-001	2x2,5mm2
23	C-SG-100D1-003/B400-SIS-001	SG-100D1-003	B400-SIS-001	2x2,5mm2
24	C-CB-200F1/B400-SIS-001	CB-200F1	B400-SIS-001	2x2,5mm2
25	C-UP-200F1/B400-SIS-001	UP-200F1	B400-SIS-001	2x2,5mm2
26	C-77-XA-001/B400-SIS-001	77-XA-001	B400-SIS-001	1x2x0,75mm2
27	C-20-XA-003/B400-SIS-001	20-XA-003	B400-SIS-001	1x2x0,75mm2
28	C-64-XA-003/B400-SIS-001	64-XA-003	B400-SIS-001	1x2x0,75mm2
29	C-950-MFA-06201/B400-FGS-002	950-MFA-06201	B400-FGS-002	1x2x0,75mm2
30	C-950-ASD-01101/00-JE-22001	950-ASD-01101	00-JE-22001	1x2x0,75mm2
31	C-950-MOB-01101/00-JE-22001	950-MOB-01101	00-JE-22001	1x2x0,75mm2
32	C-950-ESD-01101/00-JE-22001	950-ESD-01101	00-JE-22001	1x2x0,75mm2
33	C-950-ESDD-01101/00-JE-22001	950-ESDD-01101	00-JE-22001	1x2x0,75mm2
34	C-950-ASD-04101/00-JE-22001	950-ASD-04101	00-JE-22001	1x2x0,75mm2
35	C-950-MOB-04101/00-JE-22001	950-MOB-04101	00-JE-22001	1x2x0,75mm2
36	C-950-ESD-04101/00-JE-22001	950-ESD-04101	00-JE-22001	1x2x0,75mm2
37	C-950-ESDD-04101/00-JE-22001	950-ESDD-04101	00-JE-22001	1x2x0,75mm2
38	C-B100-TDC-001/B400-PCS-002	B100-TDC001	B400-PCS-002	1x2x0,75mm2
39	C-B100-TDC-002/B400-PCS-002	B100-TDC002	B400-PCS-002	1x2x0,75mm2
40	C-950-FDZ-04102/950-JE-04101	950-FDZ-04102	950-JE-04101	3x2.5 mm2
41	C-950-FDZ-04103/950-JE-04101	950-FDZ-04103	950-JE-04101	3x2.5 mm2
42	C-950-FDZ-04104/950-JE-04101	950-FDZ-04104	950-JE-04101	3x2.5 mm2

L-SEC-1C-L-600-101-IST-003

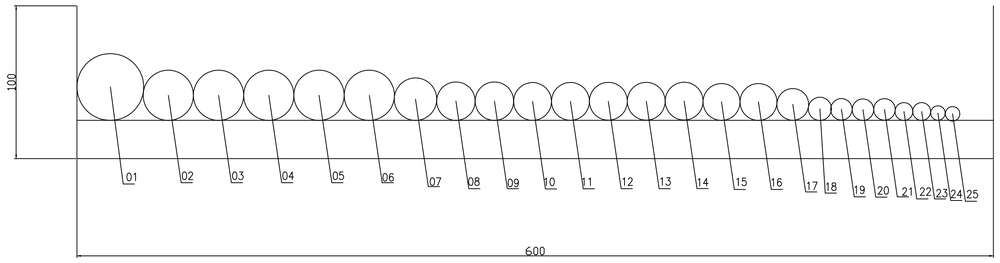


L-SEC-1C-L-600-101-IST-003				
POS	CABLENAME	FROM	TO	FORMATION
1	950-JE-03101/B400-FGS-002	950-JE-03101	B400-FGS-002	12x3x2.5 mm2
2	950-JE-04201/B400-FGS-002	950-JE-04201	B400-FGS-002	6x3x2,5mm2
3	950-JE-02103/B400-FGS-002	950-JE-02103	B400-FGS-002	6x3x2,5mm2
4	00-JE-21002/B400-SIS-001	00-JE-21002	B400-SIS-001	12x2x0,75mm2
5	00-JE-22002_1/B400-SIS-001	00-JE-22002_1	B400-SIS-001	12x2x0,75mm2
6	00-JE-22002_2/B400-SIS-001	00-JE-22002_2	B400-SIS-001	12x2x0,75mm2
7	00-JE-13002/B400-PCS-002	00-JE-13002	B400-PCS-002	24x2,5mm2
8	950-JE-05102/B400-FGS-002	950-JE-05102	B400-FGS-002	6x2x0,75mm2
9	B200-HSB-001/B400-FGS-002	950-JE-04202	B400-FGS-002	6x2x0,75mm2
10	00-JE-11003_1/B400-PCS-002	00-JE-11003_1	B400-PCS-002	12x2x0,75mm2
11	00-JE-11003_2/B400-PCS-002	00-JE-11003_2	B400-PCS-002	12x2x0,75mm2
12	00-JE-12004_1/B400-PCS-002	00-JE-12004_1	B400-PCS-002	12x2x0,75mm2
13	00-JE-12004_2/B400-PCS-002	00-JE-12004_2	B400-PCS-002	12x2x0,75mm2
14	00-JE-12005/B400-PCS-002	00-JE-12005	B400-PCS-002	12x2x0,75mm2
15	00-JE-23002/B400-SIS-001	00-JE-23002	B400-SIS-001	12x2,5mm2
16	950-JE-04203/B400-FGS-002	950-JE-04203	B400-FGS-002	12x2,5mm2
17	00-JE-13003/B400-PCS-002	00-JE-13003	B400-PCS-002	12x2,5mm2
18	C-B200-TIR-001/B400-PCS-002	B200-TIR-001	B400-PCS-002	2x2x0,75mm2
19	C-77-XS-002/B400-SIS-001	77-XS-002	B400-SIS-001	2x2,5mm2
20	C-SG-200N1-001/B400-SIS-001	SG-200N1-001	B400-SIS-001	2x2,5mm2
21	C-SG-200N1-002/B400-SIS-001	SG-200N1-002	B400-SIS-001	2x2,5mm2
22	C-77-XA-002/B400-SIS-001	77-XA-002	B400-SIS-001	1x2x0,75mm2
23	C-950-MFA-04203/B400-FGS-002	950-MFA-04203	B400-FGS-002	1x2x0,75mm2
24	C-B200-TDC-001/B400-PCS-002	B200-TD001	B400-PCS-002	1x2x0,75mm2
25	C-B200-TDC-002/B400-PCS-002	B200-TD002	B400-PCS-002	1x2x0,75mm2

L-SEC-1D-L-200-101-TLT-001

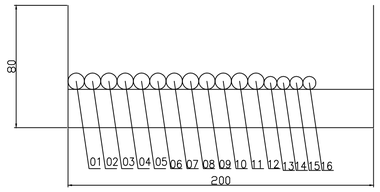

L-SEC-1D-L-200-101-TLT-001				
POS	CABLENAME	FROM	TO	FORMATION
1	TR-100AD1AVR/B400-NET-001	TR-100AD1AVR	B400-NET-001	CAT.6A4x2xAWG23
2	B100-HSB-001/B400-NET-001	B100-HSB-001	B400-NET-001	CAT.6A4x2xAWG23
3	SG-100D1/B400-NET-001.01	SG-100D1	B400-NET-001	CAT.6A4x2xAWG23
4	SG-100D1/B400-NET-001.02	SG-100D1	B400-NET-001	CAT.6A4x2xAWG23
5	SG-100D1/B400-NET-001.03	SG-100D1	B400-NET-001	CAT.6A4x2xAWG23
6	UP-200F1/B400-NET-001.01	UP-200F1	B400-NET-001	CAT.6A4x2xAWG23
7	UP-200F1/B400-NET-001.02	UP-200F1	B400-NET-001	CAT.6A4x2xAWG23
8	P320PLC/B400-NET-001.01	P320PLC	B400-NET-001	CAT.6A4x2xAWG23
9	P320PLC/B400-NET-001.02	P320PLC	B400-NET-001	CAT.6A4x2xAWG23
10	20-UCP-001/B400-NET-001.01	20-UCP-001	B400-NET-001	CAT.6A4x2xAWG23
11	20-UCP-001/B400-NET-001.02	20-UCP-001	B400-NET-001	CAT.6A4x2xAWG23
12	64-LP-001/B400-NET-001	64-LP-001	B400-NET-001	CAT.6A4x2xAWG23
13	CP-100E1/B400-NET-001.01	CP-100E1	B400-NET-001	FO12OM2
14	CP-100E1/B400-NET-001.02	CP-100E1	B400-NET-001	FO12OM2
15	HNA6/B400-NET-001	HNA6	B400-NET-001	FO12OS2
16	HNA6/CN-200N1	HNA6	CN-200N1	FO12OS2

L-SEC-5-L-200-101-IST-033

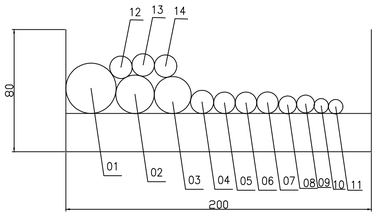

L-SEC-5-L-200-101-IST-033				
POS	CABLENAME	FROM	TO	FORMATION
1	950-JE-04201/B400-FGS-002	950-JE-042001	B400-FGS-002	6x3x2,5mm2
2	B200-HSB-001/B400-FGS-002	950-JE-042002	B400-FGS-002	6x2x0,75mm2
3	950-JE-04203/B400-FGS-002	950-JE-042003	B400-FGS-002	12x2,5mm2
4	C-B200-TIR-001/B400-PCS-002	B200-TIR-001	B400-FGS-002	2x2x0,75mm2
5	C-77-XS-002/B400-SIS-001	C-77-XS-002	B400-SIS-001	2x2,5mm2
6	C-SG-200N1-001/B400-SIS-001	SG-200N1-001	B400-SIS-001	2x2,5mm2
7	C-SG-200N1-002/B400-SIS-001	SG-200N1-002	B400-SIS-001	2x2,5mm2
8	C-77-XA-002/B400-SIS-001	C-77-XA-002	B400-SIS-001	1x2x0,75mm2
9	C-950-MFA-04203/B400-FGS-002	950-MFA-04203	B400-FGS-002	1x2x0,75mm2
10	C-B200-TDC-001/B400-PCS-002	C-B200-TDC-001	B400-PCS-002	1x2x0,75mm2
11	C-B200-TDC-002/B400-PCS-002	C-B200-TDC-002	B400-PCS-002	1x2x0,75mm2
12	C-950-GDZ-04213/950-JE-04201	950-GDZ-04213	950-JE-04201	3x2.5 mm2
13	C-950-GDZ-04214/950-JE-04201	950-GDZ-04214	950-JE-04201	3x2.5 mm2
14	C-950-GDZ-04215/950-JE-04201	950-GDZ-04215	950-JE-04201	3x2.5 mm2

INSERT SUBCONTRACTOR / VENDOR LOGO HERE

REV.	DATE	DRN	CHKD	APPD	DESCRIPTION
03	29/09/25	SPS	LCA	CGI	AS–BUILT (ASB)
02	04/10/24	VBA	LCA	DLO	ACCEPTED FOR CONSTRUCTION (AFC)
01	26/07/24	VBA	LCA	DLO	ACCEPTED FOR CONSTRUCTION (AFC)
00	22/12/23	VBA	LCA	DLO	ISSUE FOR REVIEW (IFR)

CROSSWIND

ROSETTI MARINO

TITLE :

BASE LOAD POWER HUB (BLPH)
INSTRUMENT MAIN CABLE ROUTING–LOWER DECK
TOS EL. TOS EL. 23.310M

CONTRACT NO./TITLE CW-I-WP4-2023-05/HOLLANDSE KUST NOORD WIND PARK | SCALE 1:150

DRAWN SPS | CHECKED LCA | APPROVED CGI | DATE 29/09/25


A1 | DRAWING NO. 123A90–DDL–IN–DL–40082 | SHEET 007 | REV. 03

File Name : 123A90-DDL-IN-DL-40082 REV.03.dwg

DRAWING NO. 123A90-DDL-IN-DL-40082


REV. 03

L-SEC-1D-L-600-101-IST-002

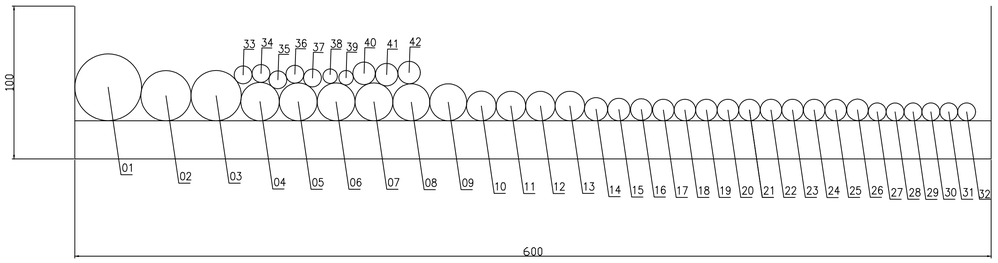


L-SEC-1D-L-600-101-IST-002				
POS	CABLENAME	FROM	TO	FORMATION
1	950-JE-05101/B400-FGS-002	950-JE-05101	B400-FGS-002	12x3x2,5mm2
2	950-JE-06101/B400-FGS-002	950-JE-06101	B400-FGS-002	6x3x2,5mm2
3	950-JE-06201/B400-FGS-002	950-JE-06201	B400-FGS-002	6x3x2,5mm2
4	B100-HSB-001/B400-FGS-002	950-JE-06202	B400-FGS-002	6x2x0,75mm2
5	00-JE-11004/B400-PCS-002	00-JE-11004	B400-PCS-002	12x2x0,75mm2
6	00-JE-12006_1/B400-PCS-002	00-JE-12006_1	B400-PCS-002	12x2x0,75mm2
7	00-JE-12006_2/B400-PCS-002	00-JE-12006_2	B400-PCS-002	12x2x0,75mm2
8	950-JE-05103/B400-FGS-002	950-JE-05103	B400-FGS-002	12x2,5mm2
9	950-JE-06203/B400-FGS-002	950-JE-06203	B400-FGS-002	12x2,5mm2
10	00-JE-11005/B400-PCS-002	00-JE-11005	B400-PCS-002	6x2x0,75mm2
11	P320PLC/B400-FGS-002	P320PLC	B400-FGS-002	2x2x0,75mm2
12	20-UCP-001/B400-FGS-002	20-UCP-001	B400-FGS-002	2x2x0,75mm2
13	P320PLC/B400-SIS-001	P320PLC	B400-SIS-001	2x2x0,75mm2
14	C-B100-TIR-001/B400-PCS-002	B100-TIR-001	B400-PCS-002	2x2x0,75mm2
15	C-950-FDZ-02101/950-JE-02101	950-FDZ-02101	950-JE-02101	3x2.5mm2
16	C-85-XS-001/B400-SIS-001	85-XS-001	B400-SIS-001	2x2,5mm2
17	C-20-XS-001/B400-SIS-001	20-XS-001	B400-SIS-001	2x2,5mm2
18	C-64-XS-001/B400-SIS-001	64-XS-001	B400-SIS-001	2x2,5mm2
19	C-77-XS-001/B400-SIS-001	77-XS-001	B400-SIS-001	2x2,5mm2
20	C-CP-100E1/B400-SIS-001	CP-100E1	B400-SIS-001	2x2,5mm2
21	C-SG-100D1-001/B400-SIS-001	SG-100D1-001	B400-SIS-001	2x2,5mm2
22	C-SG-100D1-002/B400-SIS-001	SG-100D1-002	B400-SIS-001	2x2,5mm2
23	C-SG-100D1-003/B400-SIS-001	SG-100D1-003	B400-SIS-001	2x2,5mm2
24	C-CB-200F1/B400-SIS-001	CB-200F1	B400-SIS-001	2x2,5mm2
25	C-UP-200F1/B400-SIS-001	UP-200F1	B400-SIS-001	2x2,5mm2
26	C-77-XA-001/B400-SIS-001	77-XA-001	B400-SIS-001	1x2x0,75mm2
27	C-20-XA-003/B400-SIS-001	20-XA-003	B400-SIS-001	1x2x0,75mm2
28	C-64-XA-003/B400-SIS-001	64-XA-003	B400-SIS-001	1x2x0,75mm2
29	C-950-MFA-06201/B400-FGS-002	950-MFA-06201	B400-FGS-002	1x2x0,75mm2
30	C-950-ASD-01101/00-JE-22001	950-ASD-01101	00-JE-22001	1x2x0,75mm2
31	C-950-MOB-01101/00-JE-22001	950-MOB-01101	00-JE-22001	1x2x0,75mm2
32	C-950-ESD-01101/00-JE-22001	950-ESD-01101	00-JE-22001	1x2x0,75mm2
33	C-950-ESDD-01101/00-JE-22001	950-ESDD-01101	00-JE-22001	1x2x0,75mm2
34	C-950-ASD-04101/00-JE-22001	950-ASD-04101	00-JE-22001	1x2x0,75mm2
35	C-950-MOB-04101/00-JE-22001	950-MOB-04101	00-JE-22001	1x2x0,75mm2
36	C-950-ESD-04101/00-JE-22001	950-ESD-04101	00-JE-22001	1x2x0,75mm2
37	C-950-ESDD-04101/00-JE-22001	950-ESDD-04101	00-JE-22001	1x2x0,75mm2
38	C-B100-TDC-001/B400-PCS-002	B100-TDC001	B400-PCS-002	1x2x0,75mm2
39	C-B100-TDC-002/B400-PCS-002	B100-TDC002	B400-PCS-002	1x2x0,75mm2
40	C-950-FDZ-04102/950-JE-04101	950-FDZ-04102	950-JE-04101	3x2.5 mm2
41	C-950-FDZ-04103/950-JE-04101	950-FDZ-04103	950-JE-04101	3x2.5 mm2
42	C-950-FDZ-04104/950-JE-04101	950-FDZ-04104	950-JE-04101	3x2.5 mm2

L-SEC-1D-L-600-101-IST-003

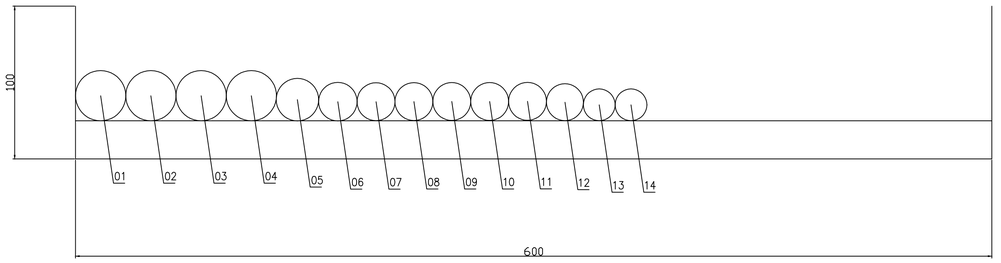


L-SEC-1D-L-600-101-IST-003				
POS	CABLENAME	FROM	TO	FORMATION
1	950-JE-03101/B400-FGS-002	950-JE-03101	B400-FGS-002	12x3x2.5 mm2
2	950-JE-02103/B400-FGS-002	950-JE-02103	B400-FGS-002	6x3x2,5mm2
3	00-JE-21002/B400-SIS-001	00-JE-21002	B400-SIS-001	12x2x0,75mm2
4	00-JE-22002_1/B400-SIS-001	00-JE-22002_1	B400-SIS-001	12x2x0,75mm2
5	00-JE-22002_2/B400-SIS-001	00-JE-22002_2	B400-SIS-001	12x2x0,75mm2
6	00-JE-13002/B400-PCS-002	00-JE-13002	B400-PCS-002	24x2,5mm2
7	950-JE-05102/B400-FGS-002	950-JE-05102	B400-FGS-002	6x2x0,75mm2
8	00-JE-11003_1/B400-PCS-002	00-JE-11003_1	B400-PCS-002	12x2x0,75mm2
9	00-JE-11003_2/B400-PCS-002	00-JE-11003_2	B400-PCS-002	12x2x0,75mm2
10	00-JE-12004_1/B400-PCS-002	00-JE-12004_1	B400-PCS-002	12x2x0,75mm2
11	00-JE-12004_2/B400-PCS-002	00-JE-12004_2	B400-PCS-002	12x2x0,75mm2
12	00-JE-12005/B400-PCS-002	00-JE-12005	B400-PCS-002	12x2x0,75mm2
13	00-JE-23002/B400-SIS-001	00-JE-23002	B400-SIS-001	12x2,5mm2
14	00-JE-13003/B400-PCS-002	00-JE-13003	B400-PCS-002	12x2,5mm2

L-SEC-1E-L-200-101-TLT-001

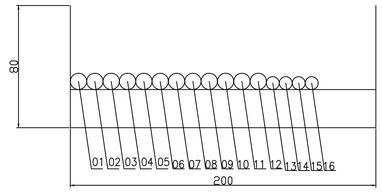


L-SEC-1E-L-200-101-TLT-001				
POS	CABLENAME	FROM	TO	FORMATION
1	TR-100AD1AVR/B400-NET-001	TR-100AD1AVR	B400-NET-001	CAT.6A4x2xAWG23
2	B100-HSB-001/B400-NET-001	B100-HSB-001	B400-NET-001	CAT.6A4x2xAWG23
3	SG-100D1/B400-NET-001.01	SG-100D1	B400-NET-001	CAT.6A4x2xAWG23
4	SG-100D1/B400-NET-001.02	SG-100D1	B400-NET-001	CAT.6A4x2xAWG23
5	SG-100D1/B400-NET-001.03	SG-100D1	B400-NET-001	CAT.6A4x2xAWG23
6	UP-200F1/B400-NET-001.01	UP-200F1	B400-NET-001	CAT.6A4x2xAWG23
7	UP-200F1/B400-NET-001.02	UP-200F1	B400-NET-001	CAT.6A4x2xAWG23
8	P320PLC/B400-NET-001.01	P320PLC	B400-NET-001	CAT.6A4x2xAWG23
9	P320PLC/B400-NET-001.02	P320PLC	B400-NET-001	CAT.6A4x2xAWG23
10	20-UCP-001/B400-NET-001.01	20-UCP-001	B400-NET-001	CAT.6A4x2xAWG23
11	20-UCP-001/B400-NET-001.02	20-UCP-001	B400-NET-001	CAT.6A4x2xAWG23
12	64-LP-001/B400-NET-001	64-LP-001	B400-NET-001	CAT.6A4x2xAWG23
13	CP-100E1/B400-NET-001.01	CP-100E1	B400-NET-001	FO12OM2
14	CP-100E1/B400-NET-001.02	CP-100E1	B400-NET-001	FO12OM2
15	HNA6/B400-NET-001	HNA6	B400-NET-001	FO12OS2
16	HNA6/CN-200N1	HNA6	CN-200N1	FO12OS2

L-SEC-1D-L-150-101-IST-004

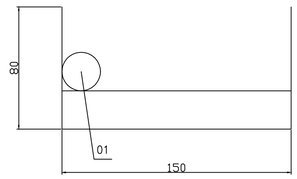

L-SEC-1D-L-150-101-IST-004				
POS	CABLENAME	FROM	TO	FORMATION
1	950-JE-06204/B400-FGS-002	950-JE-06204	B400-FGS-002	6x2x0,75mm2

L-SEC-1E-L-150-101-IST-004

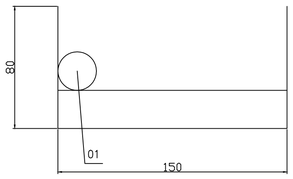

L-SEC-1E-L-150-101-IST-004				
POS	CABLENAME	FROM	TO	FORMATION
1	950-JE-06204/B400-FGS-002	950-JE-06204	B400-FGS-002	6x2x0.75 mm2

INSERT SUBCONTRACTOR / VENDOR LOGO HERE

REV.	DATE	DRN	CHKD	APPD	DESCRIPTION
03	29/09/25	SPS	LCA	CGI	AS-BUILT (ASB)
02	04/10/24	VBA	LCA	DLO	ACCEPTED FOR CONSTRUCTION (AFC)
01	26/07/24	VBA	LCA	DLO	ACCEPTED FOR CONSTRUCTION (AFC)
00	22/12/23	VBA	LCA	DLO	ISSUE FOR REVIEW (IFR)

CROSSWIND

ROSETTI MARINO

TITLE :
BASE LOAD POWER HUB (BLPH)
INSTRUMENT MAIN CABLE ROUTING-LOWER DECK
TOS EL. TOS EL. 23.310M


CONTRACT NO./TITLE CW-I-WP4-2023-05/HOLLANDSE KUST NOORD WIND PARK			SCALE 1:150
DRAWN SPS	CHECKED LCA	APPROVED CGI	DATE 29/09/25
A1	DRAWING NO. 123A90-DDL-IN-DL-40082	SHEET 008	REV. 03

File Name : 123A90-DDL-IN-DL-40082 REV-03.dwg

DRAWING NO. 123A90-DDL-IN-DL-40082


REV. 03

L-SEC-1E-L-600-101-IST-002

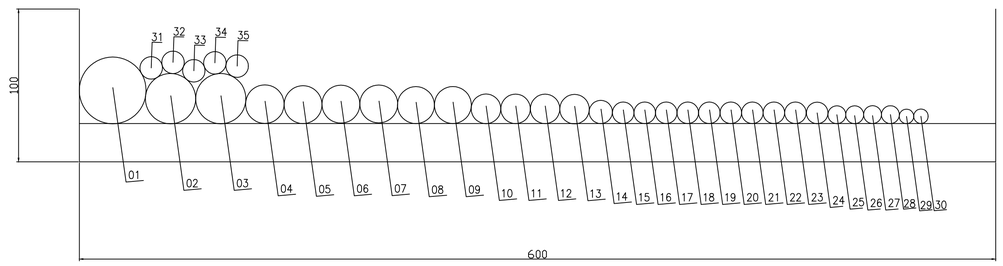


L-SEC-1E-L-600-101-IST-002				
POS	CABLENAME	FROM	TO	FORMATION
1	950-JE-05101/B400-FGS-002	950-JE-05101	B400-FGS-002	12x3x2,5mm2
2	950-JE-06101/B400-FGS-002	950-JE-06101	B400-FGS-002	6x3x2,5mm2
3	950-JE-06201/B400-FGS-002	950-JE-06201	B400-FGS-002	6x3x2,5mm2
4	B100-HSB-001/B400-FGS-002	950-JE-06202	B400-FGS-002	6x2x0,75mm2
5	00-JE-11004/B400-PCS-002	00-JE-11004	B400-PCS-002	12x2x0,75mm2
6	00-JE-12006_1/B400-PCS-002	00-JE-12006_1	B400-PCS-002	12x2x0,75mm2
7	00-JE-12006_2/B400-PCS-002	00-JE-12006_2	B400-PCS-002	12x2x0,75mm2
8	950-JE-05103/B400-FGS-002	950-JE-05103	B400-FGS-002	12x2,5mm2
9	950-JE-06203/B400-FGS-002	950-JE-06203	B400-FGS-002	12x2,5mm2
10	00-JE-11005/B400-PCS-002	00-JE-11005	B400-PCS-002	6x2x0,75mm2
11	P320PLC/B400-FGS-002	P320PLC	B400-FGS-002	2x2x0,75mm2
12	20-UCP-001/B400-FGS-002	20-UCP-001	B400-FGS-002	2x2x0,75mm2
13	P320PLC/B400-SIS-001	P320PLC	B400-SIS-001	2x2x0.75mm2
14	C-B100-TIR-001/B400-PCS-002	B100-TIR-001	B400-PCS-002	2x2x0,75mm2
15	C-85-XS-001/B400-SIS-001	85-XS-001	B400-SIS-001	2x2,5mm2
16	C-20-XS-001/B400-SIS-001	20-XS-001	B400-SIS-001	2x2,5mm2
17	C-64-XS-001/B400-SIS-001	64-XS-001	B400-SIS-001	2x2,5mm2
18	C-77-XS-001/B400-SIS-001	77-XS-001	B400-SIS-001	2x2,5mm2
19	C-CP-100E1/B400-SIS-001	CP-100E1	B400-SIS-001	2x2,5mm2
20	C-SG-100D1-001/B400-SIS-001	SG-100D1-001	B400-SIS-001	2x2,5mm2
21	C-SG-100D1-002/B400-SIS-001	SG-100D1-002	B400-SIS-001	2x2,5mm2
22	C-SG-100D1-003/B400-SIS-001	SG-100D1-003	B400-SIS-001	2x2,5mm2
23	C-CB-200F1/B400-SIS-001	CB-200F1	B400-SIS-001	2x2,5mm2
24	C-UP-200F1/B400-SIS-001	UP-200F1	B400-SIS-001	2x2,5mm2
25	C-77-XA-001/B400-SIS-001	77-XA-001	B400-SIS-001	1x2x0,75mm2
26	C-20-XA-003/B400-SIS-001	20-XA-003	B400-SIS-001	1x2x0,75mm2
27	C-64-XA-003/B400-SIS-001	64-XA-003	B400-SIS-001	1x2x0,75mm2
28	C-950-MFA-06201/B400-FGS-002	950-MFA-06201	B400-FGS-002	1x2x0,75mm2
29	C-B100-TDC-001/B400-PCS-002	B100-TDC001	B400-PCS-002	1x2x0,75mm2
30	C-B100-TDC-002/B400-PCS-002	B100-TDC002	B400-PCS-002	1x2x0,75mm2
31	C-950-FDZ-04103/950-JE-04101	950-FDZ-04103	950-JE-04101	3x2.5 mm2
32	C-950-FDZ-04104/950-JE-04101	950-FDZ-04104	950-JE-04101	3x2.5 mm2
33	C-950-FDZ-05101/950-JE-05101	950-FDZ-05101	950-JE-05101	3x2.5 mm2
34	C-950-FDZ-05103/950-JE-05101	950-FDZ-05103	950-JE-05101	3x2.5 mm2
35	C-950-GDZ-05101/950-JE-05101	950-GDZ-05101	950-JE-05101	3x2.5 mm2

L-SEC-1E-L-600-101-IST-003

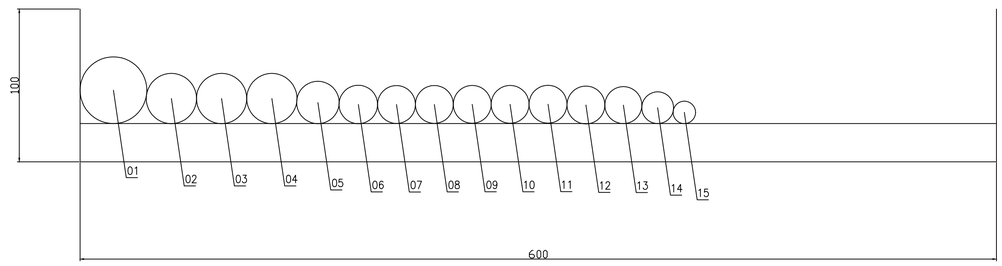


L-SEC-1E-L-600-101-IST-003				
POS	CABLENAME	FROM	TO	FORMATION
1	950-JE-03101/B400-FGS-002	950-JE-03101	400-FGS-002	12x3x2.5 mm2
2	950-JE-02103/B400-FGS-002	950-JE-02103	B400-FGS-002	6x3x2,5mm2
3	00-JE-21002/B400-SIS-001	00-JE-21002	B400-SIS-001	12x2x0,75mm2
4	00-JE-22002_1/B400-SIS-001	00-JE-22002_1	B400-SIS-001	12x2x0,75mm2
5	00-JE-22002_2/B400-SIS-001	00-JE-22002_2	B400-SIS-001	12x2x0,75mm2
6	00-JE-13002/B400-PCS-002	00-JE-13002	B400-PCS-002	24x2,5mm2
7	950-JE-05102/B400-FGS-002	950-JE-05102	B400-FGS-002	6x2x0,75mm2
8	00-JE-11003_1/B400-PCS-002	00-JE-11003_1	B400-PCS-002	12x2x0,75mm2
9	00-JE-11003_2/B400-PCS-002	00-JE-11003_2	B400-PCS-002	12x2x0,75mm2
10	00-JE-12004_1/B400-PCS-002	00-JE-12004_1	B400-PCS-002	12x2x0,75mm2
11	00-JE-12004_2/B400-PCS-002	00-JE-12004_2	B400-PCS-002	12x2x0,75mm2
12	00-JE-12005/B400-PCS-002	00-JE-12005	B400-PCS-002	12x2x0,75mm2
13	00-JE-23002/B400-SIS-001	00-JE-23002	B400-SIS-001	12x2,5mm2
14	00-JE-13003/B400-PCS-002	00-JE-13003	B400-PCS-002	12x2,5mm2
15	C-950-FDZ-02102/950-JE-02101	950-FDZ-02102	950-JE-02101	3x2.5 mm2

L-SEC-6-L-300-101-IST-028

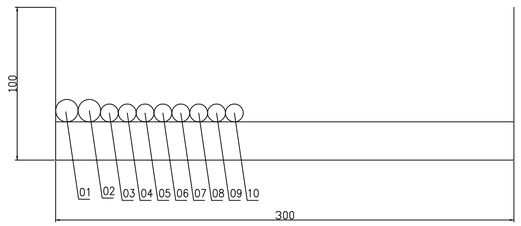


L-SEC-6-L-300-101-IST-028				
POS	CABLENAME	FROM	TO	FORMATION
1	C-950-FDZ-02101/950-JE-02101	C-950-FDZ-02101	950-JE-02101	3x2.5mm2
2	C-950-FDZ-02102/950-JE-02101	C-950-FDZ-02102	950-JE-02101	3x2.5mm2
3	C-950-ASD-01101/00-JE-22001	950-ASD-01101	00-JE-22001	1x2x0,75mm2
4	C-950-MOB-01101/00-JE-22001	950-MOB-01101	00-JE-22001	1x2x0,75mm2
5	C-950-ESD-01101/00-JE-22001	950-ESD-01101	00-JE-22001	1x2x0,75mm2
6	C-950-ESDD-01101/00-JE-22001	950-ESDD-01101	00-JE-22001	1x2x0,75mm2
7	C-950-ASD-04101/00-JE-22001	950-ASD-04101	00-JE-22001	1x2x0,75mm2
8	C-950-MOB-04101/00-JE-22001	950-MOB-04101	00-JE-22001	1x2x0,75mm2
9	C-950-ESD-04101/00-JE-22001	950-ESD-04101	00-JE-22001	1x2x0,75mm2
10	C-950-ESDD-04101/00-JE-22001	950-ESDD-04101	00-JE-22001	1x2x0,75mm2

L-SEC-8-L-150-101-IST-038

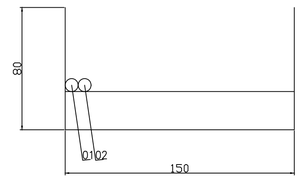


L-SEC-8-L-150-101-IST-038				
POS	CABLENAME	FROM	TO	FORMATION
1	HNA6/B400-NET-001	HNA6	B400-NET-001	FO12OS2
2	HNA6/CN-200N1	HNA6	CN-200N1	FO12OS2

L-SEC-7-L-150-101-IST-013

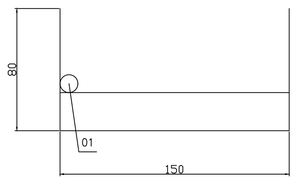

L-SEC-7-L-100-101-IST-013				
POS	CABLENAME	FROM	TO	FORMATION
1	C-55-LIT-001/00-JE-11005	55-LIT-001	00-JE-11005	1x2x0,75mm2

L-SEC-7-L-150-101-IST-012

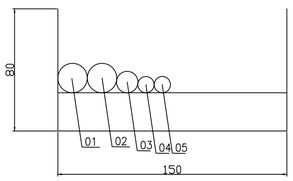

L-SEC-7-L-100-101-IST-012				
POS	CABLENAME	FROM	TO	FORMATION
1	P320PLC/B400-FGS-002	P320PLC	B400-FGS-002	2x2x0.75mm2
2	C-85-XS-001/B400-SIS-001	85-XS-001	B400-SIS-001	2x2.5mm2
3	P320PLC/B400-NET-001.01	P320PLC	B400-NET-001.01	CAT.6A4x2xAWG23
4	P320PLC/B400-NET-001.02	P320PLC	B400-NET-001.02	CAT.6A4x2xAWG23
5	P320PLC/B400-SIS-001	P320PLC	B400-SIS-001	2x2x0.75mm2

INSERT SUBCONTRACTOR / VENDOR LOGO HERE

REV.	DATE	DRN	CHKD	APPD	DESCRIPTION
03	29/09/25	SPS	LCA	CGI	AS-BUILT (ASB)
02	04/10/24	VBA	LCA	DLO	ACCEPTED FOR CONSTRUCTION (AFC)
01	26/07/24	VBA	LCA	DLO	ACCEPTED FOR CONSTRUCTION (AFC)
00	22/12/23	VBA	LCA	DLO	ISSUE FOR REVIEW (IFR)

CROSSWIND

ROSETTI MARINO

TITLE :
BASE LOAD POWER HUB (BLPH)
INSTRUMENT MAIN CABLE ROUTING-LOWER DECK
TOS EL. TOS EL. 23.310M


CONTRACT NO./TITLE	CW-I-WP4-2023-05/HOLLANDSE KUST NOORD WIND PARK		SCALE	1:150
DRAWN SPS	CHECKED LCA	APPROVED CGI	DATE	29/09/25
A1	DRAWING NO. 123A90-DDL-IN-DL-40082		SHEET 009	REV. 03

File Name : 123A90-DDL-IN-DL-40082 REV03.dwg

DRAWING NO. 123A90-DDL-IN-DL-40082


REV. 03

L-SEC-1F-L-600-101-IST-002

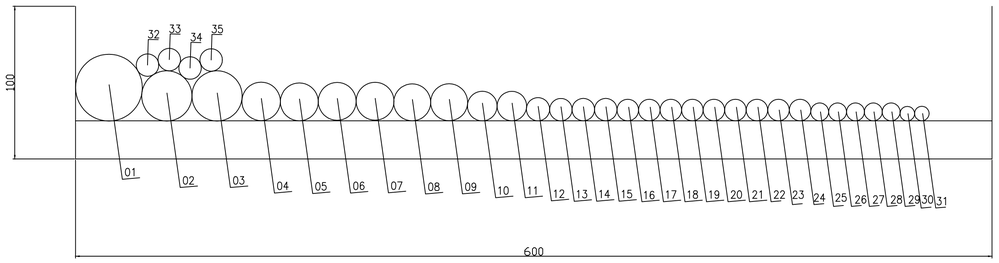


L-SEC-1F-L-600-101-IST-002				
POS	CABLENAME	FROM	TO	FORMATION
1	950-JE-05101/B400-FGS-002	950-JE-05101	B400-FGS-002	12x3x2,5mm2
2	950-JE-06101/B400-FGS-002	950-JE-06101	B400-FGS-002	6x3x2,5mm2
3	950-JE-06201/B400-FGS-002	950-JE-06201	B400-FGS-002	6x3x2,5mm2
4	B100-HSB-001/B400-FGS-002	950-JE-06202	B400-FGS-002	6x2x0,75mm2
5	00-JE-11004/B400-PCS-002	00-JE-11004	B400-PCS-002	12x2x0,75mm2
6	00-JE-12006_1/B400-PCS-002	00-JE-12006_1	B400-PCS-002	12x2x0,75mm2
7	00-JE-12006_2/B400-PCS-002	00-JE-12006_2	B400-PCS-002	12x2x0,75mm2
8	950-JE-05103/B400-FGS-002	950-JE-05103	B400-FGS-002	12x2,5mm2
9	950-JE-06203/B400-FGS-002	950-JE-06203	B400-FGS-002	12x2,5mm2
10	00-JE-11005/B400-PCS-002	00-JE-11005	B400-PCS-002	6x2x0,75mm2
11	20-UCP-001/B400-FGS-002	20-UCP-001	B400-FGS-002	2x2x0,75mm2
12	C-B100-TIR-001/B400-PCS-002	B100-TIR-001	B400-PCS-002	2x2x0,75mm2
13	C-950-FDZ-05101/950-JE-05101	950-FDZ-05101	950-JE-05101	3x2,5mm2
14	C-950-GDZ-05104/950-JE-05101	950-GDZ-05104	950-JE-05101	3x2,5mm2
15	C-950-GDZ-05105/950-JE-05101	950-GDZ-05105	950-JE-05101	3x2,5mm2
16	C-20-XS-001/B400-SIS-001	20-XS-001	B400-SIS-001	2x2,5mm2
17	C-64-XS-001/B400-SIS-001	64-XS-001	B400-SIS-001	2x2,5mm2
18	C-77-XS-001/B400-SIS-001	77-XS-001	B400-SIS-001	2x2,5mm2
19	C-CP-100E1/B400-SIS-001	CP-100E1	B400-SIS-001	2x2,5mm2
20	C-SG-100D1-001/B400-SIS-001	SG-100D1-001	B400-SIS-001	2x2,5mm2
21	C-SG-100D1-002/B400-SIS-001	SG-100D1-002	B400-SIS-001	2x2,5mm2
22	C-SG-100D1-003/B400-SIS-001	SG-100D1-003	B400-SIS-001	2x2,5mm2
23	C-CB-200F1/B400-SIS-001	CB-200F1	B400-SIS-001	2x2,5mm2
24	C-UP-200F1/B400-SIS-001	UP-200F1	B400-SIS-001	2x2,5mm2
25	C-77-XA-001/B400-SIS-001	77-XA-001	B400-SIS-001	1x2x0,75mm2
26	C-20-XA-003/B400-SIS-001	20-XA-003	B400-SIS-001	1x2x0,75mm2
27	C-64-XA-003/B400-SIS-001	64-XA-003	B400-SIS-001	1x2x0,75mm2
28	C-950-MFA-06201/B400-FGS-002	950-MFA-06201	B400-FGS-002	1x2x0,75mm2
29	C-55-LIT-001/00-JE-11005	55-LIT-001	00-JE-11005	1x2x0,75mm2
30	C-B100-TDC-001/B400-PCS-002	B100-TDC001	B400-PCS-002	1x2x0,75mm2
31	C-B100-TDC-002/B400-PCS-002	B100-TDC002	B400-PCS-002	1x2x0,75mm2
32	C-950-FDZ-04103/950-JE-04101	950-FDZ-04103	950-JE-04101	3x2.5 mm2
33	C-950-FDZ-04104/950-JE-04101	950-FDZ-04104	950-JE-04101	3x2.5 mm2
34	C-950-GDZ-05101/950-JE-05101	950-GDZ-05101	950-JE-05101	3x2.5 mm2
35	C-950-GDZ-05102/950-JE-05101	950-GDZ-05102	950-JE-05101	3x2.5 mm2

L-SEC-1F-L-600-101-IST-003

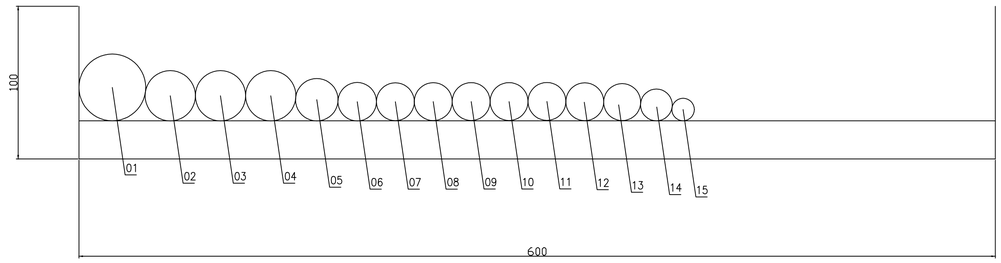


L-SEC-1F-L-600-101-IST-003				
POS	CABLENAME	FROM	TO	FORMATION
1	950-JE-03101/B400-FGS-002	950-JE-03101	400-FGS-002	12x3x2.5 mm2
2	950-JE-02103/B400-FGS-002	950-JE-02103	B400-FGS-002	6x3x2,5mm2
3	00-JE-21002/B400-SIS-001	00-JE-21002	B400-SIS-001	12x2x0,75mm2
4	00-JE-22002_1/B400-SIS-001	00-JE-22002_1	B400-SIS-001	12x2x0,75mm2
5	00-JE-22002_2/B400-SIS-001	00-JE-22002_2	B400-SIS-001	12x2x0,75mm2
6	00-JE-13002/B400-PCS-002	00-JE-13002	B400-PCS-002	24x2,5mm2
7	950-JE-05102/B400-FGS-002	950-JE-05102	B400-FGS-002	6x2x0,75mm2
8	00-JE-11003_1/B400-PCS-002	00-JE-11003_1	B400-PCS-002	12x2x0,75mm2
9	00-JE-11003_2/B400-PCS-002	00-JE-11003_2	B400-PCS-002	12x2x0,75mm2
10	00-JE-12004_1/B400-PCS-002	00-JE-12004_1	B400-PCS-002	12x2x0,75mm2
11	00-JE-12004_2/B400-PCS-002	00-JE-12004_2	B400-PCS-002	12x2x0,75mm2
12	00-JE-12005/B400-PCS-002	00-JE-12005	B400-PCS-002	12x2x0,75mm2
13	00-JE-23002/B400-SIS-001	00-JE-23002	B400-SIS-001	12x2,5mm2
14	00-JE-13003/B400-PCS-002	00-JE-13003	B400-PCS-002	12x2,5mm2
15	C-950-FDZ-02102/950-JE-02101	950-FDZ-02102	950-JE-02101	3x2.5 mm2

L-SEC-9-L-200-101-IST-022

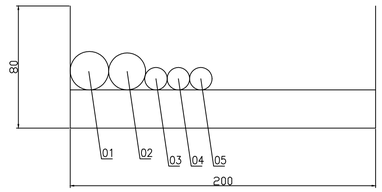


L-SEC-9-L-200-101-IST-022				
POS	CABLENAME	FROM	TO	FORMATION
1	950-JE-05103/B400-FGS-002	950-JE-05103	B400-FGS-002	12x2,5mm2
2	950-JE-05102/B400-FGS-002	950-JE-051002	B400-FGS-002	6x2x0,75mm2
3	C-950-FDZ-01104/950-JE-01101	950-FDZ-01104	950-JE-01101	3x2.5 mm2
4	C-950-FDZ-02102/950-JE-02101	950-FDZ-02102	950-JE-02101	3x2.5 mm2
5	C-950-FDZ-06102/950-JE-06101	950-FDZ-06102	950-JE-06101	3x2.5 mm2

L-SEC-10-L-150-101-IST-039

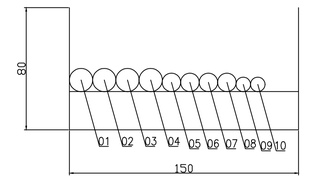


L-SEC-10-L-150-101-IST-039				
POS	CABLENAME	FROM	TO	FORMATION
1	C-50-XV-001/00-JE-12006	50-XV-001	00-JE-12006	2x2x0.75mm2
2	C-50-XV-002/00-JE-12006	50-XV-002	00-JE-12006	2x2x0.75mm2
3	C-50-XV-003/00-JE-12006	50-XV-003	00-JE-12006	2x2x0.75mm2
4	C-50-XV-004/00-JE-12006	50-XV-004	00-JE-12006	2x2x0.75mm2
5	C-50-XY-001/00-JE-13003	50-XY-001	00-JE-13003	2x2.5mm2
6	C-50-XY-002/00-JE-13003	50-XY-002	00-JE-13003	2x2.5mm2
7	C-50-XY-003/00-JE-13003	50-XY-003	00-JE-13003	2x2.5mm2
8	C-50-XY-004/00-JE-13003	50-XY-004	00-JE-13003	2x2.5mm2
9	C-50-PT-001/00-JE-11004	50-PT-001	00-JE-11004	1x2x0.75mm2
10	C-50-PT-002/00-JE-11004	50-PT-002	00-JE-11004	1x2x0.75mm2

L-SEC-1G-L-150-101-IST-004

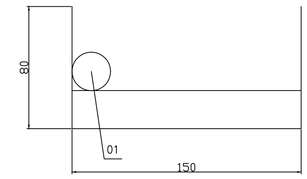


L-SEC-1G-L-150-101-IST-004				
POS	CABLENAME	FROM	TO	FORMATION
1	950-JE-06204/B400-FGS-002	950-JE-06204	B400-FGS-002	6x2x0.75 mm2

L-SEC-1F-L-200-101-TLT-001

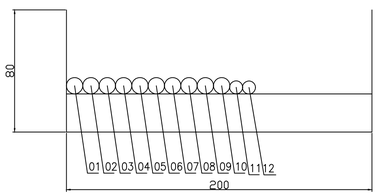

L-SEC-1F-L-200-101-TLT-001				
POS	CABLENAME	FROM	TO	FORMATION
1	TR-100AD1AVR/B400-NET-001	TR-100AD1AVR	B400-NET-001	CAT.6A4x2xAWG23
2	B100-HSB-001/B400-NET-001	B100-HSB-001	B400-NET-001	CAT.6A4x2xAWG23
3	SG-100D1/B400-NET-001.01	SG-100D1	B400-NET-001	CAT.6A4x2xAWG23
4	SG-100D1/B400-NET-001.02	SG-100D1	B400-NET-001	CAT.6A4x2xAWG23
5	SG-100D1/B400-NET-001.03	SG-100D1	B400-NET-001	CAT.6A4x2xAWG23
6	UP-200F1/B400-NET-001.01	UP-200F1	B400-NET-001	CAT.6A4x2xAWG23
7	UP-200F1/B400-NET-001.02	UP-200F1	B400-NET-001	CAT.6A4x2xAWG23
8	20-UCP-001/B400-NET-001.01	20-UCP-001	B400-NET-001	CAT.6A4x2xAWG23
9	20-UCP-001/B400-NET-001.02	20-UCP-001	B400-NET-001	CAT.6A4x2xAWG23
10	64-LP-001/B400-NET-001	64-LP-001	B400-NET-001	CAT.6A4x2xAWG23
11	CP-100E1/B400-NET-001.01	CP-100E1	B400-NET-001	FO12OM2
12	CP-100E1/B400-NET-001.02	CP-100E1	B400-NET-001	FO12OM2

L-SEC-1F-L-150-101-IST-004

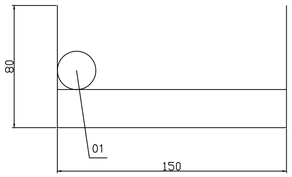

L-SEC-1F-L-150-101-IST-004				
POS	CABLENAME	FROM	TO	FORMATION
1	950-JE-06204/B400-FGS-002	950-JE-06204	B400-FGS-002	6x2x0.75 mm2

INSERT SUBCONTRACTOR / VENDOR LOGO HERE

REV.	DATE	DRN	CHKD	APPD	DESCRIPTION
03	29/09/25	SPS	LCA	CGI	AS-BUILT (ASB)
02	04/10/24	VBA	LCA	DLO	ACCEPTED FOR CONSTRUCTION (AFC)
01	26/07/24	VBA	LCA	DLO	ACCEPTED FOR CONSTRUCTION (AFC)
00	22/12/23	VBA	LCA	DLO	ISSUE FOR REVIEW (IFR)

CROSSWIND

ROSETTI MARINO

TITLE :
BASE LOAD POWER HUB (BLPH)
INSTRUMENT MAIN CABLE ROUTING-LOWER DECK
TOS EL. TOS EL. 23.310M

CONTRACT NO./TITLE CW-I-WP4-2023-05/HOLLANDSE KUST NOORD WIND PARK | SCALE 1:150

DRAWN SPS | CHECKED LCA | APPROVED CGI | DATE 29/09/25


A1 | DRAWING NO. 123A90-DDL-IN-DL-40082 | SHEET 010 | REV. 03

File Name : 123A90-DDL-IN-DL-40082 REV-03.dwg

DRAWING NO. 123A90-DDL-IN-DL-40082


REV. 03

L-SEC-1G-L-600-101-IST-002

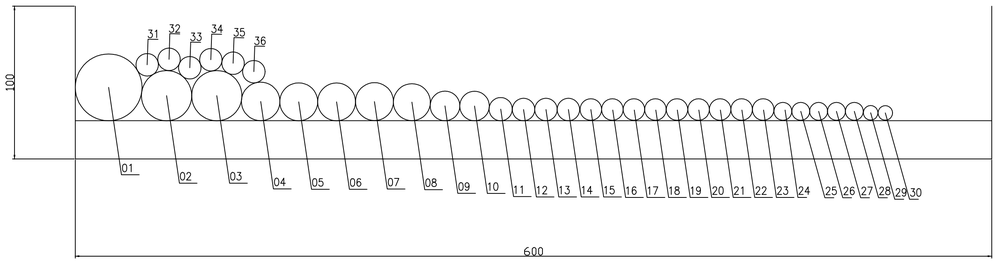


L-SEC-1G-L-600-101-IST-002				
POS	CABLENAME	FROM	TO	FORMATION
1	950-JE-05101/B400-FGS-002	950-JE-05101	B400-FGS-002	12x3x2,5mm2
2	950-JE-06101/B400-FGS-002	950-JE-06101	B400-FGS-002	6x3x2,5mm2
3	950-JE-06201/B400-FGS-002	950-JE-06201	B400-FGS-002	6x3x2,5mm2
4	B100-HSB-001/B400-FGS-002	950-JE-06202	B400-FGS-002	6x2x0,75mm2
5	00-JE-11004/B400-PCS-002	00-JE-11004	B400-PCS-002	12x2x0,75mm2
6	00-JE-12006_1/B400-PCS-002	00-JE-12006_1	B400-PCS-002	12x2x0,75mm2
7	00-JE-12006_2/B400-PCS-002	00-JE-12006_2	B400-PCS-002	12x2x0,75mm2
8	950-JE-06203/B400-FGS-002	950-JE-06203	B400-FGS-002	12x2,5mm2
9	00-JE-11005/B400-PCS-002	00-JE-11005	B400-PCS-002	6x2x0,75mm2
10	20-UCP-001/B400-FGS-002	20-UCP-001	B400-FGS-002	2x2x0,75mm2
11	C-B100-TIR-001/B400-PCS-002	B100-TIR-001	B400-PCS-002	2x2x0,75mm2
12	C-950-FDZ-05101/950-JE-05101	950-FDZ-05101	950-JE-05101	3x2,5mm2
13	C-950-GDZ-05104/950-JE-05101	950-GDZ-05104	950-JE-05101	3x2,5mm2
14	C-950-GDZ-05105/950-JE-05101	950-GDZ-05105	950-JE-05101	3x2,5mm2
15	C-20-XS-001/B400-SIS-001	20-XS-001	B400-SIS-001	2x2,5mm2
16	C-64-XS-001/B400-SIS-001	64-XS-001	B400-SIS-001	2x2,5mm2
17	C-77-XS-001/B400-SIS-001	77-XS-001	B400-SIS-001	2x2,5mm2
18	C-CP-100E1/B400-SIS-001	CP-100E1	B400-SIS-001	2x2,5mm2
19	C-SG-100D1-001/B400-SIS-001	SG-100D1-001	B400-SIS-001	2x2,5mm2
20	C-SG-100D1-002/B400-SIS-001	SG-100D1-002	B400-SIS-001	2x2,5mm2
21	C-SG-100D1-003/B400-SIS-001	SG-100D1-003	B400-SIS-001	2x2,5mm2
22	C-CB-200F1/B400-SIS-001	CB-200F1	B400-SIS-001	2x2,5mm2
23	C-UP-200F1/B400-SIS-001	UP-200F1	B400-SIS-001	2x2,5mm2
24	C-77-XA-001/B400-SIS-001	77-XA-001	B400-SIS-001	1x2x0,75mm2
25	C-20-XA-003/B400-SIS-001	20-XA-003	B400-SIS-001	1x2x0,75mm2
26	C-64-XA-003/B400-SIS-001	64-XA-003	B400-SIS-001	1x2x0,75mm2
27	C-950-MFA-06201/B400-FGS-002	950-MFA-06201	B400-FGS-002	1x2x0,75mm2
28	C-55-LIT-001/00-JE-11005	55-LIT-001	00-JE-11005	1x2x0,75mm2
29	C-B100-TDC-001/B400-PCS-002	B100-TDC001	B400-PCS-002	1x2x0,75mm2
30	C-B100-TDC-002/B400-PCS-002	B100-TDC002	B400-PCS-002	1x2x0,75mm2
31	C-950-FDZ-01104/950-JE-01101	950-FDZ-01104	950-JE-01101	3x2.5 mm2
32	C-950-FDZ-04103/950-JE-04101	950-FDZ-04103	950-JE-04101	3x2.5 mm2
33	C-950-FDZ-04104/950-JE-04101	950-FDZ-04103	950-JE-04101	3x2.5 mm2
34	C-950-GDZ-05101/950-JE-05101	950-GDZ-05101	950-JE-05101	3x2.5 mm2
35	C-950-GDZ-05102/950-JE-05101	950-GDZ-05102	950-JE-05101	3x2.5 mm2
36	C-950-FDZ-06102/950-JE-06101	950-FDZ-06102	950-JE-06101	3x2.5 mm2

L-SEC-1G-L-600-101-IST-003

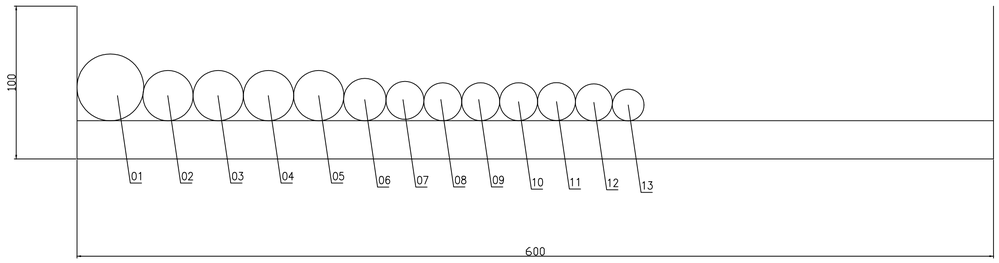


L-SEC-1G-L-600-101-IST-003				
POS	CABLENAME	FROM	TO	FORMATION
1	950-JE-03101/B400-FGS-002	950-JE-03101	400-FGS-002	12x3x2.5 mm2
2	950-JE-02103/B400-FGS-002	950-JE-02103	B400-FGS-002	6x3x2,5mm2
3	00-JE-21002/B400-SIS-001	00-JE-21002	B400-SIS-001	12x2x0,75mm2
4	00-JE-22002_1/B400-SIS-001	00-JE-22002_1	B400-SIS-001	12x2x0,75mm2
5	00-JE-22002_2/B400-SIS-001	00-JE-22002_2	B400-SIS-001	12x2x0,75mm2
6	00-JE-13002/B400-PCS-002	00-JE-13002	B400-PCS-002	24x2,5mm2
7	00-JE-11003_1/B400-PCS-002	00-JE-11003_1	B400-PCS-002	12x2x0,75mm2
8	00-JE-11003_2/B400-PCS-002	00-JE-11003_2	B400-PCS-002	12x2x0,75mm2
9	00-JE-12004_1/B400-PCS-002	00-JE-12004_1	B400-PCS-002	12x2x0,75mm2
10	00-JE-12004_2/B400-PCS-002	00-JE-12004_2	B400-PCS-002	12x2x0,75mm2
11	00-JE-12005/B400-PCS-002	00-JE-12005	B400-PCS-002	12x2x0,75mm2
12	00-JE-23002/B400-SIS-001	00-JE-23002	B400-SIS-001	12x2,5mm2
13	00-JE-13003/B400-PCS-002	00-JE-13003	B400-PCS-002	12x2,5mm2

L-SEC-11-L-300-101-IST-001

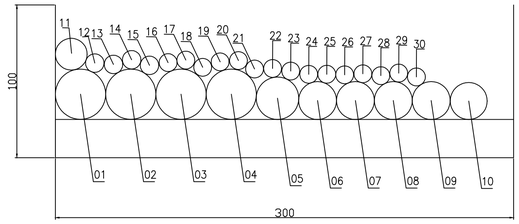


L-SEC-11-L-300-101-IST-001				
POS	CABLENAME	FROM	TO	FORMATION
1	950-JE-03101/B400-FGS-002	950-JE-03101	B400-FGS-002	12x3x2.5 mm2
2	950-JE-02103/B400-FGS-002	950-JE-02103	B400-FGS-002	6x3x2,5mm2
3	00-JE-22002_1/B400-SIS-001	00-JE-22002_1	B400-SIS-001	12x2x0,75mm2
4	00-JE-22002_2/B400-SIS-001	00-JE-22002_2	B400-SIS-001	12x2x0,75mm2
5	00-JE-21002/B400-SIS-001	00-JE-21002	B400-SIS-001	12x2x0,75mm2
6	00-JE-13002/B400-PCS-002	00-JE-13002	B400-PCS-002	24x2,5mm2
7	00-JE-11003_1/B400-PCS-002	00-JE-11003_1	B400-PCS-002	12x2x0,75mm2
8	00-JE-11003_2/B400-PCS-002	00-JE-11003_2	B400-PCS-002	12x2x0,75mm2
9	00-JE-12004_1/B400-PCS-002	00-JE-12004_1	B400-PCS-002	12x2x0,75mm2
10	00-JE-12004_2/B400-PCS-002	00-JE-12004_2	B400-PCS-002	12x2x0,75mm2
11	00-JE-12005/B400-PCS-002	00-JE-12005	B400-PCS-002	12x2x0,75mm2
12	00-JE-23002/B400-SIS-001	00-JE-23002	B400-SIS-001	12x2,5mm2
13	00-JE-13003/B400-PCS-002	00-JE-13003	B400-PCS-002	12x2,5mm2
14	C-50-XY-001/00-JE-13003	50-XY-001	00-JE-13003	2x2.5mm2
15	C-50-XY-002/00-JE-13003	50-XY-002	00-JE-13003	2x2.5mm2
16	C-50-XY-003/00-JE-13003	50-XY-003	00-JE-13003	2x2.5mm2
17	C-50-XY-004/00-JE-13003	50-XY-004	00-JE-13003	2x2.5mm2
18	C-64-PT-002/00-JE-21002	64-PT-002	00-JE-21002	1x2x0,75mm2
19	C-950-ASD-03101/00-JE-22002	950-ASD-03101	00-JE-22002	1x2x0,75mm2
20	C-950-MOB-03101/00-JE-22002	950-MOB-03101	00-JE-22002	1x2x0,75mm2
21	C-950-ESD-03101/00-JE-22002	950-ESD-03101	00-JE-22002	1x2x0,75mm2
22	C-950-ESDD-03101/00-JE-22002	950-ESDD-03101	00-JE-22002	1x2x0,75mm2
23	C-950-ASD-06101/00-JE-22002	950-ASD-06101	00-JE-22002	1x2x0,75mm2
24	C-950-MOB-06101/00-JE-22002	950-MOB-06101	00-JE-22002	1x2x0,75mm2
25	C-950-ESD-06101/00-JE-22002	950-ESD-06101	00-JE-22002	1x2x0,75mm2
26	C-950-ESDD-06101/00-JE-22002	950-ESDD-06101	00-JE-22002	1x2x0,75mm2
27	C-950-ASD-07101/00-JE-22002	950-ASD-07101	00-JE-22002	1x2x0,75mm2
28	C-950-MOB-07101/00-JE-22002	950-MOB-07101	00-JE-22002	1x2x0,75mm2
29	C-950-ESD-07101/00-JE-22002	950-ESD-07101	00-JE-22002	1x2x0,75mm2
30	C-950-ESDD-07101/00-JE-22002	950-ESDD-07101	00-JE-22002	1x2x0,75mm2

L-SEC-1H-L-150-101-IST-004

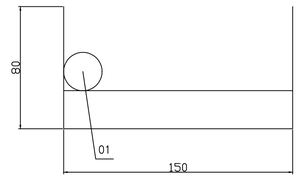

L-SEC-1H-L-150-101-IST-004				
POS	CABLENAME	FROM	TO	FORMATION
1	950-JE-06204/B400-FGS-002	950-JE-06204	B400-FGS-002	6x2x0.75 mm2

L-SEC-1G-L-200-101-TLT-001

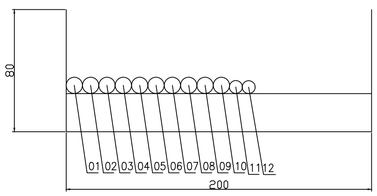

L-SEC-1G-L-200-101-TLT-001				
POS	CABLENAME	FROM	TO	FORMATION
1	TR-100AD1AVR/B400-NET-001	TR-100AD1AVR	B400-NET-001	CAT.6A4x2xAWG23
2	B100-HSB-001/B400-NET-001	B100-HSB-001	B400-NET-001	CAT.6A4x2xAWG23
3	SG-100D1/B400-NET-001.01	SG-100D1	B400-NET-001	CAT.6A4x2xAWG23
4	SG-100D1/B400-NET-001.02	SG-100D1	B400-NET-001	CAT.6A4x2xAWG23
5	SG-100D1/B400-NET-001.03	SG-100D1	B400-NET-001	CAT.6A4x2xAWG23
6	UP-200F1/B400-NET-001.01	UP-200F1	B400-NET-001	CAT.6A4x2xAWG23
7	UP-200F1/B400-NET-001.02	UP-200F1	B400-NET-001	CAT.6A4x2xAWG23
8	20-UCP-001/B400-NET-001.01	20-UCP-001	B400-NET-001	CAT.6A4x2xAWG23
9	20-UCP-001/B400-NET-001.02	20-UCP-001	B400-NET-001	CAT.6A4x2xAWG23
10	64-LP-001/B400-NET-001	64-LP-001	B400-NET-001	CAT.6A4x2xAWG23
11	CP-100E1/B400-NET-001.01	CP-100E1	B400-NET-001	FO12OM2
12	CP-100E1/B400-NET-001.02	CP-100E1	B400-NET-001	FO12OM2

INSERT SUBCONTRACTOR / VENDOR LOGO HERE

REV.	DATE	DRN	CHKD	APPD	DESCRIPTION
03	29/09/25	SPS	LCA	CGI	AS-BUILT (ASB)
02	04/10/24	VBA	LCA	DLO	ACCEPTED FOR CONSTRUCTION (AFC)
01	26/07/24	VBA	LCA	DLO	ACCEPTED FOR CONSTRUCTION (AFC)
00	22/12/23	VBA	LCA	DLO	ISSUE FOR REVIEW (IFR)

CROSSWIND

ROSETTI MARINO

TITLE :
BASE LOAD POWER HUB (BLPH)
INSTRUMENT MAIN CABLE ROUTING-LOWER DECK
TOS EL. TOS EL. 23.310M


CONTRACT NO./TITLE CW-I-WP4-2023-05/HOLLANDSE KUST NOORD WIND PARK			SCALE 1:150
DRAWN SPS	CHECKED LCA	APPROVED CGI	DATE 29/09/25
A1	DRAWING NO. 123A90-DDL-IN-DL-40082	SHEET 011	REV. 03

File Name : 123A90-DDL-IN-DL-40082 REV:03.dwg

DRAWING NO.: 123A90-DDL-IN-DL-40082


REV.: 03

L-SEC-1H-L-600-101-IST-002

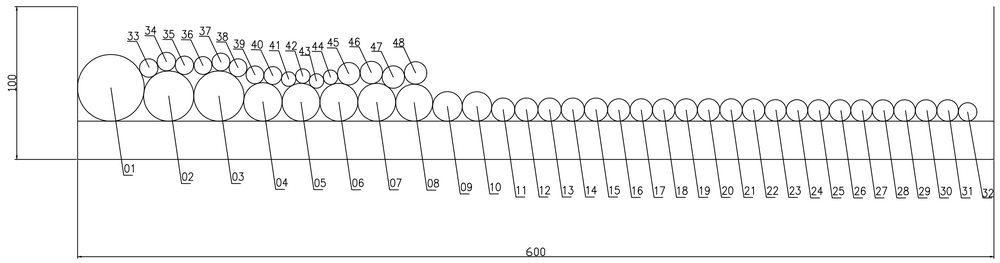


L-SEC-1H-L-600-101-IST-002				
POS	CABLENAME	FROM	TO	FORMATION
1	950-JE-05101/B400-FGS-002	950-JE-05101	B400-FGS-002	12x3x2,5mm2
2	950-JE-06101/B400-FGS-002	950-JE-06101	B400-FGS-002	6x3x2,5mm2
3	950-JE-06201/B400-FGS-002	950-JE-06201	B400-FGS-002	6x3x2,5mm2
4	B100-HSB-001/B400-FGS-002	950-JE-06202	B400-FGS-002	6x2x0,75mm2
5	00-JE-11004/B400-PCS-002	00-JE-11004	B400-PCS-002	12x2x0,75mm2
6	00-JE-12006_1/B400-PCS-002	00-JE-12006_1	B400-PCS-002	12x2x0,75mm2
7	00-JE-12006_2/B400-PCS-002	00-JE-12006_2	B400-PCS-002	12x2x0,75mm2
8	950-JE-06203/B400-FGS-002	950-JE-06203	B400-FGS-002	12x2,5mm2
9	00-JE-11005/B400-PCS-002	00-JE-11005	B400-PCS-002	6x2x0,75mm2
10	20-UCP-001/B400-FGS-002	20-UCP-001	B400-FGS-002	2x2x0,75mm2
11	C-B100-TIR-001/B400-PCS-002	B100-TIR-001	B400-PCS-002	2x2x0,75mm2
12	C-50-XV-001/00-JE-12006	50-XV-001	00-JE-12006	2x2x0.75mm2
13	C-50-XV-002/00-JE-12006	50-XV-002	00-JE-12006	2x2x0.75mm2
14	C-50-XV-003/00-JE-12006	50-XV-003	00-JE-12006	2x2x0.75mm2
15	C-50-XV-004/00-JE-12006	50-XV-004	00-JE-12006	2x2x0.75mm2
16	C-950-FDZ-05101/950-JE-05101	950-FDZ-05101	950-JE-05101	3x2.5mm2
17	C-950-GDZ-05101/950-JE-05101	950-GDZ-05101	950-JE-05101	3x2.5mm2
18	C-950-GDZ-05102/950-JE-05101	950-GDZ-05102	950-JE-05101	3x2.5mm2
19	C-950-GDZ-05103/950-JE-05101	950-GDZ-05103	950-JE-05101	3x2.5mm2
20	C-950-GDZ-05104/950-JE-05101	950-GDZ-05104	950-JE-05101	3x2.5mm2
21	C-950-GDZ-05105/950-JE-05101	950-GDZ-05105	950-JE-05101	3x2.5mm2
22	C-950-GDZ-05106/950-JE-05101	950-GDZ-05106	950-JE-05101	3x2.5mm2
23	C-20-XS-001/B400-SIS-001	20-XS-001	B400-SIS-001	2x2,5mm2
24	C-64-XS-001/B400-SIS-001	64-XS-001	B400-SIS-001	2x2,5mm2
25	C-77-XS-001/B400-SIS-001	77-XS-001	B400-SIS-001	2x2,5mm2
26	C-CP-100E1/B400-SIS-001	CP-100E1	B400-SIS-001	2x2,5mm2
27	C-SG-100D1-001/B400-SIS-001	SG-100D1-001	B400-SIS-001	2x2,5mm2
28	C-SG-100D1-002/B400-SIS-001	SG-100D1-002	B400-SIS-001	2x2,5mm2
29	C-SG-100D1-003/B400-SIS-001	SG-100D1-003	B400-SIS-001	2x2,5mm2
30	C-CB-200F1/B400-SIS-001	CB-200F1	B400-SIS-001	2x2,5mm2
31	C-UP-200F1/B400-SIS-001	UP-200F1	B400-SIS-001	2x2,5mm2
32	C-50-XY-001/00-JE-13003	50-XY-001	00-JE-13003	2x2.5mm2
33	C-50-XY-002/00-JE-13003	50-XY-002	00-JE-13003	2x2.5mm2
34	C-50-XY-003/00-JE-13003	50-XY-003	00-JE-13003	2x2.5mm2
35	C-50-XY-004/00-JE-13003	50-XY-004	00-JE-13003	2x2.5mm2
36	C-77-XA-001/B400-SIS-001	77-XA-001	B400-SIS-001	1x2x0,75mm2
37	C-20-XA-003/B400-SIS-001	20-XA-003	B400-SIS-001	1x2x0,75mm2
38	C-64-XA-003/B400-SIS-001	64-XA-003	B400-SIS-001	1x2x0,75mm2
39	C-950-MFA-06201/B400-FGS-002	950-MFA-06201	B400-FGS-002	1x2x0,75mm2
40	C-55-LIT-001/00-JE-11005	55-LIT-001	00-JE-11005	1x2x0,75mm2
41	C-B100-TDC-001/B400-PCS-002	B100-TDC001	B400-PCS-002	1x2x0,75mm2
42	C-B100-TDC-002/B400-PCS-002	B100-TDC002	B400-PCS-002	1x2x0,75mm2
43	C-50-PT-001/00-JE-11004	50-PT-001	00-JE-11004	1x2x0.75mm2
44	C-50-PT-002/00-JE-11004	50-PT-002	00-JE-11004	1x2x0.75mm2
45	C-950-FDZ-01104/950-JE-01101	950-FDZ-01104	950-JE-01101	3x2.5 mm2
46	C-950-FDZ-04103/950-JE-04101	950-FDZ-04103	950-JE-04101	3x2.5 mm2
47	C-950-FDZ-04104/950-JE-04101	950-FDZ-04104	950-JE-04101	3x2.5 mm2
48	C-950-FDZ-06102/950-JE-06101	950-FDZ-06102	950-JE-06101	3x2.5 mm2

L-SEC-1H-L-600-101-IST-003

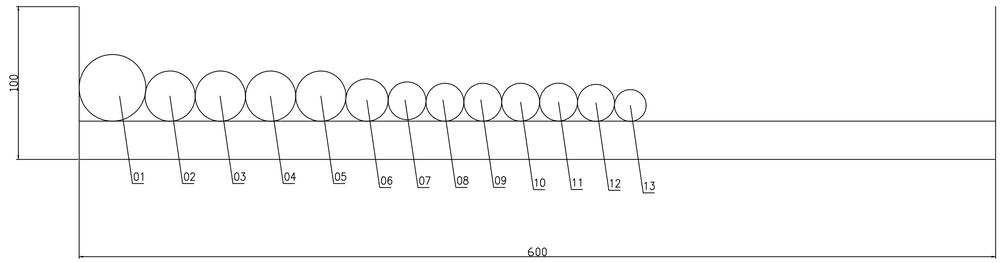


L-SEC-1H-L-600-101-003				
POS	CABLENAME	FROM	TO	FORMATION
1	950-JE-03101/B400-FGS-002	950-JE-03101	400-FGS-002	12x3x2.5 mm2
2	950-JE-02103/B400-FGS-002	950-JE-02103	B400-FGS-002	6x3x2,5mm2
3	00-JE-21002/B400-SIS-001	00-JE-21002	B400-SIS-001	12x2x0,75mm2
4	00-JE-22002_1/B400-SIS-001	00-JE-22002_1	B400-SIS-001	12x2x0,75mm2
5	00-JE-22002_2/B400-SIS-001	00-JE-22002_2	B400-SIS-001	12x2x0,75mm2
6	00-JE-13002/B400-PCS-002	00-JE-13002	B400-PCS-002	24x2,5mm2
7	00-JE-11003_1/B400-PCS-002	00-JE-11003_1	B400-PCS-002	12x2x0,75mm2
8	00-JE-11003_2/B400-PCS-002	00-JE-11003_2	B400-PCS-002	12x2x0,75mm2
9	00-JE-12004_1/B400-PCS-002	00-JE-12004_1	B400-PCS-002	12x2x0,75mm2
10	00-JE-12004_2/B400-PCS-002	00-JE-12004_2	B400-PCS-002	12x2x0,75mm2
11	00-JE-12005/B400-PCS-002	00-JE-12005	B400-PCS-002	12x2x0,75mm2
12	00-JE-23002/B400-SIS-001	00-JE-23002	B400-SIS-001	12x2,5mm2
13	00-JE-13003/B400-PCS-002	00-JE-13003	B400-PCS-002	12x2,5mm2

L-SEC-13-L-200-101-IST-025

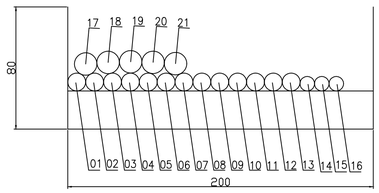


L-SEC-13-L-200-101-IST-025				
POS	CABLENAME	FROM	TO	FORMATION
1	C-950-ASD-03101/00-JE-22002	950-ASD-03101	00-JE-22002	1x2x0,75mm2
2	C-950-MOB-03101/00-JE-22002	950-MOB-03101	00-JE-22002	1x2x0,75mm2
3	C-950-ESD-03101/00-JE-22002	950-ESD-03101	00-JE-22002	1x2x0,75mm2
4	C-950-ESDD-03101/00-JE-22002	950-ESDD-03101	00-JE-22002	1x2x0,75mm2
5	C-950-ASD-06101/00-JE-22002	950-ASD-06101	00-JE-22002	1x2x0,75mm2
6	C-950-MOB-06101/00-JE-22002	950-MOB-06101	00-JE-22002	1x2x0,75mm2
7	C-950-ESD-06101/00-JE-22002	950-ESD-06101	00-JE-22002	1x2x0,75mm2
8	C-950-ESDD-06101/00-JE-22002	950-ESDD-06101	00-JE-22002	1x2x0,75mm2
9	C-950-ASD-07101/00-JE-22002	950-ASD-07101	00-JE-22002	1x2x0,75mm2
10	C-950-MOB-07101/00-JE-22002	950-MOB-07101	00-JE-22002	1x2x0,75mm2
11	C-950-ESD-07101/00-JE-22002	950-ESD-07101	00-JE-22002	1x2x0,75mm2
12	C-950-ESDD-07101/00-JE-22002	950-ESDD-07101	00-JE-22002	1x2x0,75mm2
13	C-64-PT-002/00-JE-21002	64-PT-002	00-JE-21002	1x2x0,75mm2
14	C-50-TT-001/00-JE-11004	50-TT-001	00-JE-11004	1x2x0.75 mm2
15	C-50-TT-002/00-JE-11004	50-TT-002	00-JE-11004	1x2x0.75 mm2
16	C-50-PT-014/00-JE-11004	50-PT-014	00-JE-11004	1x2x0.75 mm2
17	C-950-FDZ-01104/950-JE-01101	950-FDZ-01104	950-JE-01101	3x2.5 mm2
18	C-950-FDZ-04103/950-JE-04101	950-FDZ-04103	950-JE-04101	3x2.5 mm2
19	C-950-FDZ-04104/950-JE-04101	950-FDZ-04104	950-JE-04101	3x2.5 mm2
20	C-950-FDZ-05103/950-JE-05101	950-FDZ-05103	950-JE-05101	3x2.5 mm2
21	C-950-FDZ-05104/950-JE-05101	950-FDZ-05104	950-JE-05101	3x2.5 mm2

L-SEC-12-L-150-101-IST-037

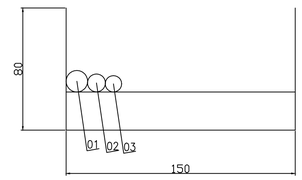


L-SEC-12-L-150-101-IST-037				
POS	CABLENAME	FROM	TO	FORMATION
1	C-64-XS-001/B400-SIS-001	64-XS-001	B400-SIS-001	2x2,5mm2
2	C-64-XA-003/B400-SIS-001	64-XA-003	B400-SIS-001	1x2x0,75mm2
3	64-LP-001/B400-NET-001	64-LP-001	B400-NET-001	CAT.6A4x2xAWG23

L-SEC-1H-L-200-101-TLT-001

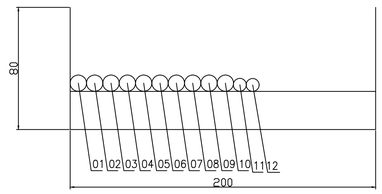

L-SEC-1H-L-200-101-TLT-001				
POS	CABLENAME	FROM	TO	FORMATION
1	TR-100AD1AVR/B400-NET-001	TR-100AD1AVR	B400-NET-001	CAT.6A4x2xAWG23
2	B100-HSB-001/B400-NET-001	B100-HSB-001	B400-NET-001	CAT.6A4x2xAWG23
3	SG-100D1/B400-NET-001.01	SG-100D1	B400-NET-001	CAT.6A4x2xAWG23
4	SG-100D1/B400-NET-001.02	SG-100D1	B400-NET-001	CAT.6A4x2xAWG23
5	SG-100D1/B400-NET-001.03	SG-100D1	B400-NET-001	CAT.6A4x2xAWG23
6	UP-200F1/B400-NET-001.01	UP-200F1	B400-NET-001	CAT.6A4x2xAWG23
7	UP-200F1/B400-NET-001.02	UP-200F1	B400-NET-001	CAT.6A4x2xAWG23
8	20-UCP-001/B400-NET-001.01	20-UCP-001	B400-NET-001	CAT.6A4x2xAWG23
9	20-UCP-001/B400-NET-001.02	20-UCP-001	B400-NET-001	CAT.6A4x2xAWG23
10	64-LP-001/B400-NET-001	64-LP-001	B400-NET-001	CAT.6A4x2xAWG23
11	CP-100E1/B400-NET-001.01	CP-100E1	B400-NET-001	FO12OM2
12	CP-100E1/B400-NET-001.02	CP-100E1	B400-NET-001	FO12OM2

L-SEC-1J-L-150-101-IST-004

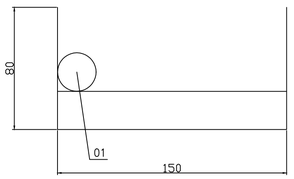

L-SEC-1J-L-150-101-IST-004				
POS	CABLENAME	FROM	TO	FORMATION
1	950-JE-06204/B400-FGS-002	950-JE-06204	B400-FGS-002	6x2x0,75mm2

INSERT SUBCONTRACTOR / VENDOR LOGO HERE

REV.	DATE	DRN	CHKD	APPD	DESCRIPTION
03	29/09/25	SPS	LCA	CGI	AS-BUILT (ASB)
02	04/10/24	VBA	LCA	DLO	ACCEPTED FOR CONSTRUCTION (AFC)
01	26/07/24	VBA	LCA	DLO	ACCEPTED FOR CONSTRUCTION (AFC)
00	22/12/23	VBA	LCA	DLO	ISSUE FOR REVIEW (IFR)

CROSSWIND

ROSETTI MARINO

TITLE :
BASE LOAD POWER HUB (BLPH)
INSTRUMENT MAIN CABLE ROUTING-LOWER DECK
TOS EL. TOS EL. 23.310M


CONTRACT NO./TITLE	CW-I-WP4-2023-05/HOLLANDSE KUST NOORD WIND PARK		SCALE 1:150
DRAWN SPS	CHECKED LCA	APPROVED CGI	DATE 29/09/25
A1	DRAWING NO. 123A90-DDL-IN-DL-40082	SHEET 012	REV. 03

File Name : 123A90-DDL-IN-DL-40082 REV03.dwg

DRAWING NO. 123A90-DDL-IN-DL-40082


REV. 03

L-SEC-1I-L-600-101-IST-002

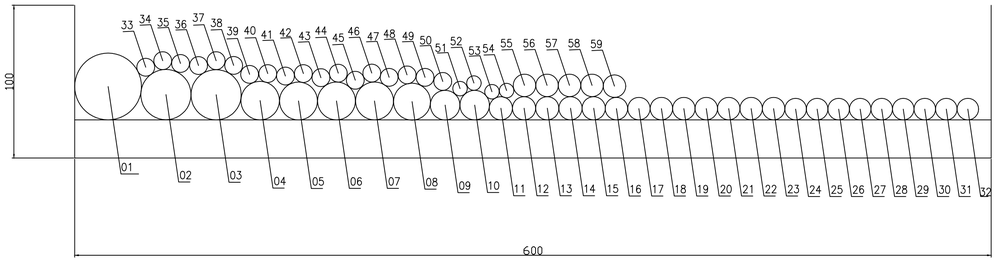


L-SEC-1I-L-600-101-IST-002				
POS	CABLENAME	FROM	TO	FORMATION
1	950-JE-05101/B400-FGS-002	950-JE-05101	B400-FGS-002	12x3x2,5mm2
2	950-JE-06101/B400-FGS-002	950-JE-06101	B400-FGS-002	6x3x2,5mm2
3	950-JE-06201/B400-FGS-002	950-JE-06201	B400-FGS-002	6x3x2,5mm2
4	B100-HSB-001/B400-FGS-002	950-JE-06202	B400-FGS-002	6x2x0,75mm2
5	00-JE-11004/B400-PCS-002	00-JE-11004	B400-PCS-002	12x2x0,75mm2
6	00-JE-12006_1/B400-PCS-002	00-JE-12006_1	B400-PCS-002	12x2x0,75mm2
7	00-JE-12006_2/B400-PCS-002	00-JE-12006_2	B400-PCS-002	12x2x0,75mm2
8	950-JE-06203/B400-FGS-002	950-JE-06203	B400-FGS-002	12x2,5mm2
9	00-JE-11005/B400-PCS-002	00-JE-11005	B400-PCS-002	6x2x0,75mm2
10	20-UCP-001/B400-FGS-002	20-UCP-001	B400-FGS-002	2x2x0,75mm2
11	C-B100-TIR-001/B400-PCS-002	B100-TIR-001	B400-PCS-002	2x2x0,75mm2
12	C-50-XV-001/00-JE-12006	50-XV-001	00-JE-12006	2x2x0.75mm2
13	C-50-XV-002/00-JE-12006	50-XV-002	00-JE-12006	2x2x0.75mm2
14	C-50-XV-003/00-JE-12006	50-XV-003	00-JE-12006	2x2x0.75mm2
15	C-50-XV-004/00-JE-12006	50-XV-004	00-JE-12006	2x2x0.75mm2
16	C-950-FDZ-05101/950-JE-05101	950-FDZ-05101	950-JE-05101	3x2.5mm2
17	C-950-FDZ-05102/950-JE-05101	950-FDZ-05102	950-JE-05101	3x2.5mm2
18	C-950-GDZ-05101/950-JE-05101	950-GDZ-05101	950-JE-05101	3x2.5mm2
19	C-950-GDZ-05102/950-JE-05101	950-GDZ-05102	950-JE-05101	3x2.5mm2
20	C-950-GDZ-05103/950-JE-05101	950-GDZ-05103	950-JE-05101	3x2.5mm2
21	C-950-GDZ-05104/950-JE-05101	950-GDZ-05104	950-JE-05101	3x2.5mm2
22	C-950-GDZ-05105/950-JE-05101	950-GDZ-05105	950-JE-05101	3x2.5mm2
23	C-950-GDZ-05106/950-JE-05101	950-GDZ-05106	950-JE-05101	3x2.5mm2
24	C-20-XS-001/B400-SIS-001	20-XS-001	B400-SIS-001	2x2,5mm2
25	C-64-XS-001/B400-SIS-001	64-XS-001	B400-SIS-001	2x2,5mm2
26	C-77-XS-001/B400-SIS-001	77-XS-001	B400-SIS-001	2x2,5mm2
27	C-CP-100E1/B400-SIS-001	CP-100E1	B400-SIS-001	2x2,5mm2
28	C-SG-100D1-001/B400-SIS-001	SG-100D1-001	B400-SIS-001	2x2,5mm2
29	C-SG-100D1-002/B400-SIS-001	SG-100D1-002	B400-SIS-001	2x2,5mm2
30	C-SG-100D1-003/B400-SIS-001	SG-100D1-003	B400-SIS-001	2x2,5mm2
31	C-CB-200F1/B400-SIS-001	CB-200F1	B400-SIS-001	2x2,5mm2
32	C-UP-200F1/B400-SIS-001	UP-200F1	B400-SIS-001	2x2,5mm2
33	C-77-XA-001/B400-SIS-001	77-XA-001	B400-SIS-001	1x2x0,75mm2
34	C-20-XA-003/B400-SIS-001	20-XA-003	B400-SIS-001	1x2x0,75mm2
35	C-64-XA-003/B400-SIS-001	64-XA-003	B400-SIS-001	1x2x0,75mm2
36	C-950-MFA-06201/B400-FGS-002	950-MFA-06201	B400-FGS-002	1x2x0,75mm2
37	C-55-LIT-001/00-JE-11005	55-LIT-001	00-JE-11005	1x2x0,75mm2
38	C-64-PT-002/00-JE-21002	64-PT-002	00-JE-21002	1x2x0,75mm2
39	C-950-ASD-03101/00-JE-22002	950-ASD-03101	00-JE-22002	1x2x0,75mm2
40	C-950-MOB-03101/00-JE-22002	950-MOB-03101	00-JE-22002	1x2x0,75mm2
41	C-950-ESD-03101/00-JE-22002	950-ESD-03101	00-JE-22002	1x2x0,75mm2
42	C-950-ESDD-03101/00-JE-22002	950-ESDD-03101	00-JE-22002	1x2x0,75mm2
43	C-950-ASD-06101/00-JE-22002	950-ASD-06101	00-JE-22002	1x2x0,75mm2
44	C-950-MOB-06101/00-JE-22002	950-MOB-06101	00-JE-22002	1x2x0,75mm2
45	C-950-ESD-06101/00-JE-22002	950-ESD-06101	00-JE-22002	1x2x0,75mm2
46	C-950-ESDD-06101/00-JE-22002	950-ESDD-06101	00-JE-22002	1x2x0,75mm2
47	C-950-ASD-07101/00-JE-22002	950-ASD-07101	00-JE-22002	1x2x0,75mm2
48	C-950-MOB-07101/00-JE-22002	950-MOB-07101	00-JE-22002	1x2x0,75mm2
49	C-950-ESD-07101/00-JE-22002	950-ESD-07101	00-JE-22002	1x2x0,75mm2
50	C-950-ESDD-07101/00-JE-22002	950-ESDD-07101	00-JE-22002	1x2x0,75mm2
51	C-B100-TDC-001/B400-PCS-002	B100-TDC001	B400-PCS-002	1x2x0,75mm2
52	C-B100-TDC-002/B400-PCS-002	B100-TDC002	B400-PCS-002	1x2x0,75mm2
53	C-50-PT-001/00-JE-11004	50-PT-001	00-JE-11004	1x2x0,75mm2
54	C-50-PT-002/00-JE-11004	50-PT-002	00-JE-11004	1x2x0,75mm2
55	C-950-FDZ-01104/950-JE-01101	950-FDZ-01104	950-JE-01101	3x2.5 mm2
56	C-950-FDZ-04103/950-JE-04101	950-FDZ-04103	950-JE-04101	3x2.5 mm2
57	C-950-FDZ-04104/950-JE-04101	950-FDZ-04104	950-JE-04101	3x2.5 mm2
58	C-950-FDZ-06101/950-JE-06101	950-FDZ-06101	950-JE-06101	3x2.5 mm2
59	C-950-FDZ-06102/950-JE-06101	950-FDZ-06102	950-JE-06101	3x2.5 mm2

L-SEC-1J-L-600-101-IST-002

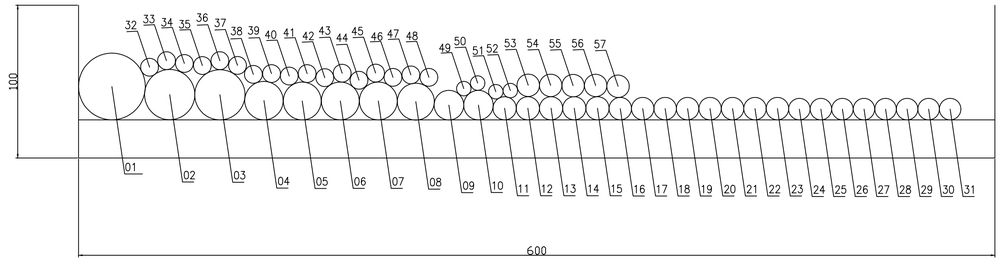


L-SEC-1J-L-600-101-IST-002				
POS	CABLENAME	FROM	TO	FORMATION
1	950-JE-05101/B400-FGS-002	950-JE-05101	B400-FGS-002	12x3x2,5mm2
2	950-JE-06101/B400-FGS-002	950-JE-06101	B400-FGS-002	6x3x2,5mm2
3	950-JE-06201/B400-FGS-002	950-JE-06201	B400-FGS-002	6x3x2,5mm2
4	B100-HSB-001/B400-FGS-002	950-JE-06202	B400-FGS-002	6x2x0,75mm2
5	00-JE-11004/B400-PCS-002	00-JE-11004	B400-PCS-002	12x2x0,75mm2
6	00-JE-12006_1/B400-PCS-002	00-JE-12006_1	B400-PCS-002	12x2x0,75mm2
7	00-JE-12006_2/B400-PCS-002	00-JE-12006_2	B400-PCS-002	12x2x0,75mm2
8	950-JE-06203/B400-FGS-002	950-JE-06203	B400-FGS-002	12x2,5mm2
9	00-JE-11005/B400-PCS-002	00-JE-11005	B400-PCS-002	6x2x0,75mm2
10	20-UCP-001/B400-FGS-002	20-UCP-001	B400-FGS-002	2x2x0,75mm2
11	C-B100-TIR-001/B400-PCS-002	B100-TIR-001	B400-PCS-002	2x2x0,75mm2
12	C-50-XV-001/00-JE-12006	50-XV-001	00-JE-12006	2x2x0.75mm2
13	C-50-XV-002/00-JE-12006	50-XV-002	00-JE-12006	2x2x0.75mm2
14	C-50-XV-003/00-JE-12006	50-XV-003	00-JE-12006	2x2x0.75mm2
15	C-50-XV-004/00-JE-12006	50-XV-004	00-JE-12006	2x2x0.75mm2
16	C-950-FDZ-05101/950-JE-05101	950-FDZ-05101	950-JE-05101	3x2.5mm2
17	C-950-FDZ-05102/950-JE-05101	950-FDZ-05102	950-JE-05101	3x2.5mm2
18	C-950-GDZ-05101/950-JE-05101	950-GDZ-05101	950-JE-05101	3x2.5mm2
19	C-950-GDZ-05102/950-JE-05101	950-GDZ-05102	950-JE-05101	3x2.5mm2
20	C-950-GDZ-05103/950-JE-05101	950-GDZ-05103	950-JE-05101	3x2.5mm2
21	C-950-GDZ-05104/950-JE-05101	950-GDZ-05104	950-JE-05101	3x2.5mm2
22	C-950-GDZ-05105/950-JE-05101	950-GDZ-05105	950-JE-05101	3x2.5mm2
23	C-950-GDZ-05106/950-JE-05101	950-GDZ-05106	950-JE-05101	3x2.5mm2
24	C-20-XS-001/B400-SIS-001	20-XS-001	B400-SIS-001	2x2,5mm2
25	C-77-XS-001/B400-SIS-001	77-XS-001	B400-SIS-001	2x2,5mm2
26	C-CP-100E1/B400-SIS-001	CP-100E1	B400-SIS-001	2x2,5mm2
27	C-SG-100D1-001/B400-SIS-001	SG-100D1-001	B400-SIS-001	2x2,5mm2
28	C-SG-100D1-002/B400-SIS-001	SG-100D1-002	B400-SIS-001	2x2,5mm2
29	C-SG-100D1-003/B400-SIS-001	SG-100D1-003	B400-SIS-001	2x2,5mm2
30	C-CB-200F1/B400-SIS-001	CB-200F1	B400-SIS-001	2x2,5mm2
31	C-UP-200F1/B400-SIS-001	UP-200F1	B400-SIS-001	2x2,5mm2
32	C-77-XA-001/B400-SIS-001	77-XA-001	B400-SIS-001	1x2x0,75mm2
33	C-20-XA-003/B400-SIS-001	20-XA-003	B400-SIS-001	1x2x0,75mm2
34	C-950-MFA-06201/B400-FGS-002	950-MFA-06201	B400-FGS-002	1x2x0,75mm2
35	C-55-LIT-001/00-JE-11005	55-LIT-001	00-JE-11005	1x2x0,75mm2
36	C-64-PT-002/00-JE-21002	64-PT-002	00-JE-21002	1x2x0,75mm2
37	C-950-ASD-03101/00-JE-22002	950-ASD-03101	00-JE-22002	1x2x0,75mm2
38	C-950-MOB-03101/00-JE-22002	950-MOB-03101	00-JE-22002	1x2x0,75mm2
39	C-950-ESD-03101/00-JE-22002	950-ESD-03101	00-JE-22002	1x2x0,75mm2
40	C-950-ESDD-03101/00-JE-22002	950-ESDD-03101	00-JE-22002	1x2x0,75mm2
41	C-950-ASD-06101/00-JE-22002	950-ASD-06101	00-JE-22002	1x2x0,75mm2
42	C-950-MOB-06101/00-JE-22002	950-MOB-06101	00-JE-22002	1x2x0,75mm2
43	C-950-ESD-06101/00-JE-22002	950-ESD-06101	00-JE-22002	1x2x0,75mm2
44	C-950-ESDD-06101/00-JE-22002	950-ESDD-06101	00-JE-22002	1x2x0,75mm2
45	C-950-ASD-07101/00-JE-22002	950-ASD-07101	00-JE-22002	1x2x0,75mm2
46	C-950-MOB-07101/00-JE-22002	950-MOB-07101	00-JE-22002	1x2x0,75mm2
47	C-950-ESD-07101/00-JE-22002	950-ESD-07101	00-JE-22002	1x2x0,75mm2
48	C-950-ESDD-07101/00-JE-22002	950-ESDD-07101	00-JE-22002	1x2x0,75mm2
49	C-B100-TDC-001/B400-PCS-002	B100-TDC001	B400-PCS-002	1x2x0,75mm2
50	C-B100-TDC-002/B400-PCS-002	B100-TDC002	B400-PCS-002	1x2x0,75mm2
51	C-50-PT-001/00-JE-11004	50-PT-001	00-JE-11004	1x2x0,75mm2
52	C-50-PT-002/00-JE-11004	50-PT-002	00-JE-11004	1x2x0,75mm2
53	C-950-FDZ-01104/950-JE-01101	950-FDZ-01104	950-JE-01101	3x2.5 mm2
54	C-950-FDZ-04103/950-JE-04101	950-FDZ-04103	950-JE-04101	3x2.5 mm2
55	C-950-FDZ-04104/950-JE-04101	950-FDZ-04104	950-JE-04101	3x2.5 mm2
56	C-950-FDZ-06101/950-JE-06101	950-FDZ-06101	950-JE-06101	3x2.5 mm2
57	C-950-FDZ-06102/950-JE-06101	950-FDZ-06102	950-JE-06101	3x2.5 mm2

L-SEC-1J-L-200-101-TLT-001

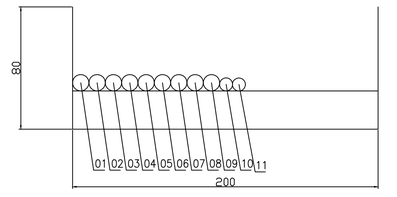


L-SEC-1J-L-200-101-TLT-001				
POS	CABLENAME	FROM	TO	FORMATION
1	TR-100AD1AVR/B400-NET-001	TR-100AD1AVR	B400-NET-001	CAT.6A4x2xAWG23
2	B100-HSB-001/B400-NET-001	B100-HSB-001	B400-NET-001	CAT.6A4x2xAWG23
3	SG-100D1/B400-NET-001.01	SG-100D1	B400-NET-001	CAT.6A4x2xAWG23
4	SG-100D1/B400-NET-001.02	SG-100D1	B400-NET-001	CAT.6A4x2xAWG23
5	SG-100D1/B400-NET-001.03	SG-100D1	B400-NET-001	CAT.6A4x2xAWG23
6	UP-200F1/B400-NET-001.01	UP-200F1	B400-NET-001	CAT.6A4x2xAWG23
7	UP-200F1/B400-NET-001.02	UP-200F1	B400-NET-001	CAT.6A4x2xAWG23
8	20-UCP-001/B400-NET-001.01	20-UCP-001	B400-NET-001	CAT.6A4x2xAWG23
9	20-UCP-001/B400-NET-001.02	20-UCP-001	B400-NET-001	CAT.6A4x2xAWG23
10	CP-100E1/B400-NET-001.01	CP-100E1	B400-NET-001	FO12OM2
11	CP-100E1/B400-NET-001.02	CP-100E1	B400-NET-001	FO12OM2

L-SEC-1I-L-150-101-IST-004

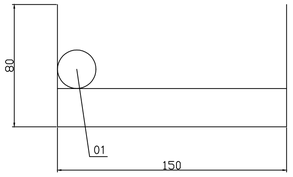

L-SEC-1I-L-150-101-IST-004				
POS	CABLENAME	FROM	TO	FORMATION
1	950-JE-06204/B400-FGS-002	950-JE-06204	B400-FGS-002	6x2x0,75mm2

L-SEC-1I-L-200-101-TLT-001

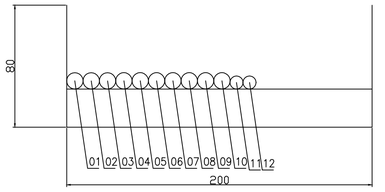

L-SEC-1I-L-200-101-TLT-001				
POS	CABLENAME	FROM	TO	FORMATION
1	TR-100AD1AVR/B400-NET-001	TR-100AD1AVR	B400-NET-001	CAT.6A4x2xAWG23
2	B100-HSB-001/B400-NET-001	B100-HSB-001	B400-NET-001	CAT.6A4x2xAWG23
3	SG-100D1/B400-NET-001.01	SG-100D1	B400-NET-001	CAT.6A4x2xAWG23
4	SG-100D1/B400-NET-001.02	SG-100D1	B400-NET-001	CAT.6A4x2xAWG23
5	SG-100D1/B400-NET-001.03	SG-100D1	B400-NET-001	CAT.6A4x2xAWG23
6	UP-200F1/B400-NET-001.01	UP-200F1	B400-NET-001	CAT.6A4x2xAWG23
7	UP-200F1/B400-NET-001.02	UP-200F1	B400-NET-001	CAT.6A4x2xAWG23
8	20-UCP-001/B400-NET-001.01	20-UCP-001	B400-NET-001	CAT.6A4x2xAWG23
9	20-UCP-001/B400-NET-001.02	20-UCP-001	B400-NET-001	CAT.6A4x2xAWG23
10	64-LP-001/B400-NET-001	64-LP-001	B400-NET-001	CAT.6A4x2xAWG23
11	CP-100E1/B400-NET-001.01	CP-100E1	B400-NET-001	FO12OM2
12	CP-100E1/B400-NET-001.02	CP-100E1	B400-NET-001	FO12OM2

INSERT SUBCONTRACTOR / VENDOR LOGO HERE

REV.	DATE	DRN	CHKD	APPD	DESCRIPTION
03	29/09/25	SPS	LCA	CGI	AS-BUILT (ASB)
02	04/10/24	VBA	LCA	DLO	ACCEPTED FOR CONSTRUCTION (AFC)
01	26/07/24	VBA	LCA	DLO	ACCEPTED FOR CONSTRUCTION (AFC)
00	22/12/23	VBA	LCA	DLO	ISSUE FOR REVIEW (IFR)

CROSSWIND

ROSETTI MARINO

TITLE :
BASE LOAD POWER HUB (BLPH)
INSTRUMENT MAIN CABLE ROUTING-LOWER DECK
TOS EL. TOS EL. 23.310M


CONTRACT NO./TITLE CW-I-WP4-2023-05/HOLLANDSE KUST NOORD WIND PARK		SCALE 1:150	
DRAWN SPS	CHECKED LCA	APPROVED CGI	DATE 29/09/25
A1	DRAWING NO. 123A90-DDL-IN-DL-40082	SHEET 013	REV. 03

File Name : 123A90-DDL-IN-DL-40082 REV:03.dwg

DRAWING NO. 123A90-DDL-IN-DL-40082


REV. 03

L-SEC-1L-L-600-101-IST-002

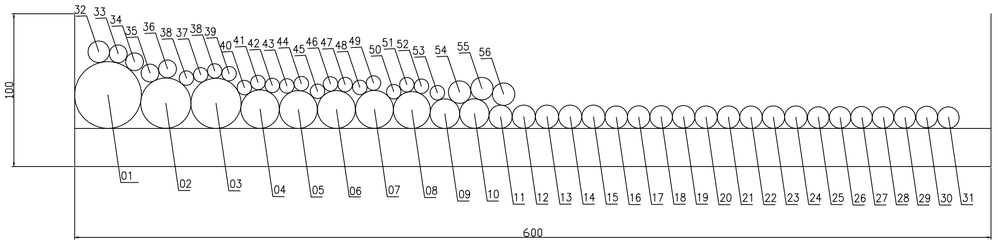


L-SEC-1L-L-600-101-IST-002				
POS	CABLENAME	FROM	TO	FORMATION
1	950-JE-05101/B400-FGS-002	950-JE-05101	B400-FGS-002	12x3x2,5mm2
2	950-JE-06101/B400-FGS-002	950-JE-06101	B400-FGS-002	6x3x2,5mm2
3	950-JE-06201/B400-FGS-002	950-JE-06201	B400-FGS-002	6x3x2,5mm2
4	B100-HSB-001/B400-FGS-002	950-JE-06202	B400-FGS-002	6x2x0,75mm2
5	00-JE-11004/B400-PCS-002	00-JE-11004	B400-PCS-002	12x2x0,75mm2
6	00-JE-12006_1/B400-PCS-002	00-JE-12006_1	B400-PCS-002	12x2x0,75mm2
7	00-JE-12006_2/B400-PCS-002	00-JE-12006_2	B400-PCS-002	12x2x0,75mm2
8	950-JE-06203/B400-FGS-002	950-JE-06203	B400-FGS-002	12x2,5mm2
9	00-JE-11005/B400-PCS-002	00-JE-11005	B400-PCS-002	6x2x0,75mm2
10	20-UCP-001/B400-FGS-002	20-UCP-001	B400-FGS-002	2x2x0,75mm2
11	C-B100-TIR-001/B400-PCS-002	B100-TIR-001	B400-PCS-002	2x2x0,75mm2
12	C-50-XV-001/00-JE-12006	50-XV-001	00-JE-12006	2x2x0.75mm2
13	C-50-XV-002/00-JE-12006	50-XV-002	00-JE-12006	2x2x0.75mm2
14	C-50-XV-003/00-JE-12006	50-XV-003	00-JE-12006	2x2x0.75mm2
15	C-50-XV-004/00-JE-12006	50-XV-004	00-JE-12006	2x2x0.75mm2
16	C-950-FDZ-05101/950-JE-05101	950-FDZ-05101	950-JE-05101	3x2.5mm2
17	C-950-FDZ-05102/950-JE-05101	950-FDZ-05102	950-JE-05101	3x2.5mm2
18	C-950-GDZ-05101/950-JE-05101	950-GDZ-05101	950-JE-05101	3x2.5mm2
19	C-950-GDZ-05102/950-JE-05101	950-GDZ-05102	950-JE-05101	3x2.5mm2
20	C-950-GDZ-05103/950-JE-05101	950-GDZ-05103	950-JE-05101	3x2.5mm2
21	C-950-GDZ-05104/950-JE-05101	950-GDZ-05104	950-JE-05101	3x2.5mm2
22	C-950-GDZ-05105/950-JE-05101	950-GDZ-05105	950-JE-05101	3x2.5mm2
23	C-950-GDZ-05106/950-JE-05101	950-GDZ-05106	950-JE-05101	3x2.5mm2
24	C-950-FDZ-06101/950-JE-06101	950-FDZ-06101	950-JE-06101	3x2.5mm2
25	C-20-XS-001/B400-SIS-001	20-XS-001	B400-SIS-001	2x2,5mm2
26	C-77-XS-001/B400-SIS-001	77-XS-001	B400-SIS-001	2x2,5mm2
27	C-CP-100E1/B400-SIS-001	CP-100E1	B400-SIS-001	2x2,5mm2
28	C-SG-100D1-001/B400-SIS-001	SG-100D1-001	B400-SIS-001	2x2,5mm2
29	C-SG-100D1-002/B400-SIS-001	SG-100D1-002	B400-SIS-001	2x2,5mm2
30	C-SG-100D1-003/B400-SIS-001	SG-100D1-003	B400-SIS-001	2x2,5mm2
31	C-CB-200F1/B400-SIS-001	CB-200F1	B400-SIS-001	2x2,5mm2
32	C-UP-200F1/B400-SIS-001	UP-200F1	B400-SIS-001	2x2,5mm2
33	C-77-XA-001/B400-SIS-001	77-XA-001	B400-SIS-001	1x2x0,75mm2
34	C-20-XA-003/B400-SIS-001	20-XA-003	B400-SIS-001	1x2x0,75mm2
35	C-950-MFA-06201/B400-FGS-002	950-MFA-06201	B400-FGS-002	1x2x0,75mm2
36	C-55-LIT-001/00-JE-11005	55-LIT-001	00-JE-11005	1x2x0,75mm2
37	C-B100-TDC-001/B400-PCS-002	B100-TDC001	B400-PCS-002	1x2x0,75mm2
38	C-B100-TDC-002/B400-PCS-002	B100-TDC002	B400-PCS-002	1x2x0,75mm2
39	C-50-PT-001/00-JE-11004	50-PT-001	00-JE-11004	1x2x0.75mm2
40	C-50-PT-002/00-JE-11004	50-PT-002	00-JE-11004	1x2x0.75mm2
41	C-64-ZSL-031A/00-JE-12006	64-ZSL-031A	00-JE-12006	1x2x0.75mm2
42	C-64-ZSH-031A/00-JE-12006	64-ZSH-031A	00-JE-12006	1x2x0.75mm2
43	C-64-ZSL-031B/00-JE-12006	64-ZSL-031B	00-JE-12006	1x2x0.75mm2
44	C-64-ZSH-031B/00-JE-12006	64-ZSH-031B	00-JE-12006	1x2x0.75mm2
45	C-64-PT-031A/00-JE-11004	64-PT-031A	00-JE-11004	1x2x0.75mm2
46	C-64-PT-031B/00-JE-11004	64-PT-031B	00-JE-11004	1x2x0.75mm2
47	C-64-PY-031A/00-JE-11004	64-PY-031A	00-JE-11004	1x2x0.75mm2
48	C-64-PY-031B/00-JE-11004	64-PY-031B	00-JE-11004	1x2x0.75mm2
49	C-64-ZT-031A/00-JE-11005	64-ZT-031A	00-JE-11005	1x2x0.75mm2
50	C-64-ZT-031B/00-JE-11005	64-ZT-031B	00-JE-11005	1x2x0.75mm2
51	C-50-TT-001/00-JE-11004	50-TT-001	00-JE-11004	1x2x0.75 mm2
52	C-50-TT-002/00-JE-11004	50-TT-002	00-JE-11004	1x2x0.75 mm2
53	C-50-PT-014/00-JE-11004	50-PT-014	00-JE-11004	1x2x0.75 mm2
54	C-950-FDZ-05103/950-JE-05101	950-FDZ-5103	950-JE-05101	3x2.5 mm2
55	C-950-FDZ-05104/950-JE-05101	950-FDZ-5104	950-JE-05101	3x2.5 mm2
56	C-950-FDZ-06102/950-JE-06101	950-FDZ-06102	950-JE-06101	3x2.5 mm2

L-SEC-1L-L-150-101-IST-004

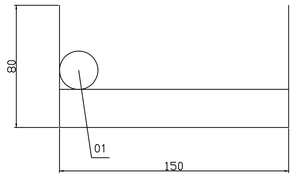


L-SEC-1L-L-150-101-IST-004				
POS	CABLENAME	FROM	TO	FORMATION
1	950-JE-06204/B400-FGS-002	950-JE-06204	B400-FGS-002	6x2x0,75mm2

L-SEC-1L-L-200-101-TLT-001

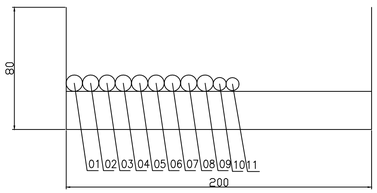


L-SEC-1L-L-200-101-TLT-001				
POS	CABLENAME	FROM	TO	FORMATION
1	TR-100AD1AVR/B400-NET-001	TR-100AD1AVR	B400-NET-001	CAT.6A4x2xAWG23
2	B100-HSB-001/B400-NET-001	B100-HSB-001	B400-NET-001	CAT.6A4x2xAWG23
3	SG-100D1/B400-NET-001.01	SG-100D1	B400-NET-001	CAT.6A4x2xAWG23
4	SG-100D1/B400-NET-001.02	SG-100D1	B400-NET-001	CAT.6A4x2xAWG23
5	SG-100D1/B400-NET-001.03	SG-100D1	B400-NET-001	CAT.6A4x2xAWG23
6	UP-200F1/B400-NET-001.01	UP-200F1	B400-NET-001	CAT.6A4x2xAWG23
7	UP-200F1/B400-NET-001.02	UP-200F1	B400-NET-001	CAT.6A4x2xAWG23
8	20-UCP-001/B400-NET-001.01	20-UCP-001	B400-NET-001	CAT.6A4x2xAWG23
9	20-UCP-001/B400-NET-001.02	20-UCP-001	B400-NET-001	CAT.6A4x2xAWG23
10	CP-100E1/B400-NET-001.01	CP-100E1	B400-NET-001	FO12OM2
11	CP-100E1/B400-NET-001.02	CP-100E1	B400-NET-001	FO12OM2

L-SEC-14-L-150-101-IST-040

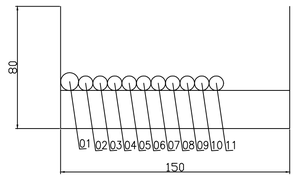


L-SEC-14-L-150-101-IST-040				
POS	CABLENAME	FROM	TO	FORMATION
1	C-64-PT-002/00-JE-21002	64-PT-002	00-JE-21002	1x2x0,75mm2
2	C-64-ZSL-031A/00-JE-12006	64-ZSL-031A	00-JE-12006	1x2x0.75mm2
3	C-64-ZSH-031A/00-JE-12006	64-ZSH-031A	00-JE-12006	1x2x0.75mm2
4	C-64-ZSL-031B/00-JE-12006	64-ZSL-031B	00-JE-12006	1x2x0.75mm2
5	C-64-ZSH-031B/00-JE-12006	64-ZSH-031B	00-JE-12006	1x2x0.75mm2
6	C-64-PT-031A/00-JE-11004	64-PT-031A	00-JE-11004	1x2x0.75mm2
7	C-64-PT-031B/00-JE-11004	64-PT-031B	00-JE-11004	1x2x0.75mm2
8	C-64-PY-031A/00-JE-11004	64-PY-031A	00-JE-11004	1x2x0.75mm2
9	C-64-PY-031B/00-JE-11004	64-PY-031B	00-JE-11004	1x2x0.75mm2
10	C-64-ZT-031A/00-JE-11005	64-ZT-031A	00-JE-11005	1x2x0.75mm2
11	C-64-ZT-031B/00-JE-11005	64-ZT-031B	00-JE-11005	1x2x0.75mm2

L-SEC-15-L-150-101-IST-030

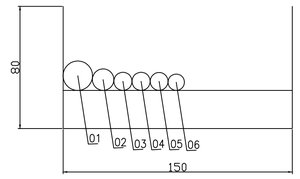


L-SEC-15-L-150-101-IST-030				
POS	CABLENAME	FROM	TO	FORMATION
1	20-UCP-001/B400-FGS-002	20-UCP-001	B400-FGS-002	2x2x0.75mm2
2	C-20-XS-001/B400-SIS-001	20-XS-001	B400-SIS-001	2x2.5mm2
3	20-UCP-001/B400-NET-001.01	20-UCP-001	B400-NET-001.01	CAT.6A4x2xAWG23
4	20-UCP-001/B400-NET-001.02	20-UCP-001	B400-NET-001.02	CAT.6A4x2xAWG23
5	C-20-XA-003/B400-SIS-001	20-XA-003	B400-SIS-001	1x2x0.75mm2
6	TR-100AD1AVR/B400-NET-001	TR-100AD1AVR	B400-NET-001	CAT.6A 4x2xAWG23

L-SEC-1M-L-200-101-TLT-001

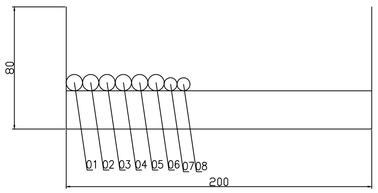

L-SEC-1M-L-200-101-TLT-001				
POS	CABLENAME	FROM	TO	FORMATION
1	B100-HSB-001/B400-NET-001	B100-HSB-001	B400-NET-001	CAT.6A4x2xAWG23
2	SG-100D1/B400-NET-001.01	SG-100D1	B400-NET-001	CAT.6A4x2xAWG23
3	SG-100D1/B400-NET-001.02	SG-100D1	B400-NET-001	CAT.6A4x2xAWG23
4	SG-100D1/B400-NET-001.03	SG-100D1	B400-NET-001	CAT.6A4x2xAWG23
5	UP-200F1/B400-NET-001.01	UP-200F1	B400-NET-001	CAT.6A4x2xAWG23
6	UP-200F1/B400-NET-001.02	UP-200F1	B400-NET-001	CAT.6A4x2xAWG23
7	CP-100E1/B400-NET-001.01	CP-100E1	B400-NET-001	FO12OM2
8	CP-100E1/B400-NET-001.02	CP-100E1	B400-NET-001	FO12OM2

L-SEC-1M-L-150-101-IST-004

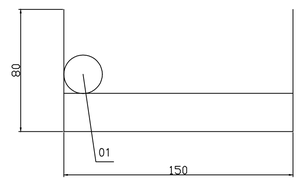

L-SEC-1M-L-150-101-IST-004				
POS	CABLENAME	FROM	TO	FORMATION
1	950-JE-06204/B400-FGS-002	950-JE-06204	B400-FGS-002	6x2x0,75mm2

INSERT SUBCONTRACTOR / VENDOR LOGO HERE

REV.	DATE	DRN	CHKD	APPD	DESCRIPTION
03	29/09/25	SPS	LCA	CGI	AS-BUILT (ASB)
02	04/10/24	VBA	LCA	DLO	ACCEPTED FOR CONSTRUCTION (AFC)
01	26/07/24	VBA	LCA	DLO	ACCEPTED FOR CONSTRUCTION (AFC)
00	22/12/23	VBA	LCA	DLO	ISSUE FOR REVIEW (IFR)

CROSSWIND

ROSETTI MARINO

TITLE :
BASE LOAD POWER HUB (BLPH)
INSTRUMENT MAIN CABLE ROUTING-LOWER DECK
TOS EL. TOS EL. 23.310M

CONTRACT NO./TITLE CW-I-WP4-2023-05/HOLLANDSE KUST NOORD WIND PARK | SCALE 1:150


DRAWN SPS | CHECKED LCA | APPROVED CGI | DATE 29/09/25

A1 | DRAWING NO. 123A90-DDL-IN-DL-40082 | SHEET 014 | REV. 03

File Name : 123A90-DDL-IN-DL-40082 REV:03.dwg


DRAWING NO. 123A90-DDL-IN-DL-40082 REV. 03

L-SEC-1M-L-600-101-IST-002

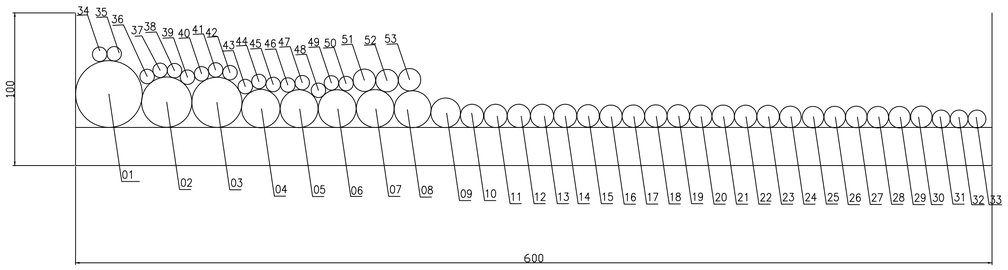


L-SEC-1M-L-600-101-IST-002				
POS	CABLENAME	FROM	TO	FORMATION
1	950-JE-05101/B400-FGS-002	950-JE-05101	B400-FGS-002	12x3x2,5mm2
2	950-JE-06101/B400-FGS-002	950-JE-06101	B400-FGS-002	6x3x2,5mm2
3	950-JE-06201/B400-FGS-002	950-JE-06201	B400-FGS-002	6x3x2,5mm2
4	B100-HSB-001/B400-FGS-002	B100-HSB-001	B400-FGS-002	6x2x0.75 mm2
5	00-JE-11004/B400-PCS-002	00-JE-11004	B400-PCS-002	12x2x0,75mm2
6	00-JE-12006_1/B400-PCS-002	00-JE-12006_1	B400-PCS-002	12x2x0,75mm2
7	00-JE-12006_2/B400-PCS-002	00-JE-12006_2	B400-PCS-002	12x2x0,75mm2
8	950-JE-06203/B400-FGS-002	950-JE-06203	B400-FGS-002	12x2,5mm2
9	00-JE-11005/B400-PCS-002	00-JE-11005	B400-PCS-002	6x2x0,75mm2
10	C-B100-TIR-001/B400-PCS-002	B100-TIR-001	B400-PCS-002	2x2x0,75mm2
11	C-50-XV-001/00-JE-12006	50-XV-001	00-JE-12006	2x2x0.75mm2
12	C-50-XV-002/00-JE-12006	50-XV-002	00-JE-12006	2x2x0.75mm2
13	C-50-XV-003/00-JE-12006	50-XV-003	00-JE-12006	2x2x0.75mm2
14	C-50-XV-004/00-JE-12006	50-XV-004	00-JE-12006	2x2x0.75mm2
15	C-950-FDZ-05101/950-JE-05101	950-FDZ-05101	950-JE-05101	3x2.5mm2
16	C-950-FDZ-05102/950-JE-05101	950-FDZ-05102	950-JE-05101	3x2.5mm2
17	C-950-GDZ-05101/950-JE-05101	950-GDZ-05101	950-JE-05101	3x2.5mm2
18	C-950-GDZ-05102/950-JE-05101	950-GDZ-05102	950-JE-05101	3x2.5mm2
19	C-950-GDZ-05103/950-JE-05101	950-GDZ-05103	950-JE-05101	3x2.5mm2
20	C-950-GDZ-05104/950-JE-05101	950-GDZ-05104	950-JE-05101	3x2.5mm2
21	C-950-GDZ-05105/950-JE-05101	950-GDZ-05105	950-JE-05101	3x2.5mm2
22	C-950-GDZ-05106/950-JE-05101	950-GDZ-05106	950-JE-05101	3x2.5mm2
23	C-950-FDZ-06101/950-JE-06101	950-FDZ-06101	950-JE-06101	3x2.5mm2
24	C-77-XS-001/B400-SIS-001	77-XS-001	B400-SIS-001	2x2,5mm2
25	C-CP-100E1/B400-SIS-001	CP-100E1	B400-SIS-001	2x2,5mm2
26	C-SG-100D1-001/B400-SIS-001	SG-100D1-001	B400-SIS-001	2x2,5mm2
27	C-SG-100D1-002/B400-SIS-001	SG-100D1-002	B400-SIS-001	2x2,5mm2
28	C-SG-100D1-003/B400-SIS-001	SG-100D1-003	B400-SIS-001	2x2,5mm2
29	C-CB-200F1/B400-SIS-001	CB-200F1	B400-SIS-001	2x2,5mm2
30	C-UP-200F1/B400-SIS-001	UP-200F1	B400-SIS-001	2x2,5mm2
31	C-77-XA-001/B400-SIS-001	77-XA-001	B400-SIS-001	1x2x0,75mm2
32	C-950-MFA-06201/B400-FGS-002	950-MFA-06201	B400-FGS-002	1x2x0,75mm2
33	C-55-LIT-001/00-JE-11005	55-LIT-001	00-JE-11005	1x2x0,75mm2
34	C-B100-TDC-001/B400-PCS-002	B100-TDC001	B400-PCS-002	1x2x0,75mm2
35	C-B100-TDC-002/B400-PCS-002	B100-TDC002	B400-PCS-002	1x2x0,75mm2
36	C-50-PT-001/00-JE-11004	50-PT-001	00-JE-11004	1x2x0.75mm2
37	C-50-PT-002/00-JE-11004	50-PT-002	00-JE-11004	1x2x0.75mm2
38	C-64-ZSL-031A/00-JE-12006	64-ZSL-031A	00-JE-12006	1x2x0.75mm2
39	C-64-ZSH-031A/00-JE-12006	64-ZSH-031A	00-JE-12006	1x2x0.75mm2
40	C-64-ZSL-031B/00-JE-12006	64-ZSL-031B	00-JE-12006	1x2x0.75mm2
41	C-64-ZSH-031B/00-JE-12006	64-ZSH-031B	00-JE-12006	1x2x0.75mm2
42	C-64-PT-031A/00-JE-11004	64-PT-031A	00-JE-11004	1x2x0.75mm2
43	C-64-PT-031B/00-JE-11004	64-PT-031B	00-JE-11004	1x2x0.75mm2
44	C-64-PY-031A/00-JE-11004	64-PY-031A	00-JE-11004	1x2x0.75mm2
45	C-64-PY-031B/00-JE-11004	64-PY-031B	00-JE-11004	1x2x0.75mm2
46	C-64-ZT-031A/00-JE-11005	64-ZT-031A	00-JE-11005	1x2x0.75mm2
47	C-64-ZT-031B/00-JE-11005	64-ZT-031B	00-JE-11005	1x2x0.75mm2
48	C-50-TT-001/00-JE-11004	50-TT-001	00-JE-11004	1x2x0.75 mm2
49	C-50-TT-002/00-JE-11004	50-TT-002	00-JE-11004	1x2x0.75 mm2
50	C-50-PT-014/00-JE-11004	50-PT-014	00-JE-11004	1x2x0.75 mm2
51	C-950-FDZ-05103/950-JE-05101	950-FDZ-05103	950-JE-05101	3x2.5 mm2
52	C-950-FDZ-05104/950-JE-05101	950-FDZ-05104	950-JE-05101	3x2.5 mm2
53	C-950-FDZ-06102/950-JE-06101	950-FDZ-06102	950-JE-06101	3x2.5 mm2

L-SEC-1N-L-200-101-TLT-001

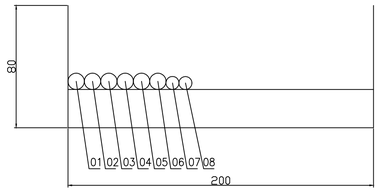


L-SEC-1N-L-200-101-TLT-001				
POS	CABLENAME	FROM	TO	FORMATION
1	B100-HSB-001/B400-NET-001	B100-HSB-001	B400-NET-001	CAT.6A4x2xAWG23
2	SG-100D1/B400-NET-001.01	SG-100D1	B400-NET-001	CAT.6A4x2xAWG23
3	SG-100D1/B400-NET-001.02	SG-100D1	B400-NET-001	CAT.6A4x2xAWG23
4	SG-100D1/B400-NET-001.03	SG-100D1	B400-NET-001	CAT.6A4x2xAWG23
5	UP-200F1/B400-NET-001.01	UP-200F1	B400-NET-001	CAT.6A4x2xAWG23
6	UP-200F1/B400-NET-001.02	UP-200F1	B400-NET-001	CAT.6A4x2xAWG23
7	CP-100E1/B400-NET-001.01	CP-100E1	B400-NET-001	FO12OM2
8	CP-100E1/B400-NET-001.02	CP-100E1	B400-NET-001	FO12OM2

L-SEC-1N-L-150-101-IST-004

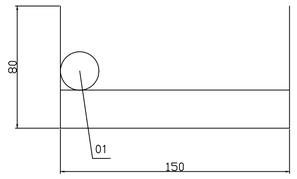


L-SEC-1N-L-150-101-IST-004				
POS	CABLENAME	FROM	TO	FORMATION
1	950-JE-06204/B400-FGS-002	950-JE-06204	B400-FGS-002	6x2x0,75mm2

L-SEC-16-L-300-101-IST-014

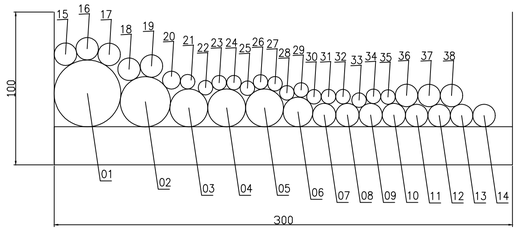

L-SEC-16-L-300-101-IST-014				
POS	CABLENAME	FROM	TO	FORMATION
1	950-JE-05101/B400-FGS-002	950-JE-05101	B400-FGS-002	12x3x2,5mm2
2	950-JE-06101/B400-FGS-002	950-JE-06101	B400-FGS-002	6x3x2,5mm2
3	00-JE-11004/B400-PCS-002	00-JE-11004	B400-PCS-002	12x2x0,75mm2
4	00-JE-12006_1/B400-PCS-002	00-JE-12006_1	B400-PCS-002	12x2x0,75mm2
5	00-JE-12006_2/B400-PCS-002	00-JE-12006_2	B400-PCS-002	12x2x0,75mm2
6	00-JE-11005/B400-PCS-002	00-JE-11005	B400-PCS-002	6x2x0,75mm2
7	C-50-XV-001/00-JE-12006	50-XV-001	00-JE-12006	2x2x0.75mm2
8	C-50-XV-002/00-JE-12006	50-XV-002	00-JE-12006	2x2x0.75mm2
9	C-50-XV-003/00-JE-12006	50-XV-003	00-JE-12006	2x2x0.75mm2
10	C-50-XV-004/00-JE-12006	50-XV-004	00-JE-12006	2x2x0.75mm2
11	C-950-FDZ-05101/950-JE-05101	950-FDZ-05101	950-JE-05101	3x2.5mm2
12	C-950-FDZ-05102/950-JE-05101	950-FDZ-05102	950-JE-05101	3x2.5mm2
13	C-950-GDZ-05101/950-JE-05101	950-GDZ-05101	950-JE-05101	3x2.5mm2
14	C-950-GDZ-05102/950-JE-05101	950-GDZ-05102	950-JE-05101	3x2.5mm2
15	C-950-GDZ-05103/950-JE-05101	950-GDZ-05103	950-JE-05101	3x2.5mm2
16	C-950-GDZ-05104/950-JE-05101	950-GDZ-05104	950-JE-05101	3x2.5mm2
17	C-950-GDZ-05105/950-JE-05101	950-GDZ-05105	950-JE-05101	3x2.5mm2
18	C-950-GDZ-05106/950-JE-05101	950-GDZ-05106	950-JE-05101	3x2.5mm2
19	C-950-FDZ-06101/950-JE-06101	950-FDZ-06101	950-JE-06101	3x2.5mm2
20	C-55-LIT-001/00-JE-11005	C-55-LIT-001	00-JE-11005	1x2x0,75mm2
21	C-50-PT-001/00-JE-11004	50-PT-001	00-JE-11004	1x2x0,75mm2
22	C-50-PT-002/00-JE-11004	50-PT-002	00-JE-11004	1x2x0,75mm2
23	C-64-ZSL-031A/00-JE-12006	64-ZSL-031A	00-JE-12006	1x2x0.75mm2
24	C-64-ZSH-031A/00-JE-12006	64-ZSH-031A	00-JE-12006	1x2x0.75mm2
25	C-64-ZSL-031B/00-JE-12006	64-ZSL-031B	00-JE-12006	1x2x0.75mm2
26	C-64-ZSH-031B/00-JE-12006	64-ZSH-031B	00-JE-12006	1x2x0.75mm2
27	C-64-PT-031A/00-JE-11004	64-PT-031A	00-JE-11004	1x2x0.75mm2
28	C-64-PT-031B/00-JE-11004	64-PT-031B	00-JE-11004	1x2x0.75mm2
29	C-64-PY-031A/00-JE-11004	64-PY-031A	00-JE-11004	1x2x0.75mm2
30	C-64-PY-031B/00-JE-11004	64-PY-031B	00-JE-11004	1x2x0.75mm2
31	C-64-ZT-031A/00-JE-11005	64-ZT-031A	00-JE-11005	1x2x0.75mm2
32	C-64-ZT-031B/00-JE-11005	64-ZT-031B	00-JE-11005	1x2x0.75mm2
33	C-50-TT-001/00-JE-11004	50-TT-001	00-JE-11004	1x2x0.75 mm2
34	C-50-TT-002/00-JE-11004	50-TT-002	00-JE-11004	1x2x0.75 mm2
35	C-50-PT-014/00-JE-11004	50-PT-014	00-JE-11004	1x2x0.75 mm2
36	C-950-FDZ-05103/950-JE-05101	950-FDZ-05103	950-JE-05101	3x2.5 mm2
37	C-950-FDZ-05104/950-JE-05101	950-FDZ-05104	950-JE-05101	3x2.5 mm2
38	C-950-FDZ-06102/950-JE-06101	950-FDZ-06102	950-JE-06101	3x2.5 mm2

L-SEC-1N-L-600-101-IST-002

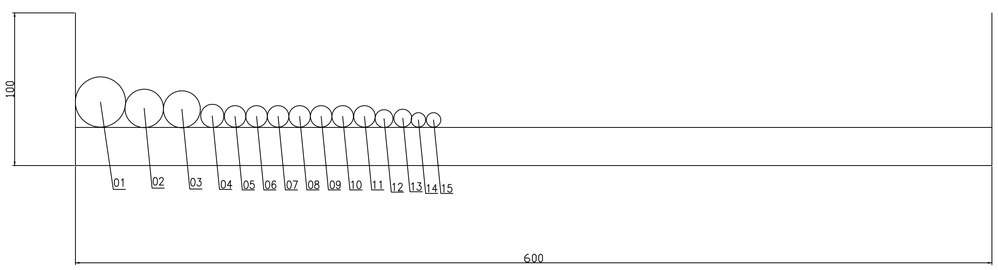

L-SEC-1N-L-600-101-IST-002				
POS	CABLENAME	FROM	TO	FORMATION
1	950-JE-06201/B400-FGS-002	950-JE-06201	B400-FGS-002	6x3x2,5mm2
2	B100-HSB-001/B400-FGS-002	950-JE-06202	B400-FGS-002	6x2x0,75mm2
3	950-JE-06203/B400-FGS-002	950-JE-06203	B400-FGS-002	12x2,5mm2
4	C-B100-TIR-001/B400-PCS-002	B100-TIR-001	B400-PCS-002	2x2x0,75mm2
5	C-77-XS-001/B400-SIS-001	77-XS-001	B400-SIS-001	2x2,5mm2
6	C-CP-100E1/B400-SIS-001	CP-100E1	B400-SIS-001	2x2,5mm2
7	C-SG-100D1-001/B400-SIS-001	SG-100D1-001	B400-SIS-001	2x2,5mm2
8	C-SG-100D1-002/B400-SIS-001	SG-100D1-002	B400-SIS-001	2x2,5mm2
9	C-SG-100D1-003/B400-SIS-001	SG-100D1-003	B400-SIS-001	2x2,5mm2
10	C-CB-200F1/B400-SIS-001	CB-200F1	B400-SIS-001	2x2,5mm2
11	C-UP-200F1/B400-SIS-001	UP-200F1	B400-SIS-001	2x2,5mm2
12	C-77-XA-001/B400-SIS-001	77-XA-001	B400-SIS-001	1x2x0,75mm2
13	C-950-MFA-06201/B400-FGS-002	950-MFA-06201	B400-FGS-002	1x2x0,75mm2
14	C-B100-TDC-001/B400-PCS-002	B100-TDC001	B400-PCS-002	1x2x0,75mm2
15	C-B100-TDC-002/B400-PCS-002	B100-TDC002	B400-PCS-002	1x2x0,75mm2

INSERT SUBCONTRACTOR / VENDOR LOGO HERE

REV.	DATE	DRN	CHKD	APPD	DESCRIPTION
03	29/09/25	SPS	LCA	CGI	AS-BUILT (ASB)
02	04/10/24	VBA	LCA	DLO	ACCEPTED FOR CONSTRUCTION (AFC)
01	26/07/24	VBA	LCA	DLO	ACCEPTED FOR CONSTRUCTION (AFC)
00	22/12/23	VBA	LCA	DLO	ISSUE FOR REVIEW (IFR)

CROSSWIND

ROSETTI MARINO

TITLE :
BASE LOAD POWER HUB (BLPH)
INSTRUMENT MAIN CABLE ROUTING-LOWER DECK
TOS EL. TOS EL. 23.310M

CONTRACT NO./TITLE CW-I-WP4-2023-05/HOLLANDSE KUST NOORD WIND PARK | SCALE 1:150

DRAWN SPS | CHECKED LCA | APPROVED CGI | DATE 29/09/25


A1 | DRAWING NO. 123A90-DDL-IN-DL-40082 | SHEET 015 | REV. 03

File Name : 123A90-DDL-IN-DL-40082 REV03.dwg

DRAWING NO.: 123A90-DDL-IN-DL-40082


REV.: 03

L-SEC-17-L-200-101-IST-034

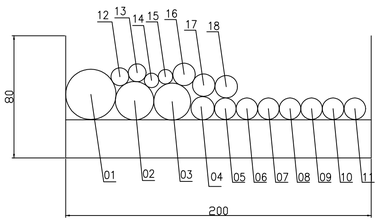


L-SEC-17-L-200-101-IST-034				
POS	CABLENAME	FROM	TO	FORMATION
1	950-JE-06201/B400-FGS-002	950-JE-06201	B400-FGS-002	6x3x2,5mm2
2	B100-HSB-001/B400-FGS-002	950-JE-06202	B400-FGS-002	6x2x0,75mm2
3	950-JE-06203/B400-FGS-002	950-JE-06203	B400-FGS-002	12x2,5mm2
4	C-B100-TIR-001/B400-PCS-002	B100-TIR-001	B400-PCS-002	2x2x0,75mm2
5	C-77-XS-001/B400-SIS-001	77-XS-001	B400-SIS-001	2x2,5mm2
6	C-CP-100E1/B400-SIS-001	CP-100E1	B400-SIS-001	2x2,5mm2
7	C-SG-100D1-001/B400-SIS-001	SG-100D1-001	B400-SIS-001	2x2,5mm2
8	C-SG-100D1-002/B400-SIS-001	SG-100D1-002	B400-SIS-001	2x2,5mm2
9	C-SG-100D1-003/B400-SIS-001	SG-100D1-003	B400-SIS-001	2x2,5mm2
10	C-CB-200F1/B400-SIS-001	CB-200F1	B400-SIS-001	2x2,5mm2
11	C-UP-200F1/B400-SIS-001	UP-200F1	B400-SIS-001	2x2,5mm2
12	C-77-XA-001/B400-SIS-001	77-XA-001	B400-SIS-001	1x2x0,75mm2
13	C-950-MFA-06201/B400-FGS-002	950-MFA-06201	B400-FGS-002	1x2x0,75mm2
14	C-B100-TDC-001/B400-PCS-002	B100-TDC001	B400-PCS-002	1x2x0,75mm2
15	C-B100-TDC-002/B400-PCS-002	B100-TDC002	B400-PCS-002	1x2x0,75mm2
16	C-950-GDZ-06201/950-JE-06201	950-GDZ-06201	950-JE-06201	3x2.5 mm2
17	C-950-GDZ-06202/950-JE-06201	950-GDZ-06202	950-JE-06201	3x2.5 mm2
18	C-950-GDZ-06203/950-JE-06201	950-GDZ-06203	950-JE-06201	3x2.5 mm2

L-SEC-17-L-150-101-IST-035

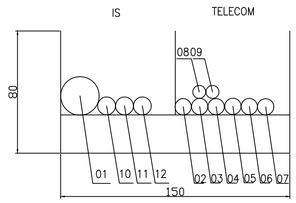


L-SEC-17-L-150-101-IST-035				
POS	CABLENAME	FROM	TO	FORMATION
1	950-JE-06204/B400-FGS-002	950-JE-062004	B400-FGS-002	6x2x0,75mm2
2	B100-HSB-001/B400-NET-001	B100-HSB-001	B400-NET-001	CAT.6A4x2xAWG23
3	SG-100D1/B400-NET-001.01	SG-100D1	B400-NET-001	CAT.6A4x2xAWG23
4	SG-100D1/B400-NET-001.02	SG-100D1	B400-NET-001	CAT.6A4x2xAWG23
5	SG-100D1/B400-NET-001.03	SG-100D1	B400-NET-001	CAT.6A4x2xAWG23
6	UP-200F1/B400-NET-001.01	UP-200F1	B400-NET-001	CAT.6A4x2xAWG23
7	UP-200F1/B400-NET-001.02	UP-200F1	B400-NET-001	CAT.6A4x2xAWG23
8	CP-100E1/B400-NET-001.01	CP-100E1	B400-NET-001	FO12OM2
9	CP-100E1/B400-NET-001.02	CP-100E1	B400-NET-001	FO12OM2
10	C-950-SDZ-06201/950-JE-06204	950-SDZ-06201	950-JE-06204	1x2x0.75 mm2
11	C-950-SDZ-06202/950-JE-06204	950-SDZ-06202	950-JE-06204	1x2x0.75 mm2
12	C-950-SDZ-06203/950-JE-06204	950-SDZ-06203	950-JE-06204	1x2x0.75 mm2

L-SEC-18A-L-600-101-IST-001

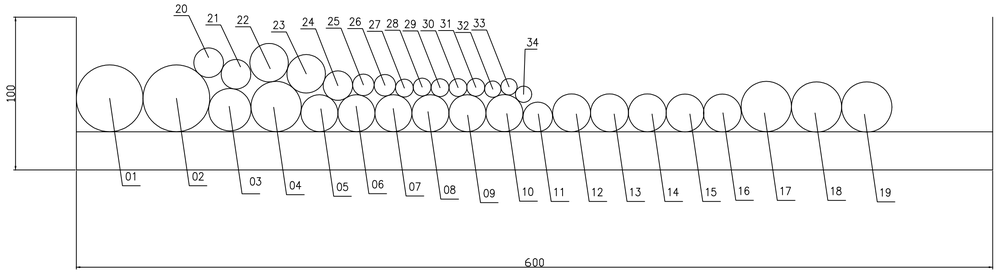


L-SEC-18A-L-600-101-IST-001				
POS	CABLE NAME	FROM	TO	FORMATION
1	950-JE-02101/B400-FGS-002	950-JE-021001	B400-FGS-002	12x3x2,5 mm2
2	950-JE-02102/B400-FGS-002	950-JE-021002	B400-FGS-002	12x3x2,5 mm2
3	00-JE-13001/B400-PCS-002	00-JE-13001	B400-PCS-002	24x2,5 mm2
4	950-JE-03102/B400-FGS-002	950-JE-031002	B400-FGS-002	6x3x2,5 mm2
5	00-JE-23001/B400-SIS-001	00-JE-23001	B400-SIS-001	12x2,5 mm2
6	950-JE-02104/B400-FGS-002	950-JE-021004	B400-FGS-002	12x2,5 mm2
7	950-JE-03104/B400-FGS-002	950-JE-031004	B400-FGS-002	12x2,5 mm2
8	950-JE-06103/B400-FGS-002	950-JE-061003	B400-FGS-002	12x2,5 mm2
9	950-JE-07101/B400-FGS-002	950-JE-071001	B400-FGS-002	12x2,5 mm2
10	950-JE-05104/B400-FGS-002	950-JE-051004	B400-FGS-002	12x2,5 mm2
11	80-UCP-001/B400-FGS-002	80-FGS-001	B400-FGS-002	2x2x0.75 mm2
12	00-JE-11001_1/B400-PCS-002	00-JE-11001_1	B400-PCS-002	12x2x0,75 mm2
13	00-JE-11001_2/B400-PCS-002	00-JE-11001_2	B400-PCS-002	12x2x0,75 mm2
14	00-JE-11002/B400-PCS-002	00-JE-11002_1	B400-PCS-002	12x2x0,75 mm2
15	00-JE-12001_1/B400-PCS-002	00-JE-12001_1	B400-PCS-002	12x2x0,75 mm2
16	00-JE-12001_2/B400-PCS-002	00-JE-12001_2	B400-PCS-002	12x2x0,75 mm2
17	00-JE-21001/B400-SIS-001	00-JE-21001	B400-SIS-001	12x2x0,75 mm2
18	00-JE-22001_1/B400-SIS-001	00-JE-22001_1	B400-SIS-001	12x2x0,75 mm2
19	00-JE-22001_2/B400-SIS-001	00-JE-22001_2	B400-SIS-001	12x2x0,75 mm2
20	00-JE-12002/B400-PCS-002	00-JE-12002	B400-PCS-002	6x2x0,75 mm2
21	00-JE-12003/B400-PCS-002	00-JE-12003	B400-PCS-002	6x2x0,75 mm2
22	950-JE-03103/B400-FGS-002	950-JE-031003	B400-FGS-002	6x2x0,75 mm2
23	950-JE-06102/B400-FGS-002	950-JE-061002	B400-FGS-002	6x2x0,75 mm2
24	50-LP-002/B400-FGS-002	50-LP-002	B400-FGS-002	2x2x0,75 mm2
25	C-80-XS-001/B400-SIS-001	80-XS-001	B400-SIS-001	2x2,5 mm2
26	C-50-XS-001/B400-SIS-001	50-XS-001	B400-SIS-001	2x2,5 mm2
27	C-80-XA-003/B400-SIS-001	80-XA-003	B400-SIS-001	1x2x0,75 mm2
28	C-50-XA-003/B400-SIS-001	50-XA-003	B400-SIS-001	1x2x0,75 mm2
29	C-950-MFA-02101/B400-FGS-002	950-MFA-02101	B400-FGS-002	1x2x0,75 mm2
30	C-950-MFA-07101/B400-FGS-002	950-MFA-07101	B400-FGS-002	1x2x0,75 mm2
31	C-950-MFA-05201/B400-FGS-002	950-MFA-05201	B400-FGS-002	1x2x0,75 mm2
32	80-UCP-001/B400-NET-001.01	80-UCP-001	B400-NET-001.01	CAT.6A 4x2xAWG23
33	80-UCP-001/B400-NET-001.02	80-UCP-001	B400-NET-001.02	CAT.6A 4x2xAWG23
34	50-LP-001/B400-NET-001	50-LP-001	B400-NET-001	CAT.6A 4x2xAWG23

L-SEC-18B-L-600-101-IST-001

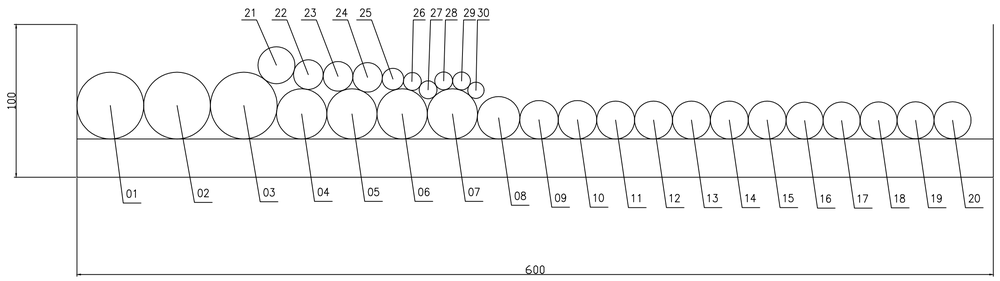

L-SEC-18B-L-600-101-IST-001				
POS	CABLE NAME	FROM	TO	FORMATION
1	950-JE-02101/B400-FGS-002	950-JE-021001	B400-FGS-002	12x3x2,5 mm2
2	950-JE-02102/B400-FGS-002	950-JE-021002	B400-FGS-002	12x3x2,5 mm2
3	00-JE-13001/B400-PCS-002	00-JE-13001	B400-PCS-002	24x2,5 mm2
4	950-JE-03102/B400-FGS-002	950-JE-031002	B400-FGS-002	6x3x2,5 mm2
5	00-JE-23001/B400-SIS-001	00-JE-23001	B400-SIS-001	12x2,5 mm2
6	950-JE-02104/B400-FGS-002	950-JE-021004	B400-FGS-002	12x2,5 mm2
7	950-JE-03104/B400-FGS-002	950-JE-031004	B400-FGS-002	12x2,5 mm2
8	950-JE-06103/B400-FGS-002	950-JE-061003	B400-FGS-002	12x2,5 mm2
9	950-JE-07101/B400-FGS-002	950-JE-071001	B400-FGS-002	12x2,5 mm2
10	950-JE-05104/B400-FGS-002	950-JE-051004	B400-FGS-002	12x2,5 mm2
11	00-JE-11001_1/B400-PCS-002	00-JE-11001_1	B400-PCS-002	12x2x0,75 mm2
12	00-JE-11001_2/B400-PCS-002	00-JE-11001_2	B400-PCS-002	12x2x0,75 mm2
13	00-JE-11002/B400-PCS-002	00-JE-11002_1	B400-PCS-002	12x2x0,75 mm2
14	00-JE-12001_1/B400-PCS-002	00-JE-12001_1	B400-PCS-002	12x2x0,75 mm2
15	00-JE-12001_2/B400-PCS-002	00-JE-12001_2	B400-PCS-002	12x2x0,75 mm2
16	00-JE-21001/B400-SIS-001	00-JE-21001	B400-SIS-001	12x2x0,75 mm2
17	00-JE-22001_1/B400-SIS-001	00-JE-22001_1	B400-SIS-001	12x2x0,75 mm2
18	00-JE-22001_2/B400-SIS-001	00-JE-22001_2	B400-SIS-001	12x2x0,75 mm2
19	00-JE-12002/B400-PCS-002	00-JE-12002	B400-PCS-002	6x2x0,75 mm2
20	00-JE-12003/B400-PCS-002	00-JE-12003	B400-PCS-002	6x2x0,75 mm2
21	950-JE-03103/B400-FGS-002	950-JE-031003	B400-FGS-002	6x2x0,75 mm2
22	950-JE-06102/B400-FGS-002	950-JE-061002	B400-FGS-002	6x2x0,75 mm2
23	50-LP-002/B400-FGS-002	50-LP-002	B400-FGS-002	2x2x0,75 mm2
24	C-50-XS-001/B400-SIS-001	50-XS-001	B400-SIS-001	2x2,5 mm2
25	C-50-XA-003/B400-SIS-001	50-XA-003	B400-SIS-001	1x2x0,75 mm2
26	C-950-MFA-02101/B400-FGS-002	950-MFA-02101	B400-FGS-002	1x2x0,75 mm2
27	C-950-MFA-07101/B400-FGS-002	950-MFA-07101	B400-FGS-002	1x2x0,75 mm2
28	C-950-MFA-05201/B400-FGS-002	950-MFA-05201	B400-FGS-002	1x2x0,75 mm2
29	C-950-FDZ-04103/950-JE-04101	950-FDZ-04103	950-JE-04101	3x2,5 mm2
30	50-LP-001/B400-NET-001	50-LP-001	B400-NET-001	CAT.6A 4x2xAWG23

L-SEC-19-L-150-101-IST-015

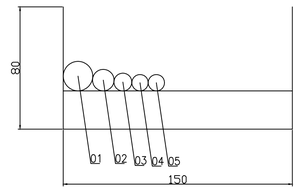

L-SEC-19-L-150-101-IST-015				
POS	CABLE NAME	FROM	TO	FORMATION
1	80-UCP-001/B400-FGS-002	80-FGS-001	B400-FGS-002	2x2x0.75 mm2
2	C-80-XS-001/B400-SIS-001	80-XS-001	B400-SIS-001	2x2,5 mm2
3	80-UCP-001/B400-NET-001.01	80-UCP-001	B400-NET-001.01	CAT.6A 4x2xAWG23
4	80-UCP-001/B400-NET-001.02	80-UCP-001	B400-NET-001.02	CAT.6A 4x2xAWG23
5	C-80-XA-003/B400-SIS-001	80-XA-003	B400-SIS-001	1x2x0,75 mm2

INSERT SUBCONTRACTOR / VENDOR LOGO HERE

REV.	DATE	DRN	CHKD	APPD	DESCRIPTION
03	29/09/25	SPS	LCA	CGI	AS-BUILT (ASB)
02	04/10/24	VBA	LCA	DLO	ACCEPTED FOR CONSTRUCTION (AFC)
01	26/07/24	VBA	LCA	DLO	ACCEPTED FOR CONSTRUCTION (AFC)
00	22/12/23	VBA	LCA	DLO	ISSUE FOR REVIEW (IFR)

CROSSWIND

ROSETTI MARINO

TITLE :
BASE LOAD POWER HUB (BLPH)
INSTRUMENT MAIN CABLE ROUTING-LOWER DECK
TOS EL. TOS EL. 23.310M

CONTRACT NO./TITLE CW-I-WP4-2023-05/HOLLANDSE KUST NOORD WIND PARK | SCALE 1:150

DRAWN SPS | CHECKED LCA | APPROVED CGI | DATE 29/09/25


A1 | DRAWING NO. 123A90-DDL-IN-DL-40082 | SHEET 016 | REV. 03

File Name : 123A90-DDL-IN-DL-40082 REV03.dwg

DRAWING NO. 123A90-DDL-IN-DL-40082


REV. 03

L-SEC-20-L-300-101-IST-027

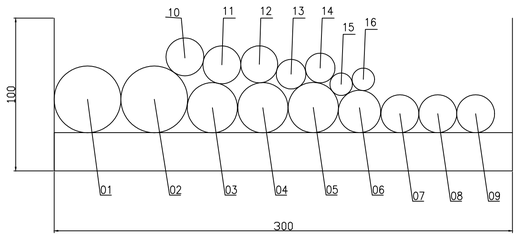


L-SEC-20-L-300-101-IST-027				
POS	CABLE NAME	FROM	TO	FORMATION
1	950-JE-02101/B400-FGS-002	950-JE-021001	B400-FGS-002	12x3x2,5 mm2
2	950-JE-02102/B400-FGS-002	950-JE-021002	B400-FGS-002	12x3x2,5 mm2
3	00-JE-21001/B400-SIS-001	00-JE-21001	B400-SIS-001	12x2x0,75 mm2
4	00-JE-22001_1/B400-SIS-001	00-JE-22001_1	B400-SIS-001	12x2x0,75 mm2
5	00-JE-22001_2/B400-SIS-001	00-JE-22001_2	B400-SIS-001	12x2x0,75 mm2
6	00-JE-13001/B400-PCS-002	00-JE-13001	B400-PCS-002	24x2,5 mm2
7	00-JE-11001_1/B400-PCS-002	00-JE-11001_1	B400-PCS-002	12x2x0,75 mm2
8	00-JE-11001_2/B400-PCS-002	00-JE-11001_2	B400-PCS-002	12x2x0,75 mm2
9	00-JE-11002/B400-PCS-002	00-JE-11002_1	B400-PCS-002	12x2x0,75 mm2
10	00-JE-12001_1/B400-PCS-002	00-JE-12001_1	B400-PCS-002	12x2x0,75 mm2
11	00-JE-12001_2/B400-PCS-002	00-JE-12001_2	B400-PCS-002	12x2x0,75 mm2
12	00-JE-23001/B400-SIS-001	00-JE-23001	B400-SIS-001	12x2,5 mm2
13	00-JE-12002/B400-PCS-002	00-JE-12002	B400-PCS-002	6x2x0,75 mm2
14	00-JE-12003/B400-PCS-002	00-JE-12003	B400-PCS-002	6x2x0,75 mm2
15	C-950-FDZ-02103/950-JE-02101	950-FDZ-02103	950-JE-02101	3x2.5 mm2
16	C-950-FDZ-02104/950-JE-02101	950-FDZ-02104	950-JE-02101	3x2.5 mm2

L-SEC-18C-L-600-101-IST-001

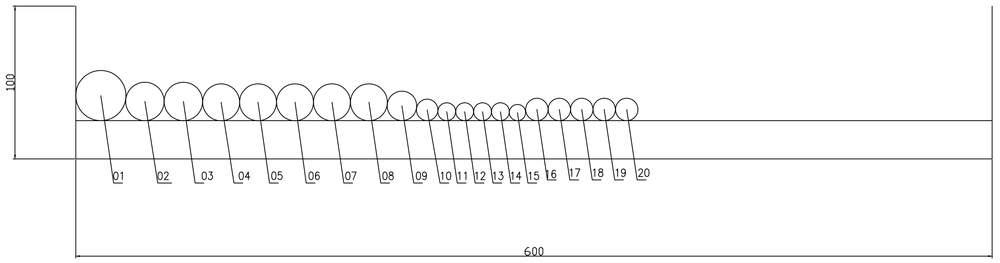


L-SEC-18C-L-600-101-IST-001				
POS	CABLE NAME	FROM	TO	FORMATION
1	950-JE-03102/B400-FGS-002	950-JE-031002	B400-FGS-002	6x3x2,5 mm2
2	950-JE-03103/B400-FGS-002	950-JE-031003	B400-FGS-002	6x2x0,75 mm2
3	950-JE-06102/B400-FGS-002	950-JE-061002	B400-FGS-002	6x2x0,75 mm2
4	950-JE-02104/B400-FGS-002	950-JE-021004	B400-FGS-002	12x2,5 mm2
5	950-JE-03104/B400-FGS-002	950-JE-031004	B400-FGS-002	12x2,5 mm2
6	950-JE-06103/B400-FGS-002	950-JE-061003	B400-FGS-002	12x2,5 mm2
7	950-JE-07101/B400-FGS-002	950-JE-071001	B400-FGS-002	12x2,5 mm2
8	950-JE-05104/B400-FGS-002	950-JE-051004	B400-FGS-002	12x2,5 mm2
9	50-LP-002/B400-FGS-002	50-LP-002	B400-FGS-002	2x2x0,75 mm2
10	C-50-XS-001/B400-SIS-001	50-XS-001	B400-SIS-001	2x2,5 mm2
11	C-50-XA-003/B400-SIS-001	50-XA-003	B400-SIS-001	1x2x0,75 mm2
12	C-950-MFA-02101/B400-FGS-002	950-MFA-02101	B400-FGS-002	1x2x0,75 mm2
13	C-950-MFA-07101/B400-FGS-002	950-MFA-07101	B400-FGS-002	1x2x0,75 mm2
14	C-950-MFA-05201/B400-FGS-002	950-MFA-05201	B400-FGS-002	1x2x0,75 mm2
15	50-LP-001/B400-NET-001	50-LP-001	B400-NET-001	CAT.6A 4x2xAWG23
16	C-950-FDZ-02103/950-JE-02101	950-FDZ-02103	950-JE-02101	3x2.5 mm2
17	C-950-FDZ-02104/950-JE-02101	950-FDZ-02104	950-JE-02101	3x2.5 mm2
18	C-950-FDZ-04103/950-JE-04101	950-FDZ-04103	950-JE-04101	3x2.5 mm2
19	C-950-FDZ-04104/950-JE-04101	950-FDZ-04104	950-JE-04101	3x2.5 mm2
20	C-950-FDZ-05103/950-JE-05101	950-FDZ-05103	950-JE-05101	3x2.5 mm2

L-SEC-21-L-150-101-IST-036

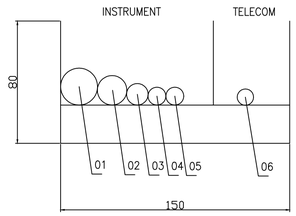


L-SEC-21-L-150-101-IST-036				
POS	CABLE NAME	FROM	TO	FORMATION
1	950-JE-05104/B400-FGS-002	950-JE-051004	B400-FGS-002	12x2,5 mm2
2	50-LP-002/B400-FGS-002	50-LP-002	B400-FGS-002	2x2x0,75 mm2
3	C-50-XS-001/B400-SIS-001	50-XS-001	B400-SIS-001	2x2,5 mm2
4	C-50-XA-003/B400-SIS-001	50-XA-003	B400-SIS-001	1x2x0,75 mm2
5	C-950-MFA-05201/B400-FGS-002	950-MFA-05201	B400-FGS-002	1x2x0,75 mm2
6	50-LP-001/B400-NET-001	50-LP-001	B400-NET-001	CAT.6A 4x2xAWG23

L-SEC-22-L-200-101-IST-026

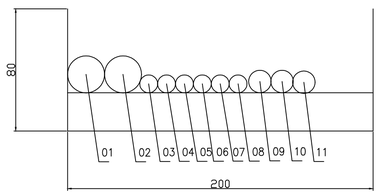

L-SEC-22-L-200-101-IST-026				
POS	CABLE NAME	FROM	TO	FORMATION
1	950-JE-02104/B400-FGS-002	950-JE-021004	B400-FGS-002	12x2,5 mm2
2	950-JE-07101/B400-FGS-002	950-JE-071001	B400-FGS-002	12x2,5 mm2
3	C-950-MFA-02101/B400-FGS-002	950-MFA-02101	B400-FGS-002	1x2x0,75 mm2
4	C-950-MFA-07101/B400-FGS-002	950-MFA-07101	B400-FGS-002	1x2x0,75 mm2
5	C-950-ASD-07101/00-JE-22002	950-ASD-07101	00-JE-22002	1x2x0,75 mm2
6	C-950-MOB-07101/00-JE-22002	950-MOB-07101	00-JE-22002	1x2x0,75 mm2
7	C-950-ESD-07101/00-JE-22002	950-ESD-07101	00-JE-22002	1x2x0,75 mm2
8	C-950-ESDD-07101/00-JE-22002	950-ESDD-07101	00-JE-22002	1x2x0,75 mm2
9	C-950-FDZ-01104/950-JE-01101	950-FDZ-01104	950-JE-01101	3x2.5 mm2
10	C-950-FDZ-02103/950-JE-02101	950-FDZ-02103	950-JE-02101	3x2.5 mm2
11	C-950-FDZ-02104/950-JE-02101	950-FDZ-02104	950-JE-02101	3x2.5 mm2

L-SEC-23-L-200-101-IST-031

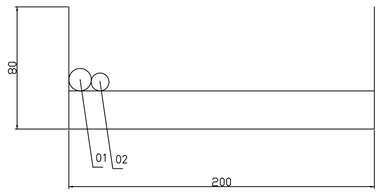

L-SEC-23-L-200-101-IST-031				
POS	CABLE NAME	FROM	TO	FORMATION
1	C-950-XZ-05104/950-JE-05103	950-XZ-05104	950-JE-05103	2x2.5 mm2
2	C-950-MFA-05104/950-JE-05102	950-MFA-05104	950-JE-05102	1x2x0.75 mm2

INSERT SUBCONTRACTOR / VENDOR LOGO HERE

REV.	DATE	DRN	CHKD	APPD	DESCRIPTION
03	29/09/25	SPS	LCA	CGI	AS-BUILT (ASB)
02	04/10/24	VBA	LCA	DLO	ACCEPTED FOR CONSTRUCTION (AFC)
01	26/07/24	VBA	LCA	DLO	ACCEPTED FOR CONSTRUCTION (AFC)
00	22/12/23	VBA	LCA	DLO	ISSUE FOR REVIEW (IFR)

CROSSWIND

ROSETTI MARINO

TITLE :
BASE LOAD POWER HUB (BLPH)
INSTRUMENT MAIN CABLE ROUTING-LOWER DECK
TOS EL. TOS EL. 23.310M

CONTRACT NO./TITLE CW-I-WP4-2023-05/HOLLANDSE KUST NOORD WIND PARK | SCALE 1:150

DRAWN SPS | CHECKED LCA | APPROVED CGI | DATE 29/09/25


A1 | DRAWING NO. 123A90-DDL-IN-DL-40082 | SHEET 017 | REV. 03

File Name : 123A90-DDL-IN-DL-40082 REV03.dwg

DRAWING NO. 123A90-DDL-IN-DL-40082


REV. 03

L-SEC-18D-L-600-101-IST-001

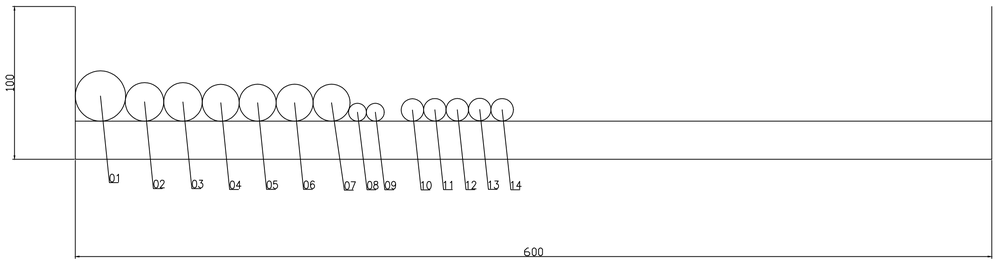


L-SEC-18D-L-600-101-IST-001				
POS	CABLE NAME	FROM	TO	FORMATION
1	950-JE-03102/B400-FGS-002	950-JE-031002	B400-FGS-002	6x3x2,5 mm2
2	950-JE-03103/B400-FGS-002	950-JE-031003	B400-FGS-002	6x2x0,75 mm2
3	950-JE-06102/B400-FGS-002	950-JE-061002	B400-FGS-002	6x2x0,75 mm2
4	950-JE-02104/B400-FGS-002	950-JE-021004	B400-FGS-002	12x2,5 mm2
5	950-JE-03104/B400-FGS-002	950-JE-031004	B400-FGS-002	12x2,5 mm2
6	950-JE-06103/B400-FGS-002	950-JE-061003	B400-FGS-002	12x2,5 mm2
7	950-JE-07101/B400-FGS-002	950-JE-071001	B400-FGS-002	12x2,5 mm2
8	C-950-MFA-02101/B400-FGS-002	950-MFA-02101	B400-FGS-002	1x2x0,75 mm2
9	C-950-MFA-07101/B400-FGS-002	950-MFA-07101	B400-FGS-002	1x2x0,75 mm2
10	C-950-FDZ-02103/950-JE-02101	950-FDZ-02103	950-JE-02101	3x2.5 mm2
11	C-950-FDZ-02104/950-JE-02101	950-FDZ-02104	950-JE-02101	3x2.5 mm2
12	C-950-FDZ-04103/950-JE-04101	950-FDZ-04103	950-JE-04101	3x2.5 mm2
13	C-950-FDZ-04104/950-JE-04101	950-FDZ-04104	950-JE-04101	3x2.5 mm2
14	C-950-FDZ-05103/950-JE-05101	950-FDZ-05103	950-JE-05101	3x2.5 mm2

L-SEC-18E-L-600-101-IST-001

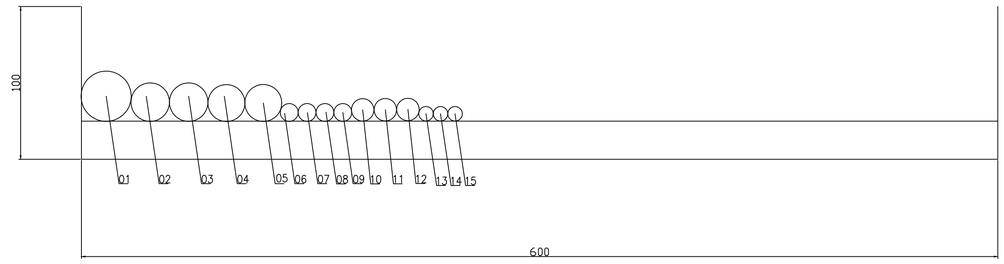

L-SEC-18E-L-450-101-IST-001				
POS	CABLE NAME	FROM	TO	FORMATION
1	950-JE-03102/B400-FGS-002	950-JE-031002	B400-FGS-002	6x3x2,5 mm2
2	950-JE-03103/B400-FGS-002	950-JE-031003	B400-FGS-002	6x2x0,75 mm2
3	950-JE-06102/B400-FGS-002	950-JE-061002	B400-FGS-002	6x2x0,75 mm2
4	950-JE-03104/B400-FGS-002	950-JE-031004	B400-FGS-002	12x2,5 mm2
5	950-JE-06103/B400-FGS-002	950-JE-061003	B400-FGS-002	12x2,5 mm2
6	C-950-ASD-07101/00-JE-22002	950-ASD-07101	00-JE-22002	1x2x0,75 mm2
7	C-950-MOB-07101/00-JE-22002	950-MOB-07101	00-JE-22002	1x2x0,75 mm2
8	C-950-ESD-07101/00-JE-22002	950-ESD-07101	00-JE-22002	1x2x0,75 mm2
9	C-950-ESDD-07101/00-JE-22002	950-ESDD-07101	00-JE-22002	1x2x0,75 mm2
10	C-950-FDZ-01104/950-JE-01101	950-FDZ-01104	950-JE-01101	3x2.5 mm2
11	C-950-FDZ-04103/950-JE-04101	950-FDZ-02103	950-JE-02101	3x2.5 mm2
12	C-950-FDZ-04104/950-JE-04101	950-FDZ-02104	950-JE-02101	3x2.5 mm2
13	C-50-TT-001/00-JE-11004	50-TT-001	00-JE-11004	1x2x0.75 mm2
14	C-50-TT-002/00-JE-11004	50-TT-002	00-JE-11004	1x2x0.75 mm2
15	C-50-PT-014/00-JE-11004	50-PT-014	00-JE-11004	1x2x0.75 mm2

L-SEC-18F-L-450-101-IST-003

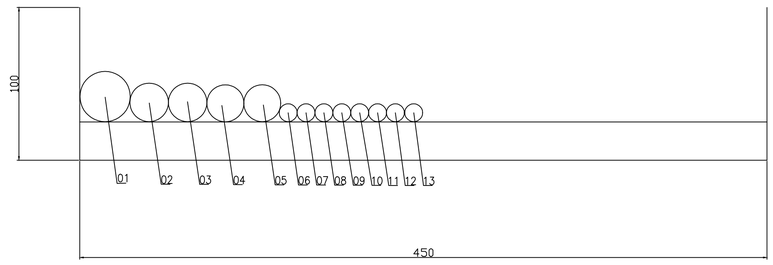

L-SEC-18F-L-450-101-IST-003				
POS	CABLE NAME	FROM	TO	FORMATION
1	950-JE-03102/B400-FGS-002	950-JE-031002	B400-FGS-002	6x3x2,5 mm2
2	950-JE-03103/B400-FGS-002	950-JE-031003	B400-FGS-002	6x2x0,75 mm2
3	950-JE-06102/B400-FGS-002	950-JE-061002	B400-FGS-002	6x2x0,75 mm2
4	950-JE-03104/B400-FGS-002	950-JE-031004	B400-FGS-002	12x2,5 mm2
5	950-JE-06103/B400-FGS-002	950-JE-061003	B400-FGS-002	12x2,5 mm2
6	C-950-ASD-03101/00-JE-22002	950-ASD-03101	00-JE-22002	1x2x0,75 mm2
7	C-950-MOB-03101/00-JE-22002	C-950-MOB-03101	00-JE-22002	1x2x0,75 mm2
8	C-950-ESD-03101/00-JE-22002	C-950-ESD-03101	00-JE-22002	1x2x0,75 mm2
9	C-950-ESDD-03101/00-JE-22002	C-950-ESDD-03101	00-JE-22002	1x2x0,75 mm2
10	C-950-ASD-06101/00-JE-22002	950-ASD-06101	00-JE-22002	1x2x0,75 mm2
11	C-950-MOB-06101/00-JE-22002	950-MOB-06101	00-JE-22002	1x2x0,75 mm2
12	C-950-ESD-06101/00-JE-22002	950-ESD-06101	00-JE-22002	1x2x0,75 mm2
13	C-950-ESDD-06101/00-JE-22002	950-ESDD-06101	00-JE-22002	1x2x0,75 mm2

INSERT SUBCONTRACTOR / VENDOR LOGO HERE

REV.	DATE	DRN	CHKD	APPD	DESCRIPTION
03	29/09/25	SPS	LCA	CGI	AS-BUILT (ASB)
02	04/10/24	VBA	LCA	DLO	ACCEPTED FOR CONSTRUCTION (AFC)
01	26/07/24	VBA	LCA	DLO	ACCEPTED FOR CONSTRUCTION (AFC)
00	22/12/23	VBA	LCA	DLO	ISSUE FOR REVIEW (IFR)

CROSSWIND

ROSETTI MARINO

TITLE :
BASE LOAD POWER HUB (BLPH)
INSTRUMENT MAIN CABLE ROUTING-LOWER DECK
TOS EL. TOS EL. 23.310M

CONTRACT NO./TITLE CW-I-WP4-2023-05/HOLLANDSE KUST NOORD WIND PARK | SCALE 1:150

DRAWN SPS | CHECKED LCA | APPROVED CGI | DATE 29/09/25


A1 | DRAWING NO. 123A90-DDL-IN-DL-40082 | SHEET 018 | REV. 03

File Name : 123A90-DDL-IN-DL-40082 REV03.dwg

DRAWING NO. 123A90-DDL-IN-DL-40082


REV. 03

L-SEC-24-L-200-101-IST-031

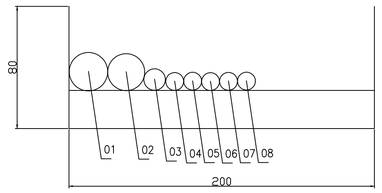


L-SEC-24-L-200-101-IST-031				
POS	CABLE NAME	FROM	TO	FORMATION
1	950-JE-06102/B400-FGS-002	950-JE-061002	B400-FGS-002	6x2x0,75 mm2
2	950-JE-06103/B400-FGS-002	950-JE-061003	B400-FGS-002	12x2,5 mm2
3	C-950-XZ-05104/950-JE-05103	950-XZ-05104	950-JE-05103	2x2.5 mm2
4	C-950-ASD-06101/00-JE-22002	950-ASD-06101	00-JE-22002	1x2x0,75 mm2
5	C-950-MOB-06101/00-JE-22002	950-MOB-06101	00-JE-22002	1x2x0,75 mm2
6	C-950-ESD-06101/00-JE-22002	950-ESD-06101	00-JE-22002	1x2x0,75 mm2
7	C-950-ESDD-06101/00-JE-22002	950-ESDD-06101	00-JE-22002	1x2x0,75 mm2
8	C-950-MFA-05104/950-JE-05102	950-MFA-05104	950-JE-05102	1x2x0.75 mm2

L-SEC-25-L-200-101-IST-031

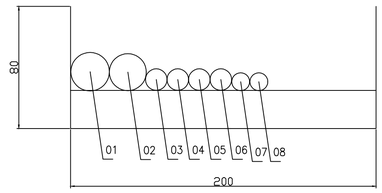


L-SEC-25-L-200-101-IST-031				
POS	CABLE NAME	FROM	TO	FORMATION
1	950-JE-06102/B400-FGS-002	950-JE-061002	B400-FGS-002	6x2x0,75 mm2
2	950-JE-06103/B400-FGS-002	950-JE-061003	B400-FGS-002	12x2,5 mm2
3	C-950-XL-06101/950-JE-06103	C-950-XL-06101	950-JE-06103	2x2.5 mm2
4	C-950-XL-06102/950-JE-06103	C-950-XL-06102	950-JE-06103	2x2.5 mm2
5	C-950-XZ-06101/950-JE-06103	950-XZ-06101	950-JE-06103	2x2.5 mm2
6	C-950-XZ-05104/950-JE-05103	950-XZ-05104	950-JE-05103	2x2.5 mm2
7	C-950-MFA-06101/950-JE-06102	950-MFA-06101	950-JE-06102	1x2x0.75 mm2
8	C-950-MFA-05104/950-JE-05102	950-MFA-05104	950-JE-05102	1x2x0.75 mm2

L-SEC-26-L-200-101-IST-024

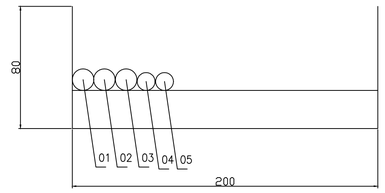


L-SEC-26-L-200-101-IST-024				
POS	CABLE NAME	FROM	TO	FORMATION
1	C-950-XL-06103/950-JE-06103	950-XL-06103	950-JE-06103	2x2.5 mm2
2	C-950-XL-06104/950-JE-06103	950-XL-06104	950-JE-06103	2x2.5 mm2
3	C-950-XZ-05104/950-JE-05103	950-XZ-05104	950-JE-05103	2x2.5 mm2
4	C-950-MFA-06102/950-JE-06102	950-MFA-06102	950-JE-06102	1x2x0.75 mm2
5	C-950-MFA-05104/950-JE-05102	950-MFA-05104	950-JE-05102	1x2x0.75 mm2

L-SEC-27-L-200-101-IST-017

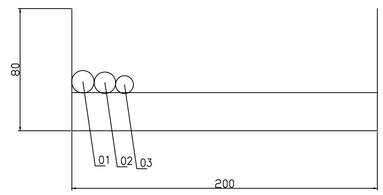


L-SEC-27-L-200-101-IST-017				
POS	CABLE NAME	FROM	TO	FORMATION
1	C-950-FDZ-06102/950-JE-06101	950-FDZ-06102	950-JE-06101	3x2.5 mm2
2	C-950-XZ-05104/950-JE-05103	950-XZ-05104	950-JE-05103	2x2.5 mm2
3	C-950-MFA-05104/950-JE-05102	950-MFA-05104	950-JE-05102	1x2x0.75 mm2

L-SEC-28-L-200-101-IST-017

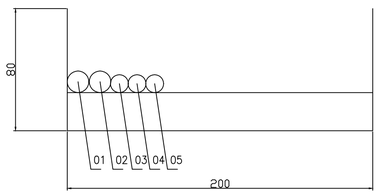

L-SEC-28-L-200-101-IST-017				
POS	CABLE NAME	FROM	TO	FORMATION
1	C-950-FDZ-06102/950-JE-06101	950-FDZ-06102	950-JE-06101	3x2.5 mm2
2	C-950-XZ-05103/950-JE-05103	950-XZ-05103	950-JE-05103	2x2.5 mm2
3	C-950-XZ-05104/950-JE-05103	950-XZ-05104	950-JE-05103	2x2.5 mm2
4	C-950-MFA-05103/950-JE-05102	950-MFA-05102	950-JE-05102	1x2x0.75 mm2
5	C-950-MFA-05104/950-JE-05102	950-MFA-05104	950-JE-05102	1x2x0.75 mm2

L-SEC-29-L-200-101-IST-017

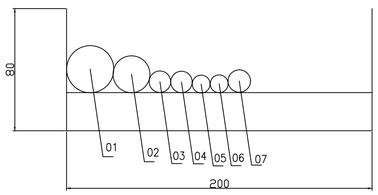

SEC-29-L-200-101-IST-017				
POS	CABLE NAME	FROM	TO	FORMATION
1	950-JE-05102/B400-FGS-002	950-JE-05102	B400-FGS-002	6x2x0,75 mm2
2	950-JE-05103/B400-FGS-002	950-JE-05103	B400-FGS-002	12x2,5 mm2
3	C-950-XZ-05101/950-JE-05103	950-XZ-05101	950-JE-05103	2x2.5 mm2
4	C-950-XZ-05102/950-JE-05103	950-XZ-05102	950-JE-05103	2x2.5 mm2
5	C-950-MFA-05101/950-JE-05102	950-MFA-05101	950-JE-05102	1x2x0.75 mm2
6	C-950-MFA-05102/950-JE-05102	950-MFA-05102	950-JE-05102	1x2x0.75 mm2
7	C-950-FDZ-06102/950-JE-06101	950-FDZ-06102	950-JE-06101	3x2.5 mm2

INSERT SUBCONTRACTOR / VENDOR LOGO HERE

REV.	DATE	DRN	CHKD	APPD	DESCRIPTION
03	29/09/25	SPS	LCA	CGI	AS-BUILT (ASB)
02	04/10/24	VBA	LCA	DLO	ACCEPTED FOR CONSTRUCTION (AFC)
01	26/07/24	VBA	LCA	DLO	ACCEPTED FOR CONSTRUCTION (AFC)
00	22/12/23	VBA	LCA	DLO	ISSUE FOR REVIEW (IFR)

CROSSWIND

ROSETTI MARINO

TITLE :
BASE LOAD POWER HUB (BLPH)
INSTRUMENT MAIN CABLE ROUTING-LOWER DECK
TOS EL. TOS EL. 23.310M

CONTRACT NO./TITLE CW-I-WP4-2023-05/HOLLANDSE KUST NOORD WIND PARK | SCALE 1:150

DRAWN SPS | CHECKED LCA | APPROVED CGI | DATE 29/09/25


A1 | DRAWING NO. 123A90-DDL-IN-DL-40082 | SHEET 019 | REV. 03

File Name : 123A90-DDL-IN-DL-40082 REV.03.dwg

DRAWING NO. 123A90-DDL-IN-DL-40082


REV. 03

L-SEC-30-L-200-101-IST-017

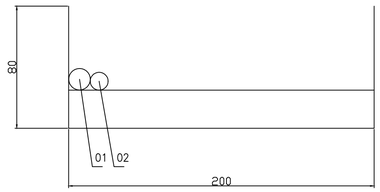


L-SEC-30-L-200-101-IST-017				
POS	CABLE NAME	FROM	TO	FORMATION
1	C-950-XZ-05101/950-JE-05103	950-XZ-05101	950-JE-05103	2x2.5 mm2
2	C-950-MFA-05101/950-JE-05102	950-MFA-05101	950-JE-05102	1x2x0.75 mm2

L-SEC-31-L-200-101-IST-017

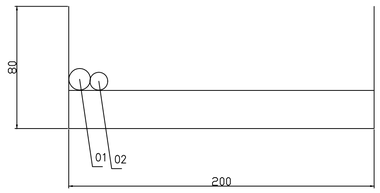


L-SEC-31-L-200-101-IST-017				
POS	CABLE NAME	FROM	TO	FORMATION
1	C-950-XZ-05101/950-JE-05103	950-XZ-05101	950-JE-05103	2x2.5 mm2
2	C-950-MFA-05101/950-JE-05102	950-MFA-05101	950-JE-05102	1x2x0.75 mm2

L-SEC-34-L-200-101-IST-017

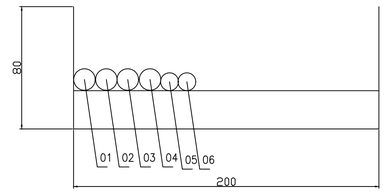


L-SEC-34-L-200-101-IST-017				
POS	CABLE NAME	FROM	TO	FORMATION
1	C-950-XL-04103/950-JE-04103	C-950-XL-04103	950-JE-04103	2x2.5 mm2
2	C-950-XL-04104/950-JE-04103	C-950-XL-04104	950-JE-04103	2x2.5 mm2
3	C-950-XZ-04102/950-JE-04103	C-950-XZ-04102	950-JE-04103	2x2.5 mm2
4	C-950-XZ-05101/950-JE-05103	950-XZ-05101	950-JE-05103	2x2.5 mm2
5	C-950-MFA-04102/950-JE-04102	C-950-MFA-04102	950-JE-04102	1x2x0.75 mm2
6	C-950-MFA-05101/950-JE-05102	950-MFA-05101	950-JE-05102	1x2x0.75 mm2

L-SEC-32-L-200-101-IST-017

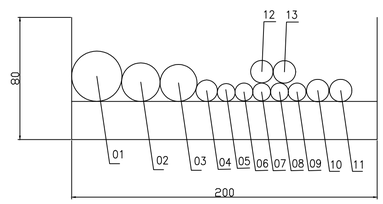


L-SEC-32-L-200-101-IST-017				
POS	CABLE NAME	FROM	TO	FORMATION
1	950-JE-04101/B400-FGS-002	950-JE-04101	B400-FGS-002	6x3x2,5 mm2
2	950-JE-04102/B400-FGS-002	950-JE-04102	B400-FGS-002	6x2x0,75 mm2
3	950-JE-04103/B400-FGS-002	950-JE-04103	B400-FGS-002	12x2,5 mm2
4	C-950-XZ-05101/950-JE-05103	950-XZ-05101	950-JE-05103	2x2.5 mm2
5	C-950-ASD-04101/00-JE-22001	950-ASD-04101	00-JE-22001	1x2x0,75 mm2
6	C-950-MOB-04101/00-JE-22001	950-MOB-04101	00-JE-22001	1x2x0,75 mm2
7	C-950-ESD-04101/00-JE-22001	950-ESD-04101	00-JE-22001	1x2x0,75 mm2
8	C-950-ESDD-04101/00-JE-22001	950-ESDD-04101	00-JE-22001	1x2x0,75 mm2
9	C-950-MFA-05101/950-JE-05102	950-MFA-05101	950-JE-05102	1x2x0.75 mm2
10	C-950-FDZ-04101/950-JE-04101	950-FDZ-04101	950-JE-04101	3x2.5 mm2
11	C-950-FDZ-04102/950-JE-04101	950-FDZ-04102	950-JE-04101	3x2.5 mm2
12	C-950-FDZ-04103/950-JE-04101	950-FDZ-04103	950-JE-04101	3x2.5 mm2
13	C-950-FDZ-04104/950-JE-04101	950-FDZ-04104	950-JE-04101	3x2.5 mm2

L-SEC-33-L-200-101-IST-017

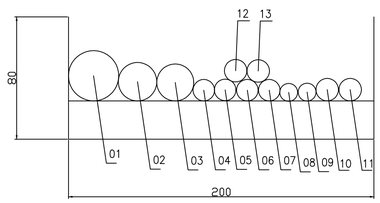


L-SEC-33-L-200-101-IST-017				
POS	CABLE NAME	FROM	TO	FORMATION
1	950-JE-04101/B400-FGS-002	950-JE-04101	B400-FGS-002	6x3x2,5 mm2
2	950-JE-04102/B400-FGS-002	950-JE-04102	B400-FGS-002	6x2x0,75 mm2
3	950-JE-04103/B400-FGS-002	950-JE-04103	B400-FGS-002	12x2,5 mm2
4	C-950-XZ-04101/950-JE-04103	950-XZ-04101	950-JE-04103	2x2.5 mm2
5	C-950-XL-04101/950-JE-04103	950-XL-04101	950-JE-04103	2x2.5 mm2
6	C-950-XL-04102/950-JE-04103	950-XL-04102	950-JE-04103	2x2.5 mm2
7	C-950-XZ-05101/950-JE-05103	950-XZ-05101	950-JE-05103	2x2.5 mm2
8	C-950-MFA-04101/950-JE-04102	950-MFA-04101	950-JE-04102	1x2x0.75 mm2
9	C-950-MFA-05101/950-JE-05102	950-MFA-05101	950-JE-05102	1x2x0.75 mm2
10	C-950-FDZ-04101/950-JE-04101	950-FDZ-04101	950-JE-04101	3x2.5 mm2
11	C-950-FDZ-04102/950-JE-04101	950-FDZ-04102	950-JE-04101	3x2.5 mm2
12	C-950-FDZ-04103/950-JE-04101	950-FDZ-04103	950-JE-04101	3x2.5 mm2
13	C-950-FDZ-04104/950-JE-04101	950-FDZ-04104	950-JE-04101	3x2.5 mm2

L-SEC-34-L-200-101-IST-018

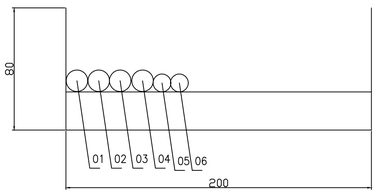

L-SEC-34-L-200-101-IST-018				
POS	CABLE NAME	FROM	TO	FORMATION
1	C-950-XL-04103/950-JE-04103	C-950-XL-04103	950-JE-04103	2x2.5 mm2
2	C-950-XL-04104/950-JE-04103	C-950-XL-04104	950-JE-04103	2x2.5 mm2
3	C-950-XZ-04102/950-JE-04103	C-950-XZ-04102	950-JE-04103	2x2.5 mm2
4	C-950-XZ-05101/950-JE-05103	950-XZ-05101	950-JE-05103	2x2.5 mm2
5	C-950-MFA-04102/950-JE-04102	C-950-MFA-04102	950-JE-04102	1x2x0.75 mm2
6	C-950-MFA-05101/950-JE-05102	950-MFA-05101	950-JE-05102	1x2x0.75 mm2

L-SEC-35-L-200-101-IST-041

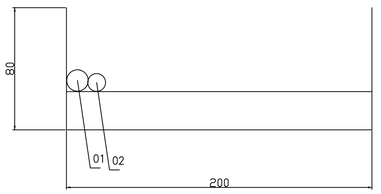

L-SEC-35-L-200-101-IST-041				
POS	CABLE NAME	FROM	TO	FORMATION
1	C-950-XZ-05101/950-JE-05103	950-XZ-05101	950-JE-05103	2x2.5 mm2
2	C-950-MFA-05101/950-JE-05102	950-MFA-05101	950-JE-05102	1x2x0.75 mm2

INSERT SUBCONTRACTOR / VENDOR LOGO HERE

REV.	DATE	DRN	CHKD	APPD	DESCRIPTION
03	29/09/25	SPS	LCA	CGI	AS-BUILT (ASB)
02	04/10/24	VBA	LCA	DLO	ACCEPTED FOR CONSTRUCTION (AFC)
01	26/07/24	VBA	LCA	DLO	ACCEPTED FOR CONSTRUCTION (AFC)
00	22/12/23	VBA	LCA	DLO	ISSUE FOR REVIEW (IFR)

CROSSWIND

ROSETTI MARINO

TITLE :
BASE LOAD POWER HUB (BLPH)
INSTRUMENT MAIN CABLE ROUTING-LOWER DECK
TOS EL. TOS EL. 23.310M

CONTRACT NO./TITLE CW-I-WP4-2023-05/HOLLANDSE KUST NOORD WIND PARK | SCALE 1:150

DRAWN SPS | CHECKED LCA | APPROVED CGI | DATE 29/09/25


A1 | DRAWING NO. 123A90-DDL-IN-DL-40082 | SHEET 020 | REV. 03

File Name : 123A90-DDL-IN-DL-40082 REV03.dwg

DRAWING NO. 123A90-DDL-IN-DL-40082


REV. 03

T-SEC-01-L-150-100-IST-001

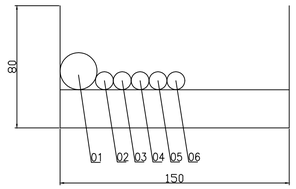


T-SEC-01-L-150-100-IST-001				
POS	CABLE NAME	FROM	TO	FORMATION
1	950-JE-07101/B400-FGS-002	950-JE-07101	B400-FGS-002	12x2.5 mm2
2	C-950-ASD-07101/00-JE-22002	950-ASD-07101	00-JE-22002	1x2x0.75 mm2
3	C-950-MOB-07101/00-JE-22002	950-MOB-07101	00-JE-22002	1x2x0.75 mm2
4	C-950-ESD-07101/00-JE-22002	950-ESD-07101	00-JE-22002	1x2x0.75 mm2
5	C-950-ESDD-07101/00-JE-22002	950-ESDD-07101	00-JE-22002	1x2x0.75 mm2
6	C-950-MFA-07101/B400-FGS-002	950-MFA-07101	00-JE-22002	1x2x0.75 mm2

T-SEC-01-L-200-100-IST-002

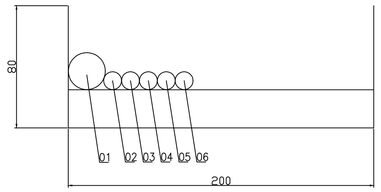


T-SEC-01-L-200-100-IST-002				
POS	CABLE NAME	FROM	TO	FORMATION
1	950-JE-07101/B400-FGS-002	950-JE-07101	B400-FGS-002	12x2.5 mm2
2	C-950-ASD-07101/00-JE-22002	950-ASD-07101	00-JE-22002	1x2x0.75 mm2
3	C-950-MOB-07101/00-JE-22002	950-MOB-07101	00-JE-22002	1x2x0.75 mm2
4	C-950-ESD-07101/00-JE-22002	950-ESD-07101	00-JE-22002	1x2x0.75 mm2
5	C-950-ESDD-07101/00-JE-22002	950-ESDD-07101	00-JE-22002	1x2x0.75 mm2
6	C-950-MFA-07101/B400-FGS-002	950-MFA-07101	00-JE-22002	1x2x0.75 mm2

T-SEC-01-L-200-100-IST-004

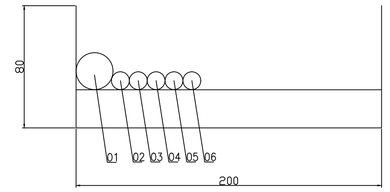


T-SEC-01-L-200-100-IST-004				
POS	CABLE NAME	FROM	TO	FORMATION
1	950-JE-07101/B400-FGS-002	950-JE-07101	B400-FGS-002	12x2.5 mm2
2	C-950-ASD-07101/00-JE-22002	950-ASD-07101	00-JE-22002	1x2x0.75 mm2
3	C-950-MOB-07101/00-JE-22002	950-MOB-07101	00-JE-22002	1x2x0.75 mm2
4	C-950-ESD-07101/00-JE-22002	950-ESD-07101	00-JE-22002	1x2x0.75 mm2
5	C-950-ESDD-07101/00-JE-22002	950-ESDD-07101	00-JE-22002	1x2x0.75 mm2
6	C-950-MFA-07101/B400-FGS-002	950-MFA-07101	00-JE-22002	1x2x0.75 mm2

T-SEC-02-L-150-100-IST-009

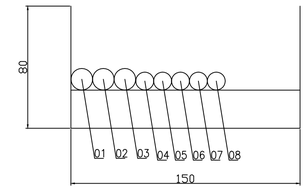


T-SEC-02-L-150-100-IST-009				
POS	CABLE NAME	FROM	TO	FORMATION
1	C-950-XZ-07101/950-JE-07101	950-XZ-07101	950-JE-07101	2x2.5 mm2
2	C-950-XL-07101/950-JE-07101	950-XL-07101	950-JE-07101	2x2.5 mm2
3	C-950-XL-07102/950-JE-07101	950-XL-07102	950-JE-07101	2x2.5 mm2
4	C-950-ASD-07101/00-JE-22002	950-ASD-07101	00-JE-22002	1x2x0.75 mm2
5	C-950-MOB-07101/00-JE-22002	950-MOB-07101	00-JE-22002	1x2x0.75 mm2
6	C-950-ESD-07101/00-JE-22002	950-ESD-07101	00-JE-22002	1x2x0.75 mm2
7	C-950-ESDD-07101/00-JE-22002	950-ESDD-07101	00-JE-22002	1x2x0.75 mm2
8	C-950-MFA-07101/B400-FGS-002	950-MFA-07101	00-JE-22002	1x2x0.75 mm2

T-SEC-03A-L-150-100-IST-010

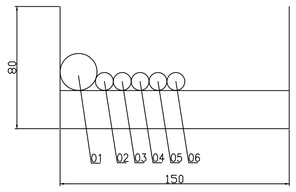


T-SEC-03A-L-150-100-IST-010				
POS	CABLE NAME	FROM	TO	FORMATION
1	950-JE-07101/B400-FGS-002	950-JE-07101	B400-FGS-002	12x2.5 mm2
2	C-950-ASD-07101/00-JE-22002	950-ASD-07101	00-JE-22002	1x2x0.75 mm2
3	C-950-MOB-07101/00-JE-22002	950-MOB-07101	00-JE-22002	1x2x0.75 mm2
4	C-950-ESD-07101/00-JE-22002	950-ESD-07101	00-JE-22002	1x2x0.75 mm2
5	C-950-ESDD-07101/00-JE-22002	950-ESDD-07101	00-JE-22002	1x2x0.75 mm2
6	C-950-MFA-07101/B400-FGS-002	950-MFA-07101	00-JE-22002	1x2x0.75 mm2

T-SEC-03B-L-150-100-IST-010

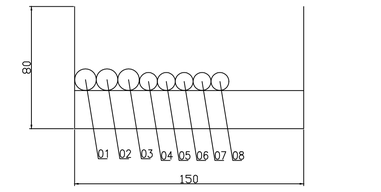


T-SEC-03B-L-150-100-IST-010				
POS	CABLE NAME	FROM	TO	FORMATION
1	C-950-XZ-07101/950-JE-07101	950-XZ-07101	950-JE-07101	2x2.5 mm2
2	C-950-XL-07101/950-JE-07101	950-XL-07101	950-JE-07101	2x2.5 mm2
3	C-950-XL-07102/950-JE-07101	950-XL-07102	950-JE-07101	2x2.5 mm2
4	C-950-ASD-07101/00-JE-22002	950-ASD-07101	00-JE-22002	1x2x0.75 mm2
5	C-950-MOB-07101/00-JE-22002	950-MOB-07101	00-JE-22002	1x2x0.75 mm2
6	C-950-ESD-07101/00-JE-22002	950-ESD-07101	00-JE-22002	1x2x0.75 mm2
7	C-950-ESDD-07101/00-JE-22002	950-ESDD-07101	00-JE-22002	1x2x0.75 mm2
8	C-950-MFA-07101/B400-FGS-002	950-MFA-07101	00-JE-22002	1x2x0.75 mm2

T-SEC-04-L-150-100-IST-006

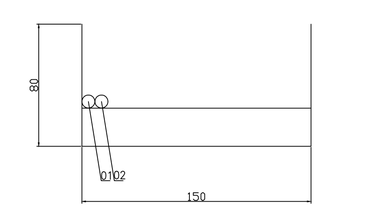


T-SEC-04-L-150-100-IST-007				
POS	CABLE NAME	FROM	TO	FORMATION
1	HNA6/CN-200N1	HNA6	CN-200N1	FO12 OS2
2	HNA6/B400-NET-001	HNA6	B400-NET-001	FO12 OS2

T-SEC-04-L-150-100-IST-007

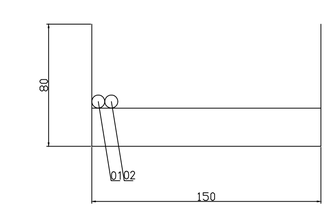


T-SEC-04-L-150-100-IST-007				
POS	CABLE NAME	FROM	TO	FORMATION
1	HNA6/CN-200N1	HNA6	CN-200N1	FO12 OS2
2	HNA6/B400-NET-001	HNA6	B400-NET-001	FO12 OS2

T-SEC-05-L-150-100-IST-005

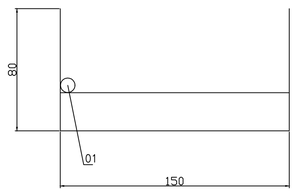

T-SEC-05-L-150-100-IST-005				
POS	CABLE NAME	FROM	TO	FORMATION
1	C-55-LIT-001/00-JE-11005	55-LIT-001	00-JE-11005	1x2x0.75 mm2

T-SEC-06-L-200-100-IST-003

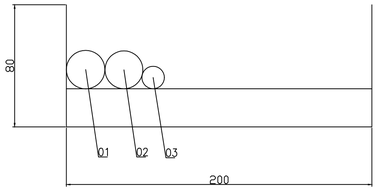

T-SEC-06-L-200-100-IST-003				
POS	CABLE NAME	FROM	TO	FORMATION
1	950-JE-05102/B400-FGS-002	950-JE-05102	B400-FGS-002	6x2x0.75 mm2
2	950-JE-05103/B400-FGS-002	950-JE-05103	B400-FGS-002	12x2.5 mm2
3	C-950-FDZ-06102/950-JE-06101	950-FDZ-06102	950-JE-06101	3x2.5 mm2

INSERT SUBCONTRACTOR / VENDOR LOGO HERE

REV.	DATE	DRN	CHKD	APPD	DESCRIPTION
03	29/09/25	SPS	LCA	CGI	AS-BUILT (ASB)
02	04/10/24	VBA	LCA	DLO	ACCEPTED FOR CONSTRUCTION (AFC)
01	26/07/24	VBA	LCA	DLO	ACCEPTED FOR CONSTRUCTION (AFC)
00	22/12/23	VBA	LCA	DLO	ISSUE FOR REVIEW (IFR)

CROSSWIND

ROSETTI MARINO

TITLE :
BASE LOAD POWER HUB (BLPH)
INSTRUMENT MAIN CABLE ROUTING-LOWER DECK
TOS EL. TOS EL. 23.310M

CONTRACT NO./TITLE	CW-I-WP4-2023-05/HOLLANDSE KUST NOORD WIND PARK		SCALE 1:150
DRAWN SPS	CHECKED LCA	APPROVED CGI	DATE 29/09/25

A1	DRAWING NO. 123A90-DDL-IN-DL-40082	SHEET 021	REV. 03

File Name : 123A90-DDL-IN-DL-40082 REV03.dwg