
DRAWING NO. 123A90-DDL-IN-DL-40115

REV. 02

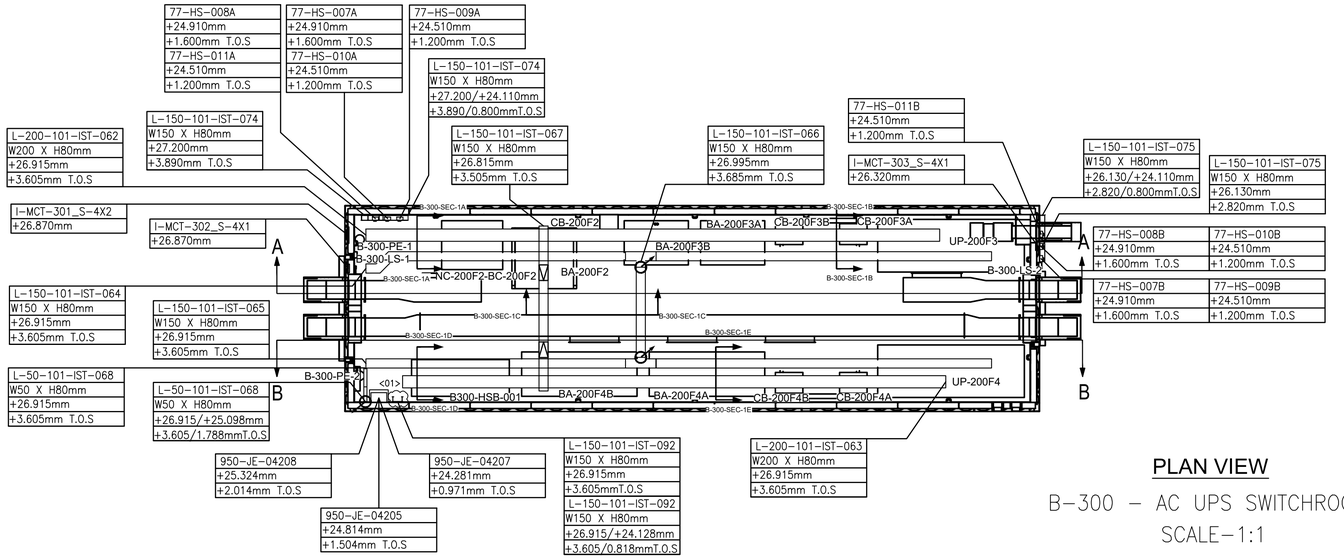

PLAN VIEW

B-300 – AC UPS SWITCHROOM


SCALE-1:1

SECTION A-A

SCALE-1:1

SECTION B-B

SCALE-1:1

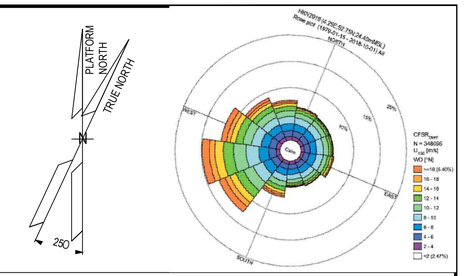

NOTES

1. ALL DIMENSIONS AND ELEVATIONS ARE GIVEN IN mm UNLESS OTHERWISE NOTED.
2. ELEVATIONS REFER TO T.O.S.
3. THIS DRAWING IS VALID ONLY FOR CONTAINER CABLE TRAY LAYOUT.

LEGEND

HOLDS

REFERENCE DOCUMENTS

123A90-DDL-PP-DL-70070	PLOT PLAN - LOWER & UPPER DECK
123A90-DDL-IN-DL-40081	INSTRUMENT LAYOUT - UPPER DECK
123A90-DDL-IN-LIS-40091	INSTRUMENT CABLE LIST
123A90-DDL-IN-DG-40015	INSTRUMENT-CCS WIRING DIAGRAMS
123A90-DDL-IN-DG-40016	INSTRUMENT-SAFETY SYSTEM WIRING DIAGRAMS
123A90-DDL-IN-DL-40083	INSTRUMENT MAIN CABLES ROUTING-LOWER DECK

INSERT SUBCONTRACTOR / VENDOR LOGO HERE

REV.	DATE	DRN	CHKD	APPD	DESCRIPTION
02	29/09/25	SPS	LCA	CGI	AS-BUILT (ASB)
01	04/10/24	VBA	LCA	DLO	ACCEPTED FOR CONSTRUCTION (AFC)
00	23/08/24	VBA	LCA	DLO	ISSUE FOR REVIEW (IFR)

CROSSWIND

ROSETTI MARINO

TITLE :

BASE LOAD POWER HUB (BLPH)

Base Load Power HUB Cables Tray Layout

B-300 Container Lower Deck – TOS EL. 23.310m


CONTRACT NO./TITLE CW-I-WP4-2023-05/HOLLANDSE KUST NOORD WIND PARK			SCALE 1:50
DRAWN SPS	CHECKED LCA	APPROVED CGI	DATE 29/09/25
A1	DRAWING NO. 123A90-DDL-IN-DL-40115	SHEET 001	REV. 02

File Name : 123A90-DDL-IN-DL-40115 REV:02.dwg

DRAWING NO. 123A90-DDL-IN-DL-40115


REV. 02

B-300-SEC-1A-L-200-101-IST-062

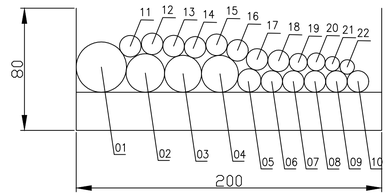


B-300-SEC-1A-L-200-101-IST-062				
POS	CABLE NAME	FROM	TO	FORMATION
1	950-JE-04205/B400-FGS-002	950-JE-04205	B400-FGS-002	6x3x2,5 mm2
2	B300-HSB-001/B400-FGS-002	B300-HSB-001	B400-FGS-002	6x2x0,75 mm2
3	UP-200F3/B400-SIS-001	UP-200F3	B400-SIS-001	12x2,5 mm2
4	950-JE-04207/B400-FGS-002	950-JE-04207	B400-FGS-002	12x2,5 mm2
5	C-B300-TIR-001/B400-PCS-002	B300-TIR-001	B400-PCS-002	2x2x0,75 mm2
6	C-77-XS-003/B400-SIS-001	C-77-XS-003	B400-SIS-001	2x2,5 mm2
7	C-CB-200F3A/B400-SIS-001	CB-200F3A	B400-SIS-001	2x2,5 mm2
8	C-CB-200F3B/B400-SIS-001	CB-200F3B	B400-SIS-001	2x2,5 mm2
9	C-CB-200F4A/B400-SIS-001	CB-200F4A	B400-SIS-001	2x2,5 mm2
10	C-CB-200F4B/B400-SIS-001	CB-200F4B	B400-SIS-001	2x2,5 mm2
11	C-UP-200F4/B400-SIS-001	UP-200F4	B400-SIS-001	2x2,5 mm2
12	C-NC-200F2/B400-FGS-002.01	NC-200F2	B400-FGS-002.01	1x2x0.75 mm2
13	C-NC-200F2/B400-FGS-002.02	NC-200F2	B400-FGS-002.02	2x2,5 mm2
14	C-77-HY-007/77-HS-007A	77-HS-007	77-HS-007A	2x2,5 mm2
15	C-77-HY-008/77-HS-008A	77-HY-008	77-HS-008A	2x2,5 mm2
16	C-77-HY-009/77-HS-009A	77-HY-009	77-HS-009A	2x2,5 mm2
17	C-77-HY-010/77-HS-010A	77-HY-010	77-HS-010A	2x2,5 mm2
18	C-77-HY-011/77-HS-011A	77-HY-011	77-HS-011A	2x2,5 mm2
19	C-77-XA-003/B400-SIS-001	C-77-XA-003	B400-SIS-001	1x2x0,75 mm2
20	C-NC-200F2/B400-SIS-001	NC-200F2	B400-SIS-001	2x2,5 mm2
21	C-B300-TDC-001/B400-PCS-002	B300-TDC-001	B400-PCS-002	1x2x0,75 mm2
22	C-B300-TDC-002/B400-PCS-002	B300-TDC-002	B400-PCS-002	1x2x0,75 mm2

B-300-SEC-1B-L-200-101-IST-062

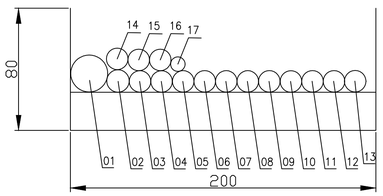


B-300-SEC-1B-L-200-101-IST-062				
POS	CABLE NAME	FROM	TO	FORMATION
1	UP-200F3/B400-SIS-001	UP-200F3	B400-SIS-001	12x2,5 mm2
2	C-950-GDZ-04212/950-JE-04205	950-GDZ-04212	950-JE-04205	3x2,5 mm2
3	C-CB-200F3A/B400-SIS-001	CB-200F3A	B400-SIS-001	2x2,5 mm2
4	C-CB-200F3B/B400-SIS-001	CB-200F3B	B400-SIS-001	2x2,5 mm2
5	C-77-HS-007B/950-JE-04207	77-HS-007B	950-JE-04207	2x2,5 mm2
6	C-77-HS-008B/950-JE-04207	77-HS-008B	950-JE-04207	2x2,5 mm2
7	C-77-HS-009B/950-JE-04207	77-HS-009B	950-JE-04207	2x2,5 mm2
8	C-77-HS-010B/950-JE-04207	77-HS-010B	950-JE-04207	2x2,5 mm2
9	C-77-HS-011B/950-JE-04207	77-HS-011B	950-JE-04207	2x2,5 mm2
10	C-77-HS-007A/77-HS-007B	77-HS-007A	77-HS-007B	2x2,5 mm2
11	C-77-HS-008A/77-HS-008B	77-HS-008A	77-HS-008B	2x2,5 mm2
12	C-77-HS-009A/77-HS-009B	77-HS-009A	77-HS-009B	2x2,5 mm2
13	C-77-HS-010A/77-HS-010B	77-HS-010A	77-HS-010B	2x2,5 mm2
14	C-77-HS-011A/77-HS-011B	77-HS-011A	77-HS-011B	2x2,5 mm2
15	C-77-HY-010/77-HS-010A	77-HY-010	77-HS-010A	2x2,5 mm2
16	C-77-HY-011/77-HS-011A	77-HY-011	77-HS-011A	2x2,5 mm2
17	C-B300-TDC-001/B400-PCS-002	C-B300-TDC-001	B400-PCS-002	1x2x0,75 mm2

B-300-SEC-1C-L-200-101-IST-067

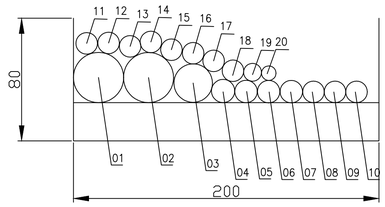


B-300-SEC-1C-L-200-101-IST-067				
POS	CABLE NUMBER	FROM	TO	FORMATION
1	950-JE-04205/B400-FGS-002	950-JE-04205	B400-FGS-002	6x3x2.5 mm2
2	950-JE-04207/B400-FGS-002	950-JE-04207	B400-FGS-002	24x2.5 mm2
3	B300-HSB-001/B400-FGS-002	950-JE-04206	B400-FGS-002	6x2x0,75 mm2
4	C-B300-TIR-001/B400-PCS-002	B300-TIR-001	B400-PCS-002	2x2x0,75 mm2
5	C-950-GDZ-04210/950-JE-04205	950-GDZ-04210	950-JE-04205	3x2.5 mm2
6	C-950-GDZ-04211/950-JE-04205	950-GDZ-04211	950-JE-04205	3x2.5 mm2
7	C-950-GDZ-04212/950-JE-04205	950-GDZ-04212	950-JE-04205	3x2.5 mm2
8	C-77-HS-007B/950-JE-04207	77-HS-007B	950-JE-04207	2x2.5 mm2
9	C-77-HS-008B/950-JE-04207	77-HS-007B	950-JE-04207	2x2.5 mm2
10	C-77-HS-009B/950-JE-04207	77-HS-008B	950-JE-04207	2x2.5 mm2
11	C-77-HS-010B/950-JE-04207	77-HS-010B	950-JE-04207	2x2.5 mm2
12	C-77-HS-011B/950-JE-04207	77-HS-011B	950-JE-04207	2x2.5 mm2
13	C-CB-200F4A/B400-SIS-001	CB-200F4A	B400-SIS-001	2x2,5 mm2
14	C-CB-200F4B/B400-SIS-001	CB-200F4B	B400-SIS-001	2x2,5 mm2
15	C-77-XS-003/B400-SIS-001	C-77-XS-003	B400-SIS-001	2x2,5 mm2
16	C-77-HY-007/77-HS-007A	77-HY-007	77-HS-007A	2x2,5 mm2
17	C-77-HY-009/77-HS-009A	77-HY-009	77-HS-009A	2x2,5 mm2
18	C-UP-200F4/B400-SIS-001	UP-200F4	B400-SIS-001	2x2,5 mm2
19	C-77-XA-003/B400-SIS-001	C-77-XA-003	B400-SIS-001	1x2x0,75 mm2
20	C-B300-TDC-002/B400-PCS-002	C-B300-TDC-002	B400-PCS-002	1x2x0,75 mm2

B-300-SEC-1A-L-150-101-IST-064

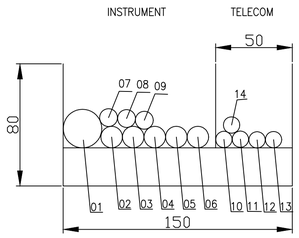

B-300-SEC-1A-L-150-101-IST-064				
POS	CABLE NAME	FROM	TO	FORMATION
1	950-JE-04208/B400-FGS-002	950-JE-04208	B400-FGS-002	6x2x0,75 mm2
2	C-77-HS-007A/77-HS-007B	77-HS-007A	77-HS-007B	2x2.5 mm2
3	C-77-HS-008A/77-HS-008B	77-HS-008A	77-HS-008B	2x2.5 mm2
4	C-77-HS-009A/77-HS-009B	77-HS-009A	77-HS-009B	2x2.5 mm2
5	C-77-HS-010A/77-HS-010B	77-HS-010A	77-HS-010B	2x2.5 mm2
6	C-77-HS-011A/77-HS-011B	77-HS-011A	77-HS-011B	2x2.5 mm2
7	C-950-SDZ-04207/950-JE-04208	950-SDZ-04207	950-JE-04208	1x2x0.75 mm2
8	C-950-SDZ-04208/950-JE-04208	950-SDZ-04208	950-JE-04208	1x2x0.75 mm2
9	C-950-SDZ-04209/950-JE-04208	950-SDZ-04209	950-JE-04208	1x2x0.75 mm2
10	B300-HSB-001/B400-NET-001	B300-HSB-001	B400-NET-001	CAT.6A 4x2xAWG23
11	UP-200F3/B400-NET-001.01	UP-200F3	B400-NET-001	CAT.6A 4x2xAWG23
12	UP-200F3/B400-NET-001.02	UP-200F3	B400-NET-001	CAT.6A 4x2xAWG23
13	UP-200F4/B400-NET-001.01	UP-200F4	B400-NET-001	CAT.6A 4x2xAWG23
14	UP-200F4/B400-NET-001.02	UP-200F4	B400-NET-001	CAT.6A 4x2xAWG23

B-300-SEC-1B-L-150-101-IST-064

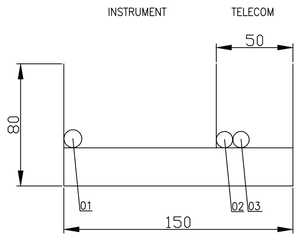

B-300-SEC-1B-L-150-101-IST-064				
POS	CABLE NAME	FROM	TO	FORMATION
1	C-950-SDZ-04212/950-JE-04208	950-SDZ-04212	950-JE-04208	1x2x0.75 mm2
2	UP-200F3/B400-NET-001.01	UP-200F3	B400-NET-001	CAT.6A 4x2xAWG23
3	UP-200F3/B400-NET-001.02	UP-200F3	B400-NET-001	CAT.6A 4x2xAWG23

INSERT SUBCONTRACTOR / VENDOR LOGO HERE

REV.	DATE	DRN	CHKD	APPD	DESCRIPTION
02	29/09/25	SPS	LCA	CGI	AS-BUILT (ASB)
01	04/10/24	VBA	LCA	DLO	ACCEPTED FOR CONSTRUCTION (AFC)
00	23/08/24	VBA	LCA	DLO	ISSUE FOR REVIEW (IFR)

CROSSWIND

ROSETTI MARINO

TITLE :
BASE LOAD POWER HUB (BLPH)
Base Load Power HUB Cables Tray Layout
B-300 Container Lower Deck – TOS EL. 23.310m

CONTRACT NO./TITLE CW-I-WP4-2023-05/HOLLANDSE KUST NOORD WIND PARK | SCALE 1:50

DRAWN SPS | CHECKED LCA | APPROVED CGI | DATE 29/09/25


A1 | DRAWING NO. 123A90-DDL-IN-DL-40115 | SHEET 002 | REV. 02

File Name : 123A90-DDL-IN-DL-40115 REV02.dwg

DRAWING NO. 123A90-DDL-IN-DL-40115


REV. 02

B-300-SEC-1C-L-150-101-IST-066

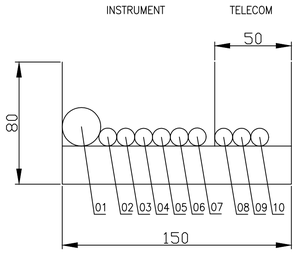


B-300-SEC-1C-L-150-101-IST-066				
POS	CABLE NUMBER	FROM	TO	FORMATION
1	950-JE-04208/B400-FGS-002	950-JE-04208	B400-FGS-002	6x2x0.75 mm2
2	C-950-SDZ-04207/950-JE-04208	950-SDZ-04207	950-JE-04208	1x2x0.75 mm2
3	C-950-SDZ-04208/950-JE-04208	950-SDZ-04208	950-JE-04208	1x2x0.75 mm2
4	C-950-SDZ-04209/950-JE-04208	950-SDZ-04209	950-JE-04208	1x2x0.75 mm2
5	C-950-SDZ-04210/950-JE-04208	950-SDZ-04210	950-JE-04208	1x2x0.75 mm2
6	C-950-SDZ-04211/950-JE-04208	950-SDZ-04211	950-JE-04208	1x2x0.75 mm2
7	C-950-SDZ-04212/950-JE-04208	950-SDZ-04212	950-JE-04208	1x2x0.75 mm2
8	B300-HSB-001/B400-NET-001	B300-HSB-001	B400-NET-001	CAT.6A 4x2xAWG23
9	UP-200F4/B400-NET-001.01	UP-200F4	B400-NET-001	CAT.6A 4x2xAWG23
10	UP-200F4/B400-NET-001.02	UP-200F4	B400-NET-001	CAT.6A 4x2xAWG23

B-300-SEC-1D-L-200-101-IST-063

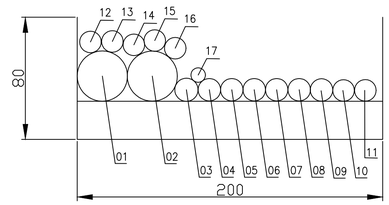


B-300-SEC-1D-L-200-101-IST-063				
POS	CABLE NUMBER	FROM	TO	FORMATION
1	950-JE-04205/B400-FGS-002	950-JE-04205	B400-FGS-002	6x3x2.5 mm2
2	950-JE-04207/B400-FGS-002	950-JE-04207	B400-FGS-002	24x2.5 mm2
3	C-B300-TIR-001/B400-PCS-002	B300-TIR-001	B400-PCS-002	2x2x0.75 mm2
4	C-950-GDZ-04207/950-JE-04205	950-GDZ-04207	950-JE-04205	3x2.5 mm2
5	C-950-GDZ-04208/950-JE-04205	950-GDZ-04208	950-JE-04205	3x2.5 mm2
6	C-950-GDZ-04209/950-JE-04205	950-GDZ-04209	950-JE-04205	3x2.5 mm2
7	C-950-GDZ-04210/950-JE-04205	950-GDZ-04210	950-JE-04205	3x2.5 mm2
8	C-950-GDZ-04211/950-JE-04205	950-GDZ-04211	950-JE-04205	3x2.5 mm2
9	C-950-GDZ-04212/950-JE-04205	950-GDZ-04212	950-JE-04205	3x2.5 mm2
10	C-77-HS-007B/950-JE-04207	77-HS-007B	950-JE-04207	2x2.5 mm2
11	C-77-HS-008B/950-JE-04207	77-HS-007B	950-JE-04207	2x2.5 mm2
12	C-77-HS-009B/950-JE-04207	77-HS-008B	950-JE-04207	2x2.5 mm2
13	C-77-HS-010B/950-JE-04207	77-HS-010B	950-JE-04207	2x2.5 mm2
14	C-77-HS-011B/950-JE-04207	77-HS-011B	950-JE-04207	2x2.5 mm2
15	C-77-HY-007/77-HS-007A	77-HY-007	77-HS-007A	2x2.5 mm2
16	C-77-XS-003/B400-SIS-001	77-XS-003	B400-SIS-001	2x2.5 mm2
17	C-B300-TDC-002/B400-PCS-002	B300-TDC-002	B400-PCS-002	1x2x0.75 mm2

B-300-SEC-1E-L-200-101-IST-063

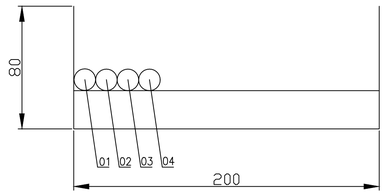


B-300-SEC-1E-L-200-101-IST-063				
POS	CABLE NUMBER	FROM	TO	FORMATION
1	C-UP-200F4/B400-SIS-001	UP-200F4	B400-SIS-001	2x2.5 mm2
2	C-CB-200F4A/B400-SIS-001	CB-200F4A	B400-SIS-001	2x2.5 mm2
3	C-CB-200F4B/B400-SIS-001	CB-200F4B	B400-SIS-001	2x2.5 mm2
4	C-77-HY-009/77-HS-009A	77-HY-009	77-HS-009A	2x2.5 mm2

B-300-SEC-1D-L-150-101-IST-065

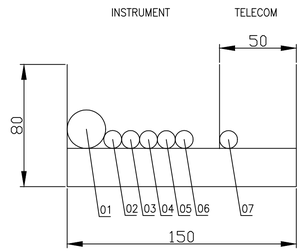

B-300-SEC-1D-L-150-101-IST-065				
POS	CABLE NUMBER	FROM	TO	FORMATION
1	950-JE-04208/B400-FGS-002	950-JE-04208	B400-FGS-002	6x2x0.75 mm2
2	C-950-SDZ-04207/950-JE-04208	950-SDZ-04207	950-JE-04208	1x2x0.75 mm2
3	C-950-SDZ-04208/950-JE-04208	950-SDZ-04208	950-JE-04208	1x2x0.75 mm2
4	C-950-SDZ-04209/950-JE-04208	950-SDZ-04209	950-JE-04208	1x2x0.75 mm2
5	C-950-SDZ-04210/950-JE-04208	950-SDZ-04210	950-JE-04208	1x2x0.75 mm2
6	C-950-SDZ-04211/950-JE-04208	950-SDZ-04211	950-JE-04208	1x2x0.75 mm2
7	C-950-SDZ-04212/950-JE-04208	950-SDZ-04212	950-JE-04208	1x2x0.75 mm2
8	B300-HSB-001/B400-NET-001	B300-HSB-001	B400-NET-001	CAT.6A 4x2xAWG23

B-300-SEC-1E-L-150-101-IST-065

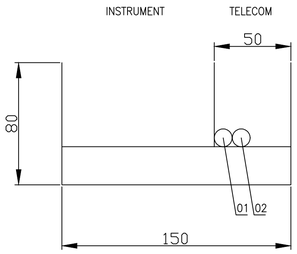

B-300-SEC-1E-L-150-101-IST-065				
POS	CABLE NUMBER	FROM	TO	FORMATION
1	UP-200F4/B400-NET-001.01	UP-200F4	B400-NET-001	CAT.6A 4x2xAWG23
2	UP-200F4/B400-NET-001.02	UP-200F4	B400-NET-001	CAT.6A 4x2xAWG23

INSERT SUBCONTRACTOR / VENDOR LOGO HERE

REV.	DATE	DRN	CHKD	APPD	DESCRIPTION
02	29/09/25	SPS	LCA	CGI	AS-BUILT (ASB)
01	04/10/24	VBA	LCA	DLO	ACCEPTED FOR CONSTRUCTION (AFC)
00	23/08/24	VBA	LCA	DLO	ISSUE FOR REVIEW (IFR)

CROSSWIND

ROSETTI MARINO

TITLE :

BASE LOAD POWER HUB (BLPH)
Base Load Power HUB Cables Tray Layout
B-300 Container Lower Deck – TOS EL. 23.310m

CONTRACT NO./TITLE CW-I-WP4-2023-05/HOLLANDSE KUST NOORD WIND PARK | SCALE 1:50

DRAWN SPS | CHECKED LCA | APPROVED CGI | DATE 29/09/25

A1 | DRAWING NO. 123A90-DDL-IN-DL-40115 | SHEET 003 | REV. 02

File Name : 123A90-DDL-IN-DL-40115 REV02.dwg