

DRAWING NO. 123A90-DDL-IN-DL-40116 REV. 02

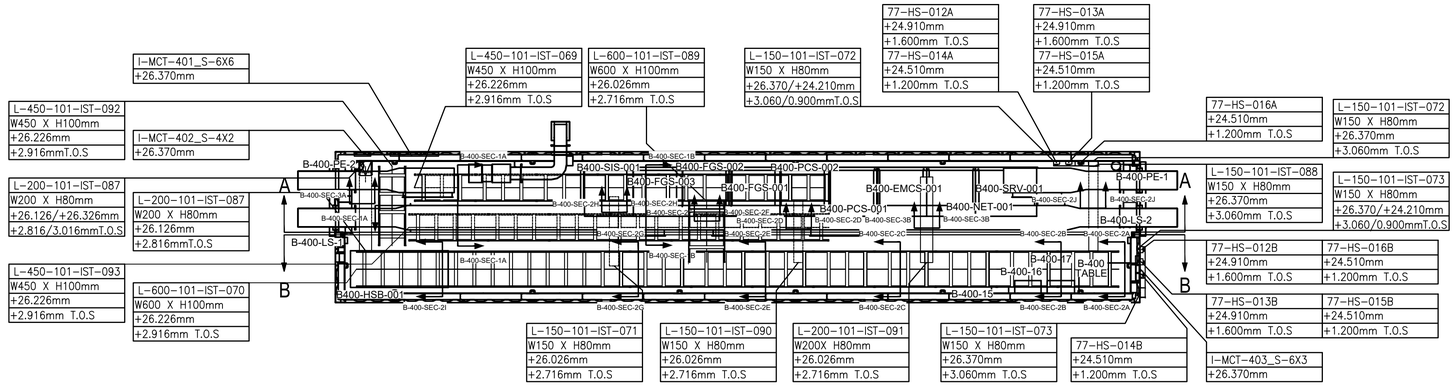

PLAN VIEW


B-400 – I&T EQUIPMENT ROOM

SCALE-1:1

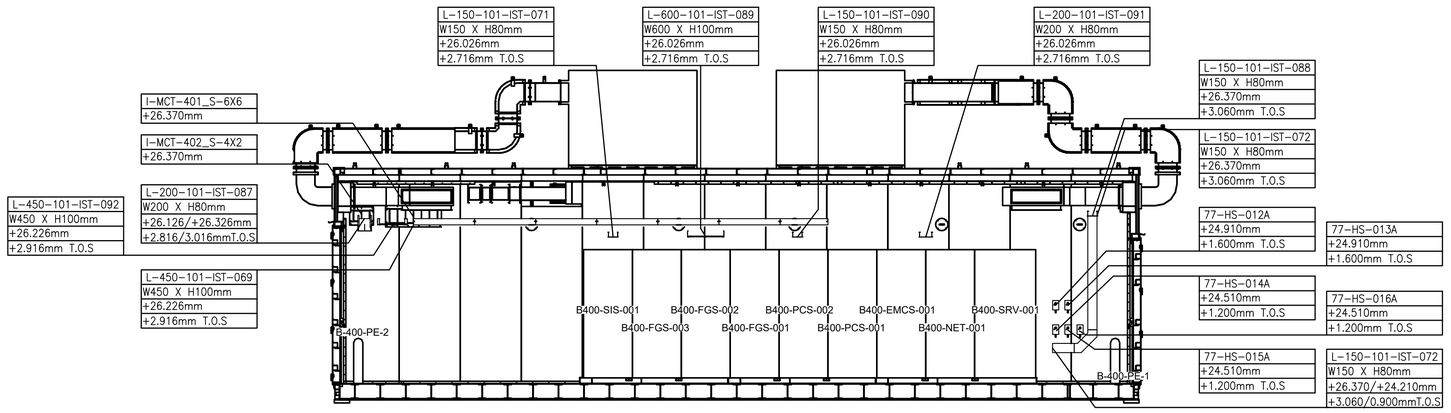


SECTION A-A

SCALE-1:1

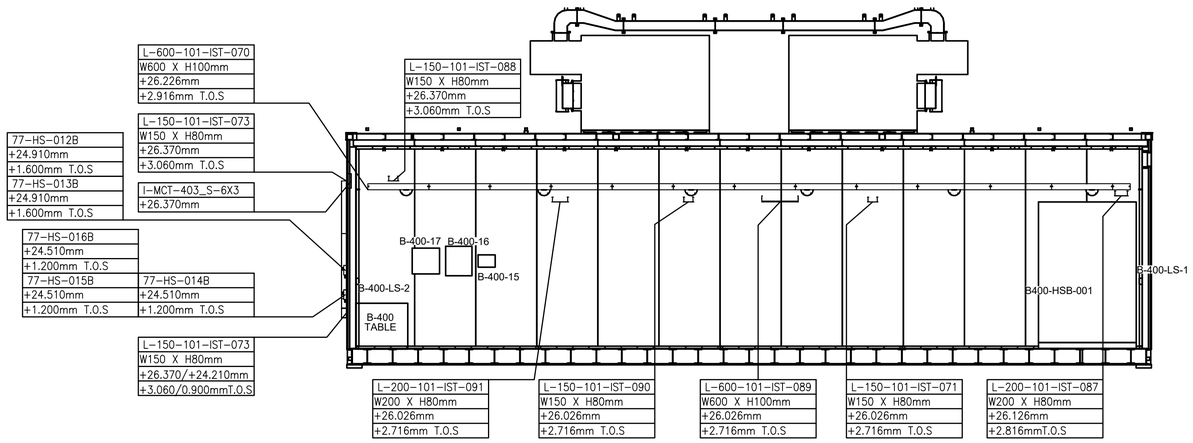

SECTION B-B

SCALE-1:1

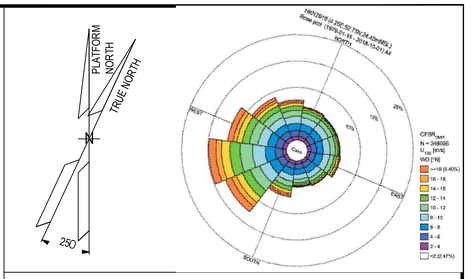

NOTES

1. ALL DIMENSIONS AND ELEVATIONS ARE GIVEN IN mm UNLESS OTHERWISE NOTED.
2. ELEVATIONS REFER TO T.O.S.
3. THIS DRAWING IS VALID ONLY FOR CONTAINER CABLE TRAY LAYOUT.

LEGEND

HOLDS

REFERENCE DOCUMENTS

123A90-DDL-PP-DL-70070	PLOT PLAN - LOWER & UPPER DECK
123A90-DDL-IN-DL-40081	INSTRUMENT LAYOUT - UPPER DECK
123A90-DDL-IN-LIS-40091	INSTRUMENT CABLE LIST
123A90-DDL-IN-DG-40015	INSTRUMENT-CCS WIRING DIAGRAMS
123A90-DDL-IN-DG-40016	INSTRUMENT-SAFETY SYSTEM WIRING DIAGRAMS
123A90-DDL-IN-DL-40083	INSTRUMENT MAIN CABLES ROUTING-LOWER DECK

INSERT SUBCONTRACTOR / VENDOR LOGO HERE

REV.	DATE	DRN	CHKD	APPD	DESCRIPTION
02	29/09/25	SPS	LCA	CGI	AS-BUILT (ASB)
01	04/10/24	VBA	LCA	DLO	ACCEPTED FOR CONSTRUCTION (AFC)
00	23/08/24	VBA	LCA	DLO	ISSUE FOR REVIEW (IFR)

CROSSWIND

ROSETTI MARINO

TITLE :

BASE LOAD POWER HUB (BLPH)

Base Load Power HUB Cables Tray Layout


B-400 Container Lower Deck – TOS EL. 23.310m

CONTRACT NO./TITLE CW-I-WP4-2023-05/HOLLANDSE KUST NOORD WIND PARK			SCALE 1:50
DRAWN SPS	CHECKED LCA	APPROVED CGI	DATE 29/09/25
A1	DRAWING NO. 123A90-DDL-IN-DL-40116	SHEET 001	REV. 02

File Name : 123A90-DDL-IN-DL-40116 REV:02.dwg


DRAWING NO. 123A90-DDL-IN-DL-40116 REV. 02

B-400-SEC-1A-L-450-101-IST-093

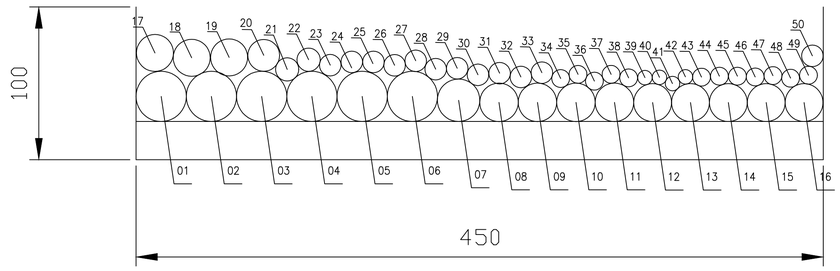

B-400-SEC-1A-L-450-101-IST-093				
POS	CABLE NAME	FROM	TO	FORMATION
1	950-JE-04201/B400-FGS-002	950-JE-04201	B400-FGS-002	6x3x2,5 mm2
2	950-JE-04205/B400-FGS-002	950-JE-04205	B400-FGS-002	6x3x2,5 mm2
3	950-JE-02103/B400-FGS-002	950-JE-02103	B400-FGS-002	6x3x2,5 mm2
4	00-JE-21002/B400-SIS-001	00-JE-21002	B400-SIS-001	12x2x0,75 mm2
5	00-JE-22002_1/B400-SIS-001	00-JE-22002_1	B400-SIS-001	12x2x0,75 mm2
6	00-JE-22002_2/B400-SIS-001	00-JE-22002_2	B400-SIS-001	12x2x0,75 mm2
7	00-JE-13002/B400-PCS-002	00-JE-13002	B400-PCS-002	24x2,5 mm2
8	950-JE-04102/B400-FGS-002	950-JE-04102	B400-FGS-002	6x2x0,75 mm2
9	950-JE-05102/B400-FGS-002	950-JE-05102	B400-FGS-002	6x2x0,75 mm2
10	B200-HSB-001/B400-FGS-002	950-JE-04202	B400-FGS-002	6x2x0,75 mm2
11	B300-HSB-001/B400-FGS-002	950-JE-04206	B400-FGS-002	6x2x0,75 mm2
12	00-JE-11003_1/B400-PCS-002	00-JE-11003_1	B400-PCS-002	12x2x0,75 mm2
13	00-JE-11003_2/B400-PCS-002	00-JE-11003_2	B400-PCS-002	12x2x0,75 mm2
14	00-JE-12004_1/B400-PCS-002	00-JE-12004_1	B400-PCS-002	12x2x0,75 mm2
15	00-JE-12004_2/B400-PCS-002	00-JE-12004_2	B400-PCS-002	12x2x0,75 mm2
16	00-JE-12005/B400-PCS-002	00-JE-12005	B400-PCS-002	12x2x0,75 mm2
17	00-JE-23002/B400-SIS-001	00-JE-23002	B400-SIS-001	12x2,5 mm2
18	UP-200F3/B400-SIS-001	UP-200F3	B400-SIS-001	12x2,5 mm2
19	950-JE-04207/B400-FGS-002	950-JE-04207	B400-FGS-002	12x2,5 mm2
20	00-JE-13003/B400-PCS-002	00-JE-13003	B400-PCS-002	12x2,5 mm2
21	C-B200-TIR-001/B400-PCS-002	B200-TIR-001	B400-PCS-002	2x2x0,75 mm2
22	C-B300-TIR-001/B400-PCS-002	B300-TIR-001	B400-PCS-002	2x2x0,75 mm2
23	C-77-XS-002/B400-SIS-001	77-XS-002	B400-SIS-001	2x2,5 mm2
24	C-77-XS-003/B400-SIS-001	77-XS-003	B400-SIS-001	2x2,5 mm2
25	C-SG-200N1-001/B400-SIS-001	SG-200N1-001	B400-SIS-001	2x2,5 mm2
26	C-SG-200N1-002/B400-SIS-001	SG-200N1-002	B400-SIS-001	2x2,5 mm2
27	C-CB-200F3A/B400-SIS-001	CB-200F3A	B400-SIS-001	2x2,5 mm2
28	C-CB-200F3B/B400-SIS-001	CB-200F3B	B400-SIS-001	2x2,5 mm2
29	C-CB-200F4A/B400-SIS-001	CB-200F4A	B400-SIS-001	2x2,5 mm2
30	C-CB-200F4B/B400-SIS-001	CB-200F4B	B400-SIS-001	2x2,5 mm2
31	C-UP-200F4/B400-SIS-001	UP-200F4	B400-SIS-001	2x2,5 mm2
32	C-NC-200F2/B400-FGS-002.01	N200F2	B400-FGS-002.01	1x2x0.75 mm2
33	C-NC-200F2/B400-FGS-002.02	N200F2	B400-FGS-002.02	2x2,5 mm2
34	C-NC-200F2/B400-SIS-001	N200F2	B400-SIS-001	2x2,5 mm2
35	C-77-XA-002/B400-SIS-001	77-XA-002	B400-SIS-001	1x2x0,75 mm2
36	C-77-XA-003/B400-SIS-001	77-XA-003	B400-SIS-001	1x2x0,75 mm2
37	C-950-MFA-04203/B400-FGS-002	950-MFA-04203	B400-FGS-002	1x2x0,75 mm2
38	C-950-MFA-04202/B400-FGS-002	950-MFA-04202	B400-FGS-002	1x2x0,75 mm2
39	C-B200-TDC-001/B400-PCS-002	B200-TD001	B400-PCS-002	1x2x0,75 mm2
40	C-B200-TDC-002/B400-PCS-002	B200-TD002	B400-PCS-002	1x2x0,75 mm2
41	C-B300-TDC-001/B400-PCS-002	B300-TD001	B400-PCS-002	1x2x0,75 mm2
42	C-B300-TDC-002/B400-PCS-002	B300-TD002	B400-PCS-002	1x2x0,75 mm2
43	C-950-SDZ-04201/B400-FGS-002	950-SDZ-04201	B400-FGS-002	1x2x0.75 mm2
44	C-950-SDZ-04202/B400-FGS-002	950-SDZ-04202	B400-FGS-002	1x2x0.75 mm2
45	C-950-SDZ-04203/B400-FGS-002	950-SDZ-04203	B400-FGS-002	1x2x0.75 mm2
46	C-950-GDZ-04201/B400-FGS-002	950-GDZ-04201	B400-FGS-002	1x2x0.75 mm2
47	C-950-GDZ-04202/B400-FGS-002	950-GDZ-04202	B400-FGS-002	1x2x0.75 mm2
48	C-950-GDZ-04203/B400-FGS-002	950-GDZ-04203	B400-FGS-002	1x2x0.75 mm2
49	C-77-ZSL-016/B400-FGS-002	77-ZSL-016	B400-FGS-002	1x2x0.75 mm2
50	C-77-HY-016/77-HS-016A	77-HY-016	77-HS-016A	2x2,5 mm2

B-400-SEC-1A-L-450-101-IST-069

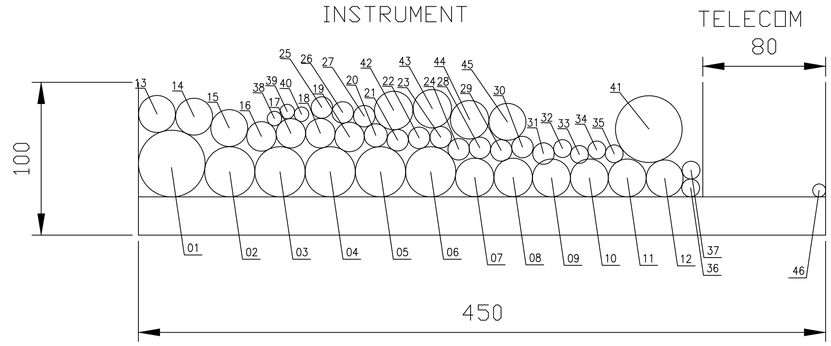

B-400-SEC-1A-L-450-101-IST-069				
POS	CABLE NAME	FROM	TO	FORMATION
1	950-JE-05101/B400-FGS-002	950-JE-05101	B400-FGS-002	12x3x2,5 mm2
2	950-JE-01101/B400-FGS-002	950-JE-01101	B400-FGS-002	6x3x2,5 mm2
3	950-JE-04101/B400-FGS-002	950-JE-04101	B400-FGS-002	6x3x2,5 mm2
4	950-JE-06101/B400-FGS-002	950-JE-06101	B400-FGS-002	6x3x2,5 mm2
5	950-JE-06201/B400-FGS-002	950-JE-06201	B400-FGS-002	6x3x2,5 mm2
6	950-JE-01102/B400-FGS-002	950-JE-01102	B400-FGS-002	6x3x2,5 mm2
7	B100-HSB-001/B400-FGS-002	950-JE-06202	B400-FGS-002	6x2x0,75 mm2
8	950-JE-01103/B400-FGS-002	950-JE-01103	B400-FGS-002	6x2x0,75 mm2
9	00-JE-11004/B400-PCS-002	00-JE-11004	B400-PCS-002	12x2x0,75 mm2
10	00-JE-12006_1/B400-PCS-002	00-JE-12006_1	B400-PCS-002	12x2x0,75 mm2
11	00-JE-12006_2/B400-PCS-002	00-JE-12006_2	B400-PCS-002	12x2x0,75 mm2
12	950-JE-01104/B400-FGS-002	950-JE-01104	B400-FGS-002	12x2,5 mm2
13	950-JE-04103/B400-FGS-002	950-JE-04103	B400-FGS-002	12x2,5 mm2
14	950-JE-05103/B400-FGS-002	950-JE-05103	B400-FGS-002	12x2,5 mm2
15	950-JE-06203/B400-FGS-002	950-JE-06203	B400-FGS-002	12x2,5 mm2
16	00-JE-11005/B400-PCS-002	00-JE-11005	B400-PCS-002	6x2x0,75 mm2
17	20-UCP-001/B400-FGS-002	20-UCP-001	B400-FGS-002	2x2x0,75 mm2
18	P320PLC/B400-FGS-002	P320 PLC	B400-FGS-002	2x2x0,75 mm2
19	P320PLC/B400-SIS-001	P320 PLC	B400-SIS-001	2x2x0,75 mm2
20	C-B100-TIR-001/B400-PCS-002	B100-TIR-001	B400-PCS-002	2x2x0,75 mm2
21	C-85-XS-001/B400-SIS-001	85-XS-001	B400-SIS-001	2x2,5 mm2
22	C-20-XS-001/B400-SIS-001	20-XS-001	B400-SIS-001	2x2,5 mm2
23	C-63-XS-001/B400-SIS-001	63-XS-001	B400-SIS-001	2x2,5 mm2
24	C-64-XS-001/B400-SIS-001	64-XS-001	B400-SIS-001	2x2,5 mm2
25	C-77-XS-001/B400-SIS-001	77-XS-001	B400-SIS-001	2x2,5 mm2
26	C-CP-100E1/B400-SIS-001	CP-100E1	B400-SIS-001	2x2,5 mm2
27	C-SG-100D1-001/B400-SIS-001	SG-100D1-001	B400-SIS-001	2x2,5 mm2
28	C-SG-100D1-002/B400-SIS-001	SG-100D1-002	B400-SIS-001	2x2,5 mm2
29	C-SG-100D1-003/B400-SIS-001	SG-100D1-003	B400-SIS-001	2x2,5 mm2
30	C-CB-200F1/B400-SIS-001	CB-200F1	B400-SIS-001	2x2,5 mm2
31	C-UP-200F1/B400-SIS-001	UP-200F1	B400-SIS-001	2x2,5 mm2
32	C-77-XA-001/B400-SIS-001	77-XA-001	B400-SIS-001	1x2x0,75 mm2
33	C-63-PT-004/B400-SIS-001	63-PT-004	B400-SIS-001	1x2x0,75 mm2
34	C-20-XA-003/B400-SIS-001	20-XA-003	B400-SIS-001	1x2x0,75 mm2
35	C-63-XA-003/B400-SIS-001	63-XA-003	B400-SIS-001	1x2x0,75 mm2
36	C-64-XA-003/B400-SIS-001	64-XA-003	B400-SIS-001	1x2x0,75 mm2
37	C-950-MFA-06201/B400-FGS-002	950-MFA-06201	B400-FGS-002	1x2x0,75 mm2
38	C-63-PT-003/B400-PCS-002	63-PT-003	B400-PCS-002	1x2x0,75 mm2
39	C-B100-TDC-001/B400-PCS-002	B100-TDC001	B400-PCS-002	1x2x0,75 mm2
40	C-B100-TDC-002/B400-PCS-002	B100-TDC002	B400-PCS-002	1x2x0,75 mm2
41	950-JE-03101/B400-FGS-002	950-JE-03101	B400-FGS-002	12x3x2.5 mm2
42	950-JE-06204/B400-FGS-002	950-JE-06204	B400-FGS-002	6x2x0.75 mm2
43	950-JE-04204/B400-FGS-002	950-JE-04204	B400-FGS-002	6x2x0.75 mm2
44	950-JE-04208/B400-FGS-002	950-JE-04208	B400-FGS-002	6x2x0.75 mm2
45	950-JE-04203/B400-FGS-002	950-JE-04203	B400-FGS-002	12x2.5 mm2
46	HNA6/B400-NET-001	HNA6	B400-NET-001	FO12 OS2
47	C-GPSANT/B400-NET-001	C-GPSANT	B400-NET-001	STD-VENDOR

INSERT SUBCONTRACTOR / VENDOR LOGO HERE

REV.	DATE	DRN	CHKD	APPD	DESCRIPTION
02	29/09/25	SPS	LCA	CGI	AS-BUILT (ASB)
01	04/10/24	VBA	LCA	DLO	ACCEPTED FOR CONSTRUCTION (AFC)
00	23/08/24	VBA	LCA	DLO	ISSUE FOR REVIEW (IFR)

CROSSWIND

ROSETTI MARINO

TITLE :
BASE LOAD POWER HUB (BLPH)
Base Load Power HUB Cables Tray Layout
B-400 Container Lower Deck – TOS EL. 23.310m

CONTRACT NO./TITLE CW-I-WP4-2023-05/HOLLANDSE KUST NOORD WIND PARK | SCALE 1:50

DRAWN SPS | CHECKED LCA | APPROVED CGI | DATE 29/09/25


A1 | DRAWING NO. 123A90-DDL-IN-DL-40116 | SHEET 002 | REV. 02

File Name : 123A90-DDL-IN-DL-40116 REV02.dwg

DRAWING NO. 123A90-DDL-IN-DL-40116


REV. 02

B-400-SEC-1B-L-450-101-IST-069

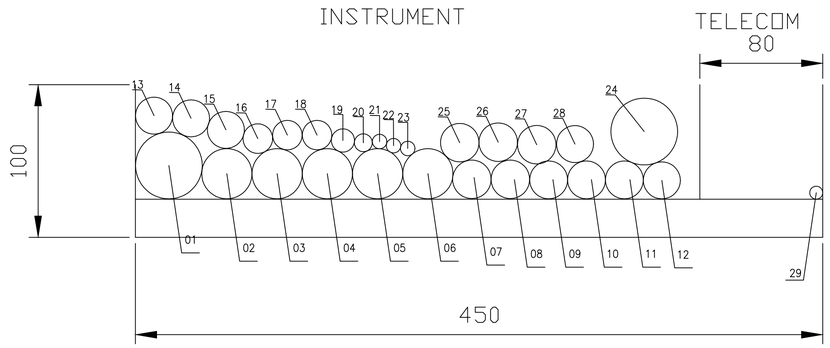

B-400-SEC-1B-L-450-101-IST-069				
POS	CABLE NAME	FROM	TO	FORMATION
1	950-JE-05101/B400-FGS-002	950-JE-05101	B400-FGS-002	12x3x2,5 mm2
2	950-JE-01101/B400-FGS-002	950-JE-01101	B400-FGS-002	6x3x2,5 mm2
3	950-JE-04101/B400-FGS-002	950-JE-04101	B400-FGS-002	6x3x2,5 mm2
4	950-JE-06101/B400-FGS-002	950-JE-06101	B400-FGS-002	6x3x2,5 mm2
5	950-JE-06201/B400-FGS-002	950-JE-06201	B400-FGS-002	6x3x2,5 mm2
6	950-JE-01102/B400-FGS-002	950-JE-01102	B400-FGS-002	6x3x2,5 mm2
7	B100-HSB-001/B400-FGS-002	950-JE-06202	B400-FGS-002	6x2x0,75 mm2
8	950-JE-01103/B400-FGS-002	950-JE-01103	B400-FGS-002	6x2x0,75 mm2
9	00-JE-11004/B400-PCS-002	00-JE-11004	B400-PCS-002	12x2x0,75 mm2
10	00-JE-12006_1/B400-PCS-002	00-JE-12006_1	B400-PCS-002	12x2x0,75 mm2
11	00-JE-12006_2/B400-PCS-002	00-JE-12006_2	B400-PCS-002	12x2x0,75 mm2
12	950-JE-01104/B400-FGS-002	950-JE-01104	B400-FGS-002	12x2,5 mm2
13	950-JE-04103/B400-FGS-002	950-JE-04103	B400-FGS-002	12x2,5 mm2
14	950-JE-05103/B400-FGS-002	950-JE-05103	B400-FGS-002	12x2,5 mm2
15	950-JE-06203/B400-FGS-002	950-JE-06203	B400-FGS-002	12x2,5 mm2
16	00-JE-11005/B400-PCS-002	00-JE-11005	B400-PCS-002	6x2x0,75 mm2
17	20-UCP-001/B400-FGS-002	20-UCP-001	B400-FGS-002	2x2x0,75 mm2
18	P320PLC/B400-FGS-002	P320 PLC	B400-FGS-002	2x2x0,75 mm2
19	C-B100-TIR-001/B400-PCS-002	B100-TIR-001	B400-PCS-002	2x2x0,75 mm2
20	C-950-MFA-06201/B400-FGS-002	950-MFA-06201	B400-FGS-002	1x2x0,75 mm2
21	C-63-PT-003/B400-PCS-002	63-PT-003	B400-PCS-002	1x2x0,75 mm2
22	C-B100-TDC-001/B400-PCS-002	B100-TDC001	B400-PCS-002	1x2x0,75 mm2
23	C-B100-TDC-002/B400-PCS-002	B100-TDC002	B400-PCS-002	1x2x0,75 mm2
24	950-JE-03101/B400-FGS-002	950-JE-03101	B400-FGS-002	12x3x2.5 mm2
25	950-JE-06204/B400-FGS-002	950-JE-06204	B400-FGS-002	6x2x0,75 mm2
26	950-JE-04204/B400-FGS-002	950-JE-04204	B400-FGS-002	6x2x0,75 mm2
27	950-JE-04208/B400-FGS-002	950-JE-04208	B400-FGS-002	6x2x0,75 mm2
28	950-JE-04203/B400-FGS-002	950-JE-04203	B400-FGS-002	12x2.5 mm2
29	HNA6/B400-NET-001	HNA6	B400-NET-001	FO12 OS2
30	C-GPSANT/B400-NET-001	C-GPSANT	B400-NET-001	STD-VENDOR

B-400-SEC-1B-L-450-101-IST-093

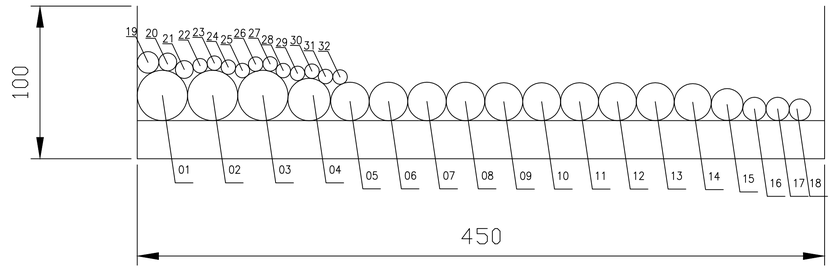

B-400-SEC-1B-L-450-101-IST-093				
POS	CABLE NAME	FROM	TO	FORMATION
1	950-JE-04201/B400-FGS-002	950-JE-04201	B400-FGS-002	6x3x2,5 mm2
2	950-JE-04205/B400-FGS-002	950-JE-04205	B400-FGS-002	6x3x2,5 mm2
3	950-JE-02103/B400-FGS-002	950-JE-02103	B400-FGS-002	6x3x2,5 mm2
4	00-JE-13002/B400-PCS-002	00-JE-13002	B400-PCS-002	24x2,5 mm2
5	950-JE-04102/B400-FGS-002	950-JE-04102	B400-FGS-002	6x2x0,75 mm2
6	950-JE-05102/B400-FGS-002	950-JE-05102	B400-FGS-002	6x2x0,75 mm2
7	B200-HSB-001/B400-FGS-002	950-JE-04202	B400-FGS-002	6x2x0,75 mm2
8	B300-HSB-001/B400-FGS-002	950-JE-04206	B400-FGS-002	6x2x0,75 mm2
9	00-JE-11003_1/B400-PCS-002	00-JE-11003_1	B400-PCS-002	12x2x0,75 mm2
10	00-JE-11003_2/B400-PCS-002	00-JE-11003_2	B400-PCS-002	12x2x0,75 mm2
11	00-JE-12004_1/B400-PCS-002	00-JE-12004_1	B400-PCS-002	12x2x0,75 mm2
12	00-JE-12004_2/B400-PCS-002	00-JE-12004_2	B400-PCS-002	12x2x0,75 mm2
13	00-JE-12005/B400-PCS-002	00-JE-12005	B400-PCS-002	12x2x0,75 mm2
14	950-JE-04207/B400-FGS-002	950-JE-04207	B400-FGS-002	12x2,5 mm2
15	00-JE-13003/B400-PCS-002	00-JE-13003	B400-PCS-002	12x2,5 mm2
16	C-B200-TIR-001/B400-PCS-002	B200-TIR-001	B400-PCS-002	2x2x0,75 mm2
17	C-B300-TIR-001/B400-PCS-002	B300-TIR-001	B400-PCS-002	2x2x0,75 mm2
18	C-NC-200F2/B400-FGS-002.01	N200F2	B400-FGS-002.01	1x2x0.75 mm2
19	C-NC-200F2/B400-FGS-002.02	N200F2	B400-FGS-002.02	2x2.5 mm2
20	C-950-MFA-04203/B400-FGS-002	950-MFA-04203	B400-FGS-002	1x2x0,75 mm2
21	C-950-MFA-04202/B400-FGS-002	950-MFA-04202	B400-FGS-002	1x2x0,75 mm2
22	C-B200-TDC-001/B400-PCS-002	B200-TD001	B400-PCS-002	1x2x0,75 mm2
23	C-B200-TDC-002/B400-PCS-002	B200-TD002	B400-PCS-002	1x2x0,75 mm2
24	C-B300-TDC-001/B400-PCS-002	B300-TD001	B400-PCS-002	1x2x0,75 mm2
25	C-B300-TDC-002/B400-PCS-002	B300-TD002	B400-PCS-002	1x2x0,75 mm2
26	C-950-SDZ-04201/B400-FGS-002	950-SDZ-04201	B400-FGS-002	1x2x0,75 mm2
27	C-950-SDZ-04202/B400-FGS-002	950-SDZ-04202	B400-FGS-002	1x2x0,75 mm2
28	C-950-SDZ-04203/B400-FGS-002	950-SDZ-04203	B400-FGS-002	1x2x0,75 mm2
29	C-950-GDZ-04201/B400-FGS-002	950-GDZ-04201	B400-FGS-002	1x2x0,75 mm2
30	C-950-GDZ-04202/B400-FGS-002	950-GDZ-04202	B400-FGS-002	1x2x0,75 mm2
31	C-950-GDZ-04203/B400-FGS-002	950-GDZ-04203	B400-FGS-002	1x2x0,75 mm2
32	C-77-ZSL-016/B400-FGS-002	77-ZSL-016	B400-FGS-002	1x2x0,75 mm2

INSERT SUBCONTRACTOR / VENDOR LOGO HERE

REV.	DATE	DRN	CHKD	APPD	DESCRIPTION
02	29/09/25	SPS	LCA	CGI	AS-BUILT (ASB)
01	04/10/24	VBA	LCA	DLO	ACCEPTED FOR CONSTRUCTION (AFC)
00	23/08/24	VBA	LCA	DLO	ISSUE FOR REVIEW (IFR)

CROSSWIND

ROSETTI MARINO

TITLE :
BASE LOAD POWER HUB (BLPH)
Base Load Power HUB Cables Tray Layout
B-400 Container Lower Deck – TOS EL. 23.310m

CONTRACT NO./TITLE CW-I-WP4-2023-05/HOLLANDSE KUST NOORD WIND PARK | SCALE 1:50

DRAWN SPS | CHECKED LCA | APPROVED CGI | DATE 29/09/25


A1 | DRAWING NO. 123A90-DDL-IN-DL-40116 | SHEET 003 | REV. 02

File Name : 123A90-DDL-IN-DL-40116 REV.02.dwg

DRAWING NO. 123A90-DDL-IN-DL-40116


REV. 02

B-400-SEC-2A-L-600-101-IST-070

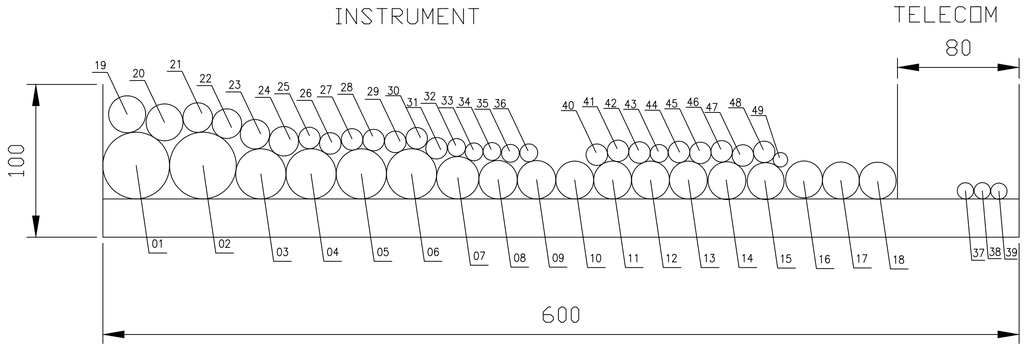

B-400-SEC-2A-L-600-101-IST-070				
POS	CABLE NAME	FROM	TO	FORMATION
1	950-JE-02101/B400-FGS-002	950-JE-021001	B400-FGS-002	12x3x2,5 mm2
2	950-JE-02102/B400-FGS-002	950-JE-021002	B400-FGS-002	12x3x2,5 mm2
3	950-JE-03102/B400-FGS-002	950-JE-031002	B400-FGS-002	6x3x2,5 mm2
4	00-JE-21001/B400-SIS-001	00-JE-21001	B400-SIS-001	12x2x0,75 mm2
5	00-JE-22001_1/B400-SIS-001	00-JE-22001_1	B400-SIS-001	12x2x0,75 mm2
6	00-JE-22001_2/B400-SIS-001	00-JE-22001_2	B400-SIS-001	12x2x0,75 mm2
7	00-JE-13001/B400-PCS-002	00-JE-13001	B400-PCS-002	24x2,5 mm2
8	950-JE-03103/B400-FGS-002	950-JE-031003	B400-FGS-002	6x2x0,75 mm2
9	950-JE-06102/B400-FGS-002	950-JE-061002	B400-FGS-002	6x2x0,75 mm2
10	00-JE-11001_1/B400-PCS-002	00-JE-11001_1	B400-PCS-002	12x2x0,75 mm2
11	00-JE-11001_2/B400-PCS-002	00-JE-11001_2	B400-PCS-002	12x2x0,75 mm2
12	00-JE-11002/B400-PCS-002	00-JE-11002_1	B400-PCS-002	12x2x0,75 mm2
13	00-JE-12001_1/B400-PCS-002	00-JE-12001_1	B400-PCS-002	12x2x0,75 mm2
14	00-JE-12001_2/B400-PCS-002	00-JE-12001_2	B400-PCS-002	12x2x0,75 mm2
15	00-JE-23001/B400-SIS-001	00-JE-23001	B400-SIS-001	12x2,5 mm2
16	950-JE-02104/B400-FGS-002	950-JE-021004	B400-FGS-002	12x2,5 mm2
17	950-JE-03104/B400-FGS-002	950-JE-031004	B400-FGS-002	12x2,5 mm2
18	950-JE-06103/B400-FGS-002	950-JE-061003	B400-FGS-002	12x2,5 mm2
19	950-JE-07101/B400-FGS-002	950-JE-071001	B400-FGS-002	12x2,5 mm2
20	950-JE-05104/B400-FGS-002	950-JE-051004	B400-FGS-002	12x2,5 mm2
21	00-JE-12002/B400-PCS-002	00-JE-12002	B400-PCS-002	6x2x0,75 mm2
22	00-JE-12003/B400-PCS-002	00-JE-12003	B400-PCS-002	6x2x0,75 mm2
23	80-UCP-001/B400-FGS-002	80-FGS-001	B400-FGS-002	2x2x0,75 mm2
24	50-LP-002/B400-FGS-002	50-LP-002	B400-FGS-002	2x2x0,75 mm2
25	C-80-XS-001/B400-SIS-001	80-XS-001	B400-SIS-001	2x2,5 mm2
26	C-50-XS-001/B400-SIS-001	50-XS-001	B400-SIS-001	2x2,5 mm2
27	C-77-HS-012A/77-HS-012B	77-HS-012A	77-HS-012B	2x2,5 mm2
28	C-77-HS-013A/77-HS-013B	77-HS-013A	77-HS-013B	2x2,5 mm2
29	C-77-HS-014A/77-HS-014B	77-HS-014A	77-HS-015B	2x2,5 mm2
30	C-77-HS-015A/77-HS-015B	77-HS-015A	77-HS-015B	2x2,5 mm2
31	C-77-HS-016A/77-HS-016B	77-HS-016A	77-HS-016B	2x2,5 mm2
32	C-80-XA-003/B400-SIS-001	80-XA-003	B400-SIS-001	1x2x0,75 mm2
33	C-50-XA-003/B400-SIS-001	50-XA-003	B400-SIS-001	1x2x0,75 mm2
34	C-950-MFA-02101/B400-FGS-002	950-MFA-02101	B400-FGS-002	1x2x0,75 mm2
35	C-950-MFA-07101/B400-FGS-002	950-MFA-07101	B400-FGS-002	1x2x0,75 mm2
36	C-950-MFA-05201/B400-FGS-002	950-MFA-05201	B400-FGS-002	1x2x0,75 mm2
37	80-UCP-001/B400-NET-001.01	80-UCP-001	B400-NET-001.01	CAT.6A 4x2xAWG23
38	80-UCP-001/B400-NET-001.02	80-UCP-001	B400-NET-001.02	CAT.6A 4x2xAWG23
39	50-LP-001/B400-NET-001	50-LP-001	B400-NET-001	CAT.6A 4x2xAWG23
40	C-950-XZ-04201/B400-FGS-002	950-XZ-04201	B400-FGS-002	2x2,5 mm2
41	C-950-XL-04201/B400-FGS-002	950-XL-04201	B400-FGS-002	2x2,5 mm2
42	C-950-XL-04202/B400-FGS-002	950-XL-04202	B400-FGS-002	2x2,5 mm2
43	C-950-MFA-04201/B400-FGS-002	950-MFA-04201	B400-FGS-002	1x2x0,75 mm2
44	C-77-HS-012B/B400-FGS-002	77-HS-012B	B400-FGS-002	2x2,5 mm2
45	C-77-HS-013B/B400-FGS-002	77-HS-013B	B400-FGS-002	2x2,5 mm2
46	C-77-HS-014B/B400-FGS-002	77-HS-014B	B400-FGS-002	2x2,5 mm2
47	C-77-HS-015B/B400-FGS-002	77-HS-015B	B400-FGS-002	2x2,5 mm2
48	C-77-HS-016B/B400-FGS-002	77-HS-016B	B400-FGS-002	2x2,5 mm2
49	C-B400-TDC-001/B400-PCS-002	B400-TDC-001	B400-PCS-002	1x2x0,75 mm2

B-400-SEC-2B-L-600-101-IST-070

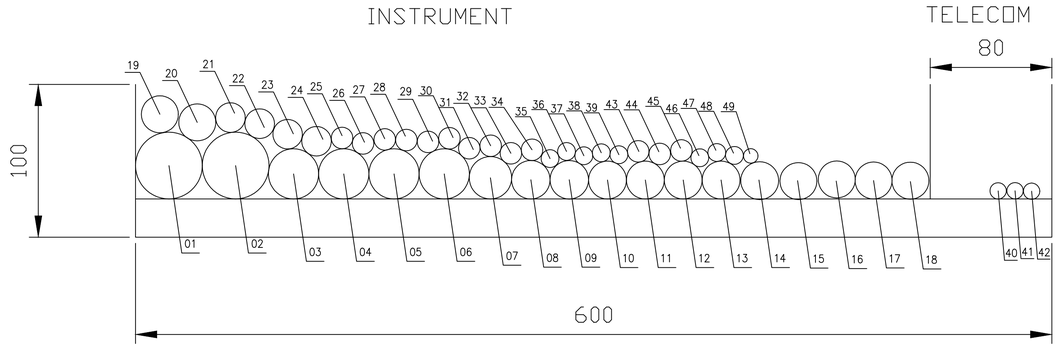

B-400-SEC-2B-L-600-101-IST-070				
POS	CABLE NAME	FROM	TO	FORMATION
1	950-JE-02101/B400-FGS-002	950-JE-021001	B400-FGS-002	12x3x2,5 mm2
2	950-JE-02102/B400-FGS-002	950-JE-021002	B400-FGS-002	12x3x2,5 mm2
3	950-JE-03102/B400-FGS-002	950-JE-031002	B400-FGS-002	6x3x2,5 mm2
4	00-JE-21001/B400-SIS-001	00-JE-21001	B400-SIS-001	12x2x0,75 mm2
5	00-JE-22001_1/B400-SIS-001	00-JE-22001_1	B400-SIS-001	12x2x0,75 mm2
6	00-JE-22001_2/B400-SIS-001	00-JE-22001_2	B400-SIS-001	12x2x0,75 mm2
7	00-JE-13001/B400-PCS-002	00-JE-13001	B400-PCS-002	24x2,5 mm2
8	950-JE-03103/B400-FGS-002	950-JE-031003	B400-FGS-002	6x2x0,75 mm2
9	950-JE-06102/B400-FGS-002	950-JE-061002	B400-FGS-002	6x2x0,75 mm2
10	00-JE-11001_1/B400-PCS-002	00-JE-11001_1	B400-PCS-002	12x2x0,75 mm2
11	00-JE-11001_2/B400-PCS-002	00-JE-11001_2	B400-PCS-002	12x2x0,75 mm2
12	00-JE-11002/B400-PCS-002	00-JE-11002_1	B400-PCS-002	12x2x0,75 mm2
13	00-JE-12001_1/B400-PCS-002	00-JE-12001_1	B400-PCS-002	12x2x0,75 mm2
14	00-JE-12001_2/B400-PCS-002	00-JE-12001_2	B400-PCS-002	12x2x0,75 mm2
15	00-JE-23001/B400-SIS-001	00-JE-23001	B400-SIS-001	12x2,5 mm2
16	950-JE-02104/B400-FGS-002	950-JE-021004	B400-FGS-002	12x2,5 mm2
17	950-JE-03104/B400-FGS-002	950-JE-031004	B400-FGS-002	12x2,5 mm2
18	950-JE-06103/B400-FGS-002	950-JE-061003	B400-FGS-002	12x2,5 mm2
19	950-JE-07101/B400-FGS-002	950-JE-071001	B400-FGS-002	12x2,5 mm2
20	950-JE-05104/B400-FGS-002	950-JE-051004	B400-FGS-002	12x2,5 mm2
21	00-JE-12002/B400-PCS-002	00-JE-12002	B400-PCS-002	6x2x0,75 mm2
22	00-JE-12003/B400-PCS-002	00-JE-12003	B400-PCS-002	6x2x0,75 mm2
23	80-UCP-001/B400-FGS-002	80-FGS-001	B400-FGS-002	2x2x0,75 mm2
24	50-LP-002/B400-FGS-002	50-LP-002	B400-FGS-002	2x2x0,75 mm2
25	C-80-XS-001/B400-SIS-001	80-XS-001	B400-SIS-001	2x2,5 mm2
26	C-50-XS-001/B400-SIS-001	50-XS-001	B400-SIS-001	2x2,5 mm2
27	C-77-HS-012B/B400-FGS-002	77-HS-012B	B400-FGS-002	2x2,5 mm2
28	C-77-HY-012/77-HS-012A	HFD-77012	77-HS-012A	2x2,5 mm2
29	C-77-HS-013B/B400-FGS-002	77-HS-013B	B400-FGS-002	2x2,5 mm2
30	C-77-HY-013/77-HS-013A	HFD-77013	77-HS-0013A	2x2,5 mm2
31	C-77-HS-014B/B400-FGS-002	77-HS-014B	B400-FGS-002	2x2,5 mm2
32	C-77-HS-015B/B400-FGS-002	77-HS-015B	B400-FGS-002	2x2,5 mm2
33	C-77-HS-016B/B400-FGS-002	77-HS-016B	B400-FGS-002	2x2,5 mm2
34	C-77-HY-016/77-HS-016A	HFD-77016	77-HS-016A	2x2,5 mm2
35	C-80-XA-003/B400-SIS-001	80-XA-003	B400-SIS-001	1x2x0,75 mm2
36	C-50-XA-003/B400-SIS-001	50-XA-003	B400-SIS-001	1x2x0,75 mm2
37	C-950-MFA-02101/B400-FGS-002	950-MFA-02101	B400-FGS-002	1x2x0,75 mm2
38	C-950-MFA-07101/B400-FGS-002	950-MFA-07101	B400-FGS-002	1x2x0,75 mm2
39	C-950-MFA-05201/B400-FGS-002	950-MFA-05201	B400-FGS-002	1x2x0,75 mm2
40	80-UCP-001/B400-NET-001.01	80-UCP-001	B400-NET-001.01	CAT.6A 4x2xAWG23
41	80-UCP-001/B400-NET-001.02	80-UCP-001	B400-NET-001.02	CAT.6A 4x2xAWG23
42	50-LP-001/B400-NET-001	50-LP-001	B400-NET-001	CAT.6A 4x2xAWG23
43	C-950-XZ-04201/B400-FGS-002	950-XZ-04201	B400-FGS-002	2x2,5 mm2
44	C-950-XL-04201/B400-FGS-002	950-XL-04201	B400-FGS-002	2x2,5 mm2
45	C-950-XL-04202/B400-FGS-002	950-XL-04202	B400-FGS-002	2x2,5 mm2
46	C-950-MFA-04201/B400-FGS-002	950-MFA-04201	B400-FGS-002	1x2x0,75 mm2
47	C-77-ZSL-014/B400-FGS-002	77-ZSL-014	B400-FGS-002	1x2x0,75 mm2
48	C-77-ZSL-015/B400-FGS-002	77-ZSL-015	B400-FGS-002	1x2x0,75 mm2
49	C-B400-TDC-001/B400-PCS-002	B400-TDC-001	B400-PCS-002	1x2x0,75 mm2

INSERT SUBCONTRACTOR / VENDOR LOGO HERE

REV.	DATE	DRN	CHKD	APPD	DESCRIPTION
02	29/09/25	SPS	LCA	CGI	AS-BUILT (ASB)
01	04/10/24	VBA	LCA	DLO	ACCEPTED FOR CONSTRUCTION (AFC)
00	23/08/24	VBA	LCA	DLO	ISSUE FOR REVIEW (IFR)

CROSSWIND

ROSETTI MARINO

TITLE :
BASE LOAD POWER HUB (BLPH)
Base Load Power HUB Cables Tray Layout
B-400 Container Lower Deck – TOS EL. 23.310m

CONTRACT NO./TITLE CW-I-WP4-2023-05/HOLLANDSE KUST NOORD WIND PARK | SCALE 1:50

DRAWN SPS | CHECKED LCA | APPROVED CGI | DATE 29/09/25


A1 | DRAWING NO. 123A90-DDL-IN-DL-40116 | SHEET 004 | REV. 02

File Name : 123A90-DDL-IN-DL-40116 REV02.dwg

DRAWING NO. 123A90-DDL-IN-DL-40116

REV. 02


B-400-SEC-2C-L-600-101-IST-070

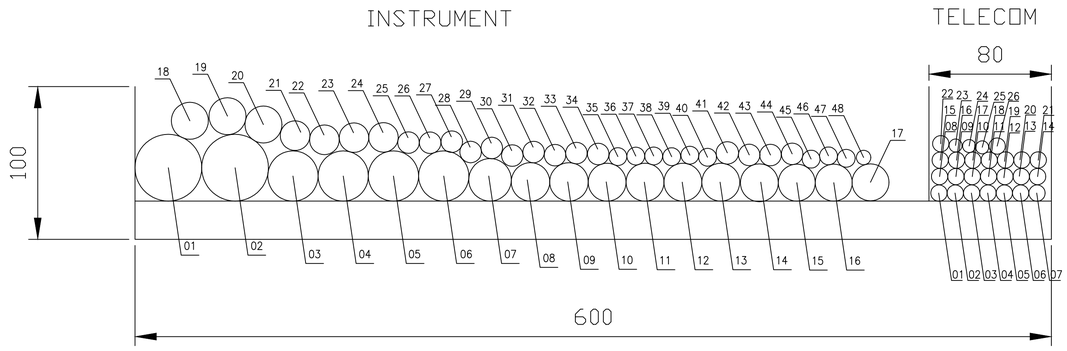

B-400-SEC-2C-L-600-101-IST-070				
POS	CABLE NAME	FROM	TO	FORMATION
1	950-JE-02101/B400-FGS-002	950-JE-021001	B400-FGS-002	12x3x2,5 mm2
2	950-JE-02102/B400-FGS-002	950-JE-021002	B400-FGS-002	12x3x2,5 mm2
3	950-JE-03102/B400-FGS-002	950-JE-031002	B400-FGS-002	6x3x2,5 mm2
4	00-JE-21001/B400-SIS-001	00-JE-21001	B400-SIS-001	12x2x0,75 mm2
5	00-JE-22001_1/B400-SIS-001	00-JE-22001_1	B400-SIS-001	12x2x0,75 mm2
6	00-JE-22001_2/B400-SIS-001	00-JE-22001_2	B400-SIS-001	12x2x0,75 mm2
7	00-JE-13001/B400-PCS-002	00-JE-13001	B400-PCS-002	24x2,5 mm2
8	950-JE-03103/B400-FGS-002	950-JE-031003	B400-FGS-002	6x2x0,75 mm2
9	950-JE-06102/B400-FGS-002	950-JE-061002	B400-FGS-002	6x2x0,75 mm2
10	00-JE-11001_1/B400-PCS-002	00-JE-11001_1	B400-PCS-002	12x2x0,75 mm2
11	00-JE-11001_2/B400-PCS-002	00-JE-11001_2	B400-PCS-002	12x2x0,75 mm2
12	00-JE-11002/B400-PCS-002	00-JE-11002_1	B400-PCS-002	12x2x0,75 mm2
13	00-JE-12001_1/B400-PCS-002	00-JE-12001_1	B400-PCS-002	12x2x0,75 mm2
14	00-JE-12001_2/B400-PCS-002	00-JE-12001_2	B400-PCS-002	12x2x0,75 mm2
15	00-JE-23001/B400-SIS-001	00-JE-23001	B400-SIS-001	12x2,5 mm2
16	950-JE-02104/B400-FGS-002	950-JE-021004	B400-FGS-002	12x2,5 mm2
17	950-JE-03104/B400-FGS-002	950-JE-031004	B400-FGS-002	12x2,5 mm2
18	950-JE-06103/B400-FGS-002	950-JE-061003	B400-FGS-002	12x2,5 mm2
19	950-JE-07101/B400-FGS-002	950-JE-071001	B400-FGS-002	12x2,5 mm2
20	950-JE-05104/B400-FGS-002	950-JE-051004	B400-FGS-002	12x2,5 mm2
21	00-JE-12002/B400-PCS-002	00-JE-12002	B400-PCS-002	6x2x0,75 mm2
22	00-JE-12003/B400-PCS-002	00-JE-12003	B400-PCS-002	6x2x0,75 mm2
23	80-UCP-001/B400-FGS-002	80-FGS-001	B400-FGS-002	2x2x0.75 mm2
24	50-LP-002/B400-FGS-002	50-LP-002	B400-FGS-002	2x2x0,75 mm2
25	C-80-XS-001/B400-SIS-001	80-XS-001	B400-SIS-001	2x2,5 mm2
26	C-50-XS-001/B400-SIS-001	50-XS-001	B400-SIS-001	2x2,5 mm2
27	C-77-HS-012B/B400-FGS-002	77-HS-012B	B400-FGS-002	2x2,5 mm2
28	C-77-HY-012/77-HS-012A	HFD-77012	77-HS-012A	2x2,5 mm2
29	C-77-HS-013B/B400-FGS-002	77-HS-013B	B400-FGS-002	2x2,5 mm2
30	C-77-HY-013/77-HS-013A	HFD-77013	77-HS-0013A	2x2,5 mm2
31	C-77-HS-014B/B400-FGS-002	77-HS-014B	B400-FGS-002	2x2,5 mm2
32	C-77-HS-015B/B400-FGS-002	77-HS-015B	B400-FGS-002	2x2,5 mm2
33	C-77-HS-016B/B400-FGS-002	77-HS-016B	B400-FGS-002	2x2,5 mm2
34	C-77-HY-016/77-HS-016A	HFD-77016	77-HS-016A	2x2,5 mm2
35	C-80-XA-003/B400-SIS-001	80-XA-003	B400-SIS-001	1x2x0,75 mm2
36	C-50-XA-003/B400-SIS-001	50-XA-003	B400-SIS-001	1x2x0,75 mm2
37	C-950-MFA-02101/B400-FGS-002	950-MFA-02101	B400-FGS-002	1x2x0,75 mm2
38	C-950-MFA-07101/B400-FGS-002	950-MFA-07101	B400-FGS-002	1x2x0,75 mm2
39	C-950-MFA-05201/B400-FGS-002	950-MFA-05201	B400-FGS-002	1x2x0,75 mm2
40	C-950-SDZ-04206/B400-FGS-002	950-SDZ-04206	B400-FGS-002	1x2x0,75 mm2
41	C-950-GDZ-04206/B400-FGS-002	950-GDZ-04206	B400-FGS-002	3x2.5 mm2
42	C-950-XZ-04201/B400-FGS-002	950-XZ-04201	B400-FGS-002	2x2.5 mm2
43	C-950-XL-04201/B400-FGS-002	950-XL-04201	B400-FGS-002	2x2.5 mm2
44	C-950-XL-04202/B400-FGS-002	950-XL-04202	B400-FGS-002	2x2.5 mm2
45	C-950-MFA-04201/B400-FGS-002	950-MFA-04201	B400-FGS-002	1x2x0.75 mm2
46	C-77-ZSL-014/B400-FGS-002	77-ZSL-014	B400-FGS-002	1x2x0.75 mm2
47	C-77-ZSL-015/B400-FGS-002	77-ZSL-015	B400-FGS-002	1x2x0.75 mm2
48	C-B400-TDC-001/B400-PCS-002	B400-TDC-001	B400-PCS-002	1x2x0.75 mm2

B-400-SEC-2C-L-600-101-IST-070				
POS	CABLE NAME	FROM	TO	FORMATION
1	TR-100AD1AVR/B400-NET-001	TR-100AD1AVR	B400-NET-001	CAT.6A 4x2xAWG23
2	B100-HSB-001/B400-NET-001	B100-HSB-001	B400-NET-001	CAT.6A 4x2xAWG23
3	B200-HSB-001/B400-NET-001	B200-HSB-001	B400-NET-001	CAT.6A 4x2xAWG23
4	SG-100D1/B400-NET-001.01	SG-100D1	B400-NET-001	CAT.6A 4x2xAWG23
5	SG-100D1/B400-NET-001.02	SG-100D1	B400-NET-001	CAT.6A 4x2xAWG23
6	SG-100D1/B400-NET-001.03	SG-100D1	B400-NET-001	CAT.6A 4x2xAWG23
7	SG-200N1/B400-NET-001.01	SG-200N1	B400-NET-001	CAT.6A 4x2xAWG23
8	SG-200N1/B400-NET-001.02	SG-200N1	B400-NET-001	CAT.6A 4x2xAWG23
9	SG-200N1/B400-NET-001.03	SG-200N1	B400-NET-001	CAT.6A 4x2xAWG23
10	SG-200D2/B400-NET-001	SG-200D2	B400-NET-001	CAT.6A 4x2xAWG23
11	B300-HSB-001/B400-NET-001	B300-HSB-001	B400-NET-001	CAT.6A 4x2xAWG23
12	UP-200F1/B400-NET-001.01	UP-200F1	B400-NET-001	CAT.6A 4x2xAWG23
13	UP-200F1/B400-NET-001.02	UP-200F1	B400-NET-001	CAT.6A 4x2xAWG23
14	UP-200F3/B400-NET-001.01	UP-200F3	B400-NET-001	CAT.6A 4x2xAWG23
15	UP-200F3/B400-NET-001.02	UP-200F3	B400-NET-001	CAT.6A 4x2xAWG23
16	UP-200F4/B400-NET-001.01	UP-200F4	B400-NET-001	CAT.6A 4x2xAWG23
17	UP-200F4/B400-NET-001.02	UP-200F4	B400-NET-001	CAT.6A 4x2xAWG23
18	P320PLC/B400-NET-001.01	P320PLC	B400-NET-001	CAT.6A 4x2xAWG23
19	20-UCP-001/B400-NET-001.01	20-UCP-001	B400-NET-001	CAT.6A 4x2xAWG23
20	20-UCP-001/B400-NET-001.02	20-UCP-001	B400-NET-001	CAT.6A 4x2xAWG23
21	63-LP-001/B400-NET-001	63-LP-001	B400-NET-001	CAT.6A 4x2xAWG23
22	64-LP-001/B400-NET-001	64-LP-001	B400-NET-001	CAT.6A 4x2xAWG23
23	CP-100E1/B400-NET-001.01	CP-100E1	B400-NET-001	FO12 OM2
24	CP-100E1/B400-NET-001.02	CP-100E1	B400-NET-001	FO12 OM2
25	HNA6/B400-NET-001	HNA6	B400-NET-001	FO12 OS2
26	P320PLC/B400-NET-001.02	P320PLC	B400-NET-001	CAT.6A 4x2xAWG23
27	C-GPSANT/B400-NET-001	GPSANT	B400-NET-001	STD-VENDOR

B-400-SEC-2D-L-150-101-IST-090

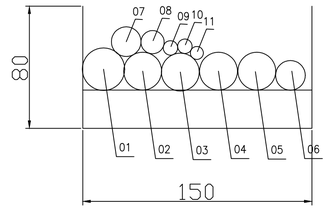

B-400-SEC-2D-L-150-101-IST-090				
POS	CABLE NAME	FROM	TO	FORMATION
1	00-JE-13001/B400-PCS-002	00-JE-13001	B400-PCS-002	24x2,5 mm2
2	00-JE-11001_1/B400-PCS-002	00-JE-11001_1	B400-PCS-002	12x2x0,75 mm2
3	00-JE-11001_2/B400-PCS-002	00-JE-11001_2	B400-PCS-002	12x2x0,75 mm2
4	00-JE-12001_1/B400-PCS-002	00-JE-12001_1	B400-PCS-002	12x2x0,75 mm2
5	00-JE-12001_2/B400-PCS-002	00-JE-12001_2	B400-PCS-002	12x2x0,75 mm2
6	00-JE-12002/B400-PCS-002	00-JE-12002	B400-PCS-002	6x2x0,75 mm2
7	00-JE-12003/B400-PCS-002	00-JE-12003	B400-PCS-002	6x2x0,75 mm2
8	C-B400-TIR-001/B400-PCS-002	B400-TIR-001	B400-PCS-002	2x2x0.75 mm2
9	C-B400-TDC-001/B400-PCS-002	B400-TDC-001	B400-PCS-002	1x2x0.75 mm2
10	C-B400-TDC-002/B400-PCS-002	B400-TDC-002	B400-PCS-002	1x2x0.75 mm2
11	HNA6/B400-NET-001	HNA6	B400-NET-001	FO12 OS2
12	C-GPSANT/B400-NET-001	GPSANT	B400-NET-001	STD-VENDOR

INSERT SUBCONTRACTOR / VENDOR LOGO HERE

REV.	DATE	DRN	CHKD	APPD	DESCRIPTION
02	29/09/25	SPS	LCA	CGI	AS-BUILT (ASB)
01	04/10/24	VBA	LCA	DLO	ACCEPTED FOR CONSTRUCTION (AFC)
00	23/08/24	VBA	LCA	DLO	ISSUE FOR REVIEW (IFR)

CROSSWIND

ROSETTI MARINO

TITLE :
BASE LOAD POWER HUB (BLPH)
Base Load Power HUB Cables Tray Layout
B-400 Container Lower Deck – TOS EL. 23.310m

CONTRACT NO./TITLE CW-I-WP4-2023-05/HOLLANDSE KUST NOORD WIND PARK | SCALE 1:50

DRAWN SPS | CHECKED LCA | APPROVED CGI | DATE 29/09/25

A1 | DRAWING NO. 123A90-DDL-IN-DL-40116 | SHEET 005 | REV. 02


File Name : 123A90-DDL-IN-DL-40116 REV02.dwg

DRAWING NO. 123A90-DDL-IN-DL-40116 REV. 02

B-400-SEC-2E-L-600-101-IST-070

INSTRUMENT

TELECOM

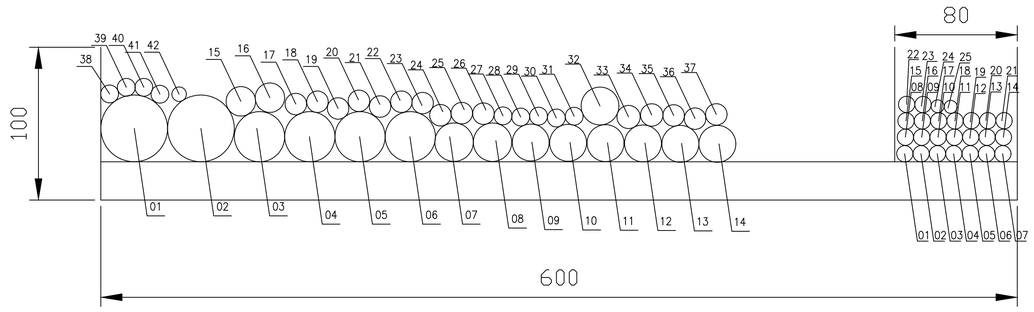


B-400-SEC-2E-L-600-101-IST-070				
POS	CABLE NAME	FROM	TO	FORMATION
1	950-JE-02101/B400-FGS-002	950-JE-021001	B400-FGS-002	12x3x2,5 mm2
2	950-JE-02102/B400-FGS-002	950-JE-021002	B400-FGS-002	12x3x2,5 mm2
3	950-JE-03102/B400-FGS-002	950-JE-031002	B400-FGS-002	6x3x2,5 mm2
4	00-JE-21001/B400-SIS-001	00-JE-21001	B400-SIS-001	12x2x0,75 mm2
5	00-JE-22001_1/B400-SIS-001	00-JE-22001_1	B400-SIS-001	12x2x0,75 mm2
6	00-JE-22001_2/B400-SIS-001	00-JE-22001_2	B400-SIS-001	12x2x0,75 mm2
7	950-JE-03103/B400-FGS-002	950-JE-031003	B400-FGS-002	6x2x0,75 mm2
8	950-JE-06102/B400-FGS-002	950-JE-061002	B400-FGS-002	6x2x0,75 mm2
9	00-JE-23001/B400-SIS-001	00-JE-23001	B400-SIS-001	12x2,5 mm2
10	950-JE-02104/B400-FGS-002	950-JE-021004	B400-FGS-002	12x2,5 mm2
11	950-JE-03104/B400-FGS-002	950-JE-031004	B400-FGS-002	12x2,5 mm2
12	950-JE-06103/B400-FGS-002	950-JE-061003	B400-FGS-002	12x2,5 mm2
13	950-JE-07101/B400-FGS-002	950-JE-071001	B400-FGS-002	12x2,5 mm2
14	950-JE-05104/B400-FGS-002	950-JE-051004	B400-FGS-002	12x2,5 mm2
15	80-UCP-001/B400-FGS-002	80-FGS-001	B400-FGS-002	2x2x0.75 mm2
16	50-LP-002/B400-FGS-002	50-LP-002	B400-FGS-002	2x2x0,75 mm2
17	C-80-XS-001/B400-SIS-001	80-XS-001	B400-SIS-001	2x2,5 mm2
18	C-50-XS-001/B400-SIS-001	50-XS-001	B400-SIS-001	2x2,5 mm2
19	C-77-HS-012B/B400-FGS-002	77-HS-012B	B400-FGS-002	2x2,5 mm2
20	C-77-HY-012/77-HS-012A	HFD-77012	77-HS-012A	2x2,5 mm2
21	C-77-HS-013B/B400-FGS-002	77-HS-013B	B400-FGS-002	2x2,5 mm2
22	C-77-HY-013/77-HS-013A	HFD-77013	77-HS-0013A	2x2,5 mm2
23	C-77-HS-014B/B400-FGS-002	77-HS-014B	B400-FGS-002	2x2,5 mm2
24	C-77-HS-015B/B400-FGS-002	77-HS-015B	B400-FGS-002	2x2,5 mm2
25	C-77-HS-016B/B400-FGS-002	77-HS-016B	B400-FGS-002	2x2,5 mm2
26	C-77-HY-016/77-HS-016A	HFD-77016	77-HS-016A	2x2,5 mm2
27	C-80-XA-003/B400-SIS-001	80-XA-003	B400-SIS-001	1x2x0,75 mm2
28	C-50-XA-003/B400-SIS-001	50-XA-003	B400-SIS-001	1x2x0,75 mm2
29	C-950-MFA-02101/B400-FGS-002	950-MFA-02101	B400-FGS-002	1x2x0,75 mm2
30	C-950-MFA-07101/B400-FGS-002	950-MFA-07101	B400-FGS-002	1x2x0,75 mm2
31	C-950-MFA-05201/B400-FGS-002	950-MFA-05201	B400-FGS-002	1x2x0,75 mm2
32	00-JE-11002/B400-PCS-002	00-JE-11002	B400-PCS-002	12x2x0.75 mm2
33	C-B400-TIR-001/B400-PCS-002	B400-TIR-001	B400-PCS-002	2x2x0.75 mm2
34	C-950-GDZ-04206/B400-FGS-002	950-GDZ-04206	B400-FGS-002	3x2.5 mm2
35	C-950-XZ-04201/B400-FGS-002	950-XZ-04201	B400-FGS-002	2x2.5 mm2
36	C-950-XL-04201/B400-FGS-002	950-XL-04201	B400-FGS-002	2x2.5 mm2
37	C-950-XL-04202/B400-FGS-002	950-XL-04202	B400-FGS-002	2x2.5 mm2
38	C-950-SDZ-04206/B400-FGS-002	950-SDZ-04206	B400-FGS-002	1x2x0.75 mm2
39	C-950-MFA-04201/B400-FGS-002	950-MFA-04201	B400-FGS-002	1x2x0.75 mm2
40	C-77-ZSL-014/B400-FGS-002	77-ZSL-014	B400-FGS-002	1x2x0.75 mm2
41	C-77-ZSL-015/B400-FGS-002	77-ZSL-015	B400-FGS-002	1x2x0.75 mm2
42	C-B400-TDC-002/B400-PCS-002	B400-TDC-002	B400-PCS-002	1x2x0.75 mm2

B-400-SEC-2E-L-600-101-IST-070				
POS	CABLE NAME	FROM	TO	FORMATION
1	TR-100AD1AVR/B400-NET-001	TR-100AD1AVR	B400-NET-001	CAT.6A 4x2xAWG23
2	B100-HSB-001/B400-NET-001	B100-HSB-001	B400-NET-001	CAT.6A 4x2xAWG23
3	B200-HSB-001/B400-NET-001	B200-HSB-001	B400-NET-001	CAT.6A 4x2xAWG23
4	SG-100D1/B400-NET-001.01	SG-100D1	B400-NET-001	CAT.6A 4x2xAWG23
5	SG-100D1/B400-NET-001.02	SG-100D1	B400-NET-001	CAT.6A 4x2xAWG23
6	SG-100D1/B400-NET-001.03	SG-100D1	B400-NET-001	CAT.6A 4x2xAWG23
7	SG-200N1/B400-NET-001.01	SG-200N1	B400-NET-001	CAT.6A 4x2xAWG23
8	SG-200N1/B400-NET-001.02	SG-200N1	B400-NET-001	CAT.6A 4x2xAWG23
9	SG-200N1/B400-NET-001.03	SG-200N1	B400-NET-001	CAT.6A 4x2xAWG23
10	SG-200D2/B400-NET-001	SG-200D2	B400-NET-001	CAT.6A 4x2xAWG23
11	B300-HSB-001/B400-NET-001	B300-HSB-001	B400-NET-001	CAT.6A 4x2xAWG23
12	UP-200F1/B400-NET-001.01	UP-200F1	B400-NET-001	CAT.6A 4x2xAWG23
13	UP-200F1/B400-NET-001.02	UP-200F1	B400-NET-001	CAT.6A 4x2xAWG23
14	UP-200F3/B400-NET-001.01	UP-200F3	B400-NET-001	CAT.6A 4x2xAWG23
15	UP-200F3/B400-NET-001.02	UP-200F3	B400-NET-001	CAT.6A 4x2xAWG23
16	UP-200F4/B400-NET-001.01	UP-200F4	B400-NET-001	CAT.6A 4x2xAWG23
17	UP-200F4/B400-NET-001.02	UP-200F4	B400-NET-001	CAT.6A 4x2xAWG23
18	P320PLC/B400-NET-001.01	P320PLC	B400-NET-001	CAT.6A 4x2xAWG23
19	20-UCP-001/B400-NET-001.01	20-UCP-001	B400-NET-001	CAT.6A 4x2xAWG23
20	20-UCP-001/B400-NET-001.02	20-UCP-001	B400-NET-001	CAT.6A 4x2xAWG23
21	63-LP-001/B400-NET-001	63-LP-001	B400-NET-001	CAT.6A 4x2xAWG23
22	64-LP-001/B400-NET-001	64-LP-001	B400-NET-001	CAT.6A 4x2xAWG23
23	P320PLC/B400-NET-001.02	P320PLC	B400-NET-001	CAT.6A 4x2xAWG23
24	CP-100E1/B400-NET-001.01	CP-100E1	B400-NET-001	FO12 OM2
25	CP-100E1/B400-NET-001.02	CP-100E1	B400-NET-001	FO12 OM2

B-400-SEC-2F-L-600-101-IST-089

INSTRUMENT

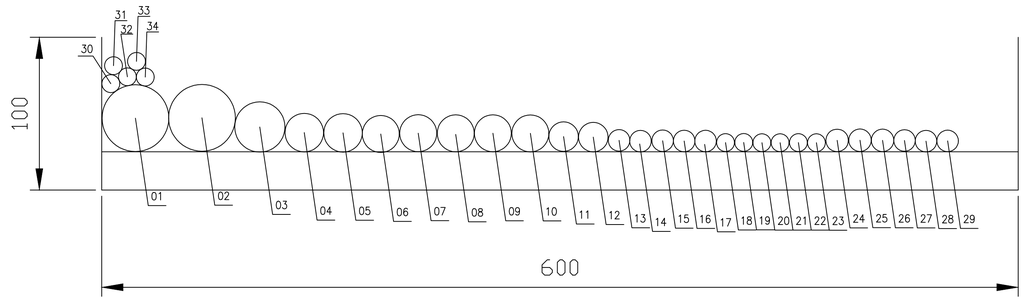

B-400-SEC-2F-L-600-101-IST-089				
POS	CABLE NAME	FROM	TO	FORMATION
1	950-JE-02101/B400-FGS-002	950-JE-021001	B400-FGS-002	12x3x2,5 mm2
2	950-JE-02102/B400-FGS-002	950-JE-021002	B400-FGS-002	12x3x2,5 mm2
3	950-JE-03102/B400-FGS-002	950-JE-031002	B400-FGS-002	6x3x2,5 mm2
4	950-JE-03103/B400-FGS-002	950-JE-031003	B400-FGS-002	6x2x0,75 mm2
5	950-JE-06102/B400-FGS-002	950-JE-061002	B400-FGS-002	6x2x0,75 mm2
6	950-JE-02104/B400-FGS-002	950-JE-021004	B400-FGS-002	12x2,5 mm2
7	950-JE-03104/B400-FGS-002	950-JE-031004	B400-FGS-002	12x2,5 mm2
8	950-JE-06103/B400-FGS-002	950-JE-061003	B400-FGS-002	12x2,5 mm2
9	950-JE-07101/B400-FGS-002	950-JE-071001	B400-FGS-002	12x2,5 mm2
10	950-JE-05104/B400-FGS-002	950-JE-051004	B400-FGS-002	12x2,5 mm2
11	80-UCP-001/B400-FGS-002	80-FGS-001	B400-FGS-002	2x2x0.75 mm2
12	50-LP-002/B400-FGS-002	50-LP-002	B400-FGS-002	2x2x0,75 mm2
13	C-77-HS-012B/B400-FGS-002	77-HS-012B	B400-FGS-002	2x2,5 mm2
14	C-77-HS-013B/B400-FGS-002	77-HS-013B	B400-FGS-002	2x2,5 mm2
15	C-77-HS-014B/B400-FGS-002	77-HS-014B	B400-FGS-002	2x2,5 mm2
16	C-77-HS-015B/B400-FGS-002	77-HS-015B	B400-FGS-002	2x2,5 mm2
17	C-77-HS-016B/B400-FGS-002	77-HS-016B	B400-FGS-002	2x2,5 mm2
18	C-950-MFA-02101/B400-FGS-002	950-MFA-02101	B400-FGS-002	1x2x0,75 mm2
19	C-950-MFA-07101/B400-FGS-002	950-MFA-07101	B400-FGS-002	1x2x0,75 mm2
20	C-950-MFA-05201/B400-FGS-002	950-MFA-05201	B400-FGS-002	1x2x0,75 mm2
21	C-950-SDZ-04204/B400-FGS-002	950-SDZ-04204	B400-FGS-002	1x2x0,75 mm2
22	C-950-SDZ-04205/B400-FGS-002	950-SDZ-04205	B400-FGS-002	1x2x0,75 mm2
23	C-950-SDZ-04206/B400-FGS-002	950-SDZ-04206	B400-FGS-002	1x2x0,75 mm2
24	C-950-GDZ-04204/B400-FGS-002	950-GDZ-04204	B400-FGS-002	3x2.5 mm2
25	C-950-GDZ-04205/B400-FGS-002	950-GDZ-04205	B400-FGS-002	3x2.5 mm2
26	C-950-GDZ-04206/B400-FGS-002	950-GDZ-04206	B400-FGS-002	3x2.5 mm2
27	C-950-XZ-04201/B400-FGS-002	950-XZ-04201	B400-FGS-002	2x2,5 mm2
28	C-950-XL-04201/B400-FGS-002	950-XL-04201	B400-FGS-002	2x2,5 mm2
29	C-950-XL-04202/B400-FGS-002	950-XL-04202	B400-FGS-002	2x2,5 mm2
30	C-950-MFA-04201/B400-FGS-002	950-MFA-04201	B400-FGS-002	1x2x0,75 mm2
31	C-77-ZSL-012/B400-FGS-002	77-ZSL-012	B400-FGS-002	1x2x0,75 mm2
32	C-77-ZSL-013/B400-FGS-002	77-ZSL-013	B400-FGS-002	1x2x0,75 mm2
33	C-77-ZSL-014/B400-FGS-002	77-ZSL-014	B400-FGS-002	1x2x0,75 mm2
34	C-77-ZSL-015/B400-FGS-002	77-ZSL-015	B400-FGS-002	1x2x0,75 mm2

INSERT SUBCONTRACTOR / VENDOR LOGO HERE

REV.	DATE	DRN	CHKD	APPD	DESCRIPTION
02	29/09/25	SPS	LCA	CGI	AS-BUILT (ASB)
01	04/10/24	VBA	LCA	DLO	ACCEPTED FOR CONSTRUCTION (AFC)
00	23/08/24	VBA	LCA	DLO	ISSUE FOR REVIEW (IFR)

CROSSWIND

ROSETTI MARINO

TITLE :

BASE LOAD POWER HUB (BLPH)
Base Load Power HUB Cables Tray Layou
B-400 Container Lower Deck – TOS EL. 23.310m


CONTRACT NO./TITLE CW-I-WP4-2023-05/HOLLANDSE KUST NOORD WIND PARK			SCALE 1:50
DRAWN SPS	CHECKED LCA	APPROVED CGI	DATE 29/09/25

A1	DRAWING NO. 123A90-DDL-IN-DL-40116	SHEET 006	REV. 02

File Name : 123A90-DDL-IN-DL-40116 REV.02.dwg

DRAWING NO. 123A90-DDL-IN-DL-40116 REV. 02


B-400-SEC-2G-L-600-101-IST-070

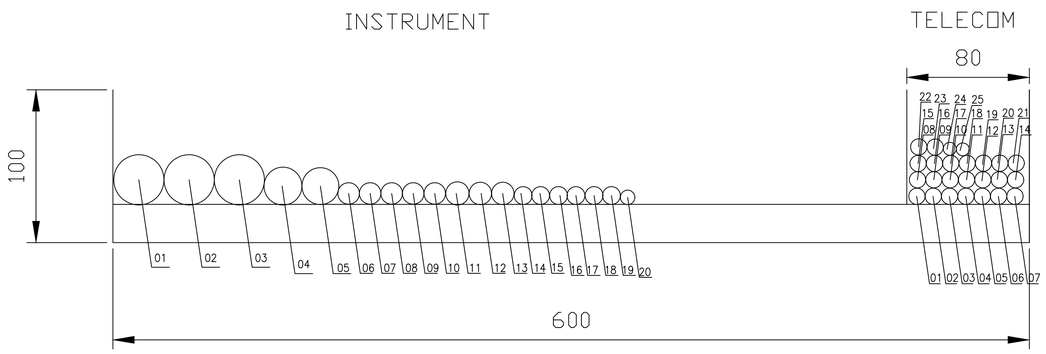

B-400-SEC-2G-L-600-101-IST-070				
POS	CABLE NAME	FROM	TO	FORMATION
1	00-JE-21001/B400-SIS-001	00-JE-21001	B400-SIS-001	12x2x0,75 mm2
2	00-JE-22001_1/B400-SIS-001	00-JE-22001_1	B400-SIS-001	12x2x0,75 mm2
3	00-JE-22001_2/B400-SIS-001	00-JE-22001_2	B400-SIS-001	12x2x0,75 mm2
4	00-JE-11002/B400-PCS-002	00-JE-11002	B400-PCS-002	12x2x0.75 mm2
5	00-JE-23001/B400-SIS-001	00-JE-23001	B400-SIS-001	12x2,5 mm2
6	C-80-XS-001/B400-SIS-001	80-XS-001	B400-SIS-001	2x2,5 mm2
7	C-50-XS-001/B400-SIS-001	50-XS-001	B400-SIS-001	2x2,5 mm2
8	C-77-HY-012/77-HS-012A	HFD-77012	77-HS-012A	2x2,5 mm2
9	C-77-HY-013/77-HS-013A	HFD-77013	77-HS-0013A	2x2,5 mm2
10	C-77-HY-016/77-HS-016A	HFD-77016	77-HS-016A	2x2,5 mm2
11	C-B400-TIR-001/B400-PCS-002	B400-TIR-001	B400-PCS-002	2x2x0.75 mm2
12	C-950-GDZ-04204/B400-FGS-002	950-GDZ-04204	B400-FGS-002	3x2.5 mm2
13	C-950-GDZ-04205/B400-FGS-002	950-GDZ-04205	B400-FGS-002	3x2.5 mm2
14	C-77-ZSL-012/B400-FGS-002	77-ZSL-012	B400-FGS-002	1x2x0.75 mm2
15	C-77-ZSL-013/B400-FGS-002	77-ZSL-013	B400-FGS-002	1x2x0.75 mm2
16	C-80-XA-003/B400-SIS-001	80-XA-003	B400-SIS-001	1x2x0,75 mm2
17	C-50-XA-003/B400-SIS-001	50-XA-003	B400-SIS-001	1x2x0,75 mm2
18	C-950-SDZ-04204/B400-FGS-002	950-SDZ-04204	B400-FGS-002	1x2x0.75 mm2
19	C-950-SDZ-04205/B400-FGS-002	950-SDZ-04205	B400-FGS-002	1x2x0.75 mm2
20	C-B400-TDC-002/B400-PCS-002	B400-TDC-002	B400-PCS-002	1x2x0.75 mm2

B-400-SEC-2G-L-600-101-IST-070				
POS	CABLE NAME	FROM	TO	FORMATION
1	TR-100AD1AVR/B400-NET-001	TR-100AD1AVR	B400-NET-001	CAT.6A 4x2xAWG23
2	B100-HSB-001/B400-NET-001	B100-HSB-001	B400-NET-001	CAT.6A 4x2xAWG23
3	B200-HSB-001/B400-NET-001	B200-HSB-001	B400-NET-001	CAT.6A 4x2xAWG23
4	SG-100D1/B400-NET-001.01	SG-100D1	B400-NET-001	CAT.6A 4x2xAWG23
5	SG-100D1/B400-NET-001.02	SG-100D1	B400-NET-001	CAT.6A 4x2xAWG23
6	SG-100D1/B400-NET-001.03	SG-100D1	B400-NET-001	CAT.6A 4x2xAWG23
7	SG-200N1/B400-NET-001.01	SG-200N1	B400-NET-001	CAT.6A 4x2xAWG23
8	SG-200N1/B400-NET-001.02	SG-200N1	B400-NET-001	CAT.6A 4x2xAWG23
9	SG-200N1/B400-NET-001.03	SG-200N1	B400-NET-001	CAT.6A 4x2xAWG23
10	SG-200D2/B400-NET-001	SG-200D2	B400-NET-001	CAT.6A 4x2xAWG23
11	B300-HSB-001/B400-NET-001	B300-HSB-001	B400-NET-001	CAT.6A 4x2xAWG23
12	UP-200F1/B400-NET-001.01	UP-200F1	B400-NET-001	CAT.6A 4x2xAWG23
13	UP-200F1/B400-NET-001.02	UP-200F1	B400-NET-001	CAT.6A 4x2xAWG23
14	UP-200F3/B400-NET-001.01	UP-200F3	B400-NET-001	CAT.6A 4x2xAWG23
15	UP-200F3/B400-NET-001.02	UP-200F3	B400-NET-001	CAT.6A 4x2xAWG23
16	UP-200F4/B400-NET-001.01	UP-200F4	B400-NET-001	CAT.6A 4x2xAWG23
17	UP-200F4/B400-NET-001.02	UP-200F4	B400-NET-001	CAT.6A 4x2xAWG23
18	P320PLC/B400-NET-001.01	P320PLC	B400-NET-001	CAT.6A 4x2xAWG23
19	20-UCP-001/B400-NET-001.01	20-UCP-001	B400-NET-001	CAT.6A 4x2xAWG23
20	20-UCP-001/B400-NET-001.02	20-UCP-001	B400-NET-001	CAT.6A 4x2xAWG23
21	63-LP-001/B400-NET-001	63-LP-001	B400-NET-001	CAT.6A 4x2xAWG23
22	64-LP-001/B400-NET-001	64-LP-001	B400-NET-001	CAT.6A 4x2xAWG23
23	P320PLC/B400-NET-001.02	P320PLC	B400-NET-001	CAT.6A 4x2xAWG23
24	CP-100E1/B400-NET-001.01	CP-100E1	B400-NET-001	FO12 OM2
25	CP-100E1/B400-NET-001.02	CP-100E1	B400-NET-001	FO12 OM2


B-400-SEC-2I-L-600-101-IST-070

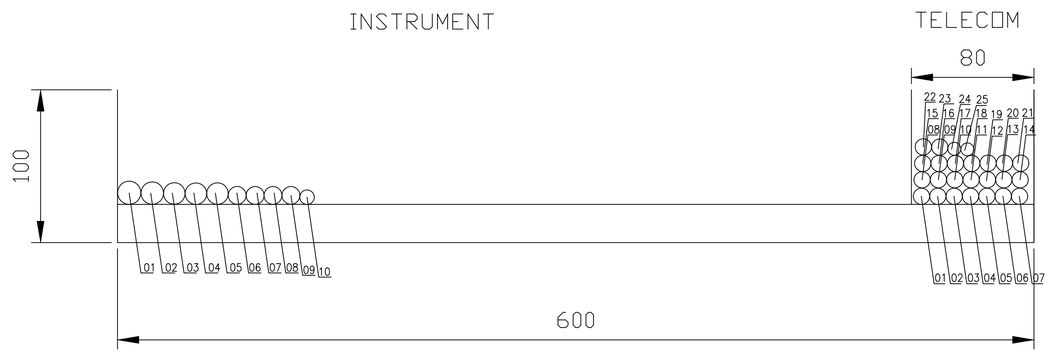

B-400-SEC-2I-L-600-101-IST-070				
POS	CABLE NAME	FROM	TO	FORMATION
1	C-B400-TIR-001/B400-PCS-002	B400-TIR-001	B400-PCS-002	2x2x0.75 mm2
2	C-950-GDZ-04204/B400-FGS-002	950-GDZ-04204	B400-FGS-002	3x2.5 mm2
3	C-77-HY-012/77-HS-012A	HFD-77012	77-HS-012A	2x2,5 mm2
4	C-77-HY-013/77-HS-013A	HFD-77013	77-HS-0013A	2x2,5 mm2
5	C-77-XS-004/B400-SIS-001	77-XS-004	B400-SIS-001	2x2,5 mm2
6	C-77-XA-004/B400-SIS-001	77-XA-004	B400-SIS-001	1x2x0.75 mm2
7	C-950-SDZ-04204/B400-FGS-002	950-SDZ-04204	B400-FGS-002	1x2x0.75 mm2
8	C-77-ZSL-012/B400-FGS-002	77-ZSL-012	B400-FGS-002	1x2x0.75 mm2
9	C-77-ZSL-013/B400-FGS-002	77-ZSL-013	B400-FGS-002	1x2x0.75 mm2
10	C-B400-TDC-002/B400-PCS-002	B400-TDC-002	B400-PCS-002	1x2x0.75 mm2

B-400-SEC-2I-L-600-101-IST-070				
POS	CABLE NAME	FROM	TO	FORMATION
1	TR-100AD1AVR/B400-NET-001	TR-100AD1AVR	B400-NET-001	CAT.6A 4x2xAWG23
2	B100-HSB-001/B400-NET-001	B100-HSB-001	B400-NET-001	CAT.6A 4x2xAWG23
3	B200-HSB-001/B400-NET-001	B200-HSB-001	B400-NET-001	CAT.6A 4x2xAWG23
4	SG-100D1/B400-NET-001.01	SG-100D1	B400-NET-001	CAT.6A 4x2xAWG23
5	SG-100D1/B400-NET-001.02	SG-100D1	B400-NET-001	CAT.6A 4x2xAWG23
6	SG-100D1/B400-NET-001.03	SG-100D1	B400-NET-001	CAT.6A 4x2xAWG23
7	SG-200N1/B400-NET-001.01	SG-200N1	B400-NET-001	CAT.6A 4x2xAWG23
8	SG-200N1/B400-NET-001.02	SG-200N1	B400-NET-001	CAT.6A 4x2xAWG23
9	SG-200N1/B400-NET-001.03	SG-200N1	B400-NET-001	CAT.6A 4x2xAWG23
10	SG-200D2/B400-NET-001	SG-200D2	B400-NET-001	CAT.6A 4x2xAWG23
11	B300-HSB-001/B400-NET-001	B300-HSB-001	B400-NET-001	CAT.6A 4x2xAWG23
12	UP-200F1/B400-NET-001.01	UP-200F1	B400-NET-001	CAT.6A 4x2xAWG23
13	UP-200F1/B400-NET-001.02	UP-200F1	B400-NET-001	CAT.6A 4x2xAWG23
14	UP-200F3/B400-NET-001.01	UP-200F3	B400-NET-001	CAT.6A 4x2xAWG23
15	UP-200F3/B400-NET-001.02	UP-200F3	B400-NET-001	CAT.6A 4x2xAWG23
16	UP-200F4/B400-NET-001.01	UP-200F4	B400-NET-001	CAT.6A 4x2xAWG23
17	UP-200F4/B400-NET-001.02	UP-200F4	B400-NET-001	CAT.6A 4x2xAWG23
18	P320PLC/B400-NET-001.01	P320PLC	B400-NET-001	CAT.6A 4x2xAWG23
19	20-UCP-001/B400-NET-001.01	20-UCP-001	B400-NET-001	CAT.6A 4x2xAWG23
20	20-UCP-001/B400-NET-001.02	20-UCP-001	B400-NET-001	CAT.6A 4x2xAWG23
21	63-LP-001/B400-NET-001	63-LP-001	B400-NET-001	CAT.6A 4x2xAWG23
22	64-LP-001/B400-NET-001	64-LP-001	B400-NET-001	CAT.6A 4x2xAWG23
23	P320PLC/B400-NET-001.02	P320PLC	B400-NET-001.02	CAT.6A 4x2xAWG23
24	CP-100E1/B400-NET-001.01	CP-100E1	B400-NET-001	FO12 OM2
25	CP-100E1/B400-NET-001.02	CP-100E1	B400-NET-001	FO12 OM2

B-400-SEC-2H-L-150-101-IST-071

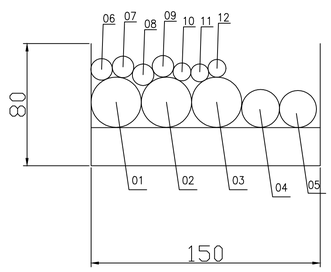

B-400-SEC-2H-L-150-101-IST-071				
POS	CABLE NAME	FROM	TO	FORMATION
1	00-JE-21001/B400-SIS-001	00-JE-21001	B400-SIS-001	12x2x0,75 mm2
2	00-JE-22001_1/B400-SIS-001	00-JE-22001_1	B400-SIS-001	12x2x0,75 mm2
3	00-JE-22001_2/B400-SIS-001	00-JE-22001_2	B400-SIS-001	12x2x0,75 mm2
4	00-JE-11002/B400-PCS-002	00-JE-11002	B400-PCS-002	12x2x0.75 mm2
5	00-JE-23001/B400-SIS-001	00-JE-23001	B400-SIS-001	12x2,5 mm2
6	C-77-XS-004/B400-SIS-001	77-XS-004	B400-SIS-001	2x2,5 mm2
7	C-80-XS-001/B400-SIS-001	80-XS-001	B400-SIS-001	2x2,5 mm2
8	C-50-XS-001/B400-SIS-001	50-XS-001	B400-SIS-001	2x2,5 mm2
9	C-77-HY-016/77-HS-016A	77-HY-016	77-HS-016A	2x2.5 mm2
10	C-80-XA-003/B400-SIS-001	80-XA-003	B400-SIS-001	1x2x0,75 mm2
11	C-50-XA-003/B400-SIS-001	50-XA-003	B400-SIS-001	1x2x0,75 mm2
12	C-77-XA-004/B400-SIS-001	77-XA-004	B400-SIS-001	1x2x0.75 mm2

INSERT SUBCONTRACTOR / VENDOR LOGO HERE

REV.	DATE	DRN	CHKD	APPD	DESCRIPTION
02	29/09/25	SPS	LCA	CGI	AS-BUILT (ASB)
01	04/10/24	VBA	LCA	DLO	ACCEPTED FOR CONSTRUCTION (AFC)
00	23/08/24	VBA	LCA	DLO	ISSUE FOR REVIEW (IFR)

CROSSWIND

ROSETTI MARINO

TITLE :
BASE LOAD POWER HUB (BLPH)
Base Load Power HUB Cables Tray Layou
B-400 Container Lower Deck – TOS EL. 23.310m

CONTRACT NO./TITLE CW-I-WP4-2023-05/HOLLANDSE KUST NOORD WIND PARK | SCALE 1:50

DRAWN SPS | CHECKED LCA | APPROVED CGI | DATE 29/09/25


A1 | DRAWING NO. 123A90-DDL-IN-DL-40116 | SHEET 007 | REV. 02

File Name : 123A90-DDL-IN-DL-40116 REV02.dwg

DRAWING NO. 123A90-DDL-IN-DL-40116


REV. 02

B-400-SEC-2J-L-150-101-IST-088

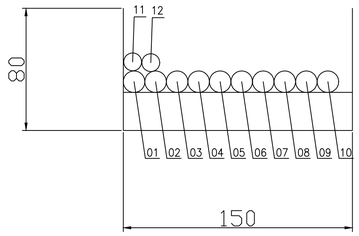


B-400-SEC-2J-L-150-101-IST-088				
POS	CABLE NAME	FROM	TO	FORMATION
1	C-77-HS-012A/77-HS-012B	77-HS-012A	77-HS-012B	2x2.5 mm2
2	C-77-HY-012/77-HS-012A	HFD-77012	77-HS-012A	2x2.5 mm2
3	C-77-HS-013A/77-HS-013B	77-HS-013A	77-HS-013B	2x2.5 mm2
4	C-77-HY-013/77-HS-013A	HFD-77013	77-HS-0013A	2x2.5 mm2
5	C-77-HS-014A/77-HS-014B	77-HS-014A	77-HS-014B	2x2.5 mm2
6	C-77-HY-014/77-HS-014A	HFD-77014	77-HS-014A	2x2.5 mm2
7	C-77-HS-015A/77-HS-015B	77-HS-015A	77-HS-015B	2x2.5 mm2
8	C-77-HY-015/77-HS-015A	HFD-77015	77-HS-015A	2x2.5 mm2
9	C-77-HS-016A/77-HS-016B	77-HS-016A	77-HS-016B	2x2.5 mm2
10	C-77-HY-016/77-HS-016A	HFD-77016	77-HS-016A	2x2.5 mm2
11	C-77-ZSL-014/B400-FGS-002	77-ZSL-014	B400-FGS-002	1x2x0.75 mm2
12	C-77-ZSL-015/B400-FGS-002	77-ZSL-015	B400-FGS-002	1x2x0.75 mm2

B-400-SEC-3A-L-200-101-IST-087

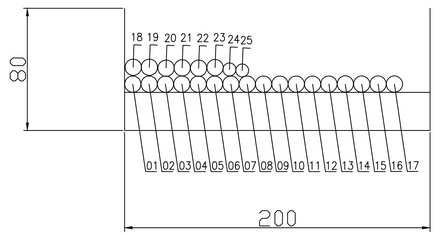

B-400-SEC-3A-L-200-101-IST-087				
POS	CABLE NAME	FROM	TO	FORMATION
1	TR-100AD1AVR/B400-NET-001	TR-100AD1AVR	B400-NET-001	CAT.6A 4x2xAWG23
2	B100-HSB-001/B400-NET-001	B100-HSB-001	B400-NET-001	CAT.6A 4x2xAWG23
3	B200-HSB-001/B400-NET-001	B200-HSB-001	B400-NET-001	CAT.6A 4x2xAWG23
4	SG-100D1/B400-NET-001.01	SG-100D1	B400-NET-001	CAT.6A 4x2xAWG23
5	SG-100D1/B400-NET-001.02	SG-100D1	B400-NET-001	CAT.6A 4x2xAWG23
6	SG-100D1/B400-NET-001.03	SG-100D1	B400-NET-001	CAT.6A 4x2xAWG23
7	SG-200N1/B400-NET-001.01	SG-200N1	B400-NET-001	CAT.6A 4x2xAWG23
8	SG-200N1/B400-NET-001.02	SG-200N1	B400-NET-001	CAT.6A 4x2xAWG23
9	SG-200N1/B400-NET-001.03	SG-200N1	B400-NET-001	CAT.6A 4x2xAWG23
10	SG-200D2/B400-NET-001	SG-200D2	B400-NET-001	CAT.6A 4x2xAWG23
11	B300-HSB-001/B400-NET-001	B300-HSB-001	B400-NET-001	CAT.6A 4x2xAWG23
12	UP-200F1/B400-NET-001.01	UP-200F1	B400-NET-001	CAT.6A 4x2xAWG23
13	UP-200F1/B400-NET-001.02	UP-200F1	B400-NET-001	CAT.6A 4x2xAWG23
14	UP-200F3/B400-NET-001.01	UP-200F3	B400-NET-001	CAT.6A 4x2xAWG23
15	UP-200F3/B400-NET-001.02	UP-200F3	B400-NET-001	CAT.6A 4x2xAWG23
16	UP-200F4/B400-NET-001.01	UP-200F4	B400-NET-001	CAT.6A 4x2xAWG23
17	UP-200F4/B400-NET-001.02	UP-200F4	B400-NET-001	CAT.6A 4x2xAWG23
18	P320PLC/B400-NET-001.01	P320PLC	B400-NET-001	CAT.6A 4x2xAWG23
19	P320PLC/B400-NET-001.02	P320PLC	B400-NET-001	CAT.6A 4x2xAWG23
20	20-UCP-001/B400-NET-001.01	20-UCP-001	B400-NET-001	CAT.6A 4x2xAWG23
21	20-UCP-001/B400-NET-001.02	20-UCP-001	B400-NET-001	CAT.6A 4x2xAWG23
22	63-LP-001/B400-NET-001	63-LP-001	B400-NET-001	CAT.6A 4x2xAWG23
23	64-LP-001/B400-NET-001	64-LP-001	B400-NET-001	CAT.6A 4x2xAWG23
24	CP-100E1/B400-NET-001.01	CP-100E1	B400-NET-001	FO12 OM2
25	CP-100E1/B400-NET-001.02	CP-100E1	B400-NET-001	FO12 OM2

B-400-SEC-3B-L-200-101-IST-091

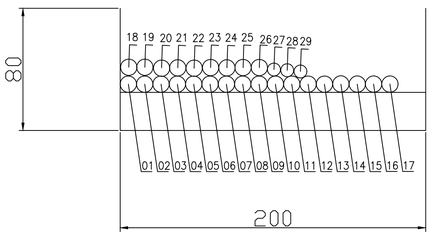

B-400-SEC-3B-L-200-101-IST-091				
POS	CABLE NAME	FROM	TO	FORMATION
1	TR-100AD1AVR/B400-NET-001	TR-100AD1AVR	B400-NET-001	CAT.6A 4x2xAWG23
2	B100-HSB-001/B400-NET-001	B100-HSB-001	B400-NET-001	CAT.6A 4x2xAWG23
3	B200-HSB-001/B400-NET-001	B200-HSB-001	B400-NET-001	CAT.6A 4x2xAWG23
4	SG-100D1/B400-NET-001.01	SG-100D1	B400-NET-001	CAT.6A 4x2xAWG23
5	SG-100D1/B400-NET-001.02	SG-100D1	B400-NET-001	CAT.6A 4x2xAWG23
6	SG-100D1/B400-NET-001.03	SG-100D1	B400-NET-001	CAT.6A 4x2xAWG23
7	SG-200N1/B400-NET-001.01	SG-200N1	B400-NET-001	CAT.6A 4x2xAWG23
8	SG-200N1/B400-NET-001.02	SG-200N1	B400-NET-001	CAT.6A 4x2xAWG23
9	SG-200N1/B400-NET-001.03	SG-200N1	B400-NET-001	CAT.6A 4x2xAWG23
10	SG-200D2/B400-NET-001	SG-200D2	B400-NET-001	CAT.6A 4x2xAWG23
11	B300-HSB-001/B400-NET-001	B300-HSB-001	B400-NET-001	CAT.6A 4x2xAWG23
12	UP-200F1/B400-NET-001.01	UP-200F1	B400-NET-001	CAT.6A 4x2xAWG23
13	UP-200F1/B400-NET-001.02	UP-200F1	B400-NET-001	CAT.6A 4x2xAWG23
14	UP-200F3/B400-NET-001.01	UP-200F3	B400-NET-001	CAT.6A 4x2xAWG23
15	UP-200F3/B400-NET-001.02	UP-200F3	B400-NET-001	CAT.6A 4x2xAWG23
16	UP-200F4/B400-NET-001.01	UP-200F4	B400-NET-001	CAT.6A 4x2xAWG23
17	UP-200F4/B400-NET-001.02	UP-200F4	B400-NET-001	CAT.6A 4x2xAWG23
18	P320PLC/B400-NET-001.01	P320PLC	B400-NET-001	CAT.6A 4x2xAWG23
19	20-UCP-001/B400-NET-001.01	20-UCP-001	B400-NET-001	CAT.6A 4x2xAWG23
20	20-UCP-001/B400-NET-001.02	20-UCP-001	B400-NET-001	CAT.6A 4x2xAWG23
21	63-LP-001/B400-NET-001	63-LP-001	B400-NET-001	CAT.6A 4x2xAWG23
22	64-LP-001/B400-NET-001	64-LP-001	B400-NET-001	CAT.6A 4x2xAWG23
23	80-UCP-001/B400-NET-001.01	80-UCP-001	B400-NET-001.01	CAT.6A 4x2xAWG23
24	80-UCP-001/B400-NET-001.02	80-UCP-001	B400-NET-001.02	CAT.6A 4x2xAWG23
25	50-LP-001/B400-NET-001	50-LP-001	B400-NET-001	CAT.6A 4x2xAWG23
26	P320PLC/B400-NET-001.02	P320PLC	B400-NET-001	CAT.6A 4x2xAWG23
27	CP-100E1/B400-NET-001.01	CP-100E1	B400-NET-001	FO12 OM2
28	CP-100E1/B400-NET-001.02	CP-100E1	B400-NET-001	FO12 OM2
29	HNA6/B400-NET-001	HNA6	B400-NET-001	FO12 OS2
30	C-GPSANT/B400-NET-001	GPSANT	B400-NET-001	STD-VENDOR

INSERT SUBCONTRACTOR / VENDOR LOGO HERE

REV.	DATE	DRN	CHKD	APPD	DESCRIPTION
02	29/09/25	SPS	LCA	CGI	AS-BUILT (ASB)
01	04/10/24	VBA	LCA	DLO	ACCEPTED FOR CONSTRUCTION (AFC)
00	23/08/24	VBA	LCA	DLO	ISSUE FOR REVIEW (IFR)

CROSSWIND

ROSETTI MARINO

TITLE :
BASE LOAD POWER HUB (BLPH)
Base Load Power HUB Cables Tray Layout
B-400 Container Lower Deck – TOS EL. 23.310m

CONTRACT NO./TITLE CW-I-WP4-2023-05/HOLLANDSE KUST NOORD WIND PARK | SCALE 1:50

DRAWN SPS | CHECKED LCA | APPROVED CGI | DATE 29/09/25


A1 | DRAWING NO. 123A90-DDL-IN-DL-40116 | SHEET 008 | REV. 02

File Name : 123A90-DDL-IN-DL-40116 REV:02.dwg

DRAWING NO. 123A90-DDL-IN-DL-40116

REV. 02

B-400-SEC-1A-L-450-101-IST-092

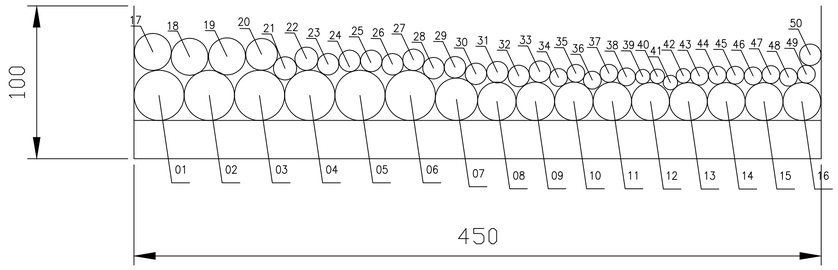

B-400-SEC-1A-L-450-101-IST-093				
POS	CABLE NAME	FROM	TO	FORMATION
1	950-JE-04201/B400-FGS-002	950-JE-04201	B400-FGS-002	6x3x2,5 mm2
2	950-JE-04205/B400-FGS-002	950-JE-04205	B400-FGS-002	6x3x2,5 mm2
3	950-JE-02103/B400-FGS-002	950-JE-02103	B400-FGS-002	6x3x2,5 mm2
4	00-JE-21002/B400-SIS-001	00-JE-21002	B400-SIS-001	12x2x0,75 mm2
5	00-JE-22002_1/B400-SIS-001	00-JE-22002_1	B400-SIS-001	12x2x0,75 mm2
6	00-JE-22002_2/B400-SIS-001	00-JE-22002_2	B400-SIS-001	12x2x0,75 mm2
7	00-JE-13002/B400-PCS-002	00-JE-13002	B400-PCS-002	24x2,5 mm2
8	950-JE-04102/B400-FGS-002	950-JE-04102	B400-FGS-002	6x2x0,75 mm2
9	950-JE-05102/B400-FGS-002	950-JE-05102	B400-FGS-002	6x2x0,75 mm2
10	B200-HSB-001/B400-FGS-002	950-JE-04202	B400-FGS-002	6x2x0,75 mm2
11	B300-HSB-001/B400-FGS-002	950-JE-04206	B400-FGS-002	6x2x0,75 mm2
12	00-JE-11003_1/B400-PCS-002	00-JE-11003_1	B400-PCS-002	12x2x0,75 mm2
13	00-JE-11003_2/B400-PCS-002	00-JE-11003_2	B400-PCS-002	12x2x0,75 mm2
14	00-JE-12004_1/B400-PCS-002	00-JE-12004_1	B400-PCS-002	12x2x0,75 mm2
15	00-JE-12004_2/B400-PCS-002	00-JE-12004_2	B400-PCS-002	12x2x0,75 mm2
16	00-JE-12005/B400-PCS-002	00-JE-12005	B400-PCS-002	12x2x0,75 mm2
17	00-JE-23002/B400-SIS-001	00-JE-23002	B400-SIS-001	12x2,5 mm2
18	UP-200F3/B400-SIS-001	UP-200F3	B400-SIS-001	12x2,5 mm2
19	950-JE-04207/B400-FGS-002	950-JE-04207	B400-FGS-002	12x2,5 mm2
20	00-JE-13003/B400-PCS-002	00-JE-13003	B400-PCS-002	12x2,5 mm2
21	C-B200-TIR-001/B400-PCS-002	B200-TIR-001	B400-PCS-002	2x2x0,75 mm2
22	C-B300-TIR-001/B400-PCS-002	B300-TIR-001	B400-PCS-002	2x2x0,75 mm2
23	C-77-XS-002/B400-SIS-001	77-XS-002	B400-SIS-001	2x2,5 mm2
24	C-77-XS-003/B400-SIS-001	77-XS-003	B400-SIS-001	2x2,5 mm2
25	C-SG-200N1-001/B400-SIS-001	SG-200N1-001	B400-SIS-001	2x2,5 mm2
26	C-SG-200N1-002/B400-SIS-001	SG-200N1-002	B400-SIS-001	2x2,5 mm2
27	C-CB-200F3A/B400-SIS-001	CB-200F3A	B400-SIS-001	2x2,5 mm2
28	C-CB-200F3B/B400-SIS-001	CB-200F3B	B400-SIS-001	2x2,5 mm2
29	C-CB-200F4A/B400-SIS-001	CB-200F4A	B400-SIS-001	2x2,5 mm2
30	C-CB-200F4B/B400-SIS-001	CB-200F4B	B400-SIS-001	2x2,5 mm2
31	C-UP-200F4/B400-SIS-001	UP-200F4	B400-SIS-001	2x2,5 mm2
32	C-NC-200F2/B400-FGS-002.01	N200F2	B400-FGS-002.01	1x2x0.75 mm2
33	C-NC-200F2/B400-FGS-002.02	N200F2	B400-FGS-002.02	2x2.5 mm2
34	C-NC-200F2/B400-SIS-001	N200F2	B400-SIS-001	2x2.5 mm2
35	C-77-XA-002/B400-SIS-001	77-XA-002	B400-SIS-001	1x2x0,75 mm2
36	C-77-XA-003/B400-SIS-001	77-XA-003	B400-SIS-001	1x2x0,75 mm2
37	C-950-MFA-04203/B400-FGS-002	950-MFA-04203	B400-FGS-002	1x2x0,75 mm2
38	C-950-MFA-04202/B400-FGS-002	950-MFA-04202	B400-FGS-002	1x2x0,75 mm2
39	C-B200-TDC-001/B400-PCS-002	B200-TD001	B400-PCS-002	1x2x0,75 mm2
40	C-B200-TDC-002/B400-PCS-002	B200-TD002	B400-PCS-002	1x2x0,75 mm2
41	C-B300-TDC-001/B400-PCS-002	B300-TD001	B400-PCS-002	1x2x0,75 mm2
42	C-B300-TDC-002/B400-PCS-002	B300-TD002	B400-PCS-002	1x2x0,75 mm2
43	C-950-SDZ-04201/B400-FGS-002	950-SDZ-04201	B400-FGS-002	1x2x0.75 mm2
44	C-950-SDZ-04202/B400-FGS-002	950-SDZ-04202	B400-FGS-002	1x2x0.75 mm2
45	C-950-SDZ-04203/B400-FGS-002	950-SDZ-04203	B400-FGS-002	1x2x0.75 mm2
46	C-950-GDZ-04201/B400-FGS-002	950-GDZ-04201	B400-FGS-002	1x2x0.75 mm2
47	C-950-GDZ-04202/B400-FGS-002	950-GDZ-04202	B400-FGS-002	1x2x0.75 mm2
48	C-950-GDZ-04203/B400-FGS-002	950-GDZ-04203	B400-FGS-002	1x2x0.75 mm2
49	C-77-ZSL-016/B400-FGS-002	77-ZSL-016	B400-FGS-002	1x2x0.75 mm2
50	C-77-HY-016/77-HS-016A	77-HY-016	77-HS-016A	2x2.5 mm2

INSERT SUBCONTRACTOR / VENDOR LOGO HERE

REV.	DATE	DRN	CHKD	APPD	DESCRIPTION
02	29/09/25	SPS	LCA	CGI	AS-BUILT (ASB)
01	04/10/24	VBA	LCA	DLO	ACCEPTED FOR CONSTRUCTION (AFC)
00	23/08/24	VBA	LCA	DLO	ISSUE FOR REVIEW (IFR)

CROSSWIND

ROSETTI MARINO

TITLE :
BASE LOAD POWER HUB (BLPH)
Base Load Power HUB Cables Tray Layout
B-400 Container Lower Deck – TOS EL. 23.310m

CONTRACT NO./TITLE CW-I-WP4-2023-05/HOLLANDSE KUST NOORD WIND PARK | SCALE 1:50

DRAWN SPS | CHECKED LCA | APPROVED CGI | DATE 29/09/25

A1 | DRAWING NO. 123A90-DDL-IN-DL-40116 | SHEET 009 | REV. 02

File Name : 123A90-DDL-IN-DL-40116 REV02.dwg