
DRAWING NO. 123A90-DDL-PP-DD-70057

REV. 02

DETAIL "E"
I-MCT-T01
SK-2X1 PRIMED
EL.+21.680
NOTE 2, 3

DETAIL "G"
E-MCT-T03
SK-6X1 PRIMED
EL.+21.680
NOTE 2, 3


DETAIL "L"
E-MCT-T02
SK-6X3 PRIMED
EL.+21.680
NOTE 2, 3

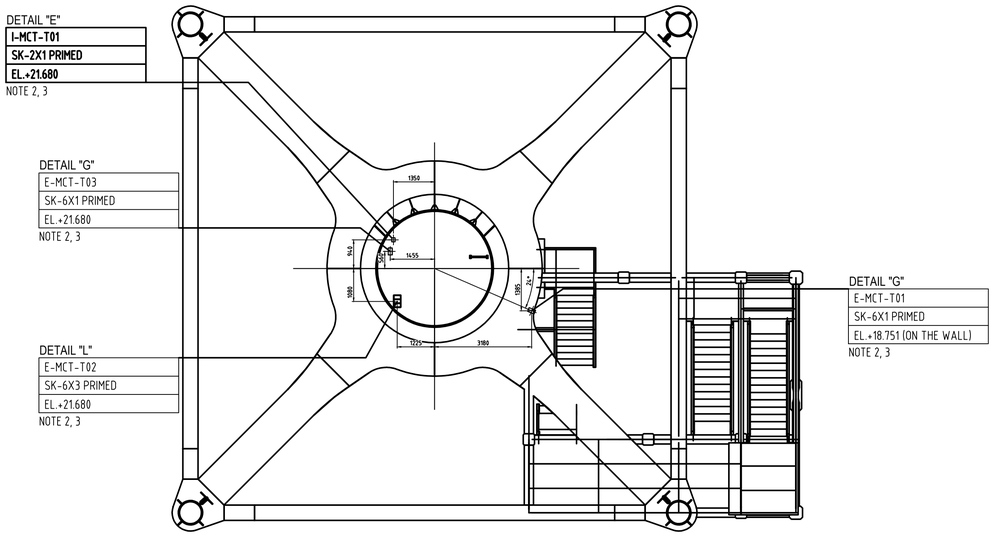

DETAIL "G"
E-MCT-T01
SK-6X1 PRIMED
EL.+18.751 (ON THE WALL)
NOTE 2, 3

MONO PILE (TRANSITION PIECE)

VIEW EL. +17180mm to +23340mm

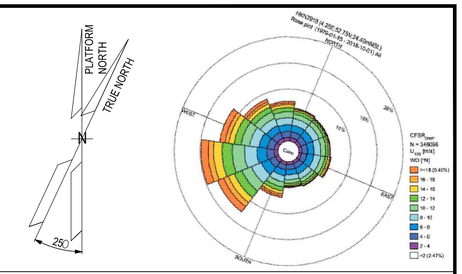

NOTES

1. ALL DIMENSIONS AND ELEVATIONS ARE IN MILLIMETERS.
2. DIMENSIONS SHOWN REFER TO THE MAXIMUM DIMENSIONS OF THE MCT FRAME AND NOT TO THE ACTUAL. CUT-OUT THAT SHOULD BE INCREASED by 1,5 mm. Max. ON EACH SIDE.
3. ALL MTC's SHALL BE INSTALLED ACCORDING TO ROXTEC (VENDOR) PROCEDURE.

LEGEND

LEGEND:

FLAT PLATE - 8 THK

HOLDS

REFERENCE DOCUMENTS

123A90-DDL-PP-DD-70055	PIPING FLOOR PENETRATION LOWER & UPPER DECK EL. +23.310m & EL.+30.310m
123A90-DDL-PP-DD-70056	PIPING FLOOR PENETRATION EL. +31.410m TO EL.+36.210m - Typical & detail

REV.	DATE	DRN	CHKD	APPD	DESCRIPTION
02	22/09/25	SPS	CBO	CGI	AS-BUILT (ASB)
01	31/10/24	MMA	CBO	DLO	ACCEPTED FOR CONSTRUCTION (AFC)
00	02/07/24	MMA	CBO	DLO	ACCEPTED FOR CONSTRUCTION (AFC)

CROSSWIND

ROSETTI MARINO

TITLE :
BASE LOAD POWER HUB (BLPH)
TRANSITION PIECE PENETRATIONS
VIEW EL. +17180mm to +23340mm

CONTRACT NO./TITLE	CW-I-WP4-2023-05/HOLLANDSE KUST NOORD WIND PARK		SCALE 1:100
DRAWN SPS	CHECKED C. BORTOLIN	APPROVED CGI	DATE 22/07/25
A1	DRAWING NO. 123A90-DDL-PP-DD-70057	SHEET 001	REV. 02

File Name: 123A90-DDL-PP-DD-70057_02