

DRAWING NO. 123A90-DDL-PP-DL-70071

REV. 03

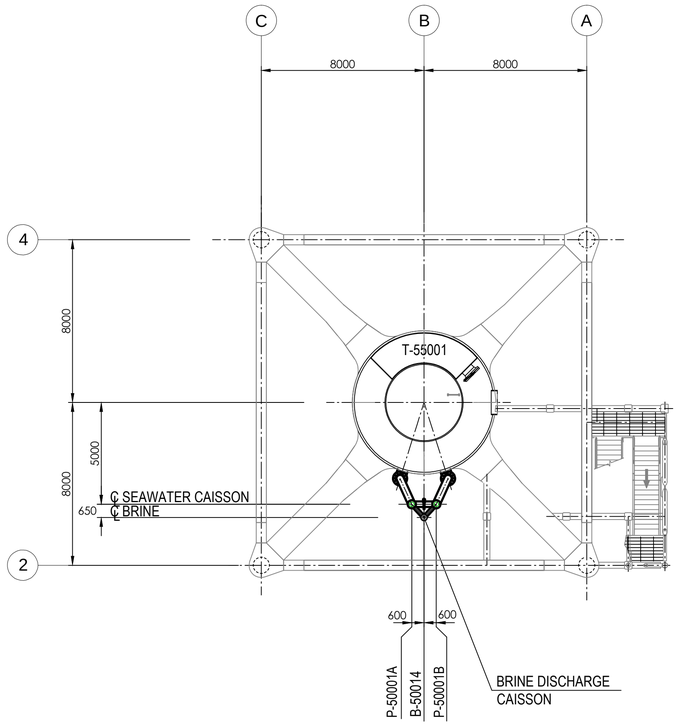


PLAN ON TRANSITION PIECE
EL+21.710 T.O.S.

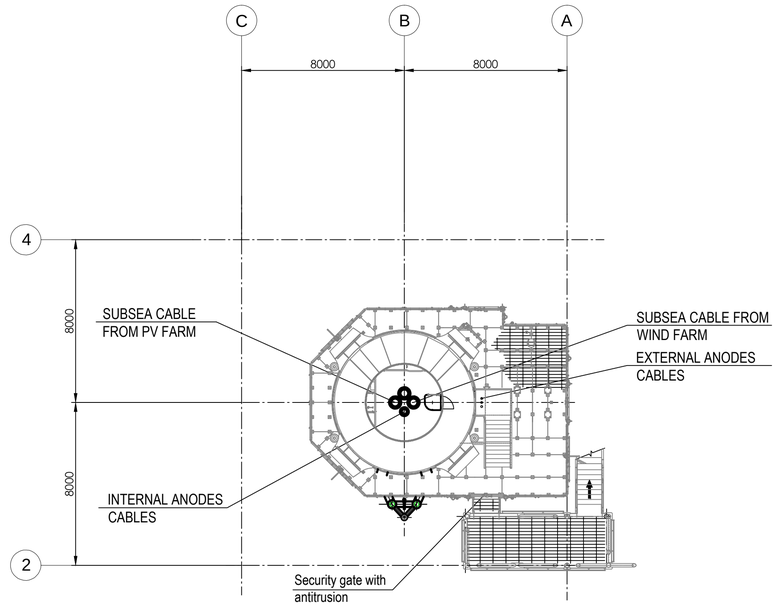

PLAN ON EXISTING
PLATFORM AT
EL+16.860 T.O.S.

EQUIPMENT LIST	
TAG NUMBER	DESCRIPTION
P-50001A/B	SEAWATER LIFT PUMPS
T-55001	WASTE WATER TANK
B-50014	BRINE CAISSON

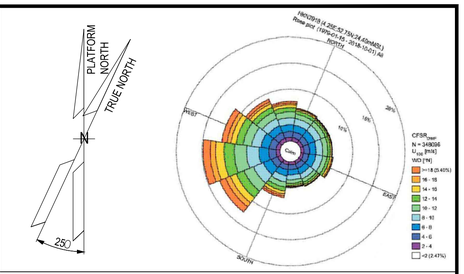

NOTES

1. ALL DIMENSIONS IN mm U.N.O
2. ALL ELEVATIONS IN METERS.
3. EQUIPMENT SIZES ARE BASED ON MASTER EQUIPMENT LIST 123A90-DDL-MAC-LIS-50000 AND VENDOR DWG. RECEIVED.
4. ALL ELEVATIONS RELATE TO LOWEST ASTRONOMICAL TIDE (LAT) = 0.000.
5. PLAN SHOWS PRIMARY ESCAPE/MATERIAL HANDLING ROUTES ONLY.
6. DELETED
7. MISCELLANEOUS SAFETY EQUIPMENT ARE SHOWN IN DOC. 123A90-DDL-SAF-DL-3002516_Escape Routes, Fire Fighting, Life Saving Equipment and Safety Equipment Layouts Drawings.
8. PREVAILING WIND DIRECTION INFLUENCING EQUIPMENT/VENT LAYOUT FROM THE SOUTH WEST.
9. PLATFORM NORTH DIRECTION IS N 25°W.

LEGEND

DENOTES PLATED DECK

ESCAPE/MATERIAL HANDLING ROUTE

DENOTES OPEN GRATING

HOLDS

1. DELETED
2. DELETED
3. DELETED
4. DELETED
5. DELETED
6. DELETED
7. DELETED
8. DELETED
9. DELETED

REFERENCE DOCUMENTS

123A90-DDL-PP-DS-70070	PLOT PLAN - LOWER & UPPER DECK
123A90-DDL-PP-DS-70072	PLOT PLAN - ELEVATION LOOKING NORTH & EAST

REV.	DATE	DRN	CHKD	APPD	DESCRIPTION
03	22/09/25	SPS	CBO	CGI	AS-BUILT (ASB)
02	24/05/24	MMA	CBO	DLO	ACCEPTED FOR CONSTRUCTION (AFC)
01	07/02/24	MMA	CBO	DLO	ISSUE FOR REVIEW (IFR)
00	31/10/23	MMA	CBO	DLO	ISSUE FOR REVIEW (IFR)

CROSSWIND

ROSETTI MARINO

TITLE :
BASE LOAD POWER HUB (BLPH)
PLOT PLAN
BELOW LOWER DECK

CONTRACT NO./TITLE CW-I-WP4-2023-05/HOLLANDSE KUST NOORD WIND PARK			SCALE 1:150
DRAWN SPS	CHECKED C. BORTOLIN	APPROVED CGI	DATE 22/09/25
A1	DRAWING NO. 123A90-DDL-PP-DL-70071	SHEET 001	REV. 03

File Name : 123A90-DDL-PP-DL-70071 Rev.03