

DRAWING NO. 123A90-DDL-PP-DL-70072

REV. 03

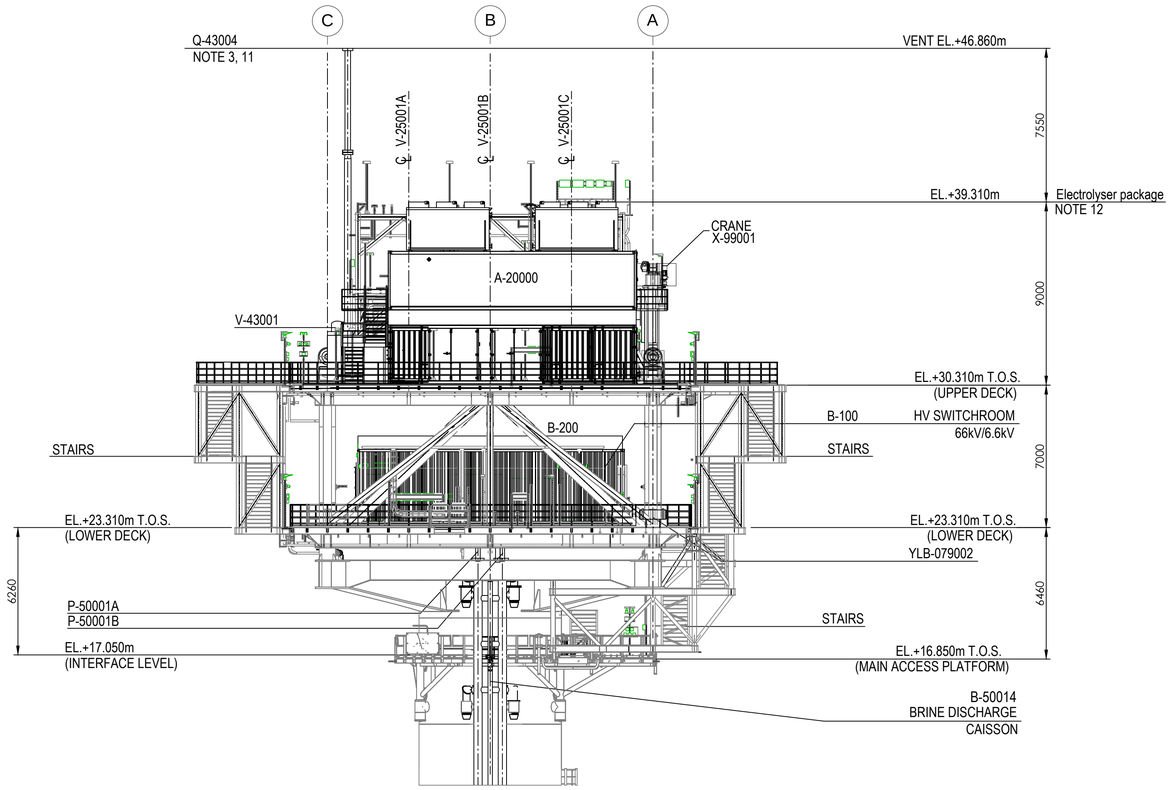


ELEVATION LOOKING NORTH

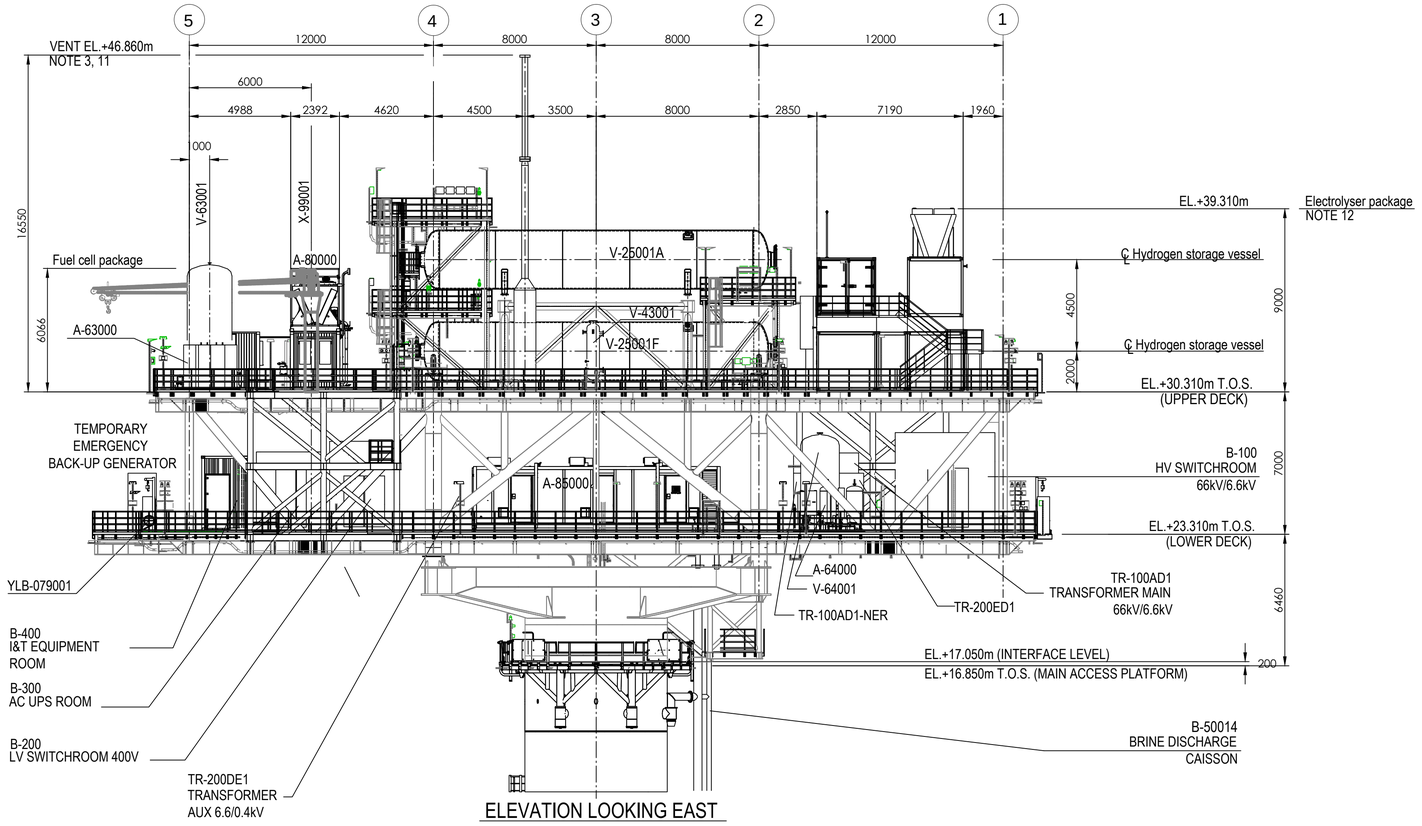

ELEVATION LOOKING EAST

EQUIPMENT LIST

TAG NUMBER	DESCRIPTION	
A-20000	ELECTROLYSER	NOTE 12
A-63000	INSTRUMENT AIR PACKAGE	
A-80000	FUEL CELL	
A-85000	BESS	
P-50001A/B	SEAWATER LIFT PUMPS	
Q-43004	HYDROGEN VENT	NOTE 11
V-25001A-F	HYDROGEN STORAGE VESSELS	
V-43001	HYDROGEN VENT KO DRUM	
YLB-079001/2	LIFE RAFTS	
B-100	HV SWITCHROOM 66kV/6.6kV	
B-200	LV SWITCHROOM 400V	
B-300	AC UPS EQUIPMENT ROOM	
B-400	I&T EQUIPMENT ROOM	
TR-100AD1	TRANSFORMER MAIN 66kV/6.6kV	
TR-100AD1-NER	NEUTRAL EARTHING RESISTOR	
TR-200DE1	TRANSFORMER AUX. 6.6kV/0.4kV	
TR-200ED1	SOLAR TRANSFORMER PV FARM EQUIPMENT	
X-99001	CRANE	
V-63001	AIR RECEIVER	
V-64001	NITROGEN RECEIVER	

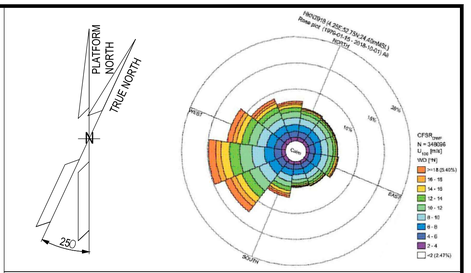

NOTES

1. ALL DIMENSIONS IN mm U.N.O
2. ALL ELEVATIONS IN METERS.
3. H2 VENT ELEVATIONS, AS PER DOC. 123A90-DDL-SAF-RE-30021_Vent Gas Dispersion / and Potential Radiation Study
4. ALL ELEVATIONS RELATE TO LOWEST ASTRONOMICAL TIDE (LAT) = 0.000.
5. DELETED
6. DELETED
7. MISCELLANEOUS SAFETY EQUIPMENT ARE SHOWN IN DOC. 123A90-DDL-SAF-DL-3002516_Escape Routes, Fire Fighting, Life Saving Equipment and Safety Equipment Layouts Drawings.
8. PREVAILING WIND DIRECTION INFLUENCING EQUIPMENT/VENT LAYOUT FROM THE SOUTH WEST.
9. PLATFORM NORTH DIRECTION IS N 25°W.
10. DELETED
11. LIQUID SEAL IS PART OF THE HYDROGEN VENT.
12. FOR ELECTROLYSER PACKAGE DETAILS SEE VENDOR DWG. C63-GAD-001

LEGEND

DENOTES PLATED DECK

ESCAPE/MATERIAL HANDLING ROUTE

DENOTES OPEN GRATING

HOLDS

1. DELETED
2. DELETED
3. DELETED
4. DELETED
5. DELETED
6. DELETED
7. DELETED
8. DELETED
9. DELETED

REFERENCE DOCUMENTS

123A90-DDL-PP-DS-70070	PLOT PLAN - LOWER & UPPER DECK
123A90-DDL-PP-DS-70071	PLOT PLAN - BELOW LOWER DECK

REV.	DATE	DRN	CHKD	APPD	DESCRIPTION
03	22/09/25	SPS	CBO	CGI	AS-BUILT (ASB)
02	24/05/24	MMA	CBO	DLO	ACCEPTED FOR CONSTRUCTION (AFC)
01	07/02/24	MMA	CBO	DLO	ISSUE FOR REVIEW (IFR)
00	31/10/23	MMA	CBO	DLO	ISSUE FOR REVIEW (IFR)

CROSSWIND

ROSETTI MARINO

TITLE :

BASE LOAD POWER HUB (BLPH)
PLOT PLAN
ELEVATION LOOKING NORTH & EAST

CONTRACT NO./TITLE CW-I-WP4-2023-05/HOLLANDSE KUST NOORD WIND PARK			SCALE 1:150
DRAWN SPS	CHECKED C. BORTOLIN	APPROVED CGI	DATE 22/09/25
A1	DRAWING NO. 123A90-DDL-PP-DL-70072		SHEET 001 / REV. 03

File Name : 123A90-DDL-PP-DL-70072 Rev.03