
DRAWING NO. DRAWING_NO. 123A90-DDL-PR-PID-80012

REV. REV 05

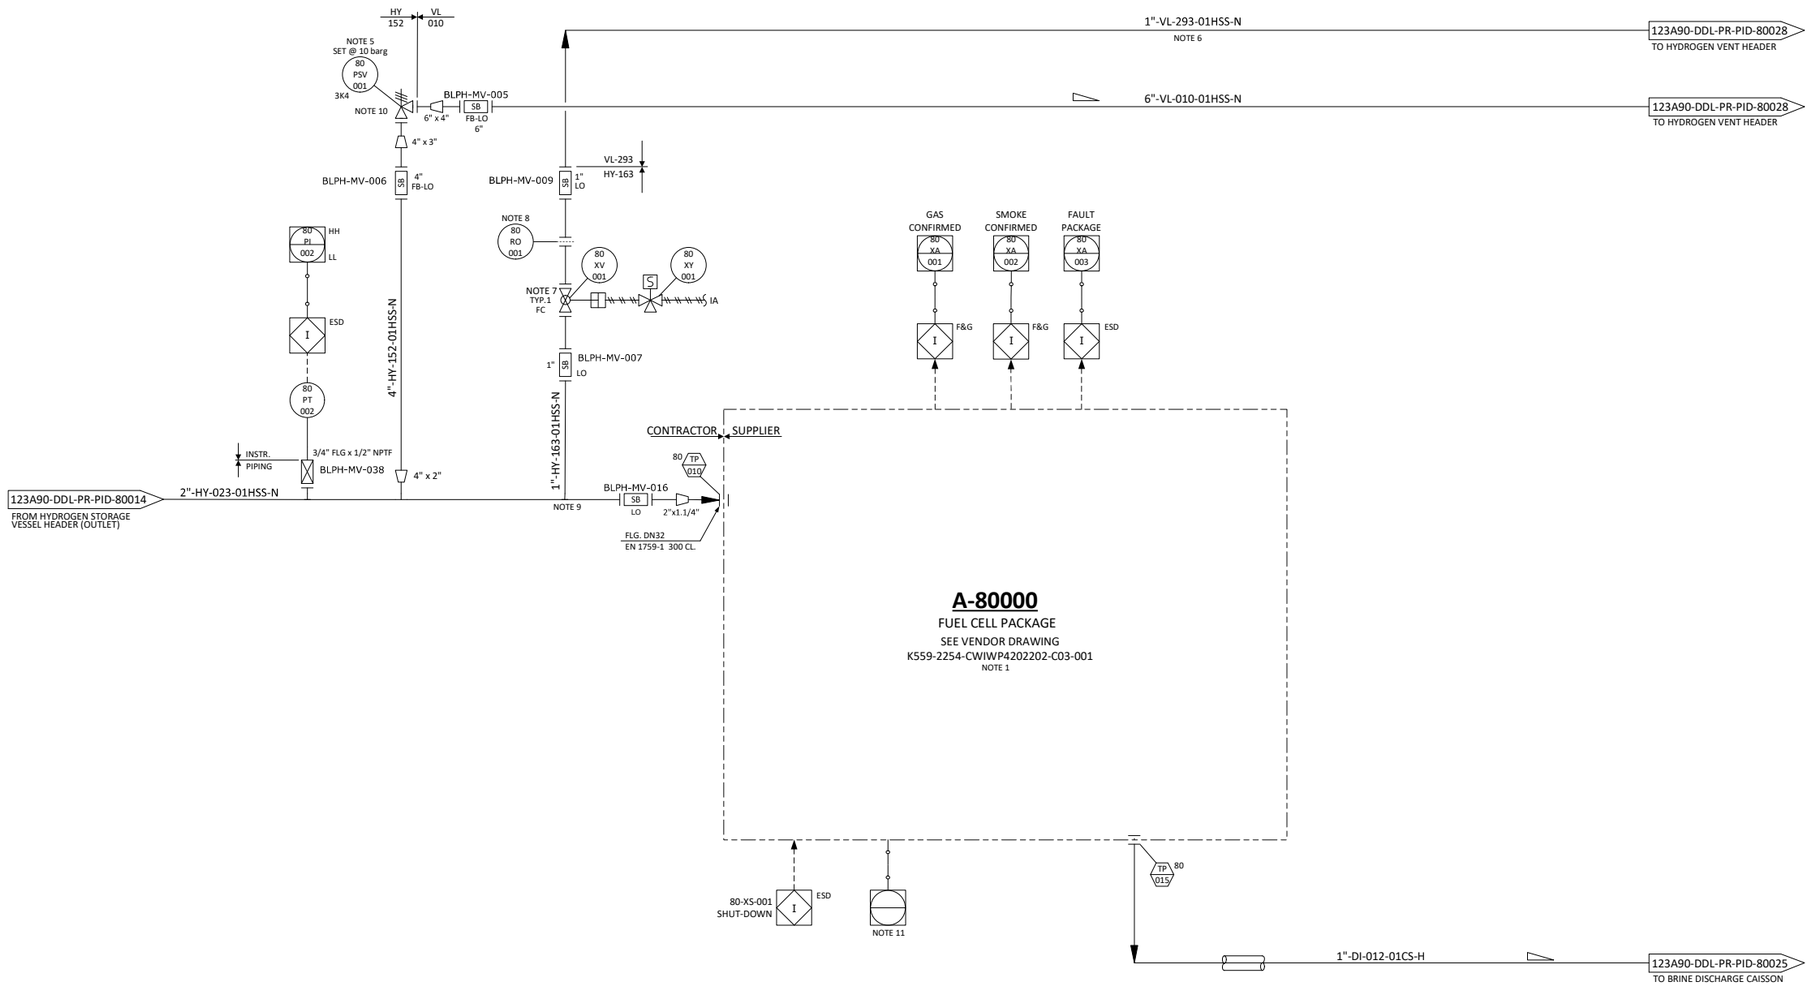

NOTES

1. THE VENDOR PACKAGE WILL CONTAIN AIR INTAKE AND EXHAUST, SUITABLY SAFEGUARDED AND SEPARATED.
2. DELETED.
3. DELETED.
4. DELETED
5. ONE UNINSTALLED SPARE PSV SHALL BE AVAILABLE.
6. LINE REQUIRED FOR PURGING OF PIPING WORK.
7. TIGHT SHUT-OFF VALVE.
8. FOR ORIFICE DIAMETER REFERENCE SHALL BE MADE TO "RELIEF, VENT AND BLOWDOWN REPORT" DOC. N. "123A90-DDL-PR-RE-80030".
9. LINE 1"-HY-163-01HSS-N WILL BE LOCATED AS CLOSE TO THE PACKAGE AS POSSIBLE TO ENSURE COMPLETE PURGING OF THE LINE.
10. 80-PSV-001 SIZED FOR CV FAILURE OF UPSTREAM CONTROL VALVE 25-PV-055A/B.
11. SERIAL COMMUNICATION WITH CONTROL SYSTEM.

HOLDS

1. DELETED.
2. DELETED.

REV.	DATE	DRN	CHKD	APPD	DESCRIPTION
05	21/10/2025	RZI	RZI	CGI	AS BUILT
04	16/04/2025	CIM	RZI	CGI	ACCEPTED FOR CONSTRUCTION (AFC)
03	09/09/2024	CIM	RZI	DLO	ACCEPTED FOR CONSTRUCTION (AFC)
02	12/06/2024	CIM	RZI	DLO	ACCEPTED FOR CONSTRUCTION (AFC)
01	15/02/2024	CIM	RZI	DLO	ISSUE FOR ACCEPTANCE (IFA)
00	20/10/2023	CIM	RZI	DLO	ISSUE FOR ACCEPTANCE (IFA)

CROSSWIND

ROSETTI MARINO

TITLE :
BLPH PIPING AND INSTRUMENTATION DIAGRAM
FUEL CELL PACKAGE

CONTRACT NO./TITLE	CW-I-WP4-2023-05/HOLLANDSE KUST NOORD WIND PARK		SCALE NTS
DRAWN	CHECKED	APPROVED	DATE

	DRAWING NO.	SHEET	REV.
A1	123A90-DDL-PR-PID-80012	001	05

File Name : FILE_NAME 123A90-DDL-PR-PID-80012