
DRAWING NO. DRAWING_NO. 123A90-DDL-PR-PID-80013

REV. REV 04

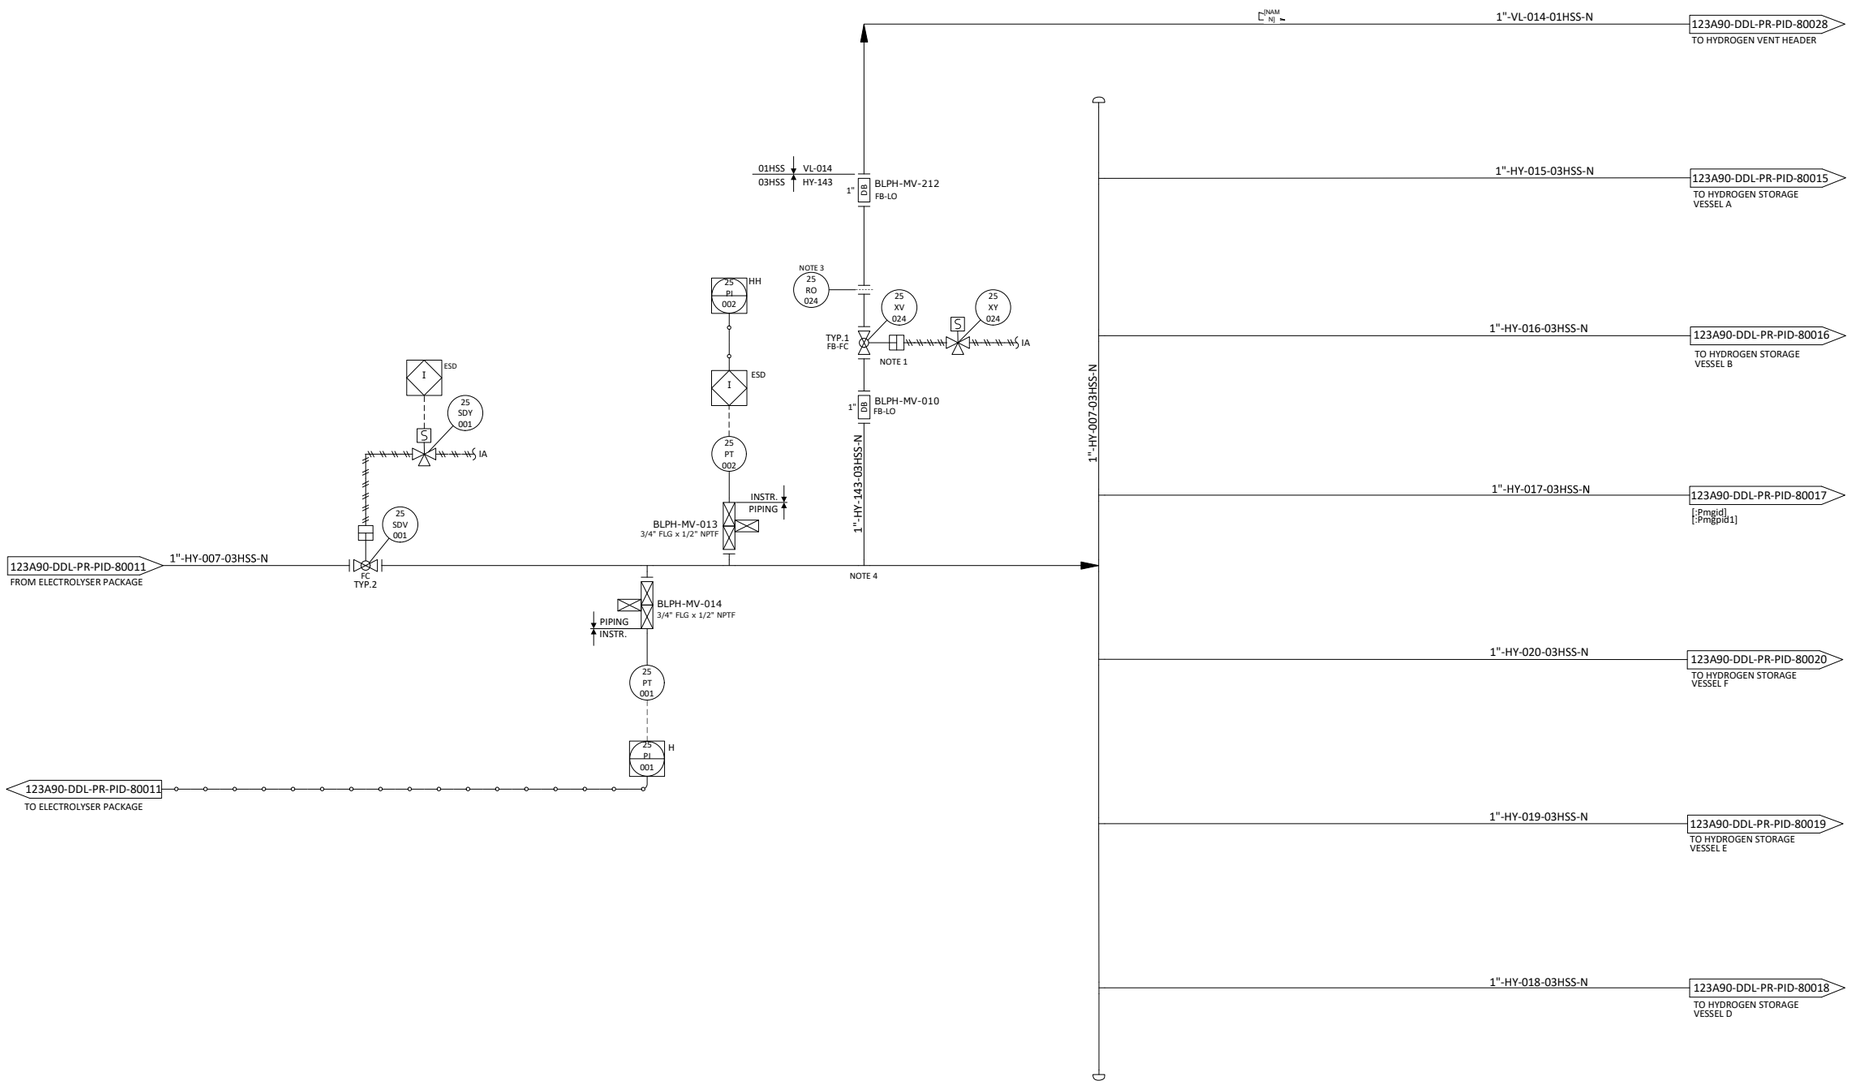

NOTES

1. TIGHT SHUT OFF XV.
2. DELETED.
3. FOR ORIFICE DIAMETER REFERENCE SHALL BE MADE TO "RELIEF, VENT AND BLOWDOWN REPORT" DOC. N. "123A90-DDL-PR-RE-80030".
4. PIPING CONNECTION TO 25-XV-003 SHALL BE AS CLOSE TO THE MANIFOLD AS POSSIBLE, TO ENSURE COMPLETE PURGING OF FEED LINE.

HOLDS

1. DELETED.

REV.	DATE	DRN	CHKD	APPD	DESCRIPTION
03	21/10/2025	RZI	RZI	CGI	AS BUILT
02	12/06/2024	CIM	RZI	DLO	ACCEPTED FOR CONSTRUCTION (AFC)
01	15/02/2024	CIM	RZI	DLO	ISSUE FOR ACCEPTANCE (IFA)
00	20/10/2023	CIM	RZI	DLO	ISSUE FOR ACCEPTANCE (IFA)

CROSSWIND

ROSETTI MARINO

TITLE :

BLPH PIPING AND INSTRUMENTATION DIAGRAM HYDROGEN STORAGE VESSELS HEADER (INLET)

CONTRACT NO./TITLE CW-I-WP4-2023-05/HOLLANDSE KUST NOORD WIND PARK			SCALE NTS
DRAWN	CHECKED	APPROVED	DATE
A1	DRAWING NO. 123A90-DDL-PR-PID-80013	SHEET 001	REV. 03

File Name : FILE_NAME