
DRAWING NO. DRAWING_NO. 123A90-DDL-PR-PID-80017

REV. REV 04

V-25001_C

HYDROGEN STORAGE VESSEL

SIZE : 2800 mm (ID) X 15500 mm (L T/T)
DESIGN P/T : 40 barg / -10 / 80 °C
MATERIAL : CARBON STEEL
OPERATING P/T : 30 barg / AMB

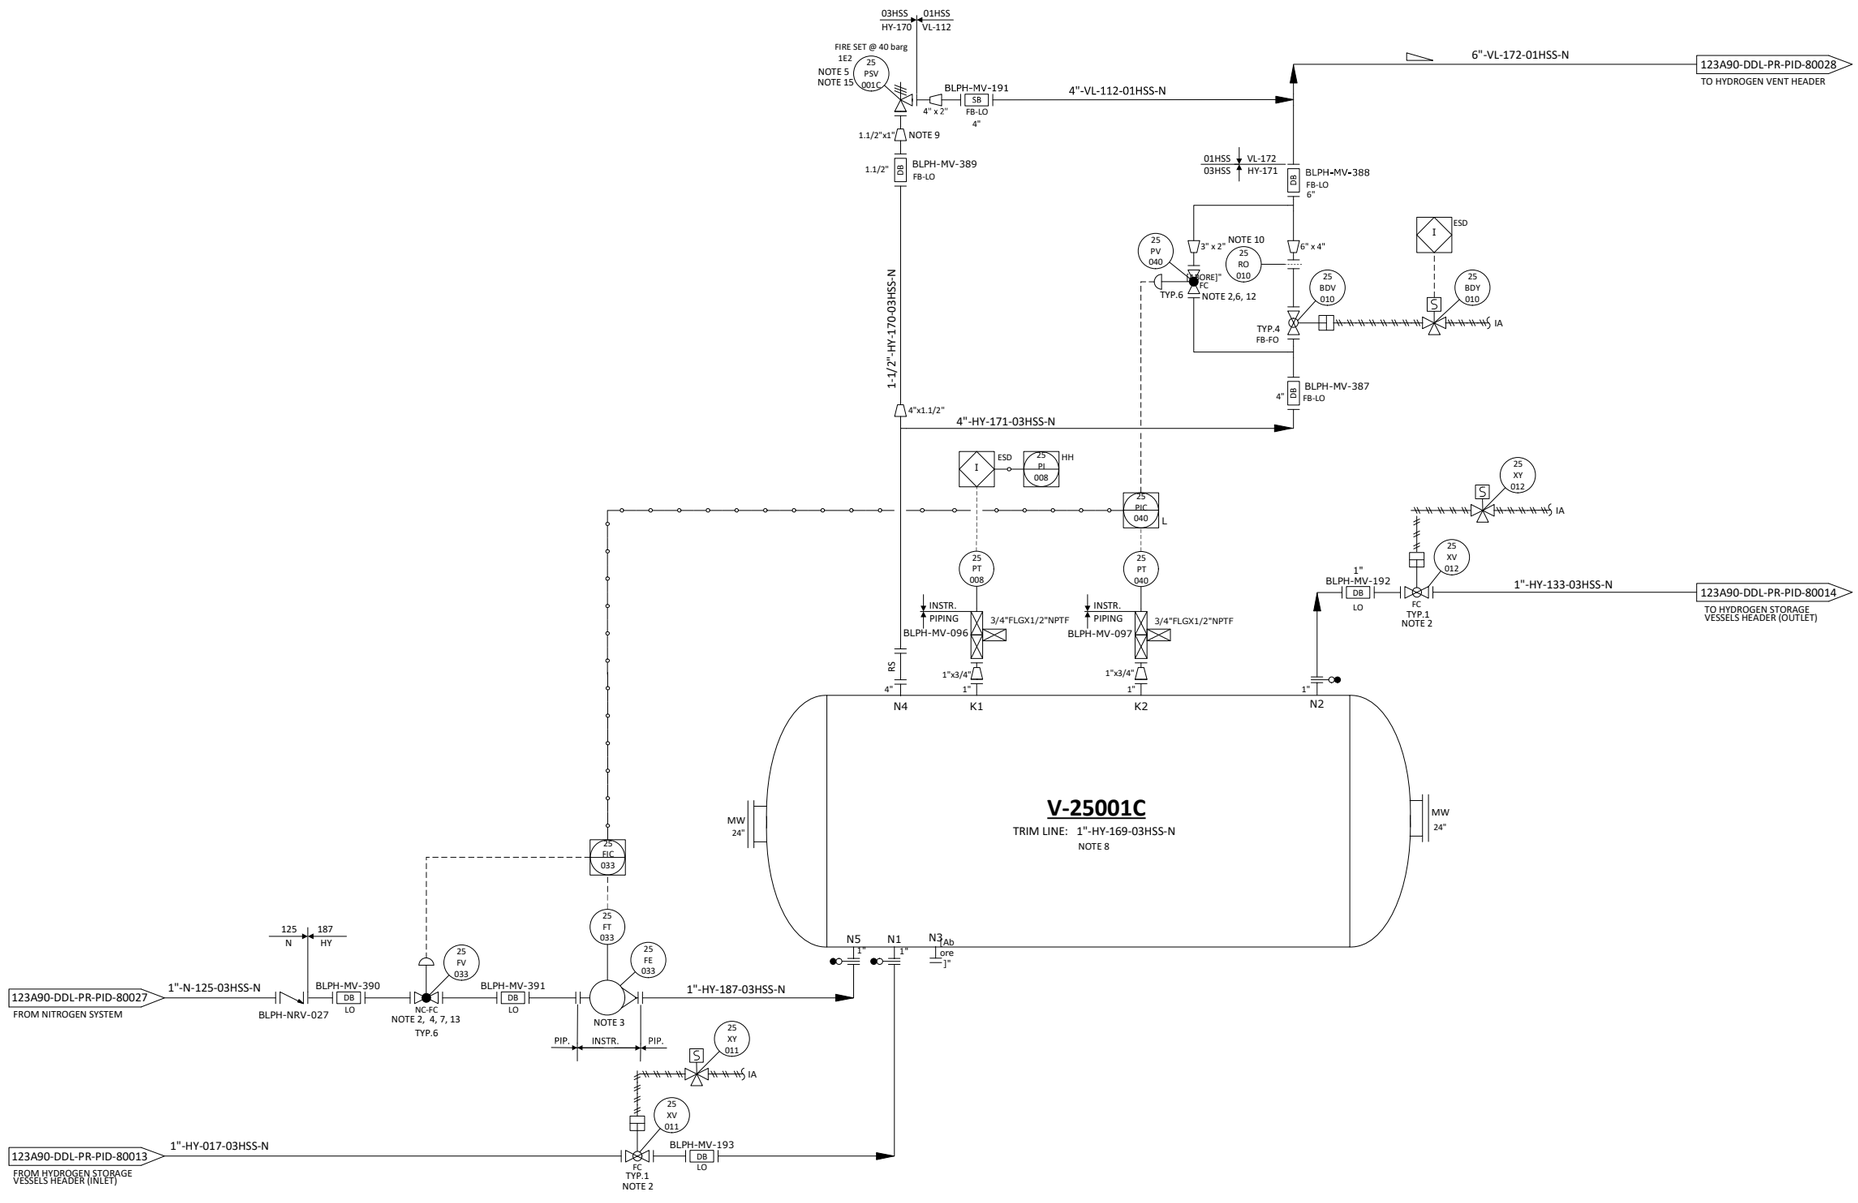

NOTES

1. DELETED.
2. TIGHT SHUT OFF VALVE.
3. VARIABLE AREA FLOWMETER TO BE INSTALLED VERTICALLY WITH DIRECTION OF FLOW UPWARDS.
4. NITROGEN CONTROL VALVE (25-FV-033), CAN NOT OPEN UNTIL THE PRESSURE WITHIN THE VESSEL IS BELOW THE NITROGEN SUPPLY PRESSURE.
5. ONE COMMON UNINSTALLED SPARE PSV FOR ALL VESSELS.
6. FOR PULSE PRESSURE PURGING OF VESSEL WITH HYDROGEN.
7. FOR FLOW PURGING OF VESSEL WITH NITROGEN.
8. FOR DESCRIPTION AND SPECIFICATION OF VESSEL NOZZLE, REFERENCE SHALL BE MADE TO THE TECHNICAL DATA SHEET FOR H2 STORAGE, DOC. N. "123A90-DDL-MAC-DS-50027".
9. REDUCERS TO BE INSTALLED AS CLOSE TO PSV AS POSSIBLE.
10. FOR ORIFICE DIAMETER REFERENCE SHALL BE MADE TO "RELIEF, VENT AND BLOWDOWN REPORT" DOC. N. "123A90-DDL-PR-RE-80030".
11. NOZZLE N4 TO BE INSTALLED AT MINIMUM DISTANCE FROM TANGENT LINE OF THE VESSEL (ON THE OPPOSITE SIDE OF N5 NOZZLE).
12. SOFTWARE INTERLOCK TO PREVENT 25-PV-040 BEING OPENED OUTSIDE OF A PURGE CYCLE OPERATION AND PROCESS START-UP CHARGING MODE (SEE DOC. "PROCESS CONTROL LOGICS DESCRIPTION" N. 123A90-DDL-IN-RE-40095). CONTROL VALVE 25-PV-040 IS USED ONLY IN CASE OF VESSEL PURGING OR PROCESS START-UP CHARGING MODES.
13. SOFTWARE INTERLOCK TO PREVENT 25-FV-033 BEING OPENED OUTSIDE OF A PURGE CYCLE OPERATION.
14. A TIMER ALARM ON THE H2 PRESSURIZATION SECTION OF THE PURGE CYCLE IN THE CONTROL LOGIC IS PROVIDED TO DETERMINE IF THE PURGE VALVE 25-PV-040 HAS FAILED TO CLOSE.
15. 25-PS-V001C SIZED FOR FIRE.

HOLDS

1. DELETED.
2. DELETED.
3. DELETED.
4. DELETED.

REV.	DATE	DRN	CHKD	APPD	DESCRIPTION
04	21/10/2025	RZI	RZI	CGI	AS BUILT
03	09/09/2024	CIM	RZI	DLO	ACCEPTED FOR CONSTRUCTION (AFC)
02	12/06/2024	CIM	RZI	DLO	ACCEPTED FOR CONSTRUCTION (AFC)
01	15/02/2024	CIM	RZI	DLO	ISSUE FOR ACCEPTANCE (IFA)
00	20/10/2023	CIM	RZI	DLO	ISSUE FOR ACCEPTANCE (IFA)

CROSSWIND

ROSETTI MARINO

TITLE :
BLPH PIPING AND INSTRUMENTATION DIAGRAM
HYDROGEN STORAGE VESSEL C

CONTRACT NO./TITLE	CW-I-WP4-2023-05/HOLLANDSE KUST NOORD WIND PARK		SCALE NTS
DRAWN	CHECKED	APPROVED	DATE

A1	DRAWING NO. 123A90-DDL-PR-PID-80017	SHEET 001	REV. 04

File Name : FILE_NAME