
DRAWING NO. DRAWING_NO:123A90-DDL-PR-PID-80028 | REV. REV04

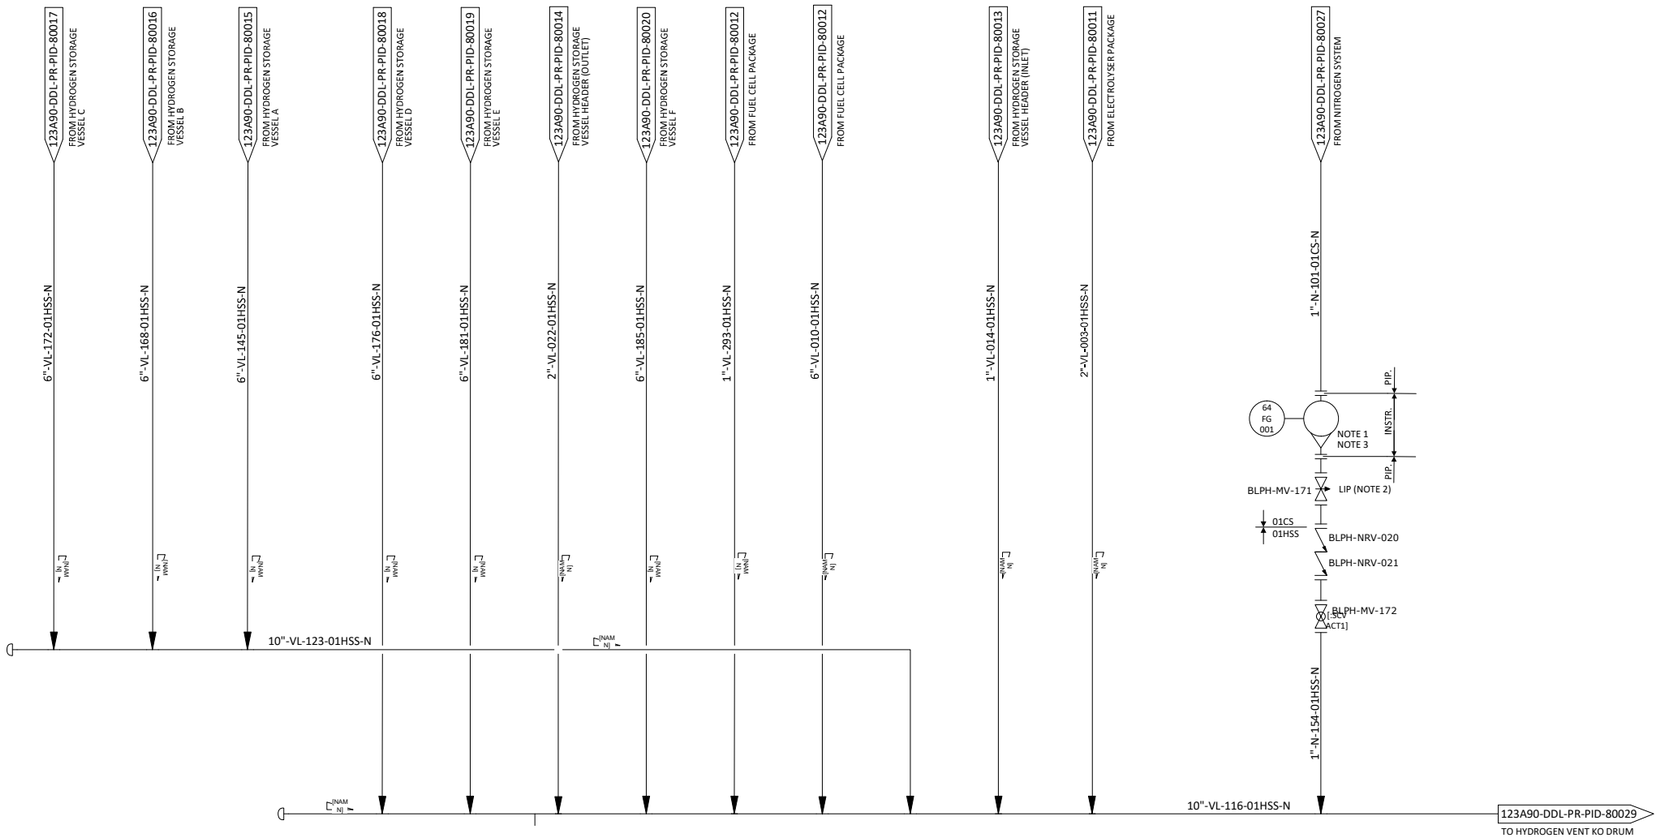

NOTES

1. FLOW METER 64-FG-001 SHALL BE READABLE FROM MANUAL VALVE MV-171.
2. VALVE BLPH-MV-171 TO BE LOCKED IN PLACE.
3. VERTICAL INSTALLATION.

HOLDS

1. DELETED.
2. DELETED.

REV.	DATE	DRN	CHKD	APPD	DESCRIPTION
04	21/10/2025	RZI	RZI	CGI	AS BUILT
03	09/09/2024	CIM	RZI	DLO	ACCEPTED FOR CONSTRUCTION (AFC)
02	12/06/2024	CIM	RZI	DLO	ACCEPTED FOR CONSTRUCTION (AFC)
01	15/02/2024	CIM	RZI	DLO	ISSUE FOR ACCEPTANCE (IFA)
00	20/10/2023	CIM	RZI	DLO	ISSUE FOR ACCEPTANCE (IFA)

CROSSWIND | ROSETTI MARINO

TITLE :
BLPH PIPING AND INSTRUMENTATION DIAGRAM
HYDROGEN VENT HEADER

CONTRACT NO./TITLE CW-I-WP4-2023-05/HOLLANDSE KUST NOORD WIND PARK			SCALE NTS
DRAWN	CHECKED	APPROVED	DATE
A1	DRAWING NO. 123A90-DDL-PR-PID-80028		SHEET 001 / REV. 04

File Name : FILE_NAME