DRAWING NO. DRAWING_NO. 123A90-DDL-PR-PID-80029


REV. REV 05

V-43001

HYDROGEN VENT KO DRUM
SIZE : 600 mm (ID) x 2350 mm (H)
DESIGN P/T : 3.5 barg / -10 / 80°C
MATERIAL : LTCS + 1 mm CA

Q-43004

HYDROGEN VENT NOTE 1
SIZE : 254 mm (ID)
DESIGN P/T : 3.5 barg / -10 / 80°C
MATERIAL : LTCS + 3 mm CA

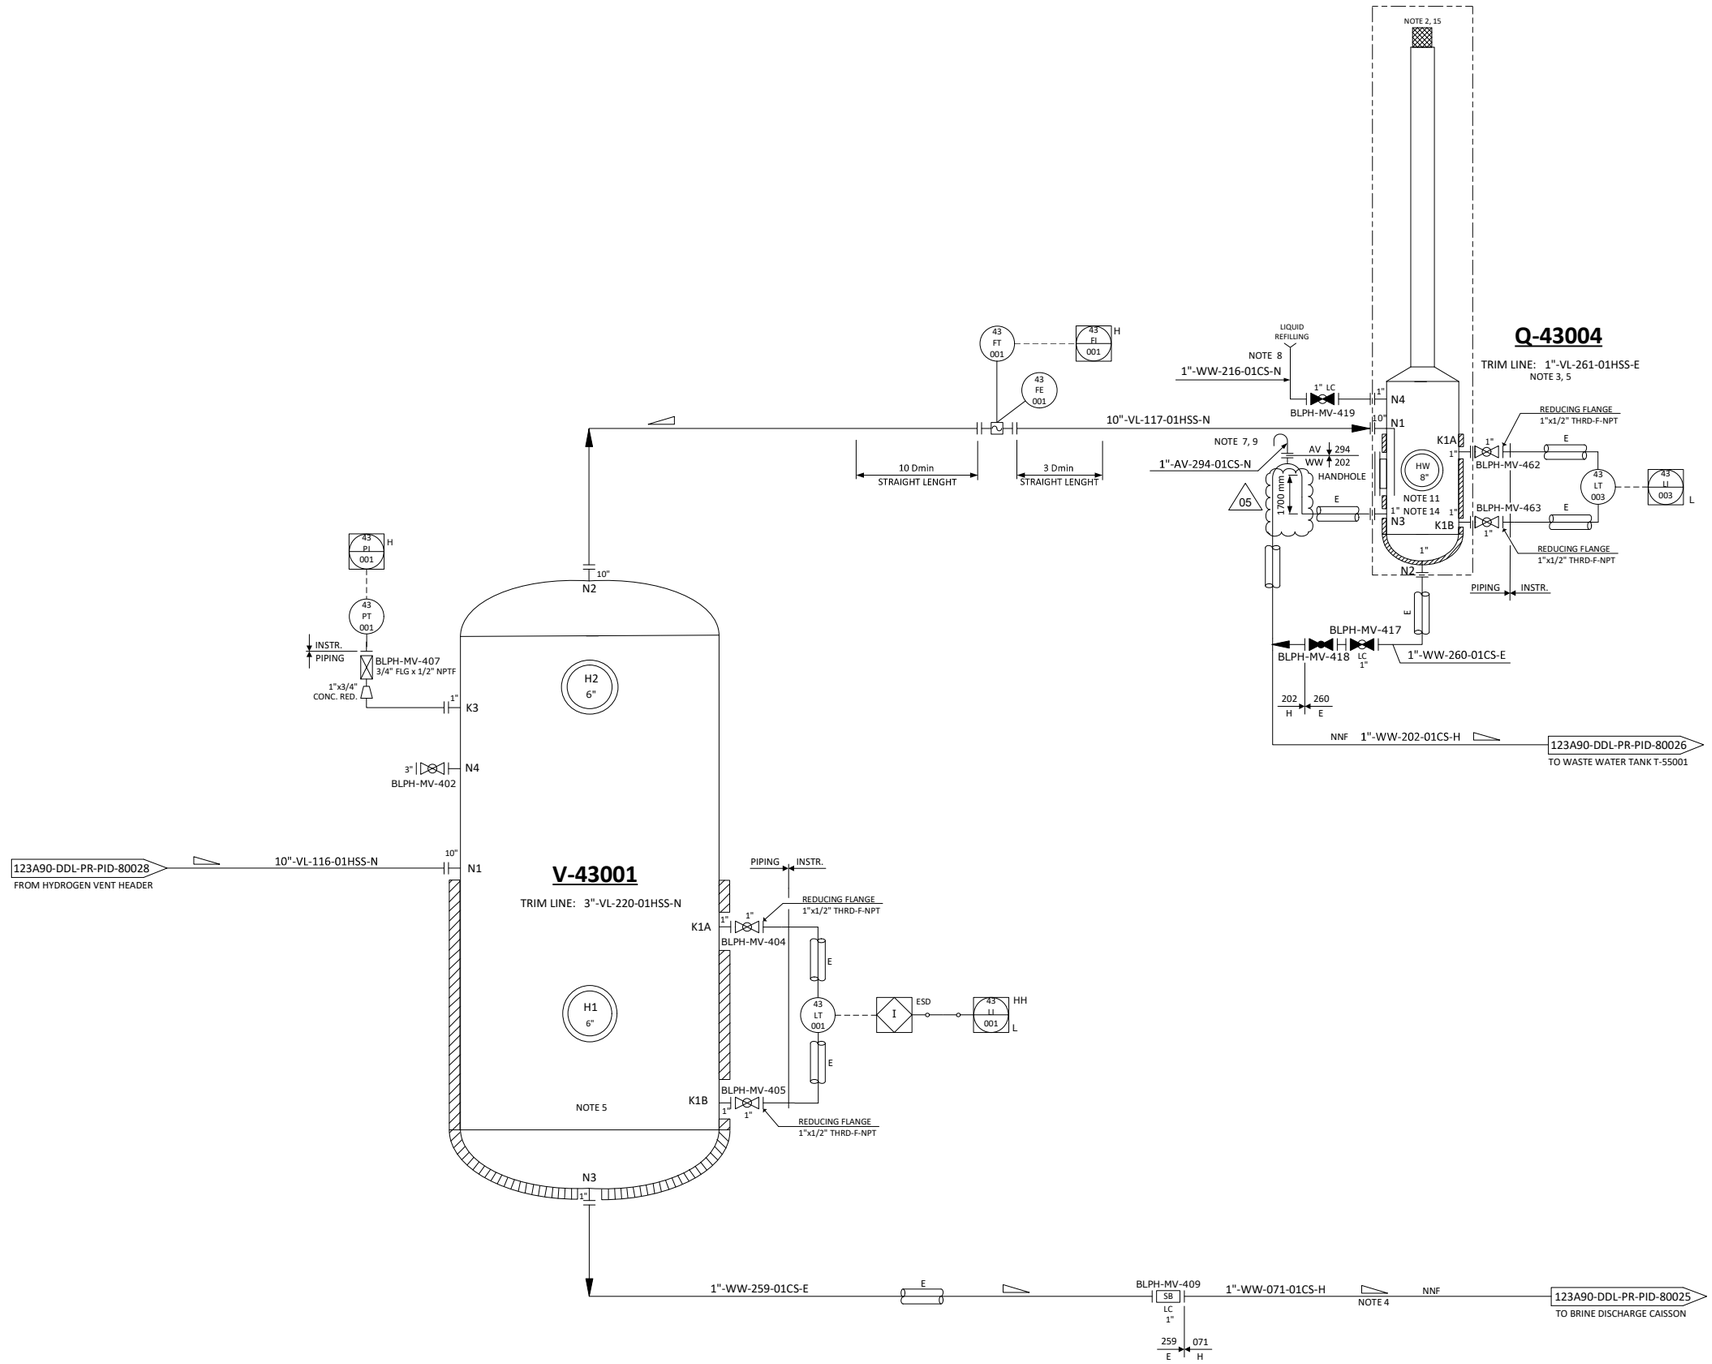

NOTES

1. VENT TO SAFE LOCATION SEGREGATED FROM OTHER VENTS.
2. VENT TO BE EQUIPPED WITH BIRD SCREEN.
3. LIQUID SEAL DRUM IS PART OF THE VENT SYSTEM.
4. LIQUID DRAIN LINES TO BE ROUTED TO ENSURE GRAVITY DRAIN.
5. HYDROGEN VENT KO DRUM AND LIQUID SEAL DRUM TO BE HEAT TRACING.
   - V-43001 HEAT TRACED FROM B.T.L. UP TO 600 mm, BOTTOM HEAD ALSO TO BE HEAT TRACED.
6. DELETED. 05
7. SEAL VENT TO BE PLACED INTO A SAFE POSITION.
8. FILLING LINE TO BE PLACED IN AN ACCESSIBLE POSITION.
9. TRACED FROM NOZZLE N3 UP TO SWAN NECK.
10. DELETED.
11. INLET DIP LEG SUBMERSION HEIGHT OF 0.6 m.
12. DELETED.
13. FOR DESCRIPTION AND SPECIFICATION OF VESSEL NOZZLE, REFERENCE SHALL BE MADE TO THE TECHNICAL DATA SHEET FOR H2 VENT KOD.
14. LIQUID INSIDE SEAL DRUM IS A WATER - GLYCOL MIXTURE WITH 50% VOLUME OF GLYCOL.
15. TOP OF TIP OF H2 VENT SHALL BE AT AS MINIMUM 6.2 m FROM HIGHEST REACHABLE PLATFORM.

HOLDS

1. DELETED.
2. DELETED.
3. DELETED.

REV.	DATE	DRN	CHKD	APPD	DESCRIPTION
05	21/10/2025	RZI	RZI	CGI	AS BUILT
04	16/04/2025	CIM	RZI	CGI	ACCEPTED FOR CONSTRUCTION (AFC)
03	09/09/2024	CIM	RZI	DLO	ACCEPTED FOR CONSTRUCTION (AFC)
02	12/06/2024	CIM	RZI	DLO	ACCEPTED FOR CONSTRUCTION (AFC)
01	15/02/2024	CIM	RZI	DLO	ISSUE FOR ACCEPTANCE (IFA)
00	20/10/2023	CIM	RZI	DLO	ISSUE FOR ACCEPTANCE (IFA)

CROSSWIND

ROSETTI MARINO

TITLE :
BLPH PIPING AND INSTRUMENTATION DIAGRAM
HYDROGEN VENT DRUM

CONTRACT NO./TITLE	CW-I-WP4-2023-05/HOLLANDSE KUST NOORD WIND PARK		SCALE NTS
DRAWN	CHECKED	APPROVED	DATE

	DRAWING NO.	SHEET	REV.
A1	123A90-DDL-PR-PID-80029	001	05

File Name : FILE_NAME