
DRAWING NO. DRAWING_NO. 123A90-DDL-PR-PID-80041

REV. REV 07

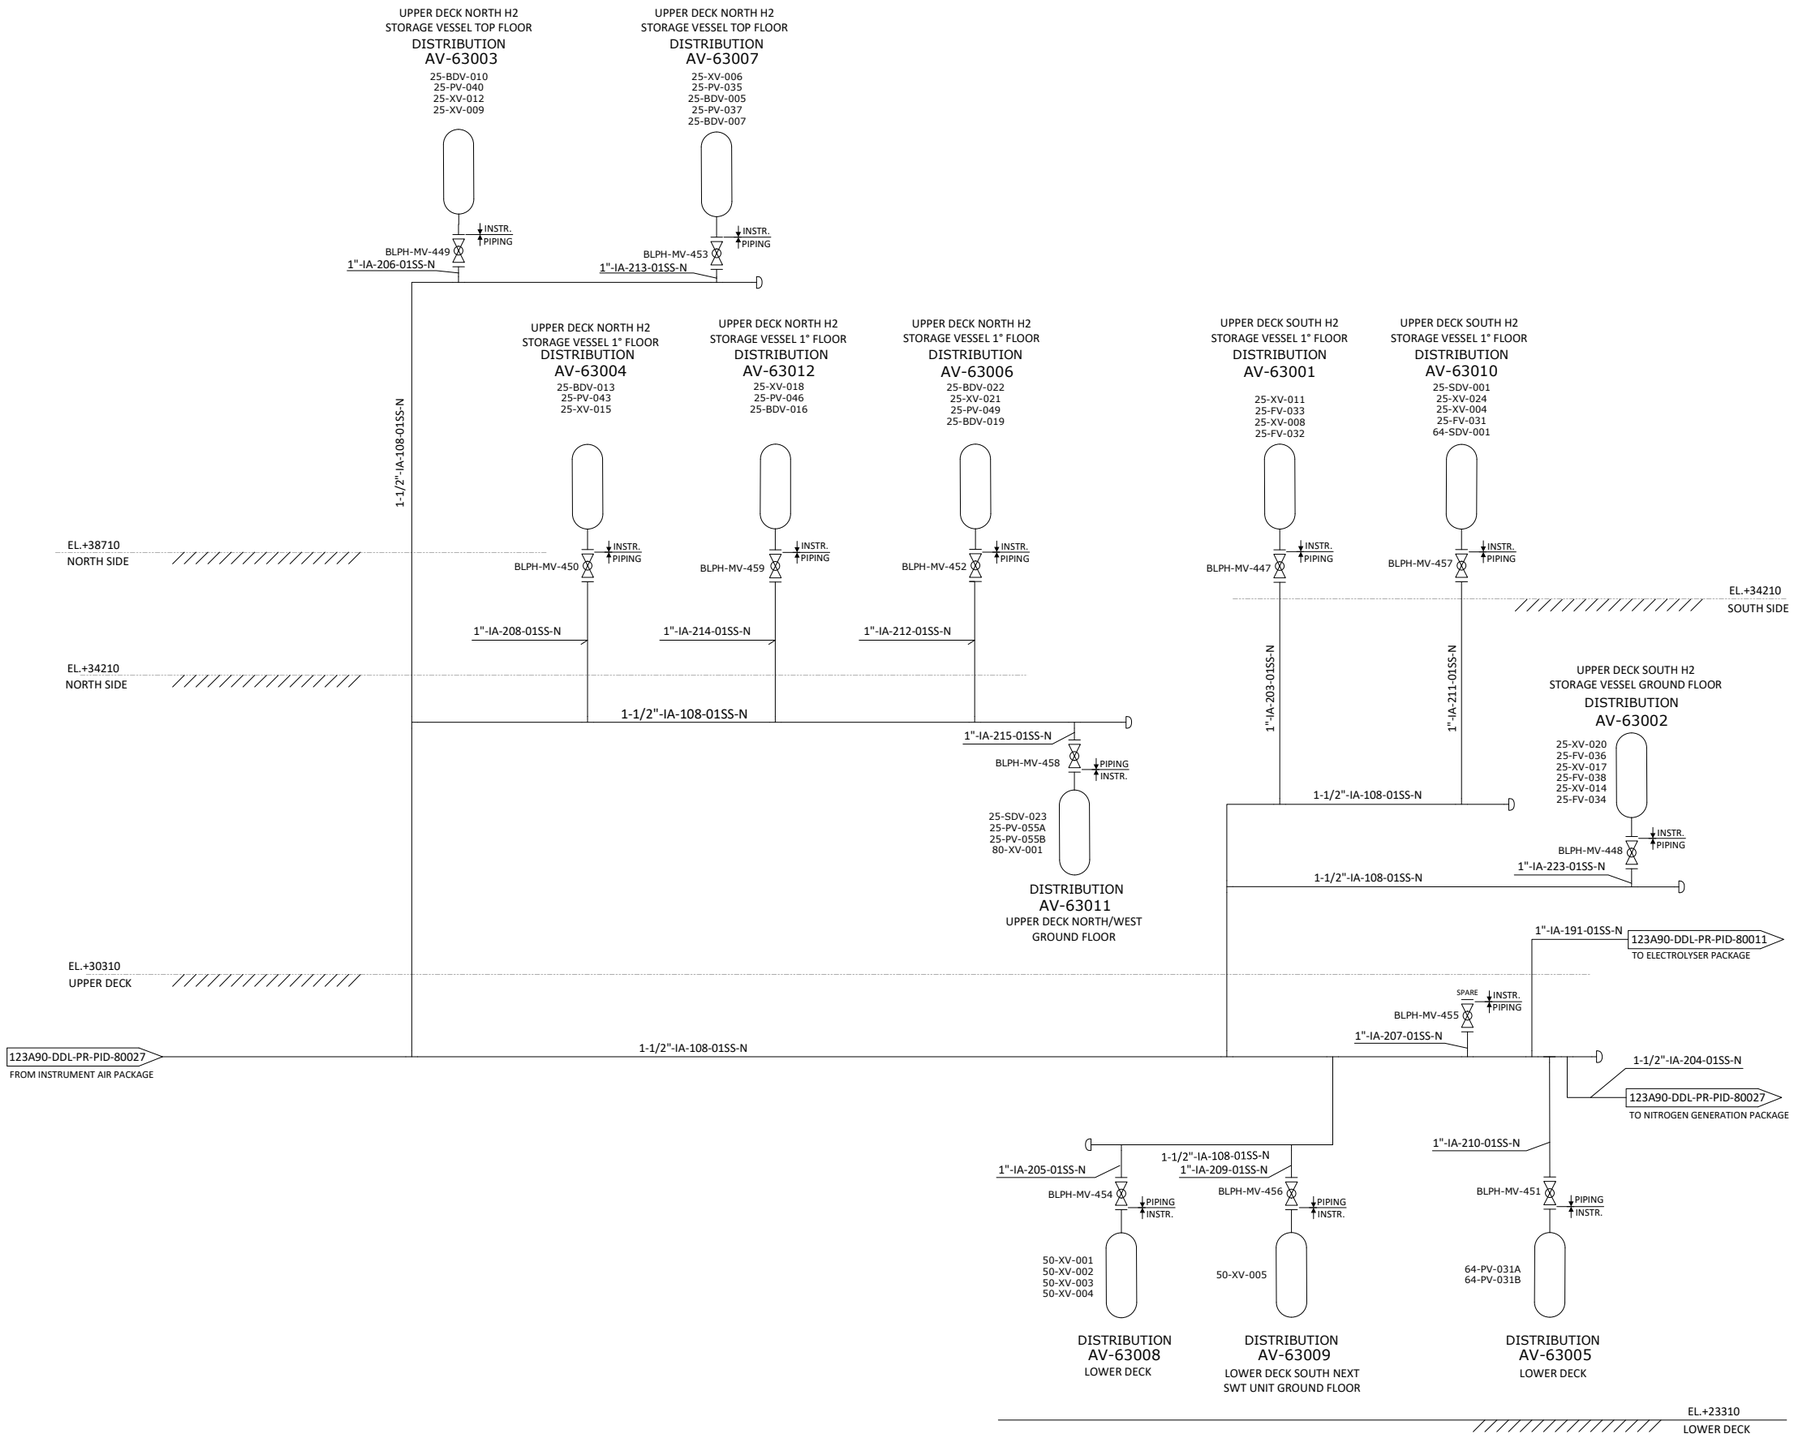

NOTES

REV.	DATE	DRN	CHKD	APPD	DESCRIPTION
07	21/10/2025	RZI	RZI	CGI	AS BUILT
06	19/05/2025	CIM	RZI	CGI	ACCEPTED FOR CONSTRUCTION (AFC)
05	16/04/2025	CIM	RZI	CGI	ACCEPTED FOR CONSTRUCTION (AFC)
04	11/10/2024	CIM	RZI	DLO	ACCEPTED FOR CONSTRUCTION (AFC)
03	09/09/2024	CIM	RZI	DLO	ACCEPTED FOR CONSTRUCTION (AFC)
02	12/06/2024	CIM	RZI	DLO	ACCEPTED FOR CONSTRUCTION (AFC)
01	15/02/2024	CIM	RZI	DLO	ISSUE FOR ACCEPTANCE (IFA)
00	20/10/2023	CIM	RZI	DLO	ISSUE FOR ACCEPTANCE (IFA)

CROSSWIND

ROSETTI MARINO

TITLE :
BLPH PIPING AND INSTRUMENTATION DIAGRAM
INSTRUMENT AIR DISTRIBUTION HEADER

CONTRACT NO./TITLE	CW-I-WP4-2023-05/HOLLANDSE KUST NOORD WIND PARK	SCALE	NTS
DRAWN	CHECKED	APPROVED	DATE
A1	DRAWING NO. 123A90-DDL-PR-PID-80041	SHEET 001	REV. 07

File Name : FILE_NAME