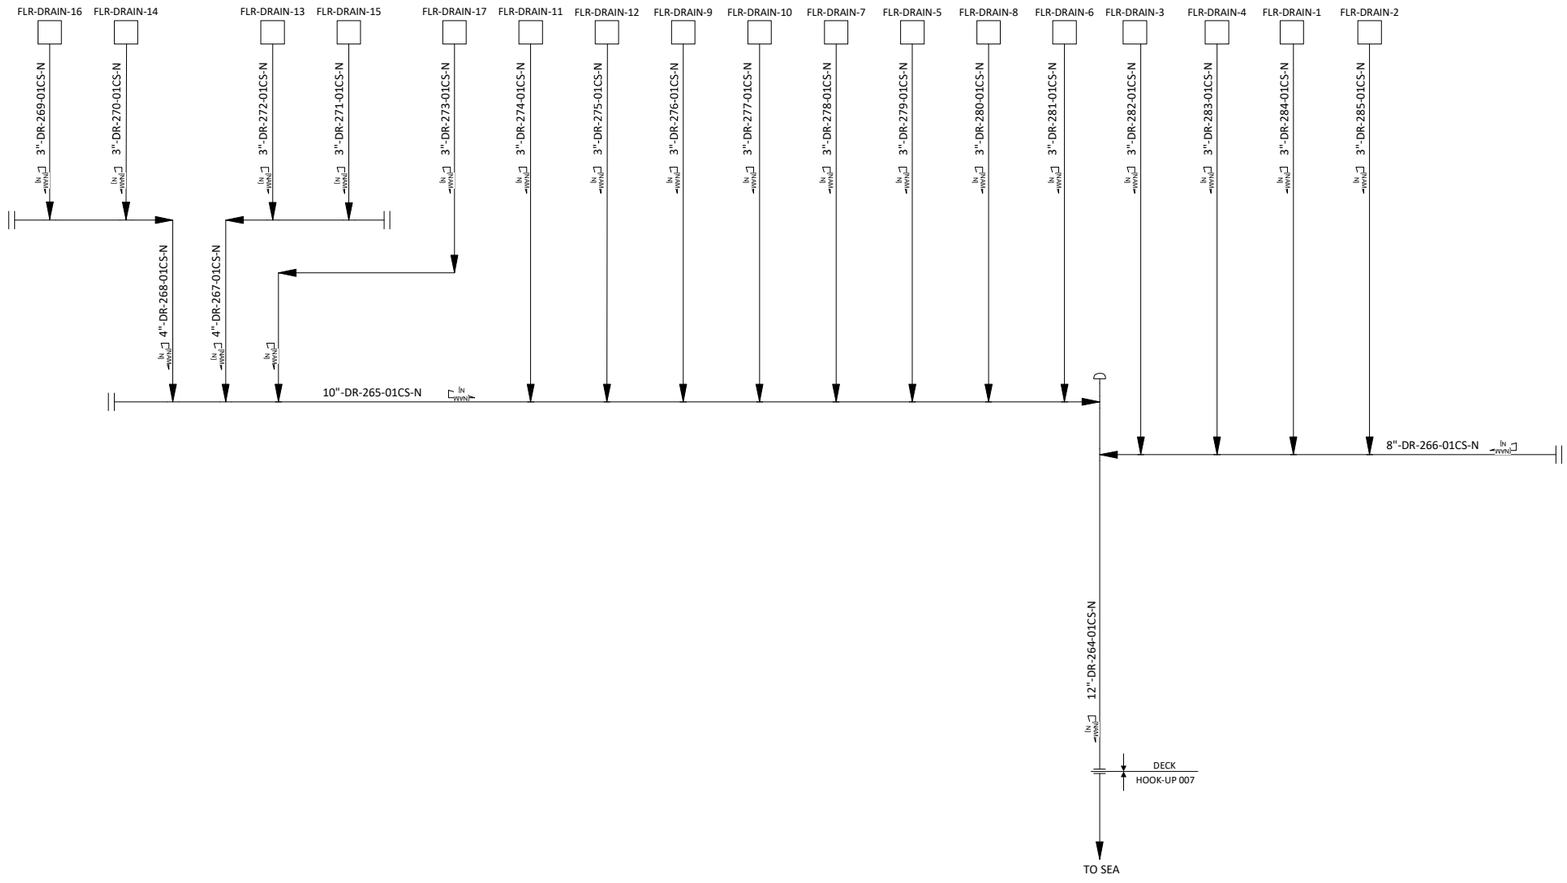


NOTES

1. ALL HEADERS ARE BELOW THE UPPER DECK. 01

HOLDS

REV.	DATE	DRN	CHKD	APPD	DESCRIPTION
02	21/10/2025	RZI	RZI	CGI	AS BUILT
01	09/09/2024	CIM	RZI	DLO	ACCEPTED FOR CONSTRUCTION (AFC)
00	12/06/2024	CIM	RZI	DLO	ISSUE FOR ACCEPTANCE (IFA)

CROSSWIND

ROSETTI MARINO

TITLE :
BLPH PIPING AND INSTRUMENTATION DIAGRAM
OPEN DRAIN SYSTEM

CONTRACT NO./TITLE	CW-I-WP4-2023-05/HOLLANDSE KUST NOORD WIND PARK		SCALE NTS
DRAWN	CHECKED	APPROVED	DATE

A1	DRAWING NO. 123A90-DDL-PR-PID-80043	SHEET 001	REV. 02

File Name : FILE_NAME