

DRAWING NO. 123A90-DDL-SAF-DL-30022

REV. 04

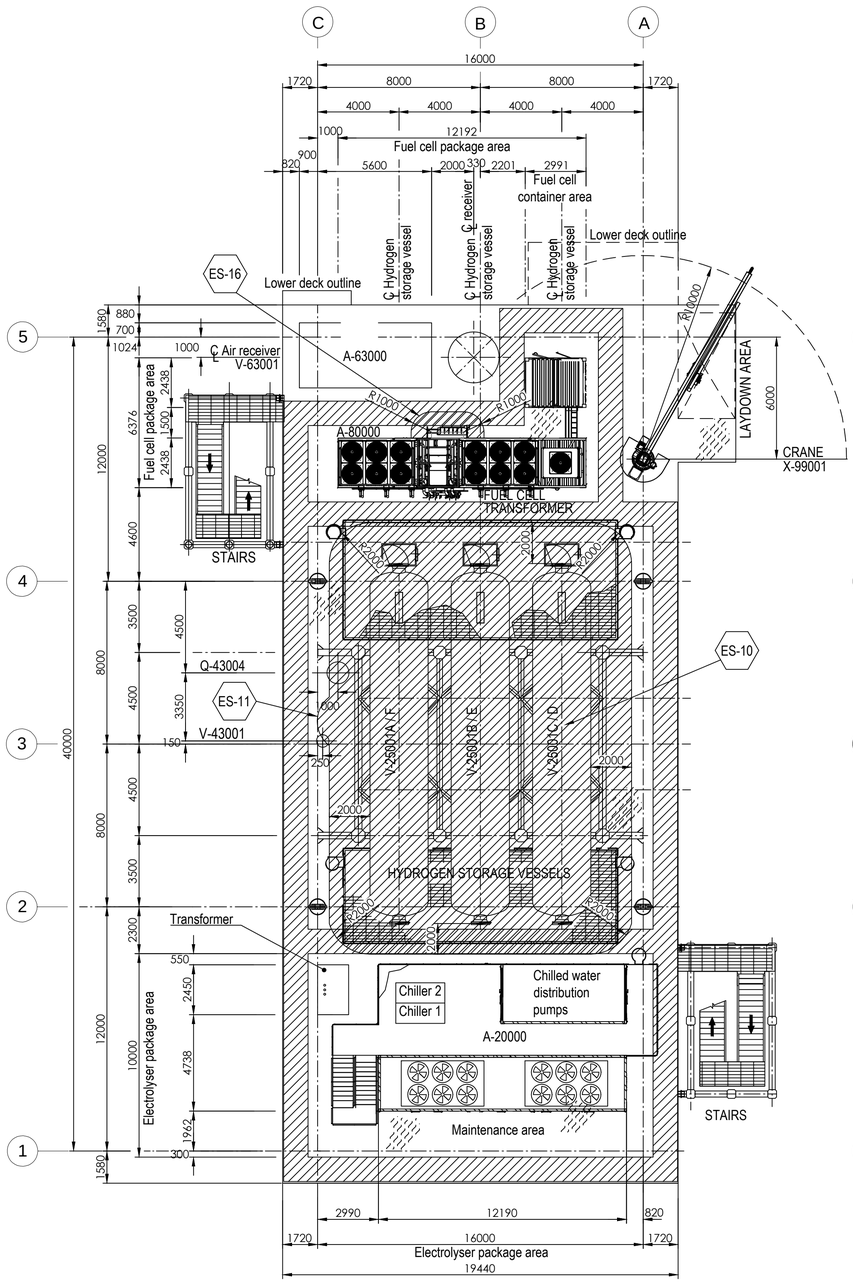


PLAN ON UPPER DECK
EL+30.310 T.O.S.

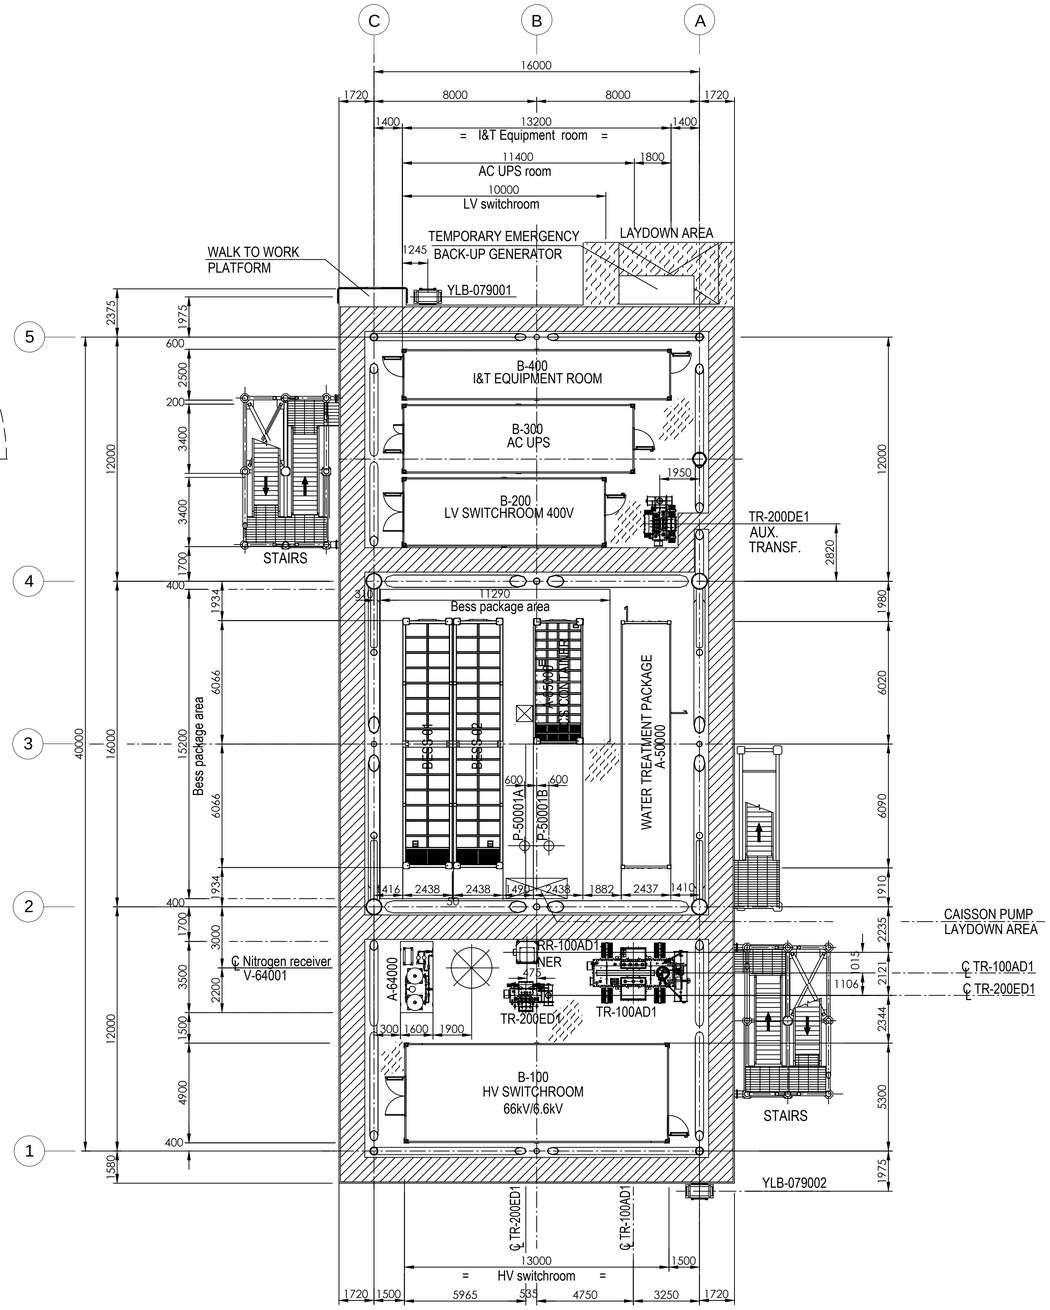

PLAN ON LOWER DECK
EL+23.310 T.O.S.

Tag No.	Equipment Tag	Description	Material	Ventilation Type
01	P-50001 A/B	SEA WATER LIFT PUMPS	SEA WATER	NATURAL (OPEN AREA)
02	Q-43004	HYDROGEN VENT	HYDROGEN	NATURAL (OPEN AREA)
03	V-43001	HYDROGEN VENT KO DRUM	HYDROGEN	NATURAL (OPEN AREA)
04	V-25001 (A/B/C/D/E/F)	HYDROGEN STORAGE VESSELS	HYDROGEN	NATURAL (OPEN AREA)
05	V-63001	AIR RECEIVER	INSTRUMENT AIR	NATURAL (OPEN AREA)
06	A-20000	ELECTROLYSER PACKAGE		
07	A-63000	INSTRUMENT AIR PACKAGE		
08	A-80000	FUEL CELL PACKAGE		
09	A-85000	BESS PACKAGE		
10	YLB-079001/2	LIFE RAFTS		
11	A-50000	WATER TREATMENT PACKAGE		

Tag No.	Equipment Tag	Description	Material	Ventilation Type
12	A-64000	NITROGEN SYSTEM		
13	B-100	HV SWITCHROOM 66kV/6.6kV		
14	B-200	LV SWITCHROOM 400V		
15	B-300	AC UPS EQUIPMENT ROOM		
16	B-400	I&T EQUIPMENT ROOM		
17	TR-100AD1	TRANSFORMER MAIN 66kV/6.6kV		
18	RR-100AD1-NER	NEUTRAL EARTHING RESISTOR		
19	TR-200DE1	TRANSFORMER AUX. 6.6kV/0.4kV		
20	TR-200ED1	SOLAR TRANSFORMER PV FARM EQUIPMENT		
21	X-99001	CRANE		
22	V-64001	NITROGEN RECEIVER		

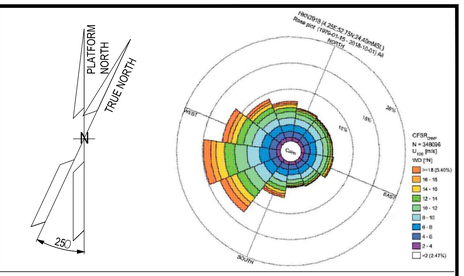

NOTES

1. ALL DIMENSIONS IN mm U.N.O.
2. ALL ELEVATIONS IN METERS.
3. PLATFORM NORTH DIRECTION IS N 25°W.
4. VENT TOP SHALL BE REACHEABLE FOR MAINTENANCE PURPOSE.
5. THE BESS IS CONSIDERED SAFE AREA EXCEPT EXTRACTORES FROM BATTERIES , CURRENTLY NOT SHOWN IN DRAWINGS, SINCE INFORMATION FROM VENDOR IS NOT YET AVAILABLE.[ES17].
6. THE LOCATION OF EMISSION SOURCES ON THE LAYOUT ARE ONLY INDICATIVE. EMISSION SOURCES CONSIDERED ARE PRESENT WITHIN THE EXTENSION OF HAZARDOUS CLASSIFIED AREAS SHOWN ON THE LAYOUT. THIS IS BECAUSE VALVES AND FLANGES,WHICH ARE CONSIDERED POTENTIAL SOURCES OF RELEASE POINTS FOR FLAMMABLE GAS ARE NOT SHOWN ON CURRENT LAYOUT PROVIDED. THE SAME APPLIES TO THE EMISSION SOURCES FOR CPI'S ITEM.
7. IDENTIFIED EMISSION SOURCES DETAIL.
8. FOR DETAILS RELATED TO ELECTROLYSER PACKAGE INTERNAL ENCLOSURES REFER TO DRAWING 224J10-DDL-PP-DA-00001 REV 0.
9. FOR DETAILS RELATED TO FUELL CELL PACKAGE INTERNAL ENCLOSURES REFER TO DRAWING K559-2254-CWIWP4202202-B01-001 REV 009".
10. THE N.6 HYDROGEN STORAGE VESSELS ARE NOT CLASSIFIED INTERNALLY, SINCE THEY ARE DESIGNED TO CONTAIN HYDROGEN OR NITROGEN FOR THE ENTIRE DURATION OF THE 2 YEARS OF OPERATION.

EMISSION SOURCE No.	IDENTIFIED AREAS
ES10	HYDROGEN STORAGE VESSLES
ES11	HYDROGEN VENT KO DRUM
ES16	FUEL CELL

LEGEND

ZONE 0 — ZONE 1

ZONE 2 — ES EMISSION SOURCES

123A90-DDL-PP-DS-70071	PLOT PLAN - BELOW LOWER DECK
123A90-DDL-PP-DS-70072	PLOT PLAN - ELEVATION LOOKING NORTH & EAST

REV.	DATE	DRN	CHKD	APPD	DESCRIPTION
04	22/10/25	SPS	CCA	CGI	AS-BUILT (ASB)
03	15/05/25	MMA	CCA	DLO	ACCEPTED FOR CONSTRUCTION (AFC)
02	15/01/25	MMA	CCA	DLO	ACCEPTED FOR CONSTRUCTION (AFC)
01	27/08/24	MMA	CCA	DLO	ACCEPTED FOR CONSTRUCTION (AFC)
00	08/02/24	MMA	CCA	DLO	ISSUE FOR REVIEW (IFR)

CROSSWIND

ROSETTI MARINO

TITLE :
BASE LOAD POWER HUB (BLPH)
HAZARDOUS AREA CLASSIFICATION
LOWER & UPPER DECK

CONTRACT NO./TITLE CW-I-WP4-2023-05/HOLLANDSE KUST NOORD WIND PARK		SCALE 1:150	
DRAWN SPS	CHECKED C. CARACCIOLO	APPROVED CGI	DATE 22/10/2025
A1	DRAWING NO. 123A90-DDL-SAF-DL-30022	SHEET 001	REV. 04

File Name : 123A90-DDL-SAF-DL-30022 Rev.04