

DRAWING NO. 123A90-DDL-SAF-DL-30024


REV. 04

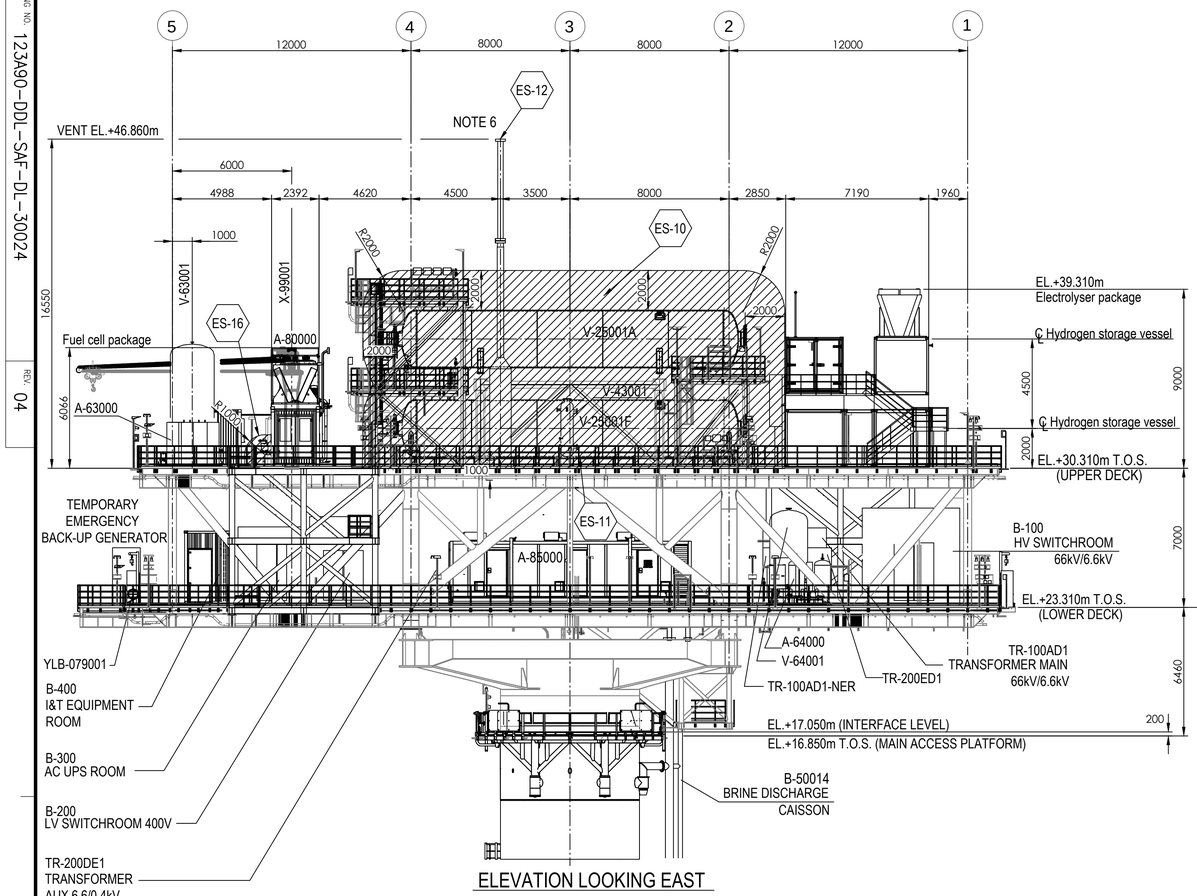


ELEVATION LOOKING EAST

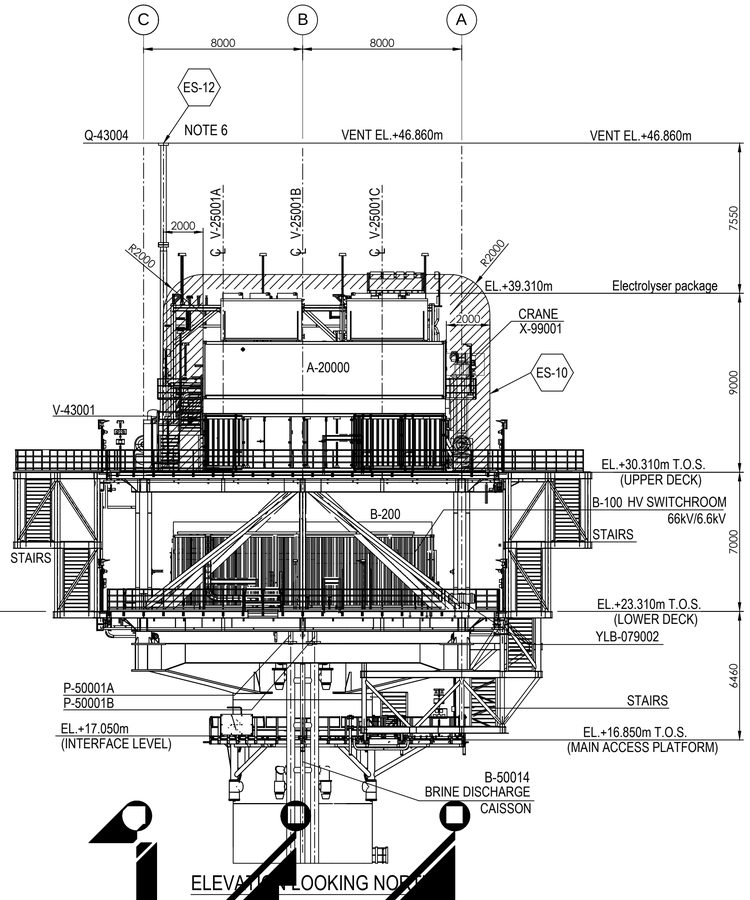

ELEVATION LOOKING NORTH

 

Tag No.	Equipment Tag	Description	Material	Ventilation Type
01	P-50001 A/B	SEA WATER LIFT PUMPS	SEA WATER	NATURAL (OPEN AREA)
02	Q-43004	HYDROGEN VENT	HYDROGEN	NATURAL (OPEN AREA)
03	V-43001	HYDROGEN VENT KO DRUM	HYDROGEN	NATURAL (OPEN AREA)
04	V-25001 (A/B/C/D/E/F)	HYDROGEN STORAGE VESSELS	HYDROGEN	NATURAL (OPEN AREA)
05	V-63001	INSTRUMENT AIR RECEIVER	INSTRUMENT AIR	NATURAL (OPEN AREA)
06	A-20000	ELECTROLYSER PACKAGE	HYDROGEN	FORCED
07	A-63000	INSTRUMENT AIR PACKAGE	N/A	
08	A-80000	FUEL CELL PACKAGE	HYDROGEN	FORCED
09	A-85000	BESS PACKAGE	HYDROGEN	FORCED
10	YLB-079001/2	LIFE RAFTS	N/A	
11	B-100	HV SWITCHROOM 66kV/6.6kV	N/A	
12	B-200	LV SWITCHROOM 400V	N/A	
13	B-300	AC UPS EQUIPMENT ROOM	N/A	
14	B-400	I&T EQUIPMENT ROOM	N/A	
15	TR-100AD1	TRANSFORMER MAIN 66kV/6.6kV	N/A	
16	TR-100AD1-NER	NEUTRAL EARTHING RESISTOR	N/A	
17	TR-200DE1	TRANSFORMER AUX. 6.6kV/0.4kV	N/A	
18	TR-200ED1	SOLAR TRANSFORMER PV FARM EQUIPMENT	N/A	
19	X-99001	CRANE	N/A	
20	V-64001	NITROGEN RECEIVER	NITROGEN	

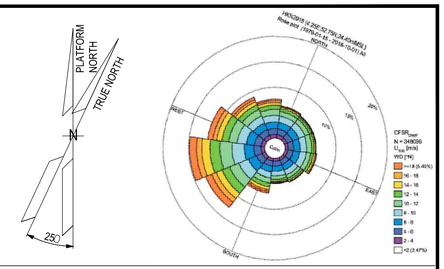

NOTES

1. ALL DIMENSIONS IN mm U.N.O
2. ALL ELEVATIONS IN METERS.
3. PLATFORM NORTH DIRECTION IS N 25°W.
4. VENT TOP SHALL BE REACHEABLE FOR MAINTENANCE PURPOSE.
5. THE BESS IS CONSIDERED SAFE AREA EXCEPT EXTRACTORES FROM BATTERIES , CURRENTLY NOT SHOWN IN DRAWINGS, SINCE INFORMATION FROM VENDOR IS NOT YET AVAILABLE.[ES17]
6. FOR ES12 PLUME, PLEASE REFER TO THE DETAIL "A" BELOW.
7. THE LOCATION OF EMISSION SOURCES ON THE LAYOUT ARE ONLY INDICATIVE. EMISSION SOURCES CONSIDERED ARE PRESENT WITHIN THE EXTENSION OF HAZARDOUS CLASSIFIED AREAS SHOWN ON THE LAYOUT. THIS IS BECAUSE VALVES AND FLANGES,WHICH ARE CONSIDERED POTENTIAL SOURCES OF RELEASE POINTS FOR FLAMMABLE GAS ARE NOT SHOWN ON CURRENT LAYOUT PROVIDED. THE SAME APPLIES TO THE EMISSION SOURCES FOR CPI'S ITEM.
8. IDENTIFIED EMISSION SOURCES DETAIL

EMISSION SOURCE No.	IDENTIFIED AREAS
ES10	HYDROGEN STORAGE VESSLES
ES11	HYDROGEN VENT KO DRUM
ES12	HYDROGEN VENT
ES16	FUEL CELL

LEGEND

ZONE 0 — ZONE 1

ZONE 2 — ES EMISSION SOURCES

REFERENCE DOCUMENTS

123A90-DDL-PP-DS-70070	PLOT PLAN - LOWER & UPPER DECK
123A90-DDL-PP-DS-70071	PLOT PLAN - BELOW LOWER DECK

REV.	DATE	DRN	CHKD	APPD	DESCRIPTION
04	22/10/25	SPS	CCA	CGI	AS-BUILT (ASB)
03	15/05/25	MMA	CCA	DLO	ACCEPTED FOR CONSTRUCTION (AFC)
02	15/01/24	MMA	CCA	DLO	ACCEPTED FOR CONSTRUCTION (AFC)
01	27/08/24	MMA	CCA	DLO	ACCEPTED FOR CONSTRUCTION (AFC)
00	08/02/24	MMA	CCA	DLO	ISSUE FOR REVIEW (IFR)

CROSSWIND

ROSETTI MARINO

TITLE :
BASE LOAD POWER HUB (BLPH)
HAZARDOUS AREA CLASSIFICATION
ELEVATION LOOKING NORTH & EAST

CONTRACT NO./TITLE CW-I-WP4-2023-05/HOLLANDSE KUST NOORD WIND PARK			SCALE 1:150
DRAWN SPS	CHECKED C. CARACCIOLO	APPROVED CGI	DATE 22/10/25
A1	DRAWING NO. 123A90-DDL-SAF-DL-30024	SHEET 001	REV. 04

File Name : 123A90-DDL-SAF-DL-30024 Rev.04