

DRAWING NO. 123A90-DDL-SAF-DL-30025

REV. 02

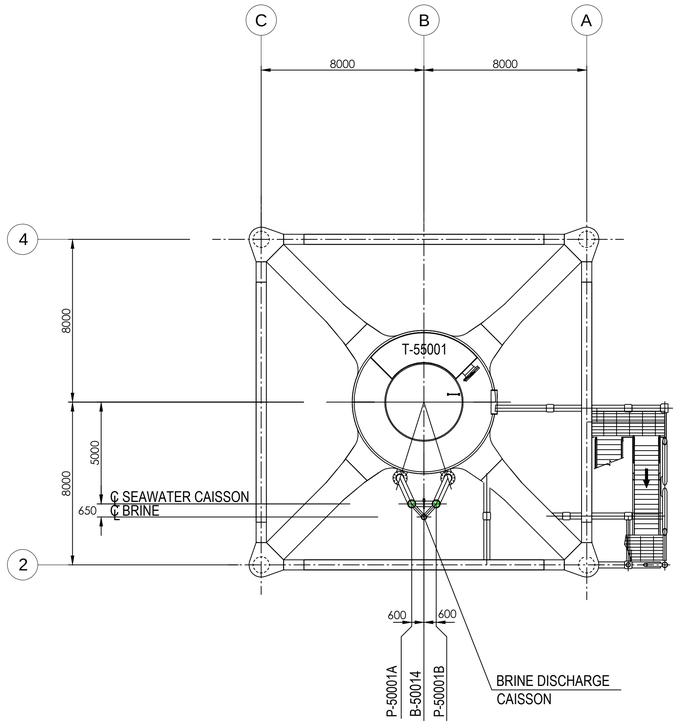



PLAN ON TRANSITION PIECE
EL+21.710 T.O.S.

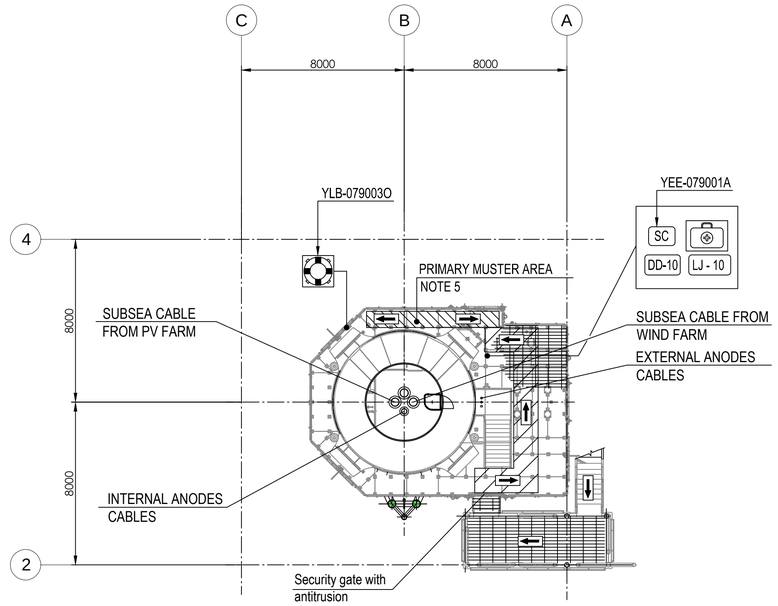

PLAN ON EXISTING
PLATFORM AT
EL+16.860 T.O.S.

SYMBOL	DESCRIPTION
	LIFE BUOY(FITTED WITH LIGHT, SMOKE SIGNAL & LIFELINE)
	FIRST AID KIT
LJ-XX	LIFE JACKET (INSIDE CABINET)
SC	SAFETY CABINET
DD	DESCENT DEVICE

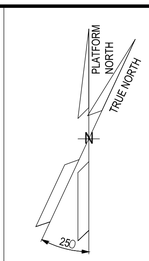

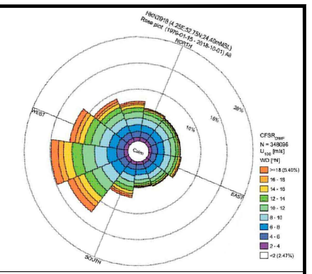

NOTES

1. ALL DIMENSIONS IN mm U.N.O
2. ALL ELEVATIONS IN METERS.
3. PRIMARY ESCAPE ROUTES SHALL BE MINIMUM 1.2m WIDTH AND 2.3m HEIGHT.
4. SECONDARY ESCAPE ROUTES SHALL BE MINIMUM 0.8m WIDTH AND 2.3m HEIGHT.
5. PRIMARY MUSTER AREA SHALL BE SIZED IN ORDER TO PROVIDE SUFFICIENT SPACE FOR THE MAXIMUM POB OF 10 ON THE PLATFORM, CONSIDERING AS MINIMUM 0.8 m^2 PER PERSON.
6. THE EVACUATION PHILOSOPHY IS AS FOLLOW:
   - PRIMARY MEANS OF EVACUATION - VIA PRIMARY MUSTER AREA,LOCATED AT PLATFORM ON TRANSITION PIECE THEN TO CREW TRANSFER VESSEL.
   - SECONADRY MEANS OF EVACUATION - VIA SECONDARY MUSTER AREA, LOCATED AT THE NORTH-EAST CORNER OF THE LOWER DECK, THEN TO LIFERAFTS.
7. ESCAPE MASKS, ELECTRICAL SAFETY KIT, RESUSCITATION UNIT, IMMERSION SUITS, LIFE JACKET AND FIRST AID KID TO BE LOCATED IN WEATHERPROOF CABINETS, AT STRATEGIC POSITIONS.
8. EACH LIFERAFT TO BE SIZED FOR MAXIMUM POB OF 10 PERSONS.
9. 2 NOS. OF PORTABLE CO2 EXTINGUISHERS TO BE LOCATED IN EACH ROOM (ITER, HV & LV ROOMS AND UPS ROOM).
10. EYEWASH BOTTLES TO BE PORTABLE AND CARRIED BY OPERATORS ONLY DURING MAINTENACE PERIOD.
11. ALL PORTABLE EXTINGUISHERS LOCATED IN OPEN AREA WILL BE EQUIPPED WITH A WEATHERPROOF CABINET.
12. LIFE RAFT ACCESS WILL BE GUARANTED BY MEANS OF DESCENT DEVICE.

LEGEND

PRIMARY ESCAPE ROUTE

SECONDARY ESCAPE ROUTE

HOLDS

REFERENCE DOCUMENTS

123A90-DDL-PP-DS-70071	PLOT PLAN - BELOW LOWER DECK

REV.	DATE	DRN	CHKD	APPD	DESCRIPTION
02	17/09/25	SPS	CCA	CGI	AS-BUILT (ASB)
01	10/07/24	MMA	CCA	DLO	ACCEPTED FOR CONSTRUCTION (AFC)
0	31/01/24	MMA	CCA	DLO	ISSUE FOR REVIEW (IFR)

CROSSWIND

ROSETTI MARINO

TITLE :
ESCAPE ROUTES, FIRE FIGHTING, LIFE SAVING EQUIPMENT AND SAFETY EQUIPMENT LAYOUTS DRAWINGS

CONTRACT NO./TITLE CW-I-WP4-2023-05/HOLLANDSE KUST NOORD WIND PARK			SCALE 1:150
DRAWN SPS	CHECKED C. CARACCIOLO	APPROVED CGI	DATE 15/09/25
A1	DRAWING NO. 123A90-DDL-SAF-DL-30025	SHEET 001	REV. 02

File Name : 123A90-DDL-SAF-DL-30025 Rev.02