

DRAWING NO. 123A90-DDL-SAF-DL-30028


REV. 02

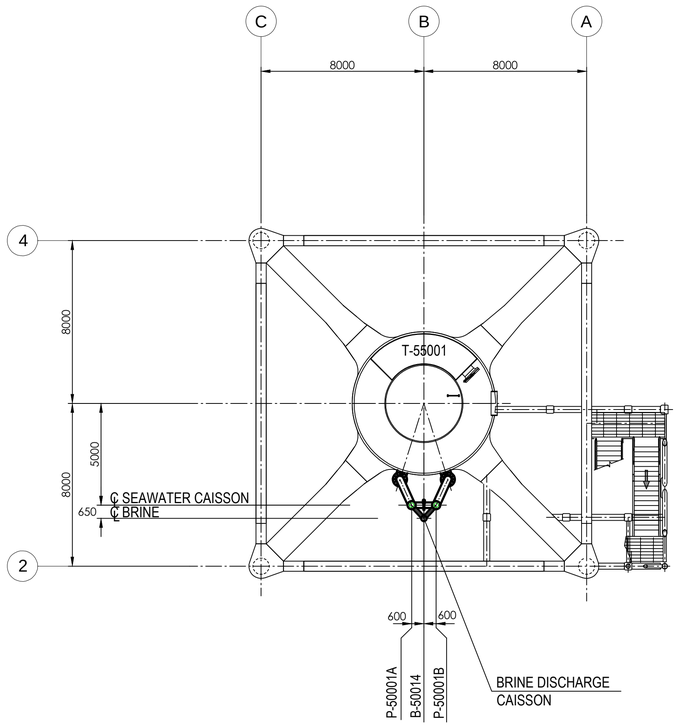

PLAN ON TRANSITION PIECE
EL+21.710 T.O.S.

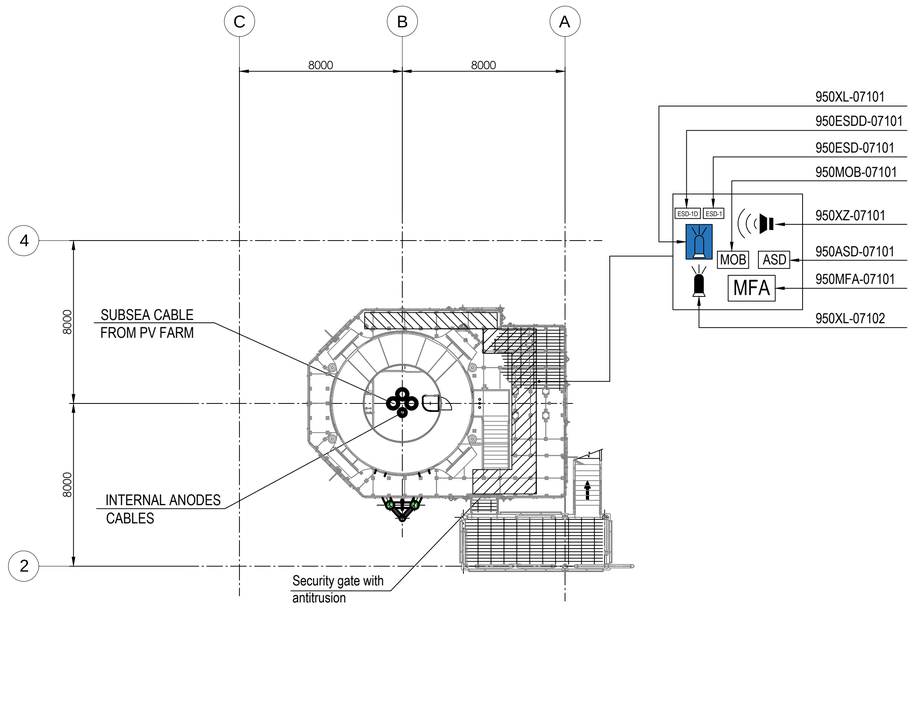

PLAN ON EXISTING
PLATFORM AT
EL+16.860 T.O.S.

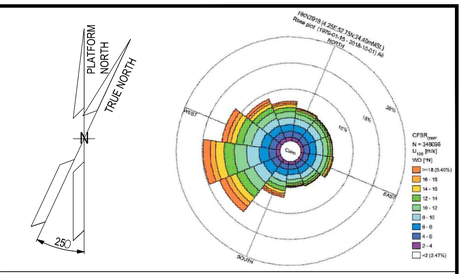

NOTES

1. ALL DIMENSIONS IN mm U.N.O
2. ALL ELEVATIONS IN METERS.
3. PERSONNEL EXPECTED TO USE HANDHELD HYDROGEN AND LOW OXYGEN DETECTORS WHEN WORKING IN CONFINED SPACES ENTRY.
4. DETAIL LOCATION IS SHOWN IN THE 3D MODEL.

ELEVATION
1. ALL BUTTONS ARE 1.5M TOP
2. SOUNDERS AND BEACONS ARE 2.4/2.5M

LEGEND

HOLDS

REFERENCE DOCUMENTS

123A90-DDL-PP-DS-70071	PLOT PLAN - BELOW LOWER DECK
123A90-DDL-SAP-RE-30020	FERA REPORT

EQUIPMENT LIST

TAG NUMBER	DESCRIPTION
P-50001A/B	SEAWATER LIFT PUMPS
T-55001	WASTE WATER TANK

SYMBOL	DESCRIPTION	QTY.	SYMBOL	DESCRIPTION	QTY.
	SOUNDER (XZ)	1		FIRE BEACON (XL)	1
MOB	MAN OVER BOARD (MOB)	1		FLAMMABLE GAS RELEASE BEACON (XL)	1
ASD	ABANDON SHUTDOWN (ASD)	1	ESD-1	ESD-1 PUSH BUTTON (ESD)	1
MFA	MANUAL FIRE ALARM (MFA)	1	ESD-1D	ESD-1D PUSH BUTTON (ESDD)	1

REV.	DATE	DRN	CHKD	APPD	DESCRIPTION
02	15/09/25	SPS	CCA	CGI	AS-BUILT (ASB)
01	10/07/24	MMA	CCA	DLO	ACCEPTED FOR CONSTRUCTION (AFC)
00	12/02/24	MMA	CCA	DLO	ISSUE FOR APPROVAL (IFA)

CROSSWIND

ROSETTI MARINO

TITLE :

F & G DETECTORS LAYOUT - BELOW LOWER DECK

CONTRACT NO./TITLE CW-I-WP4-2023-05/HOLLANDSE KUST NOORD WIND PARK | SCALE 1:150

DRAWN SPS | CHECKED C. CARACCIOLO | APPROVED CGI | DATE 15/09/25

A1 | DRAWING NO. 123A90-DDL-SAF-DL-30028 | SHEET 001 | REV. 02

File Name : 123A90-DDL-SAF-DL-30028 Rev.02