

DRAWING NO. 123A90-DDL-SAF-DL-30029


REV. 02

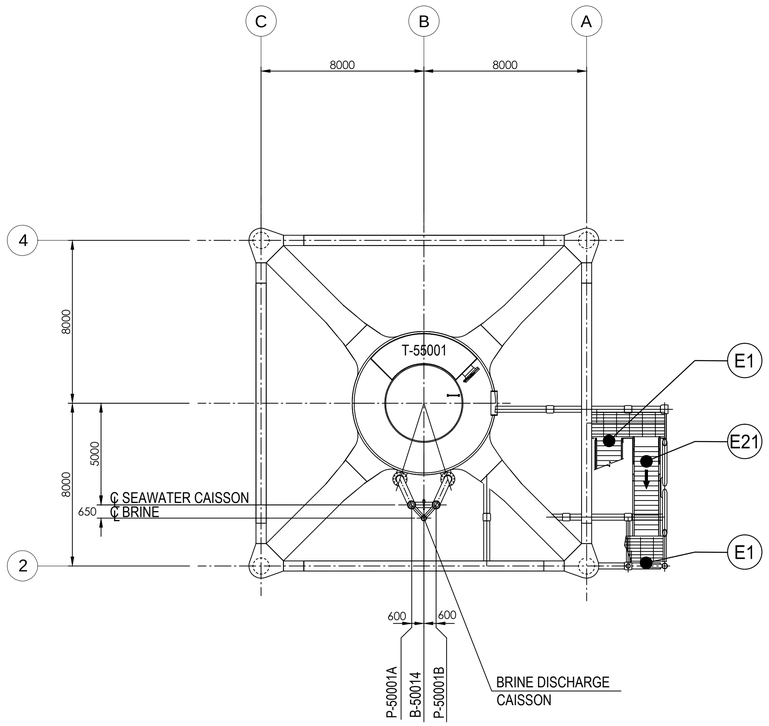

PLAN ON TRANSITION PIECE
EL+21.710 T.O.S.

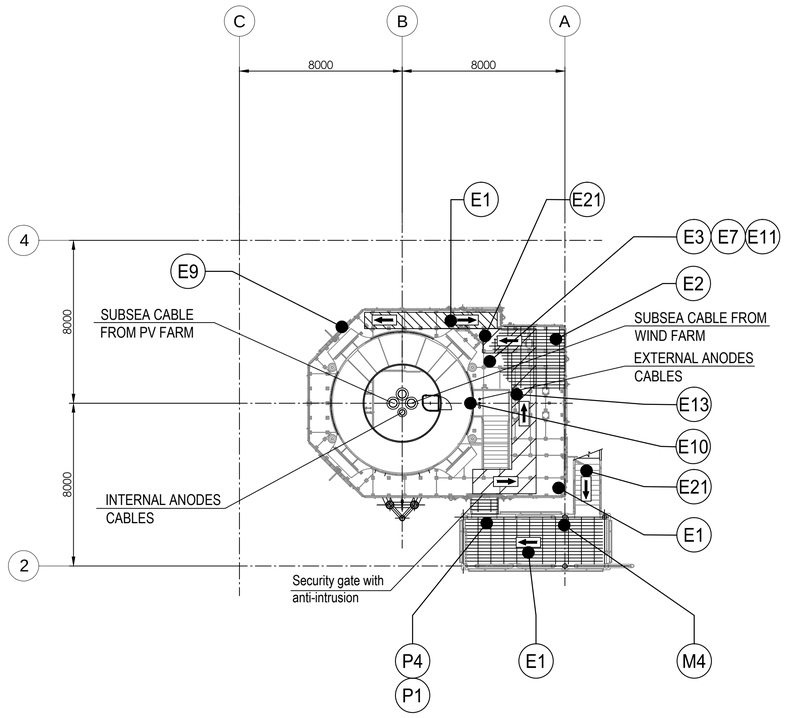

PLAN ON EXISTING
PLATFORM AT
EL+16.860 T.O.S.

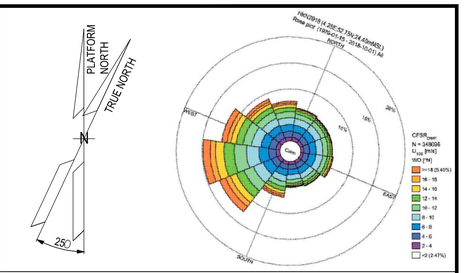

LEGEND

SIMB	DESCRIPTION	Q.ty
E1	ESCAPE ROUTE DIRECTION ARROW (STRAIGHT)	5
E21	ESCAPE ROUTE DIRECTION ARROW (LEFT/RIGHT)	3
E2	MUSTER POINT	1
E3	SAFETY CABINET	1
E6	RESUSCITATION UNIT	–
E7	FIRST AID KIT	1
E8	ESCAPE MASK	–
E9	LIFE BUOYS	1
E10	EMERGENCY EXIT	1
E11	LIFE JACKET BOX	1
E12	STRETCHER	–
E13	EMERGENCY PUSH BUTTON	1
E14	LIFE RAFT	–
E20	EYE WASH STATION (BOTTLES)	–
F1	FIRE EXTINGUISHER CO2	–
F2	FIRE EXTINGUISHER POWDER	
M4	WEAR SAFETY VEST	1
P1	OPEN FLAME AND SMOKING PROHIBITED	1
P2	ACCESS ALLOWED ONLY WITH PTW	–
P4	ACCESS FOR UNAUTHORIZED PERSONS PROHIBITED	1
W1	ATTENTION SUSPENDED LOAD	–
W2	ELECTRICAL HAZARD	–

NOTES

HOLDS

REFERENCE DOCUMENTS

123A90-DDL-PP-DS-70071	PLOT PLAN - BELOW LOWER DECK
123A90-DDL-SAF-DL-30025	ESCAPE ROUTES, FIRE FIGHTING, LIFE SAVING EQUIPMENT AND SAFETY EQUIPMENT LAYOUTS DRAWINGS

REV.	DATE	DRN	CHKD	APPD	DESCRIPTION
02	15/09/25	SPS	CCA	CGI	AS-BUILT (ASB)
01	21/11/24	ECA	CCA	DLO	ACCEPTED FOR CONSTRUCTION (AFC)
0	02/10/24	ECA	CCA	DLO	ISSUE FOR REVIEW (IFR)

CROSSWIND

ROSETTI MARINO

TITLE :

SAFETY SIGN
EQUIPMENT LAYOUT DRAWINGS

CONTRACT NO./TITLE CW-I-WP4-2023-05/HOLLANDSE KUST NOORD WIND PARK			SCALE 1:150
DRAWN SPS	CHECKED C. CARACCIOLO	APPROVED CGI	DATE 15/09/25
A1	DRAWING NO. 123A90-DDL-SAF-DL-30029	SHEET 001	REV. 02

File Name : 123A90-DDL-SAF-DL-30029_02