


DRAWING NO. 123A90-DDL-ST-DA-90055

REV. 04

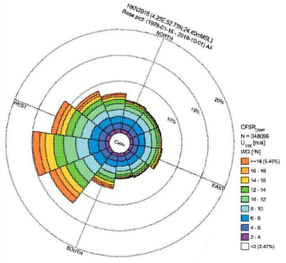


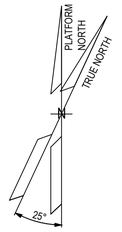

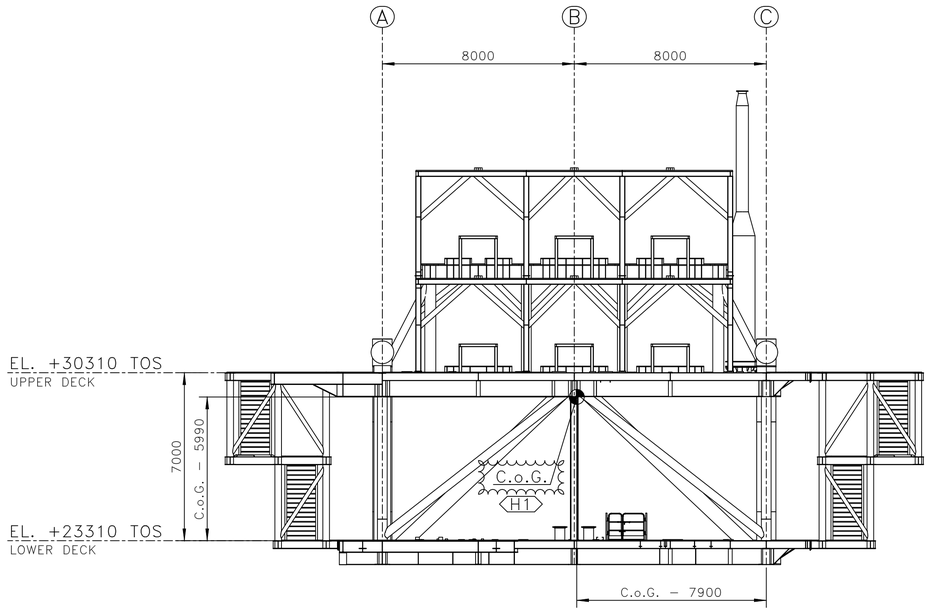

TOPSIDE – TRANSVERSAL VIEW
SCALE 1:125

TOPSIDE EXPECTED WEIGHT = 1802 t
(CONTINGENCY INCLUDED)

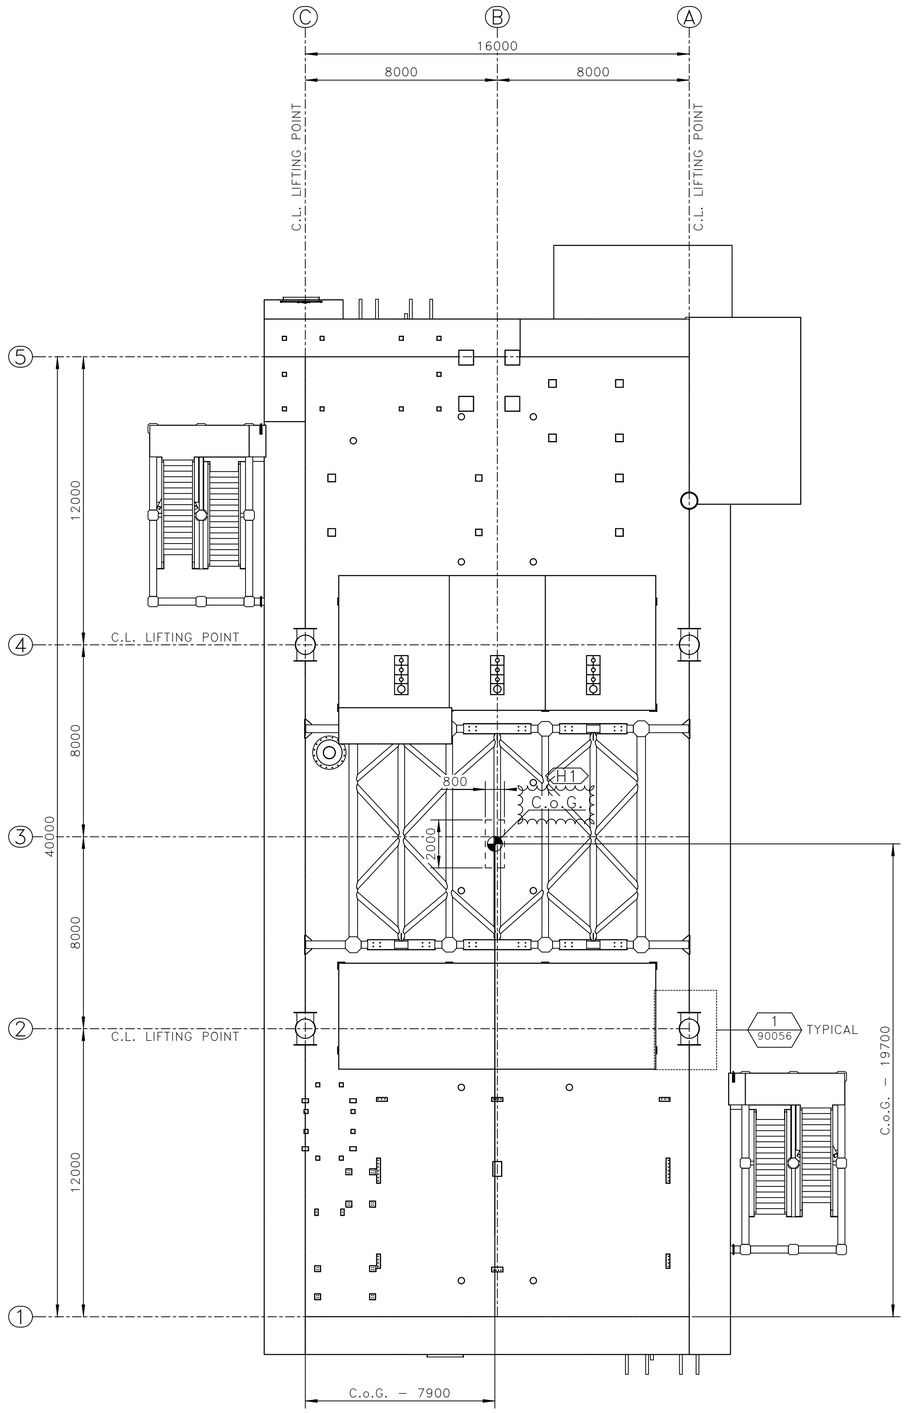

TOPSIDE – PLAN VIEW
SCALE 1:125

NOTES

1 – ALL DIMENSIONS AND ELEVATIONS ARE IN MILLIMETERS U.N.O.
2 – ALL ELEVATIONS ARE REFERED TO C.D.
3 – WEIGHT MONTLY REPORT – JULY 2024

MATERIALS

HOLDS

1 – C.o.G: POSITION
DRAWING WILL BE UPDATED AFTER PHYSICALLY WEIGHING.

REFERENCE DRAWINGS

DWG No.	DESCRIPTION
123A90-DDL-ST-DD-90025	DRAWING LIST
123A90-DDL-ST-DD-90026	GENERAL NOTES
123A90-DDL-ST-DD-90056	TOPSIDE – LIFTING POINTS – DETAILS

REV.	DATE	DRN	CHKD	APPD	DESCRIPTION
04	25/09/25	SPS	AB	CGI	AS-BUILT (ASB)
03	24/09/24	SGR	AB	DLS	ACCEPTED FOR CONSTRUCTION (AFC)
02	25/03/24	SGR	AB	DLS	ACCEPTED FOR CONSTRUCTION (AFC)
01	22/02/24	SGR	AB	DLS	ACCEPTED FOR CONSTRUCTION (AFC)
00	23/10/23	SGR	AB	DLS	ISSUE FOR REVIEW (IFR)

TECON

CROSSWIND

ROSETTI MARINO

TITLE :
BASE LOAD POWER HUB (BLPH)
TOPSIDE – LIFTING POINTS
GENERAL ARRANGEMENT

CONTRACT NO./TITLE CW-I-WP4-2023-05/HOLLANDSE KUST NOORD WIND PARK | SCALE 1:125

DRAWN SPS | CHECKED A.BALZAROTTI | APPROVED CGI | DATE 25/09/25

A1 | DRAWING NO. 123A90-DDL-ST-DA-90055 | SHEET 001 | REV. 04

File Name : 123A90-DDL-ST-DA-90055_04.dwg