

DRAWING NO. 123A90-DDL-ST-DD-90035


REV. 02

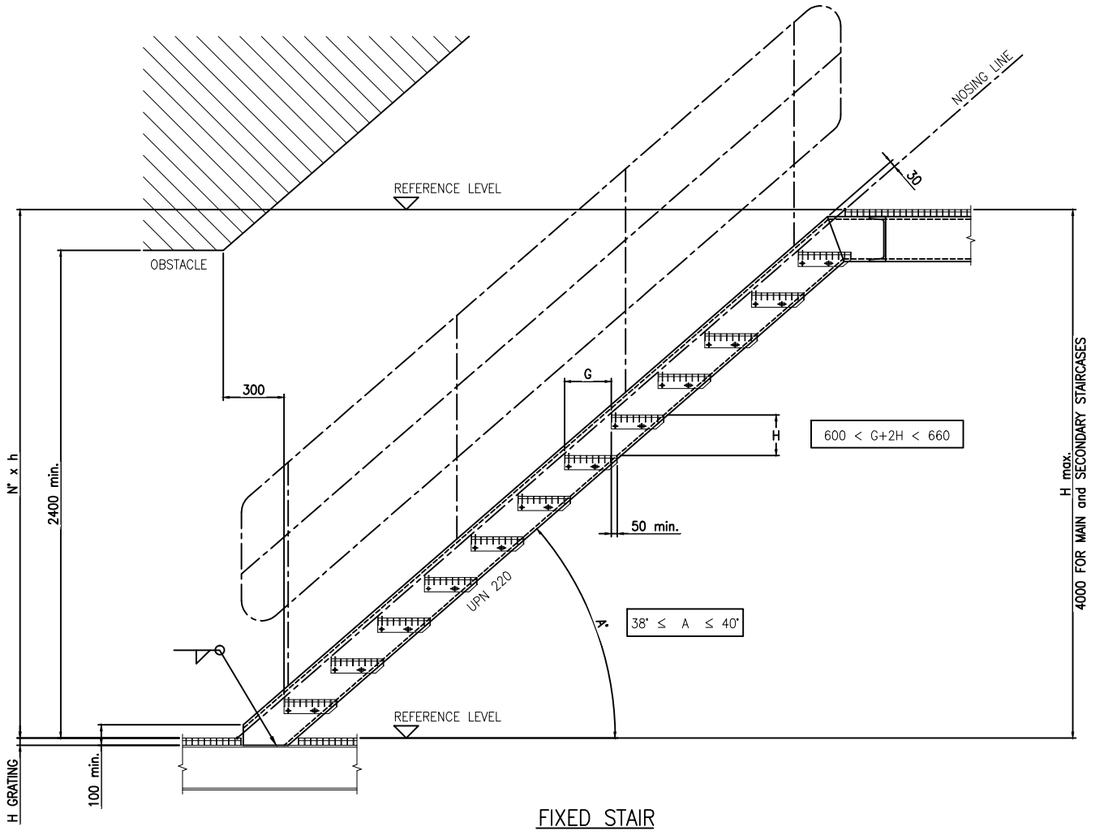


FIXED STAIR

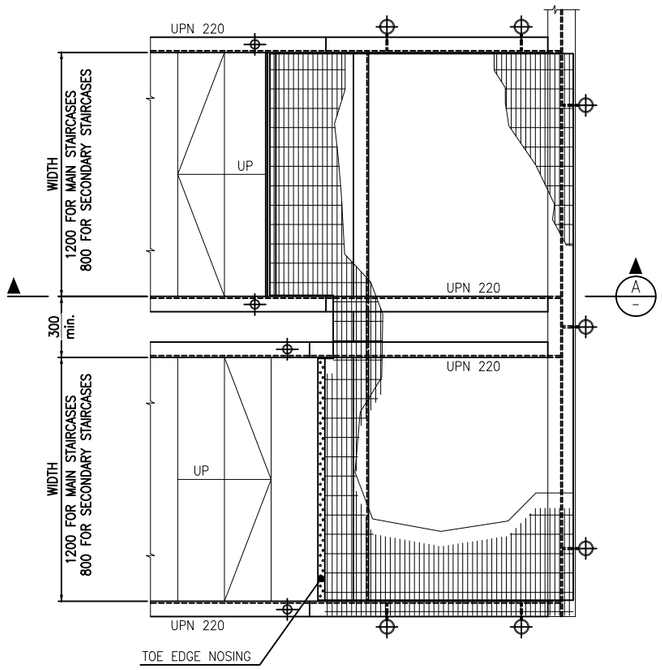

INTERMEDIATE LANDING – TYPICAL

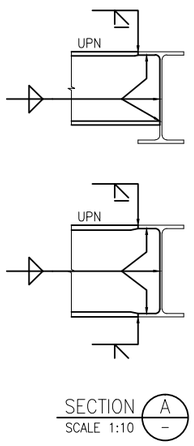


SECTION A
SCALE 1:10

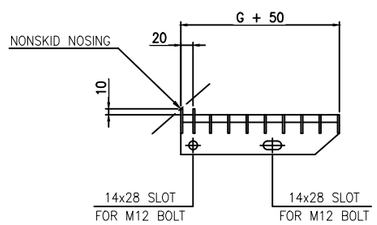


STEP GRATING – TYPICAL SECTION
GRATING MESH 30x50 – BEARING PLATE 30x5
FOR WIDTH SEE STAIR AND WALKWAY DRAWINGS


TYPICAL STRINGER CONNECTIONS

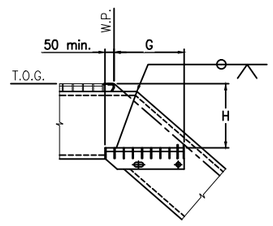


TOP CONNECTION FOR GRTG

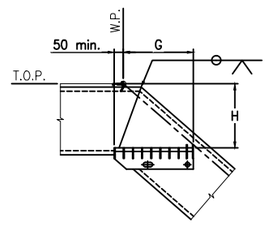


TOP CONNECTION FOR PLTG

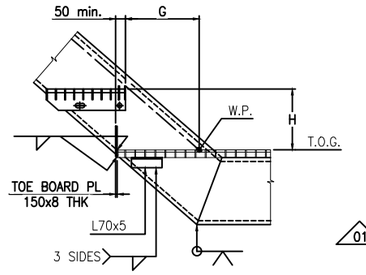


BOTTOM CONNECTION FOR GRTG

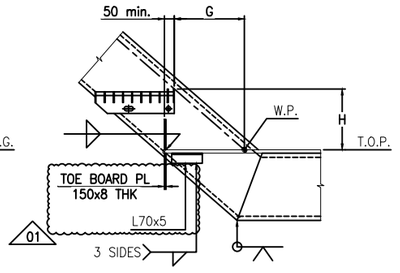

BOTTOM CONNECTION FOR PLTG

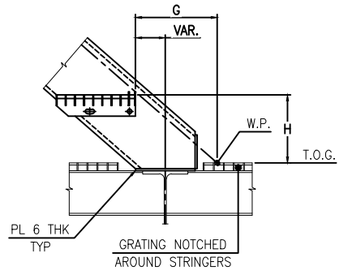

BOTTOM CONNECTION FOR GRTG

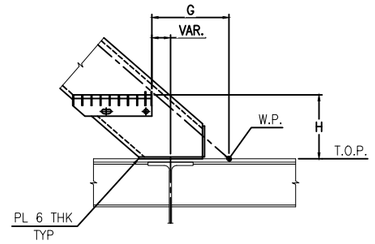

BOTTOM CONNECTION FOR PLTG

NOTES:

1 – ALL DIMENSIONS ARE IN mm (U.N.O.)
2 – ALL FILLET WELDS SHALL BE CONTINUOUS AND THE LEG SIZE SHALL BE EQUAL 0.7 THE MINIMUM THICKNESS TO BE JOINTED U.N.O.

TECON

REV.	DATE	DRN	CHKD	APPD	DESCRIPTION
02	22/09/25	SPS	AB	CGI	AS-BUILT (ASB)
01	31/01/24	SGR	AB	DLS	ACCEPTED FOR CONSTRUCTION (AFC)
00	13/10/23	SGR	AB	DLS	ISSUE FOR REVIEW (IFR)

CROSSWIND

ROSETTI MARINO

TITLE :
BASE LOAD POWER HUB (BLPH)
STANDARD DRAWINGS
STAIRWAYS

CONTRACT NO./TITLE CW-I-WP4-2023-05/HOLLANDSE KUST NOORD WIND PARK | SCALE 1:15

DRAWN SPS | CHECKED A.BALZAROTTI | APPROVED CGI | DATE 22/09/25

A1 | DRAWING NO. 123A90-DDL-ST-DD-90035 | SHEET 001 | REV. 02

File Name : 123A90-DDL-ST-DD-90035 REV.02.dwg