

DRAWING NO. 123A90-DDL-ST-DD-90040

REV. 03

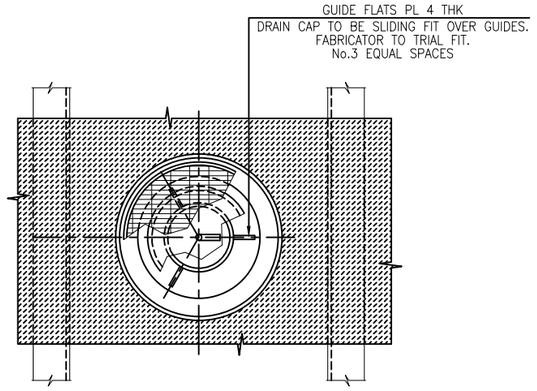

DRAIN SYSTEM
TOPSIDE

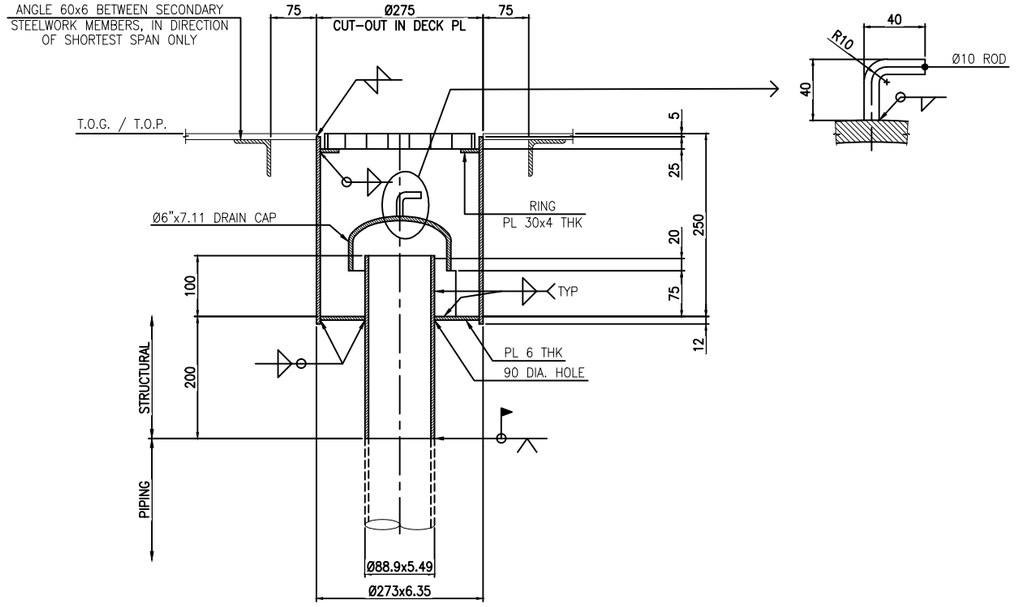

NOTES:

1 – ALL DIMENSIONS ARE IN mm (U.N.O.)
2 – ALL THE DRAINS BOXES HAVE THE SAME PAINTING CYCLE OF THE STRUCTURAL TOPSIDE, COATING SYSTEM 123A90-DDL-MAT-SP-60006 (NORSOK M-501).

TECON

REV.	DATE	DRN	CHKD	APPD	DESCRIPTION
03	22/09/25	SPS	AB	CGI	AS-BUILT (ASB)
02	22/08/24	SGR	AB	DLS	ACCEPTED FOR CONSTRUCTION (AFC)
01	31/01/24	SGR	AB	DLS	ISSUED FOR APPROVAL (IFA)
00	13/10/23	SGR	AB	DLS	ISSUE FOR REVIEW (IFR)

CROSSWIND

ROSETTI MARINO

TITLE :
BASE LOAD POWER HUB (BLPH)
STANDARD DRAWINGS
DRAIN SYSTEM TYPICAL DETAILS

CONTRACT NO./TITLE	CW-I-WP4-2023-05/HOLLANDSE KUST NOORD WIND PARK			SCALE 1:5
DRAWN SPS	CHECKED A.BALZAROTTI	APPROVED CGI		DATE 22/09/25
A1	DRAWING NO. 123A90-DDL-ST-DD-90040		SHEET 001	REV. 03

File Name : 123A90-DDL-ST-DD-90040 REV.03.dwg