

DRAWING NO. 123A90-DDL-ST-DD-90049


REV. 03

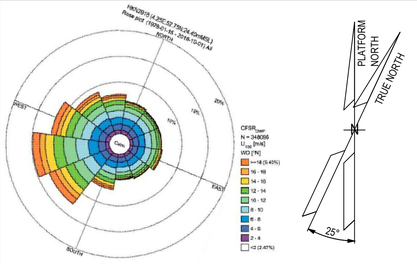

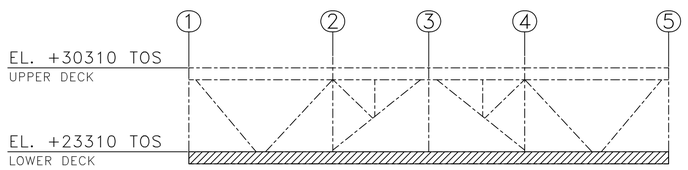


KEY ELEVATION

SCALE 1:250

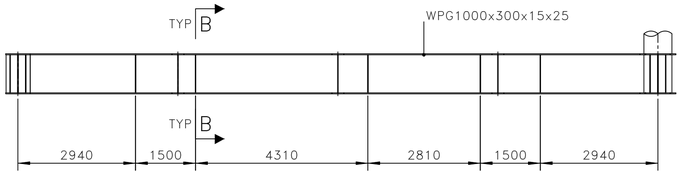


SECTION A – A

SCALE 1:75

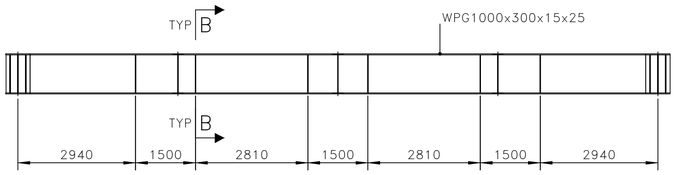


SECTION C – C

SCALE 1:75

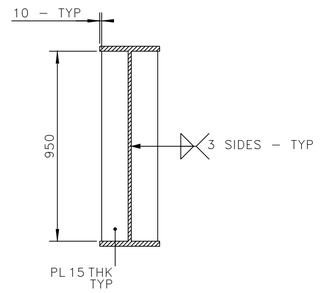

SECTION B – B

SCALE 1:15

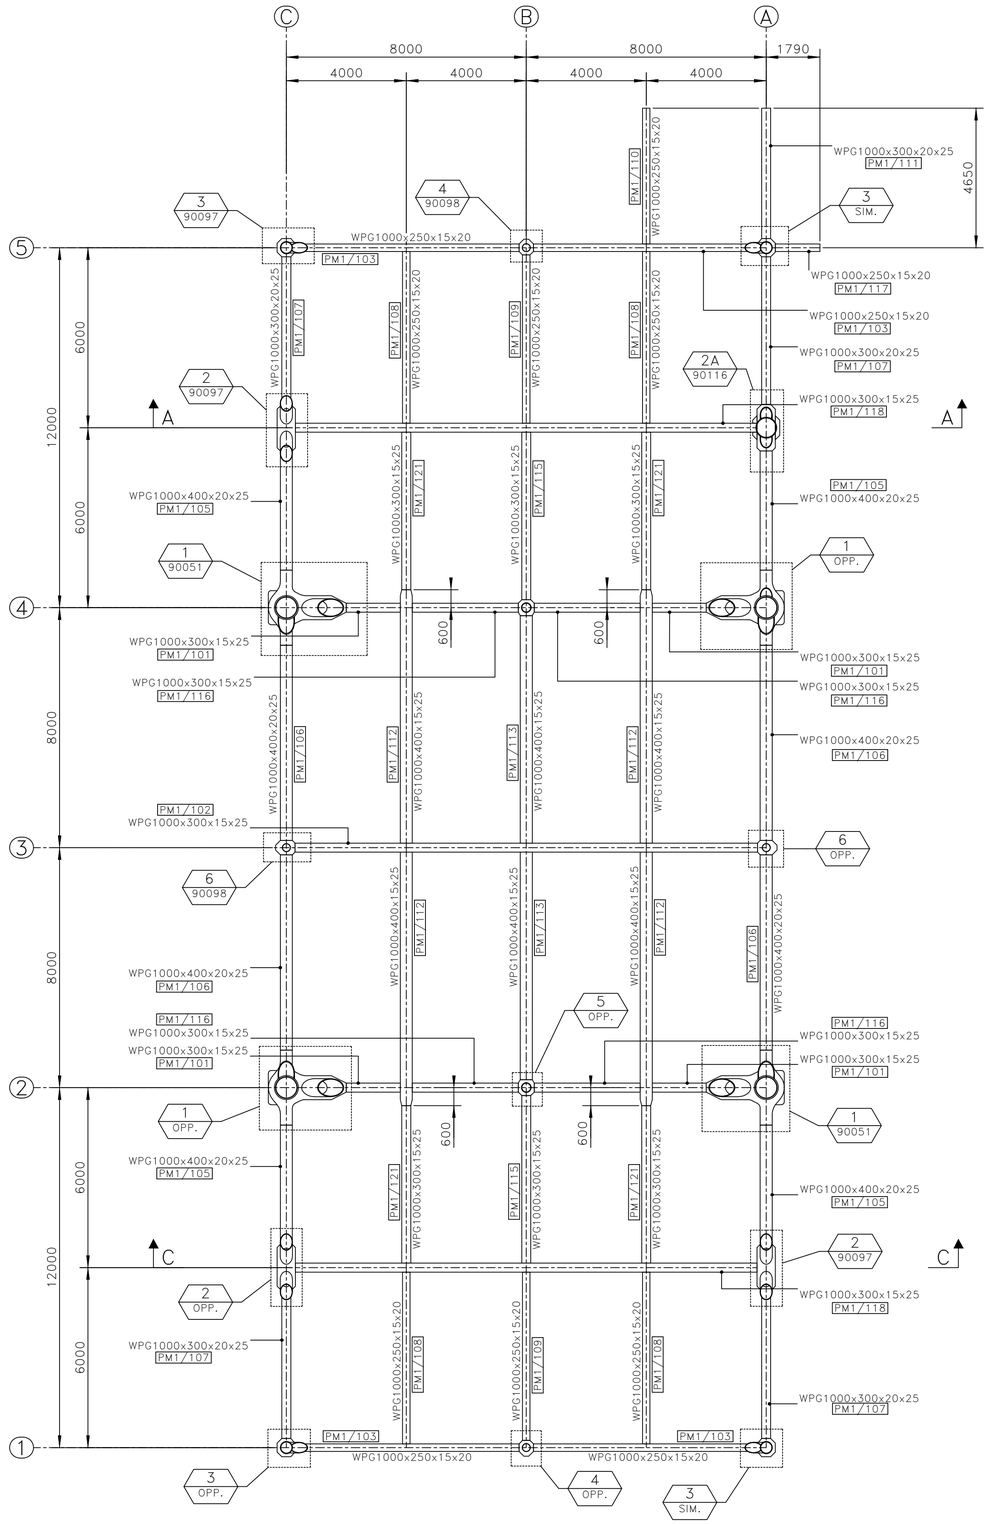

PLAN AT EL.+23310 T.O.S.

SCALE 1:100

NOTES

1 – ALL DIMENSIONS AND ELEVATIONS ARE IN MILLIMETERS U.N.O.
2 – ALL ELEVATIONS ARE REFERED TO C.D.
3 – ALL BEAMS CONNECTIONS TO BE TYPE "04" FOR BEAMS WITH EQUAL HEIGHT U.N.O.

MATERIALS

ITEM IDENTIFICATION	MATERIAL DESIGNATION
WPG1000x250x15x20	DC2–II–420–20
WPG1000x300x15x25	DC2–II–420–20
WPG1000x300x20x25	DC2–II–420–20
WPG1000x400x15x25	DC2–II–420–20
WPG1000x400x20x25	DC2–II–420–20

HOLDS

REFERENCE DRAWINGS

DWG No.	DESCRIPTION
123A90-DDL-ST-DD-90025	DRAWING LIST
123A90-DDL-ST-DD-90026	GENERAL NOTES
123A90-DDL-ST-DD-90027	WELDING GENERAL NOTES
123A90-DDL-ST-DD-90034	TYPICAL BEAM CONNECTIONS

REV.	DATE	DRN	CHKD	APPD	DESCRIPTION
04	22/09/25	SPS	AB	CGI	AS-BUILT (ASB)
03	25/03/24	SGR	AB	DLS	ACCEPTED FOR CONSTRUCTION (AFC)
02	15/02/24	SGR	AB	DLS	ACCEPTED FOR CONSTRUCTION (AFC)
01	20/12/23	SGR	AB	DLS	ACCEPTED FOR CONSTRUCTION (AFC)
00	23/10/23	SGR	AB	DLS	ISSUE FOR REVIEW (IFR)

TECON

CROSSWIND

ROSETTI MARINO

TITLE :

BASE LOAD POWER HUB (BLPH)
TOPSIDE – PRIMARY STEEL
PLAN AT EL. +23310 T.O.S.

CONTRACT NO./TITLE CW-I-WP4-2023-05/HOLLANDSE KUST NOORD WIND PARK | SCALE 1:100

DRAWN SPS | CHECKED A.BALZAROTTI | APPROVED CGI | DATE 22/09/25

A1 | DRAWING NO. 123A90-DDL-ST-DD-90049 | SHEET 001 | REV. 04

File Name : 123A90-DDL-ST-DD-90049_04.dwg