



KEY ELEVATION

SCALE 1:250

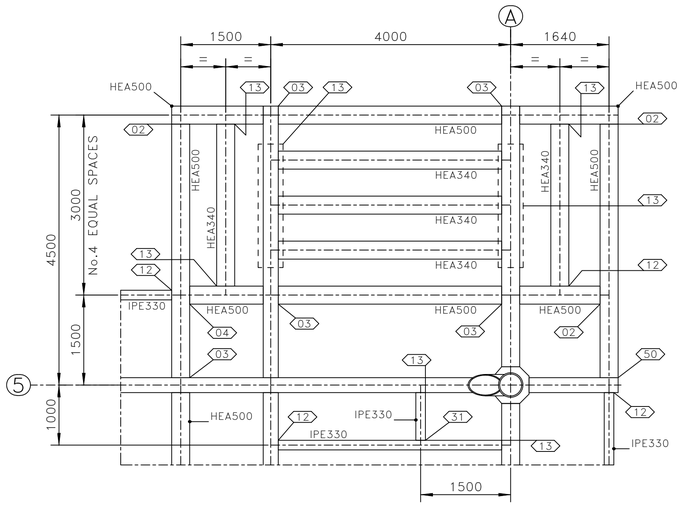

1 DETAIL

SCALE 1:50

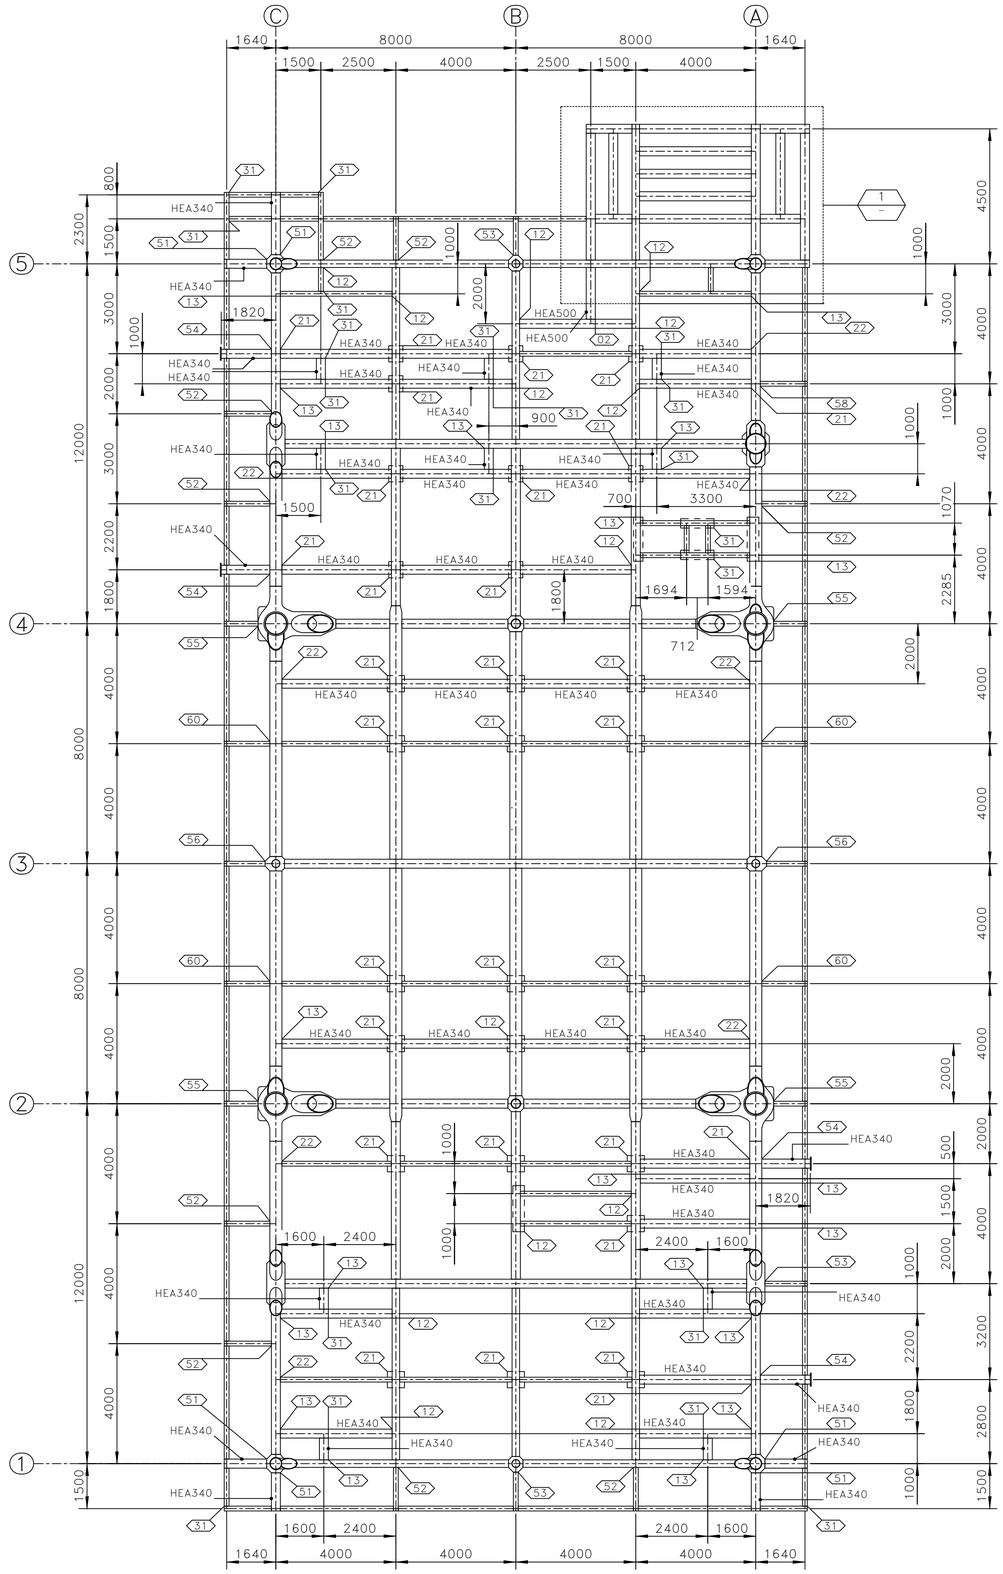

PLAN AT EL.+23310 TOS

ALL BEAMS ARE IPE330 U.N.O. – ALL CONNECTIONS ARE 30 U.N.O.

SCALE 1:100

NOTES

1 – ALL DIMENSIONS AND ELEVATIONS ARE IN MILLIMETERS U.N.O.
2 – ALL ELEVATIONS ARE REFERED TO C.D.
3 – ALL OTHER SECONDARY BEAMS ARE SHOWN IN THE DWG. No. 123A90-DDL-ST-DD-90104
4 – ALL STIFFENER MATERIALS ARE DC3-II-355-0 or 20 U.N.O.

MATERIALS

ITEM IDENTIFICATION	MATERIAL DESIGNATION
IPE330	DC3-II-355-0
HEA340	DC3-II-355-20
HEA500	DC3-II-355-20

HOLDS

REFERENCE DRAWINGS

DWG No.	DESCRIPTION
123A90-DDL-ST-DD-90025	DRAWING LIST
123A90-DDL-ST-DD-90026	GENERAL NOTES
123A90-DDL-ST-DD-90027	WELDING GENERAL NOTES
123A90-DDL-ST-DD-90034	TYPICAL BEAM CONNECTIONS
123A90-DDL-ST-DD-90049	PRIMARY STEEL – PLAN AT EL +23310 TOS
123A90-DDL-ST-DD-90102	SEC. JOINTS – JOINT –50, 51, 52, 53, 54, 58 & 60–
123A90-DDL-ST-DD-90103	SEC. JOINTS – JOINT –55, 56, 57 & 59–
123A90-DDL-ST-DD-90104	SEC. STEEL – PLAN AT EL +23310 TOS – SH. 2

REV.	DATE	DRN	CHKD	APPD	DESCRIPTION
03	22/09/25	SPS	AB	CGI	AS-BUILT (ASB)
02	16/09/24	SGR	AB	DLS	ACCEPTED FOR CONSTRUCTION (AFC)
01	23/05/24	SGR	AB	DLS	ACCEPTED FOR CONSTRUCTION (AFC)
00	01/12/23	SGR	AB	DLS	ISSUE FOR REVIEW (IFR)

TECON

CROSSWIND

ROSETTI MARINO

TITLE :

BASE LOAD POWER HUB (BLPH)
TOPSIDE – SECONDARY STEEL
PLAN AT EL. +23310 T.O.S. – SHEET 1

CONTRACT NO./TITLE CW-I-WP4-2023-05/HOLLANDSE KUST NOORD WIND PARK | SCALE 1:100

DRAWN SPS | CHECKED A.BALZAROTTI | APPROVED CGI | DATE 22/09/25

A1 | DRAWING NO. 123A90-DDL-ST-DD-90057 | SHEET 001 | REV. 03

DRAWING NO. 123A90-DDL-ST-DD-90057 REV. 03

File Name : 123A90-DDL-ST-DD-90057_03.dwg