


DRAWING NO. 123A90-DDL-ST-DD-90058 REV. 03

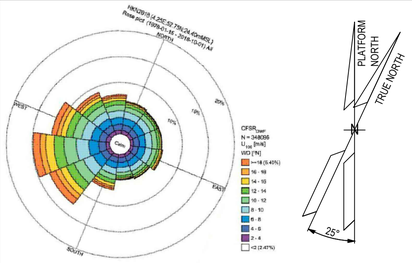

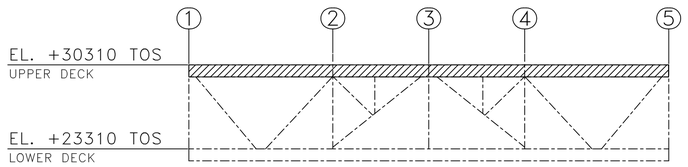


KEY ELEVATION

SCALE 1:250

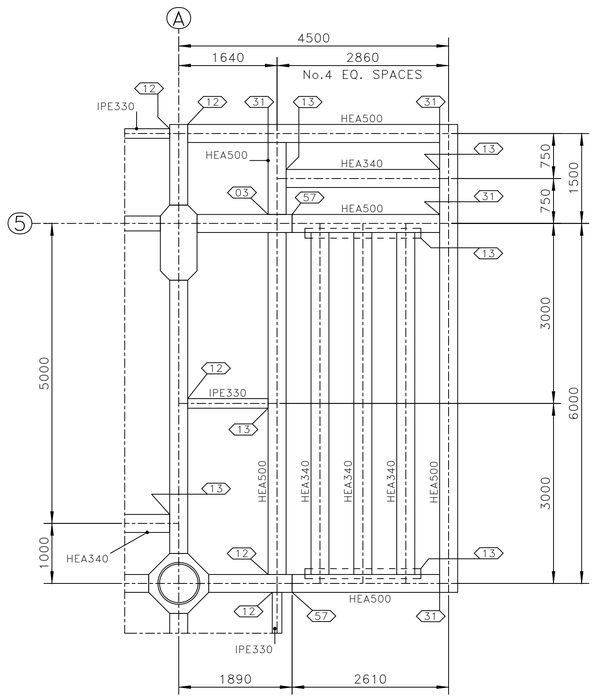

1 DETAIL

– SCALE 1:50

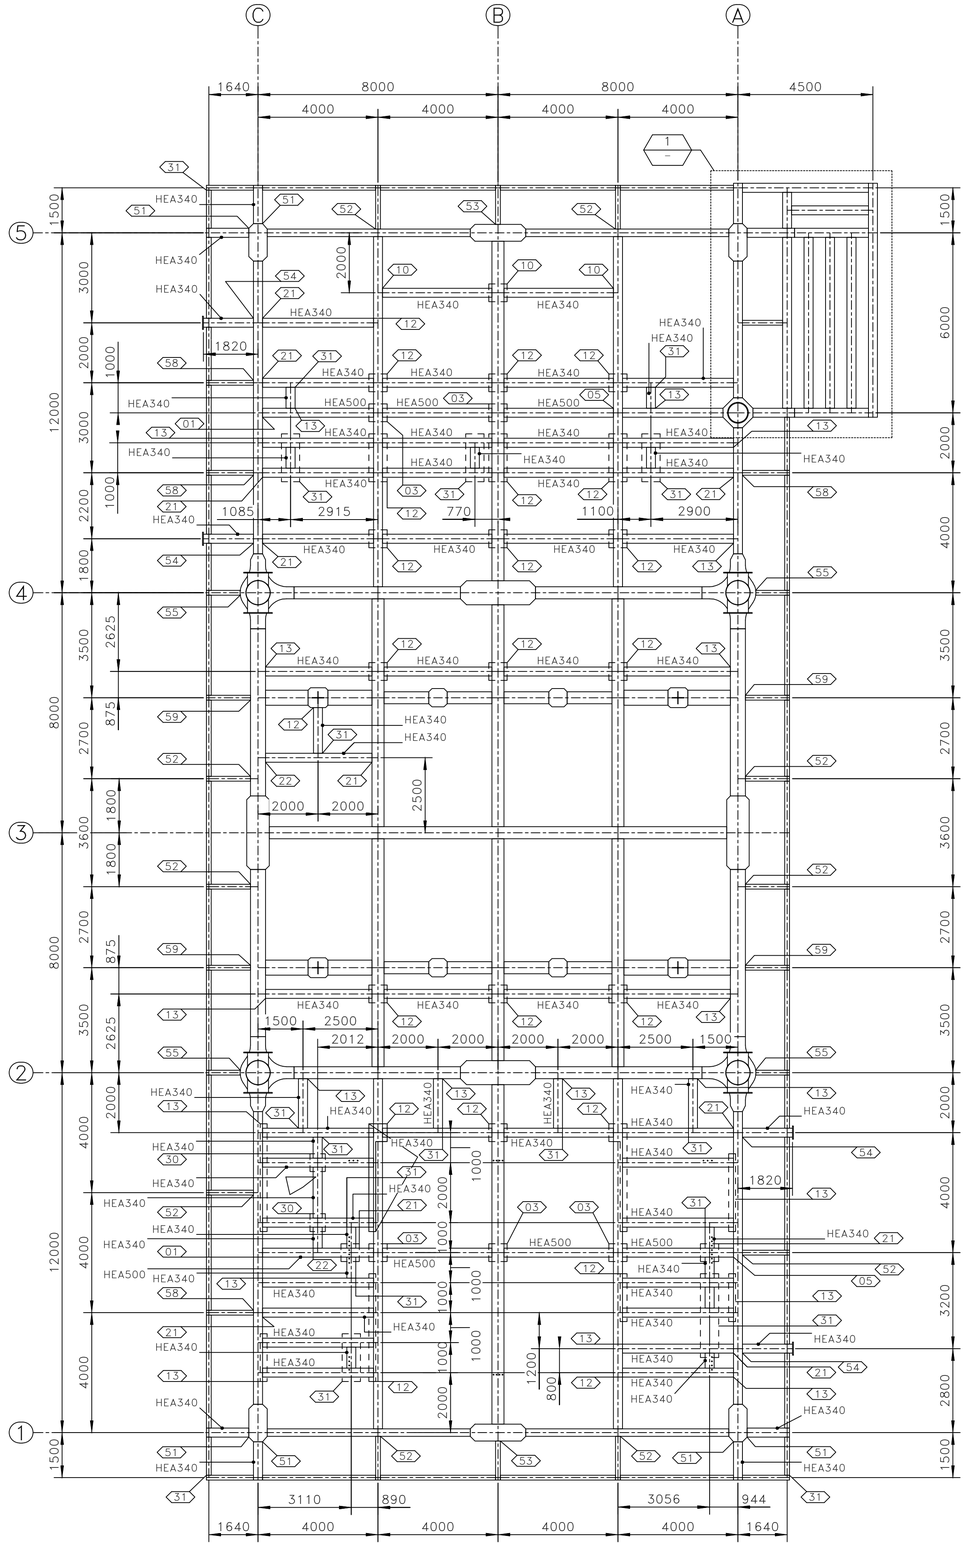

PLAN AT EL.+30310 TOS

ALL BEAMS ARE IPE330 U.N.O. – ALL CONNECTIONS ARE ⟨30⟩ U.N.O.

SCALE 1:100

NOTES

1 – ALL DIMENSIONS AND ELEVATIONS ARE IN MILLIMETERS U.N.O.
2 – ALL ELEVATIONS ARE REFERED TO C.D.
3 – ALL OTHER SECONDARY BEAMS ARE SHOWN IN THE DWG. No. 123A90-DDL-ST-DD-90105
4 – ALL STIFFENER MATERIALS ARE DC3-II-355-0 or 20 U.N.O.

MATERIALS

ITEM IDENTIFICATION	MATERIAL DESIGNATION
IPE330	DC3-II-355-0
HEA340	DC3-II-355-20
HEA500	DC3-II-355-20

HOLDS

REFERENCE DRAWINGS

DWG No.	DESCRIPTION
123A90-DDL-ST-DD-90025	DRAWING LIST
123A90-DDL-ST-DD-90026	GENERAL NOTES
123A90-DDL-ST-DD-90027	WELDING GENERAL NOTES
123A90-DDL-ST-DD-90034	TYPICAL BEAM CONNECTIONS
123A90-DDL-ST-DD-90050	PRIMARY STEEL – PLAN AT EL +30310 TOS
123A90-DDL-ST-DD-90102	SEC. JOINTS – JOINT –50, 51, 52, 53, 54, 58 & 60–
123A90-DDL-ST-DD-90103	SEC. JOINTS – JOINT –55, 56, 57 & 59–
123A90-DDL-ST-DD-90105	SEC. STEEL – PLAN AT EL +30310 TOS – SH. 2

TECON

REV.	DATE	DRN	CHKD	APPD	DESCRIPTION
03	22/09/25	SPS	AB	CGI	AS-BUILT (ASB)
02	16/09/24	SGR	AB	DLS	ACCEPTED FOR CONSTRUCTION (AFC)
01	23/05/24	SGR	AB	DLS	ACCEPTED FOR CONSTRUCTION (AFC)
00	01/12/23	SGR	AB	DLS	ISSUE FOR REVIEW (IFR)

CROSSWIND

ROSETTI MARINO

TITLE :

BASE LOAD POWER HUB (BLPH)
TOPSIDE – SECONDARY STEEL
PLAN AT EL. +30310 T.O.S. – SHEET 1

CONTRACT NO./TITLE CW-I-WP4-2023-05/HOLLANDSE KUST NOORD WIND PARK			SCALE 1:100
DRAWN SPS	CHECKED A.BALZAROTTI	APPROVED CGI	DATE 22/09/25

A1	DRAWING NO. 123A90-DDL-ST-DD-90058	SHEET 001	REV. 03

File Name : 123A90-DDL-ST-DD-90058_03.dwg