


DRAWING NO. 123A90-DDL-ST-DD-90063

REV. 02

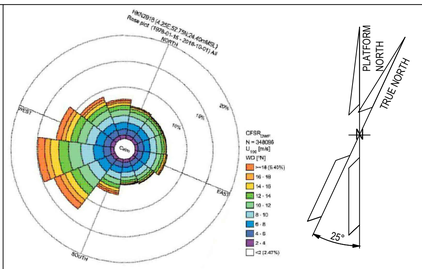


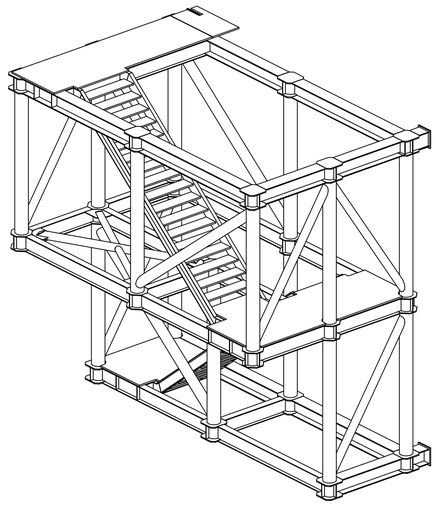

TOPSIDE STAIR – NORTH SIDE
3D VIEW

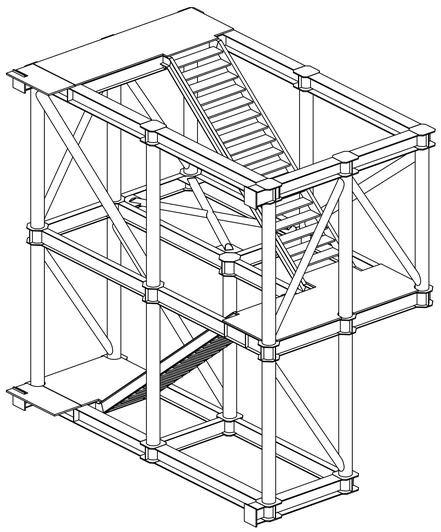

TOPSIDE STAIR – SOUTH SIDE
3D VIEW

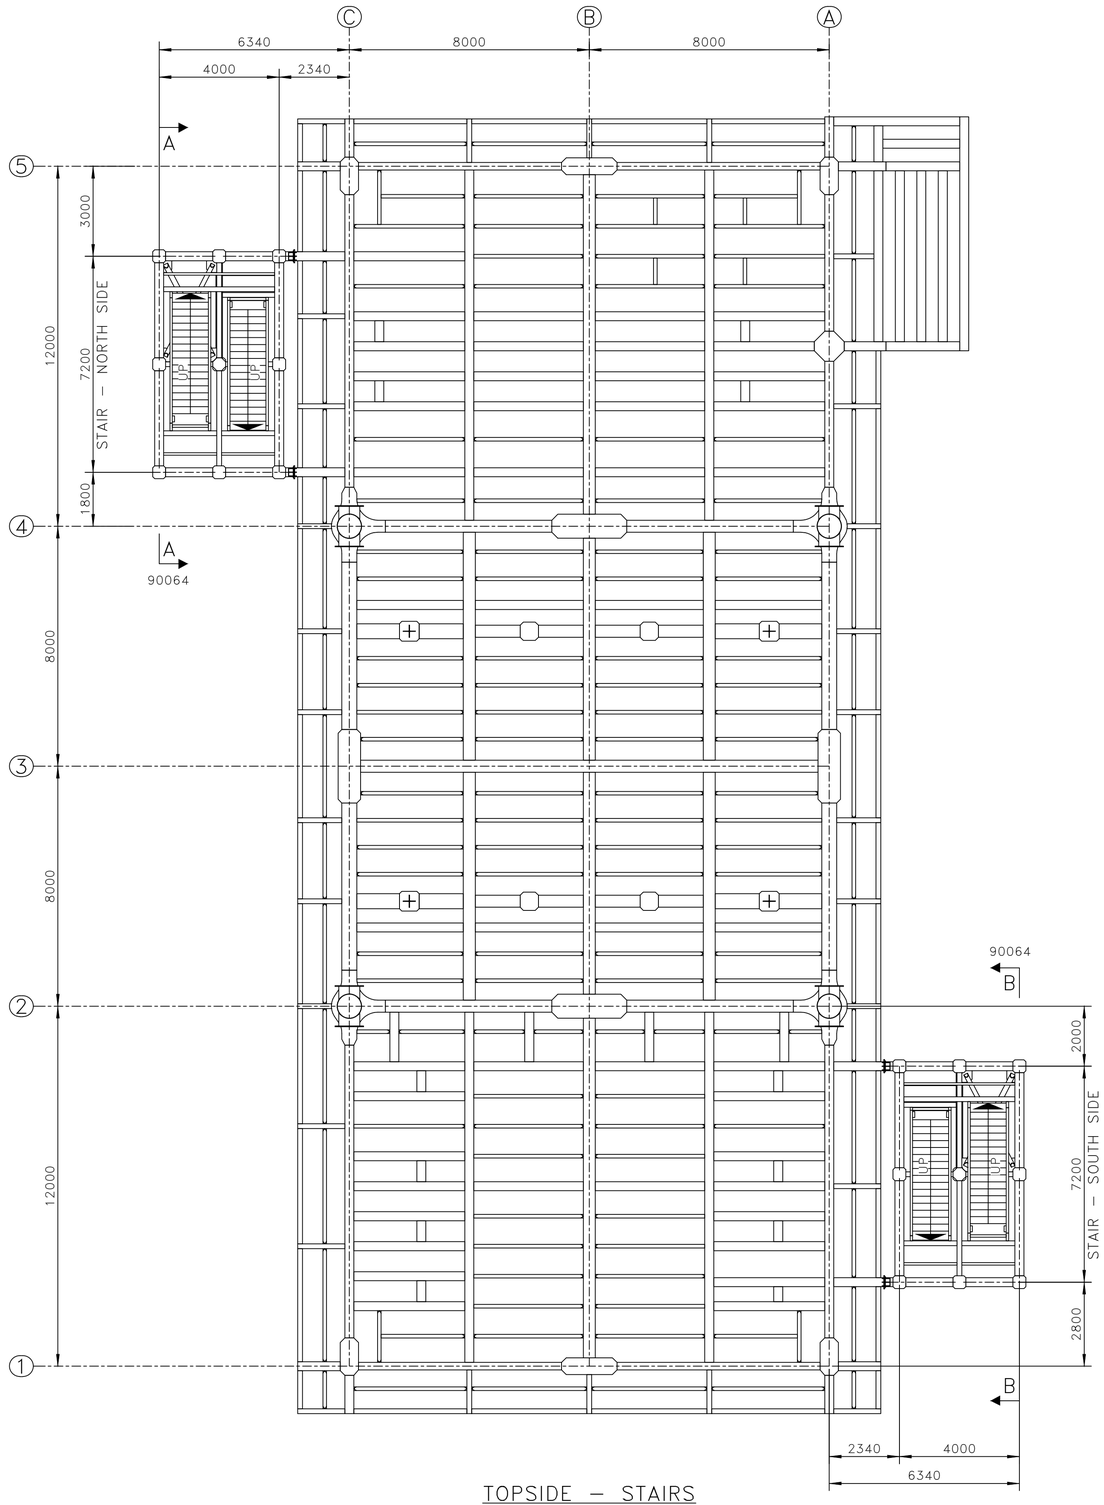

TOPSIDE – STAIRS
PLAN VIEW
SCALE 1:100

NOTES

1 – ALL DIMENSIONS AND ELEVATIONS ARE IN MILLIMETERS U.N.O.
2 – ALL ELEVATIONS ARE REFERED TO C.D.

MATERIALS

HOLDS

REFERENCE DRAWINGS

DWG No.	DESCRIPTION
123A90-DDL-ST-DD-90025	DRAWING LIST
123A90-DDL-ST-DD-90026	GENERAL NOTES
123A90-DDL-ST-DD-90064	TOPSIDE – WALKWAYS & STAIRS – ELEVATIONS

TECON

REV.	DATE	DRN	CHKD	APPD	DESCRIPTION
02	22/09/25	SPS	AB	CGI	AS-BUILT (ASB)
01	25/03/24	SGR	AB	DLS	ACCEPTED FOR CONSTRUCTION (AFC)
00	30/01/24	SGR	AB	DLS	ISSUE FOR REVIEW (IFR)

CROSSWIND

ROSETTI MARINO

TITLE :
BASE LOAD POWER HUB (BLPH)
TOPSIDE – WALKWAYS & STAIRS
ASSEMBLY

CONTRACT NO./TITLE CW-I-WP4-2023-05/HOLLANDSE KUST NOORD WIND PARK | SCALE 1:100

DRAWN SPS | CHECKED A.BALZAROTTI | APPROVED CGI | DATE 22/09/25

A1 | DRAWING NO. 123A90-DDL-ST-DD-90063 | SHEET 001 | REV. 02

File Name : 123A90-DDL-ST-DD-90063_02.dwg