

DRAWING NO. 123A90-DDL-ST-DD-90064 REV. 02

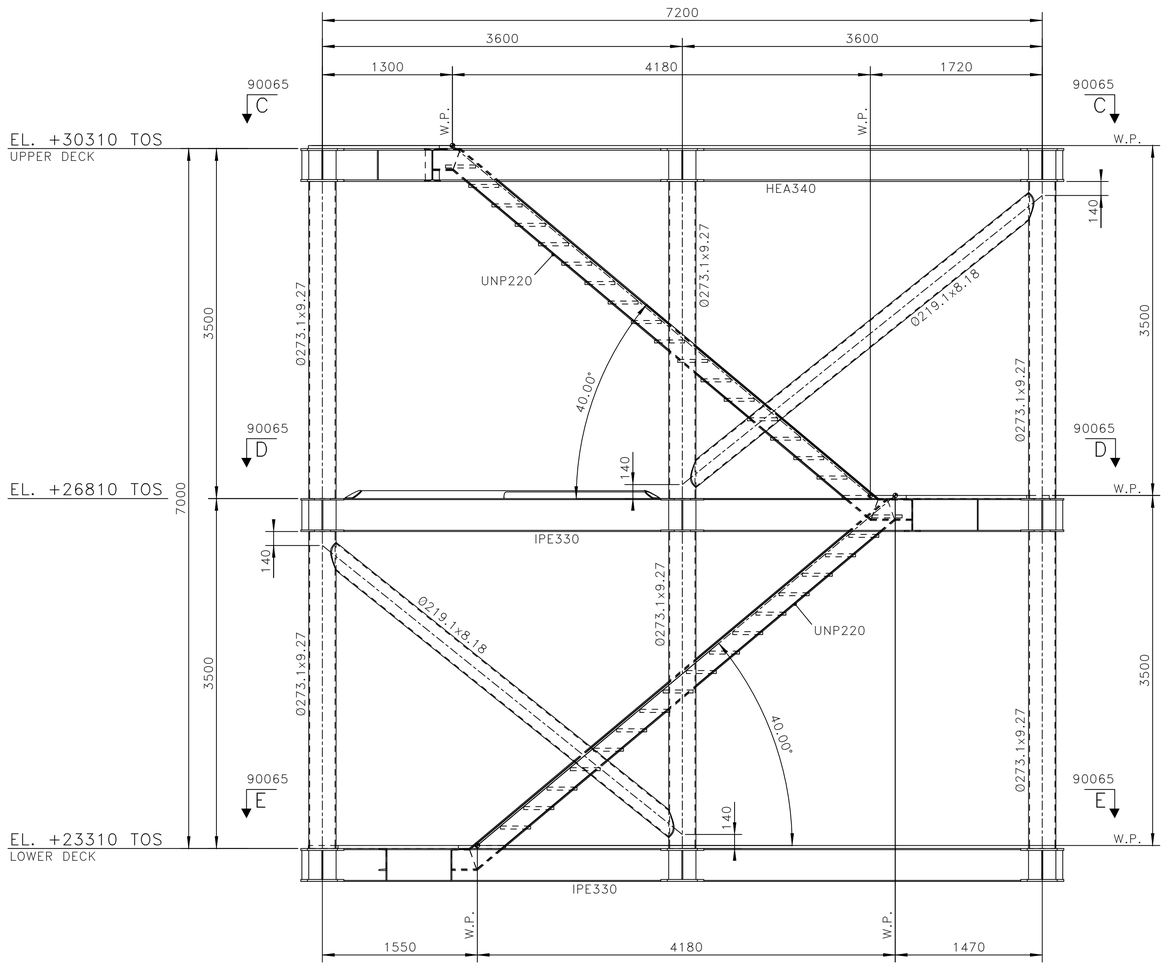

SECTION A – A
123A90-DDL-ST-DD-90063
SCALE 1:30

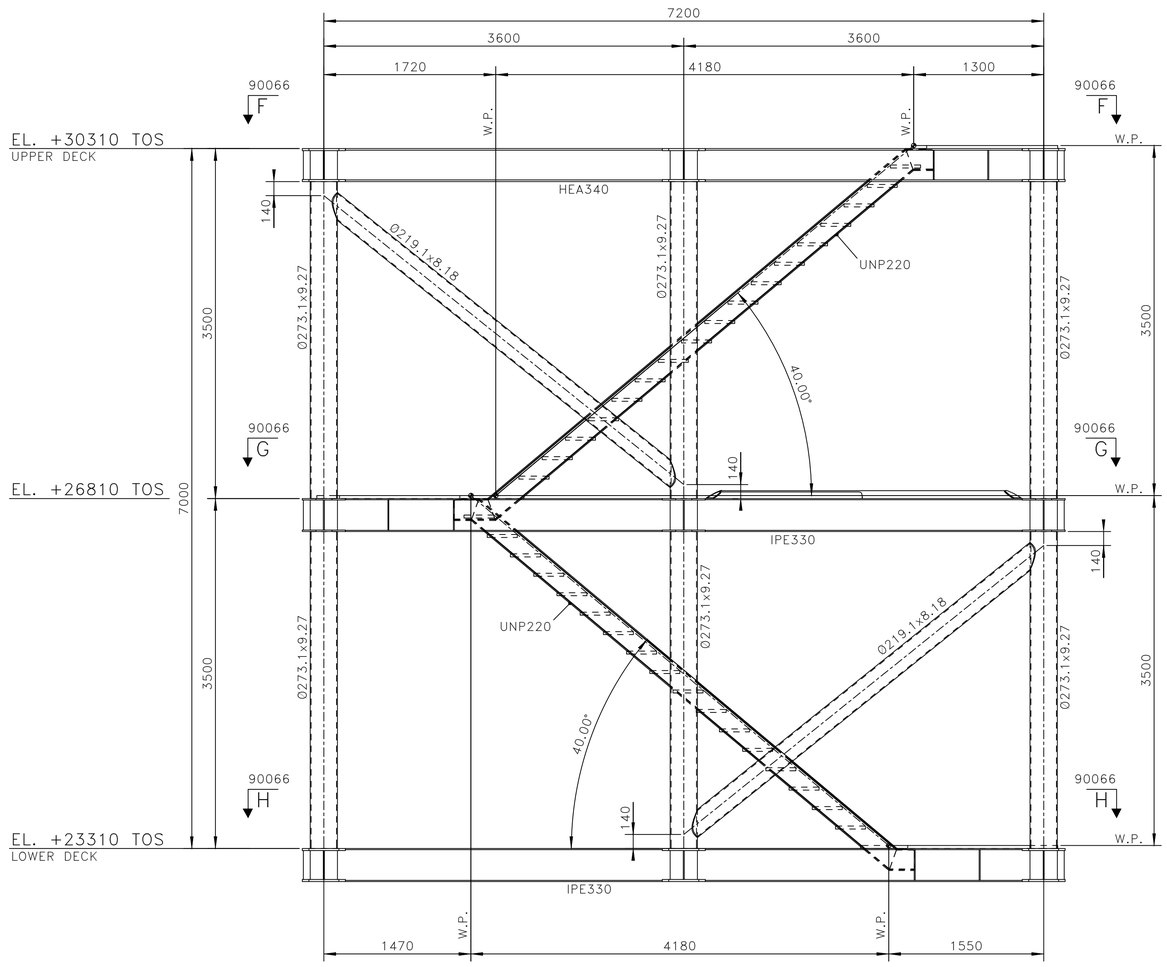

SECTION B – B
123A90-DDL-ST-DD-90063
SCALE 1:30

NOTES

1 – ALL DIMENSIONS AND ELEVATIONS ARE IN MILLIMETERS U.N.O.
2 – ALL ELEVATIONS ARE REFERED TO C.D.
3 – ALL WELDS ARE FULL PENETRATION WELDS U.N.O.

MATERIALS

ITEM IDENTIFICATION	MATERIAL DESIGNATION
Ø219.1x8.18	DC4-III-X52-0
Ø273.1x9.27	DC4-III-X52-0
UNP220	DC5-IV-275-10

HOLDS

REFERENCE DRAWINGS

DWG No.	DESCRIPTION
123A90-DDL-ST-DD-90025	DRAWING LIST
123A90-DDL-ST-DD-90026	GENERAL NOTES
123A90-DDL-ST-DD-90027	WELDING GENERAL NOTES
123A90-DDL-ST-DD-90029	TUBULAR JOINTS – STANDARD WELDING DETAILS
123A90-DDL-ST-DD-90035	STANDARD DRAWINGS – STAIRWAYS
123A90-DDL-ST-DD-90037	STANDARD DRAWINGS – HANDRAILS
123A90-DDL-ST-DD-90063	TOPSIDE – WALKWAYS & STAIRS – ASSEMBLY
123A90-DDL-ST-DD-90065	TOPSIDE – WALKWAYS & STAIRS – NORTH SIDE – PLANS
123A90-DDL-ST-DD-90066	TOPSIDE – WALKWAYS & STAIRS – SOUTH SIDE – PLANS

TECON

REV.	DATE	DRN	CHKD	APPD	DESCRIPTION
02	22/09/25	SPS	AB	CGI	AS-BUILT (ASB)
01	25/03/24	SGR	AB	DLS	ACCEPTED FOR CONSTRUCTION (AFC)
00	30/01/24	SGR	AB	DLS	ISSUE FOR REVIEW (IFR)

CROSSWIND

ROSETTI MARINO

TITLE :
BASE LOAD POWER HUB (BLPH)
TOPSIDE – WALKWAYS & STAIRS
ELEVATIONS

CONTRACT NO./TITLE CW-I-WP4-2023-05/HOLLANDSE KUST NOORD WIND PARK | SCALE 1:30

DRAWN SPS | CHECKED A.BALZAROTTI | APPROVED CGI | DATE 22/09/25

A1 | DRAWING NO. 123A90-DDL-ST-DD-90064 | SHEET 001 | REV. 02

File Name : 123A90-DDL-ST-DD-90064_02.dwg