


DRAWING NO. 123A90-DDL-ST-DD-90071

REV. 04

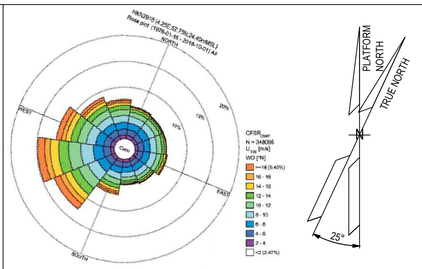

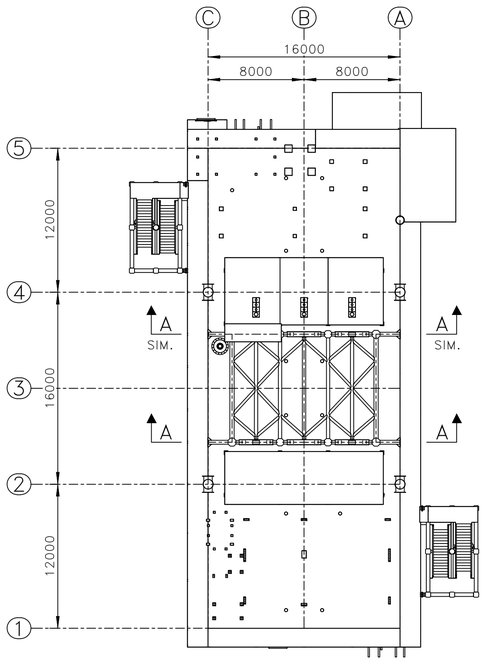

TOPSIDE – PLAN AT EL.+34810 T.O.S.
SCALE 1:250

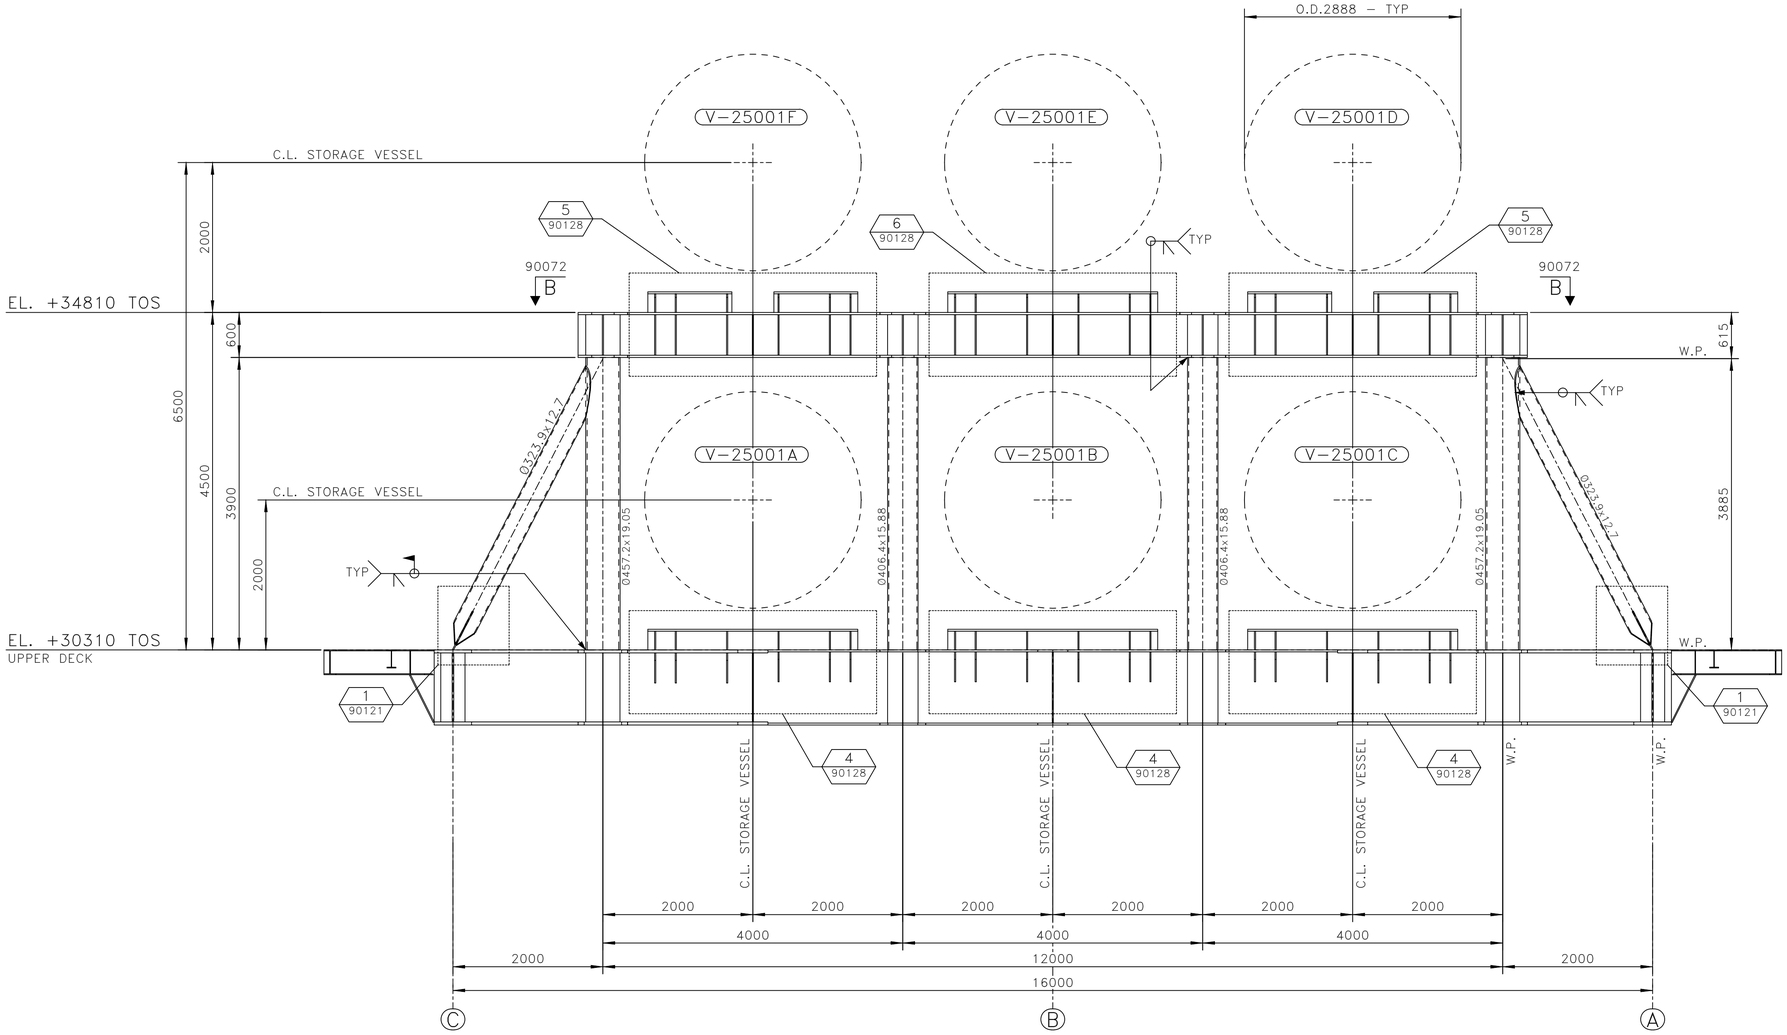

SECTION A – A
SCALE 1:40

NOTES

1 – ALL DIMENSIONS AND ELEVATIONS ARE IN MILLIMETERS U.N.O.
2 – ALL ELEVATIONS ARE REFERED TO C.D.
3 – ALL WELDS ARE FULL PENETRATION WELDS U.N.O.
4 – ALL FILLET WELDS SHALL BE CONTINUOUS AND THE LEG SIZE SHALL BE EQUAL 0.7 THE MINIMUM THICKNESS TO BE JOINTED U.N.O.
5 – ALL GROOVE WELDS SHALL BE WELDED FROM BOTH SIDES UNLESS IMPRATICAL.

MATERIALS

ITEM IDENTIFICATION	MATERIAL DESIGNATION
0406.4x15.88	DC3-II-X52-20
0457.2x19.05	DC3-II-X52-20
0323.9x12.7	DC4-III-X52-0

HOLDS

REFERENCE DRAWINGS

DWG No.	DESCRIPTION
123A90-DDL-ST-DD-90025	DRAWING LIST
123A90-DDL-ST-DD-90026	GENERAL NOTES
123A90-DDL-ST-DD-90027	WELDING GENERAL NOTES
123A90-DDL-ST-DD-90032	PLATES – DOUBLE SIDED WELDS
123A90-DDL-ST-DD-90033	PLATES – SINGLE SIDED WELDS
123A90-DDL-ST-DD-90050	PRIMARY STEEL – PLAN AT EL. +30310 TOS
123A90-DDL-ST-DD-90072	STORAGE VESSEL – PRIMARY STEEL – SECTIONS
123A90-DDL-ST-DD-90114	PRIMARY JOINTS – UPPER DECK – JOINT 16 & 17
123A90-DDL-ST-DD-90121	STORAGE VESSEL – PRIMARY STEEL – SEC. & DET.

TECON

REV.	DATE	DRN	CHKD	APPD	DESCRIPTION
04	22/09/25	SPS	AB	CGI	AS-BUILT (ASB)
03	11/03/25	SGR	AB	DLS	ACCEPTED FOR CONSTRUCTION (AFC)
02	12/12/24	SGR	AB	DLS	ACCEPTED FOR CONSTRUCTION (AFC)
01	22/08/24	SGR	AB	DLS	ACCEPTED FOR CONSTRUCTION (AFC)
00	17/05/24	SGR	AB	DLS	ISSUE FOR REVIEW (IFR)

CROSSWIND

ROSETTI MARINO

TITLE :
BASE LOAD POWER HUB (BLPH)
STORAGE VESSEL – PRIMARY STEEL
ASSEMBLY

CONTRACT NO./TITLE CW-I-WP4-2023-05/HOLLANDSE KUST NOORD WIND PARK | SCALE 1:40

DRAWN SPS | CHECKED A.BALZAROTTI | APPROVED CGI | DATE 22/09/25

A1 | DRAWING NO. 123A90-DDL-ST-DD-90071 | SHEET 001 | REV. 04

File Name : 123A90-DDL-ST-DD-90071_04.dwg