


DRAWING NO. 123A90-DDL-ST-DD-90075

REV. 02

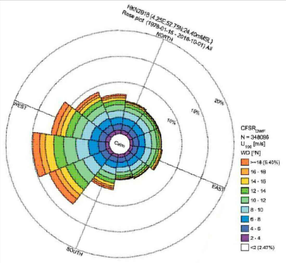


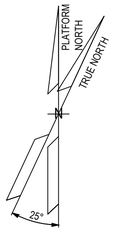

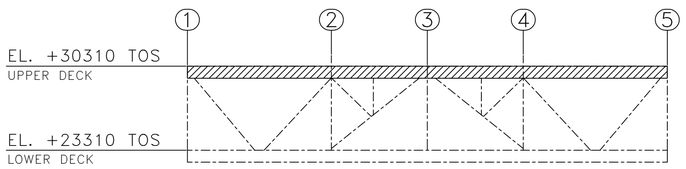

KEY ELEVATION

SCALE 1:250

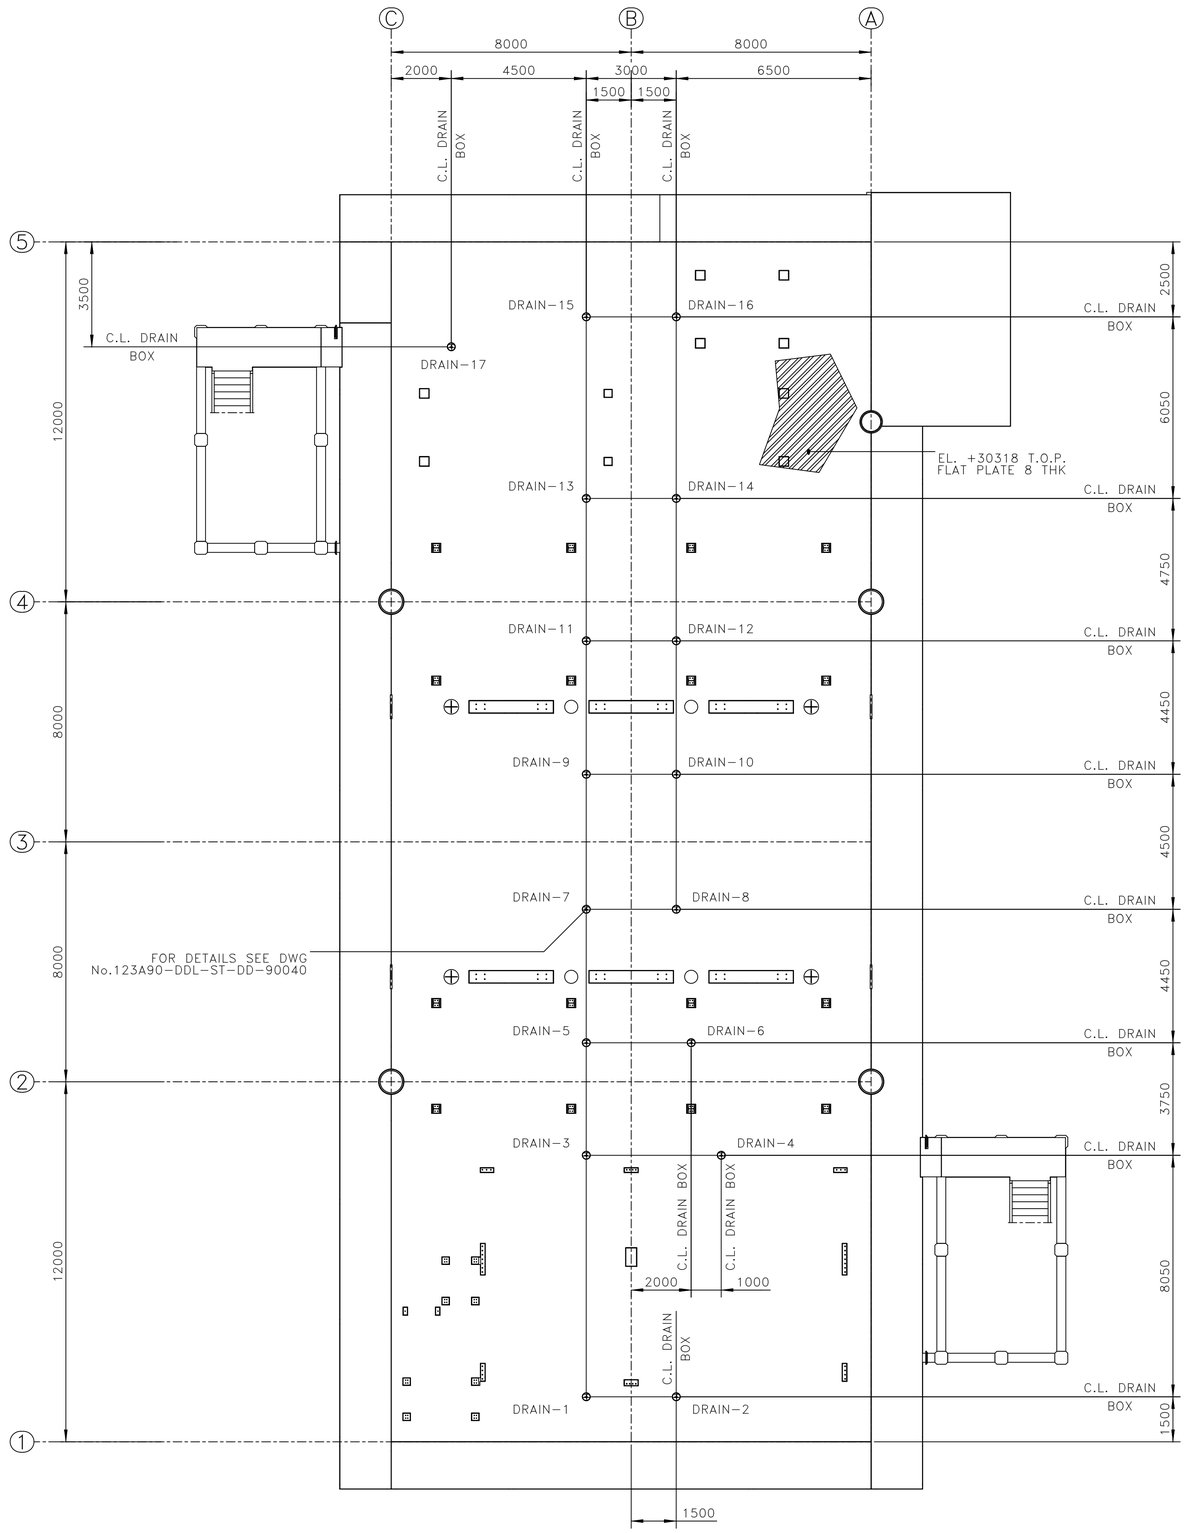

PLAN AT EL.+30310 TOS

SCALE 1:100

NOTES

1 – ALL DIMENSIONS AND ELEVATIONS ARE IN MILLIMETERS U.N.O.
2 – ALL ELEVATIONS ARE REFERED TO C.D.

MATERIALS

HOLDS

REFERENCE DRAWINGS

DWG No.	DESCRIPTION
123A90-DDL-ST-DD-90025	DRAWING LIST
123A90-DDL-ST-DD-90026	GENERAL NOTES
123A90-DDL-ST-DD-90039	PLATING AND GRATING TYPICAL DETAILS
123A90-DDL-ST-DD-90040	DRAIN SYSTEM TYPICAL DETAILS
123A90-DDL-ST-DD-90050	PRIMARY STEEL – PLAN AT EL +30310 TOS
123A90-DDL-ST-DD-90058	SEC. STEEL – PLAN AT EL +30310 TOS – SH. 1
123A90-DDL-ST-DD-90060	FLOORING – PLAN AT EL +30310 TOS
123A90-DDL-ST-DD-90105	SEC. STEEL – PLAN AT EL +30310 TOS – SH. 2

TECON

REV.	DATE	DRN	CHKD	APPD	DESCRIPTION
02	22/09/25	SPS	AB	CGI	AS-BUILT (ASB)
01	24/06/24	SGR	AB	DLS	ACCEPTED FOR CONSTRUCTION (AFC)
00	17/04/24	SGR	AB	DLS	ISSUE FOR REVIEW (IFR)

CROSSWIND

ROSETTI MARINO

TITLE :

BASE LOAD POWER HUB (BLPH)
TOPSIDE – DRAIN SYSTEM
PLAN AT EL. +30310 T.O.S.

CONTRACT NO./TITLE CW-I-WP4-2023-05/HOLLANDSE KUST NOORD WIND PARK | SCALE 1:100

DRAWN SPS | CHECKED A.BALZAROTTI | APPROVED CGI | DATE 22/09/25

A1 | DRAWING NO. 123A90-DDL-ST-DD-90075 | SHEET 001 | REV. 02

File Name : 123A90-DDL-ST-DD-90075_02.dwg