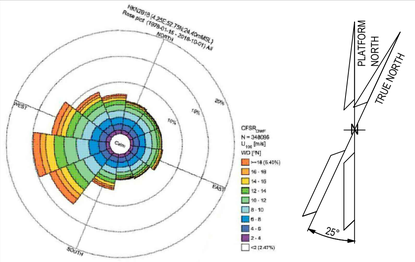
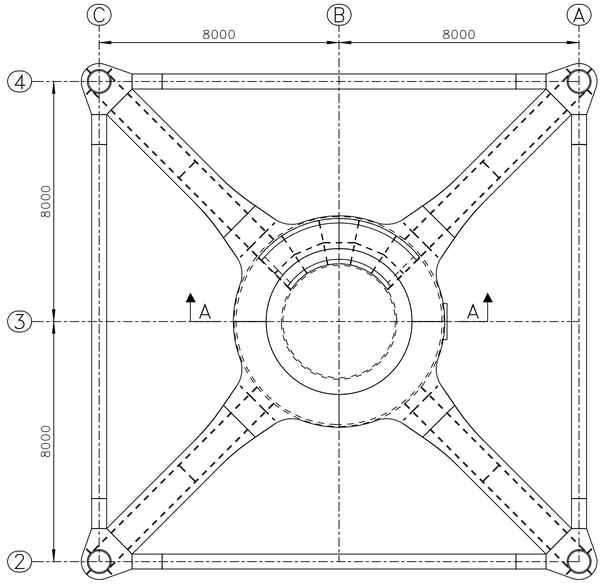
DRAWING NO. 123A90-DDL-ST-DD-90123

REV. 02












TP – WASTE WATER TANK – KEY PLAN

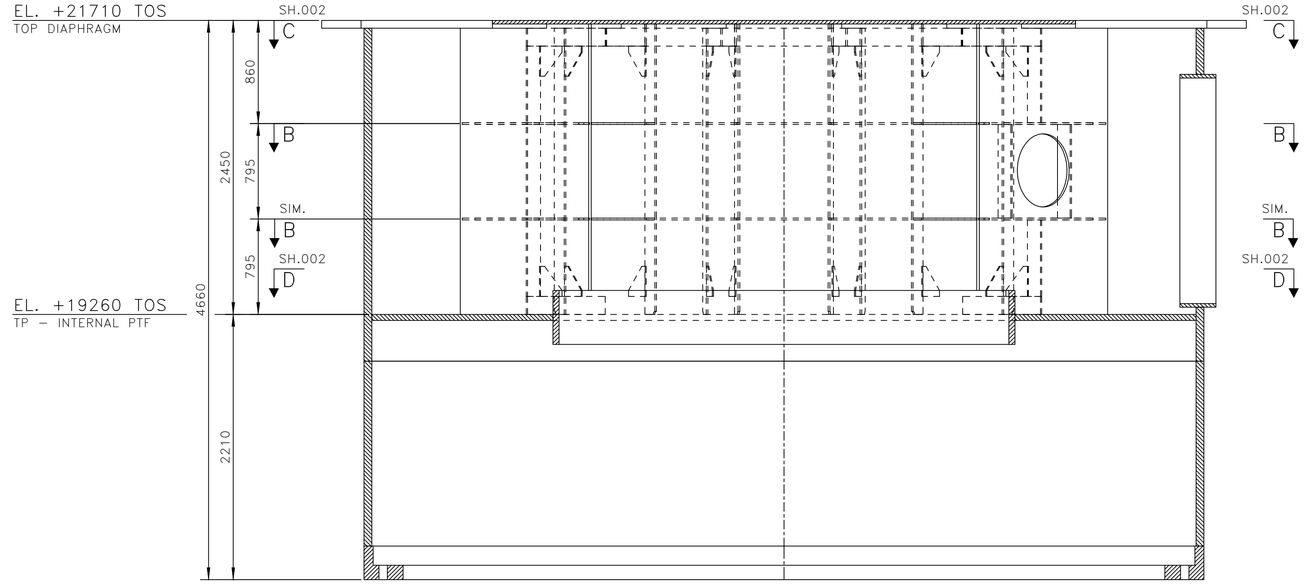SCALE 1:100





SECTION A – A

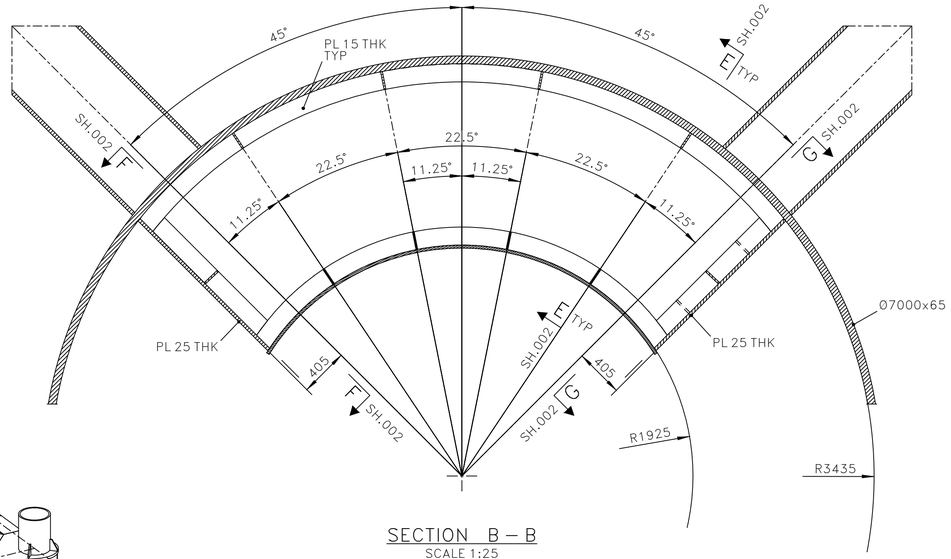SCALE 1:25




SECTION B – B

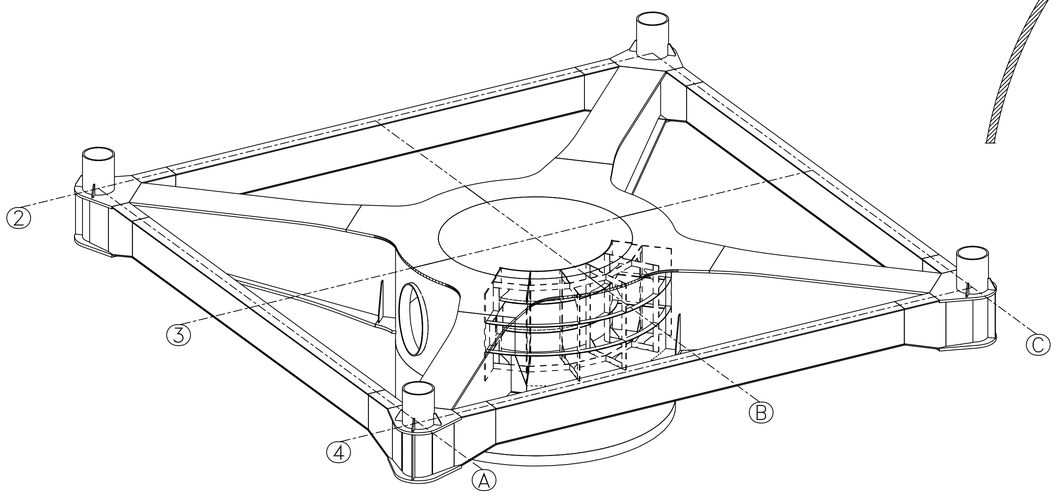SCALE 1:25




TP – WASTE WATER TANK – 3D VIEW

## NOTES

1 – ALL DIMENSIONS AND ELEVATIONS ARE IN MILLIMETERS U.N.O.
2 – ALL ELEVATIONS ARE REFERED TO C.D.
3 – ALL WELDS ARE FULL PENETRATION WELDS U.N.O.
4 – ALL FILLET WELDS SHALL BE CONTINUOUS AND THE LEG SIZE SHALL BE EQUAL 0.7 THE MINIMUM THICKNESS TO BE JOINTED U.N.O.

## MATERIALS

| ITEM IDENTIFICATION | MATERIAL DESIGNATION |
|---|---|
| PL 10 THK | DC3-II-355-0 |
| PL 15 THK | DC3-II-355-20 |
| PL 25 THK | DC3-II-355-20 |

## HOLDS

## REFERENCE DRAWINGS

| DWG No. | DESCRIPTION |
|---|---|
| 123A90-DDL-ST-DD-90025 | DRAWING LIST |
| 123A90-DDL-ST-DD-90026 | GENERAL NOTES |
| 123A90-DDL-ST-DD-90027 | WELDING GENERAL NOTES |
| 123A90-DDL-ST-DD-90032 | PLATES – DOUBLE SIDED WELDS |
| 123A90-DDL-ST-DD-90033 | PLATES – SINGLE SIDED WELDS |
| 123A90-DDL-ST-DD-90078 | TP – PRIMARY STEEL – ELEVATION ROW –A– |
| 123A90-DDL-ST-DD-90085 | TP – PRIMARY STEEL – PLAN AT EL. +21710 TOS |
| 123A90-DDL-ST-DD-90101 | TP – PRIMARY STEEL – SECTIONS |
| 123A90-DDL-ST-DD-90123 | TP – WASTE WATER TANK – ASS. AND DET. – SH.2 |

TECON

| REV. | DATE | DRN | CHKD | APPD | DESCRIPTION |
|---|---|---|---|---|---|
| 02 | 22/09/25 | SPS | AB | CGI | AS-BUILT (ASB) |
| 01 | 19/08/24 | SGR | AB | DLS | ACCEPTED FOR CONSTRUCTION (AFC) |
| 00 | 03/06/24 | SGR | AB | DLS | ISSUE FOR REVIEW (IFR) |

CROSSWIND

ROSETTI MARINO

TITLE :

BASE LOAD POWER HUB (BLPH)
TP – WASTE WATER TANK
ASSEMBLY AND DETAILS

CONTRACT NO./TITLE CW-I-WP4-2023-05/HOLLANDSE KUST NOORD WIND PARK | SCALE 1:10


DRAWN SPS | CHECKED A.BALZAROTTI | APPROVED CGI | DATE 22/09/25

A1 | DRAWING NO. 123A90-DDL-ST-DD-90123 | SHEET / SHEETS 001/002 | REV. 02


File Name : 123A90-DDL-ST-DD-90123_02.dwg

DRAWING NO. 123A90-DDL-ST-DD-90123

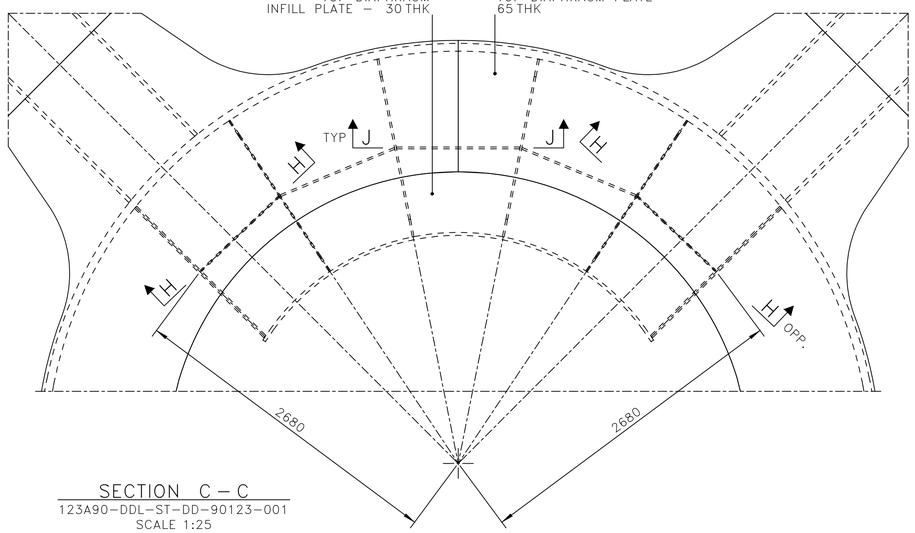
REV. 02



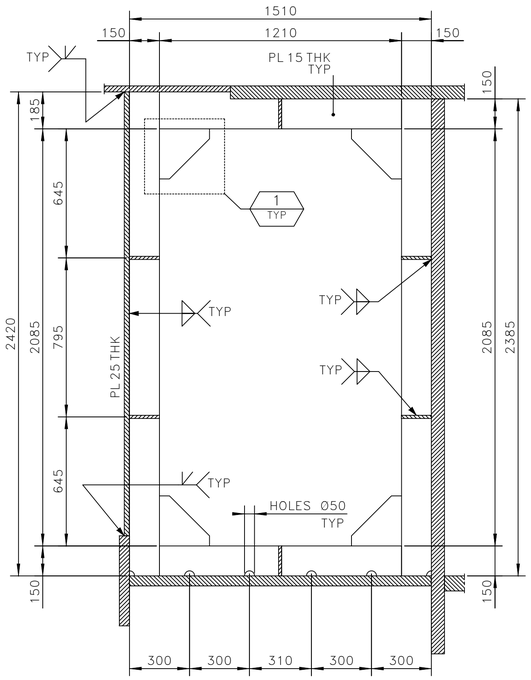

SECTION C – C
123A90-DDL-ST-DD-90123-001
SCALE 1:25





SECTION E – E
SCALE 1:15

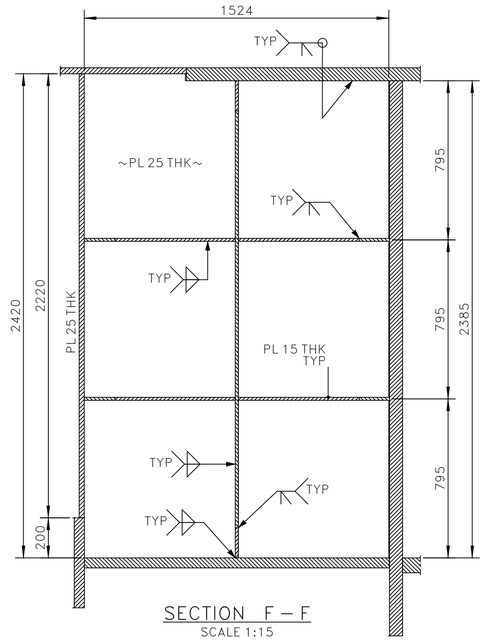



SECTION F – F
SCALE 1:15

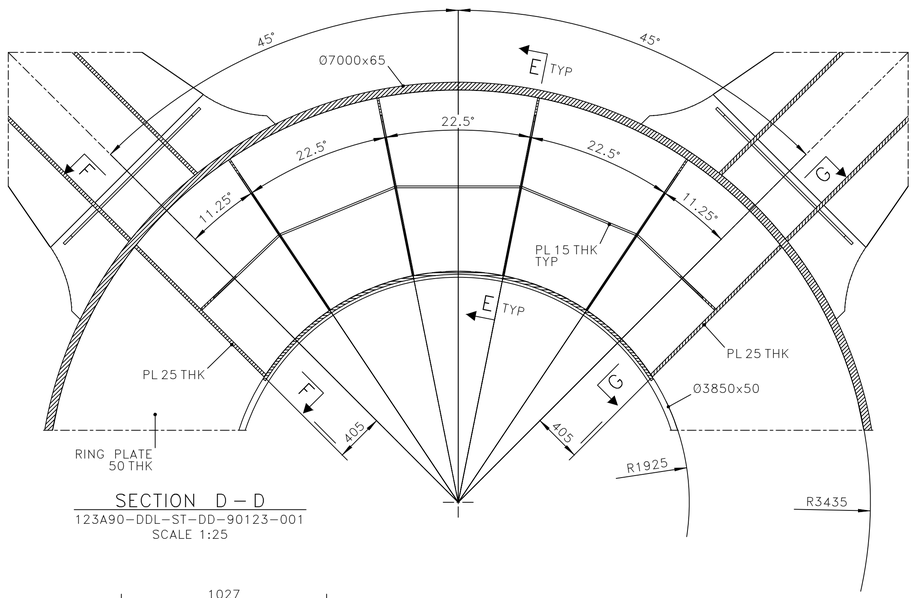

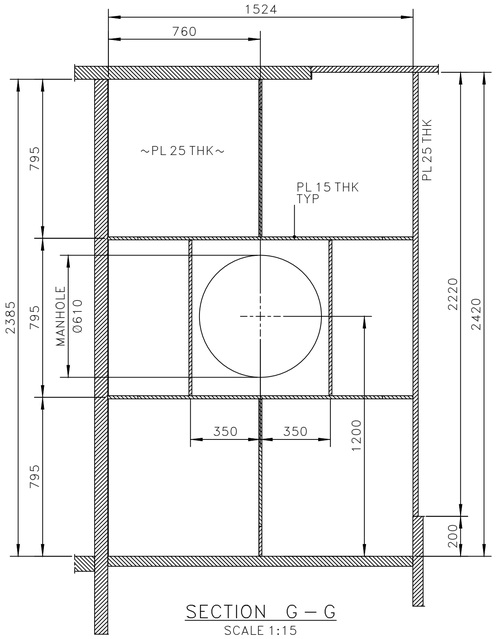

SECTION D – D
123A90-DDL-ST-DD-90123-001
SCALE 1:25





SECTION G – G
SCALE 1:15

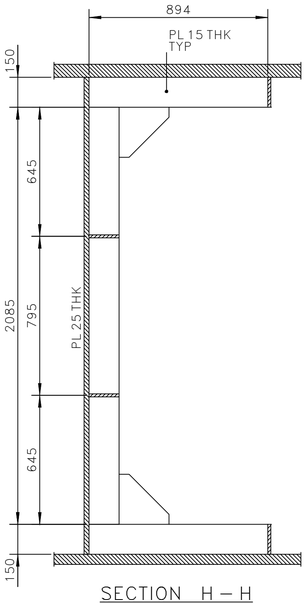


SECTION H – H
SCALE 1:15

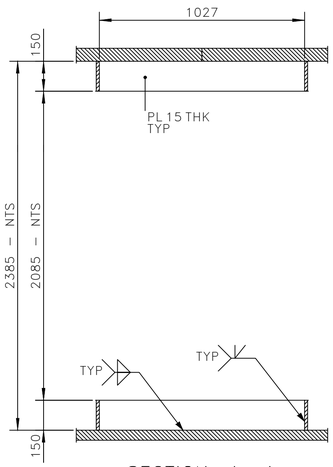


SECTION J – J
SCALE 1:15

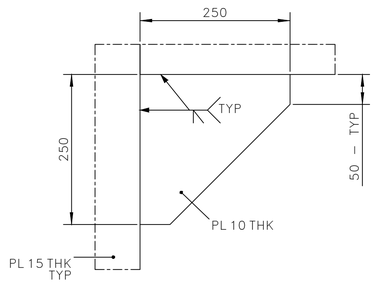


1 TYP DETAIL –

## NOTES

1 – ALL DIMENSIONS AND ELEVATIONS ARE IN MILLIMETERS U.N.O.
2 – ALL ELEVATIONS ARE REFERED TO C.D.
3 – ALL WELDS ARE FULL PENETRATION WELDS U.N.O.
4 – ALL FILLET WELDS SHALL BE CONTINUOUS AND THE LEG SIZE SHALL BE EQUAL 0.7 THE MINIMUM THICKNESS TO BE JOINTED U.N.O.

## MATERIALS

| ITEM IDENTIFICATION | MATERIAL DESIGNATION |
|---|---|
| PL 10 THK | DC3-II-355-0 |
| PL 15 THK | DC3-II-355-20 |
| PL 25 THK | DC3-II-355-20 |

## HOLDS

## REFERENCE DRAWINGS

| DWG No. | DESCRIPTION |
|---|---|
| 123A90-DDL-ST-DD-90025 | DRAWING LIST |
| 123A90-DDL-ST-DD-90026 | GENERAL NOTES |
| 123A90-DDL-ST-DD-90027 | WELDING GENERAL NOTES |
| 123A90-DDL-ST-DD-90032 | PLATES – DOUBLE SIDED WELDS |
| 123A90-DDL-ST-DD-90033 | PLATES – SINGLE SIDED WELDS |
| 123A90-DDL-ST-DD-90123 | TP – WASTE WATER TANK – ASS. AND DET. – SH.1 |

TECON

| REV. | DATE | DRN | CHKD | APPD | DESCRIPTION |
|---|---|---|---|---|---|
| 02 | 22/09/25 | SPS | AB | CGI | AS-BUILT (ASB) |
| 01 | 19/08/24 | SGR | AB | DLS | ACCEPTED FOR CONSTRUCTION (AFC) |
| 00 | 03/06/24 | SGR | AB | DLS | ISSUE FOR REVIEW (IFR) |

CROSSWIND

ROSETTI MARINO

TITLE :

BASE LOAD POWER HUB (BLPH)
TP – WASTE WATER TANK
ASSEMBLY AND DETAILS

CONTRACT NO./TITLE CW-I-WP4-2023-05/HOLLANDSE KUST NOORD WIND PARK | SCALE 1:10

DRAWN SPS | CHECKED A.BALZAROTTI | APPROVED CGI | DATE 22/09/25

A1 | DRAWING NO. 123A90-DDL-ST-DD-90123 | SHEET / SHEETS 002/002 | REV. 02

File Name : 123A90-DDL-ST-DD-90123_02.dwg