

DRAWING NO. 123A90-DDL-ST-DD-90124

REV. 02






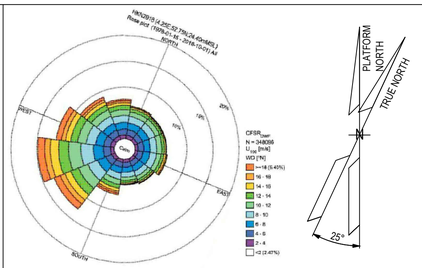


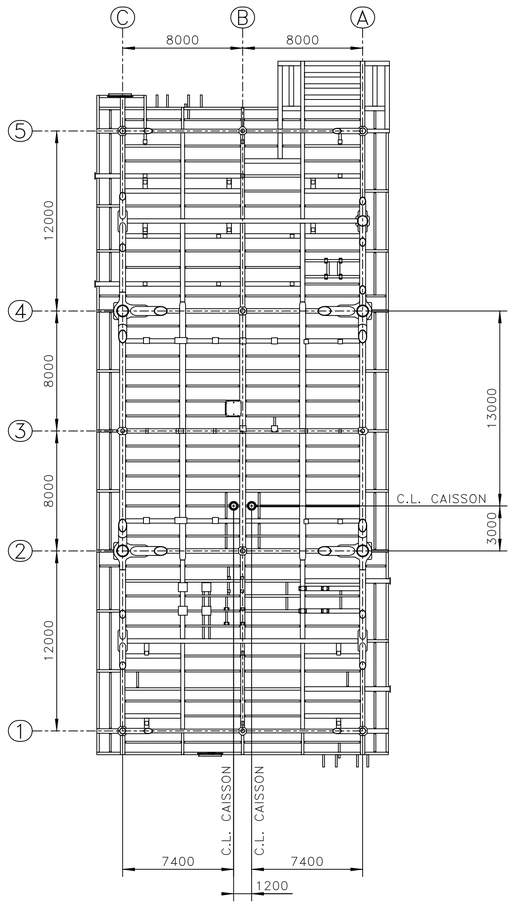


TOPSIDE – LOWER DECK
KEY PLAN
SCALE 1:200

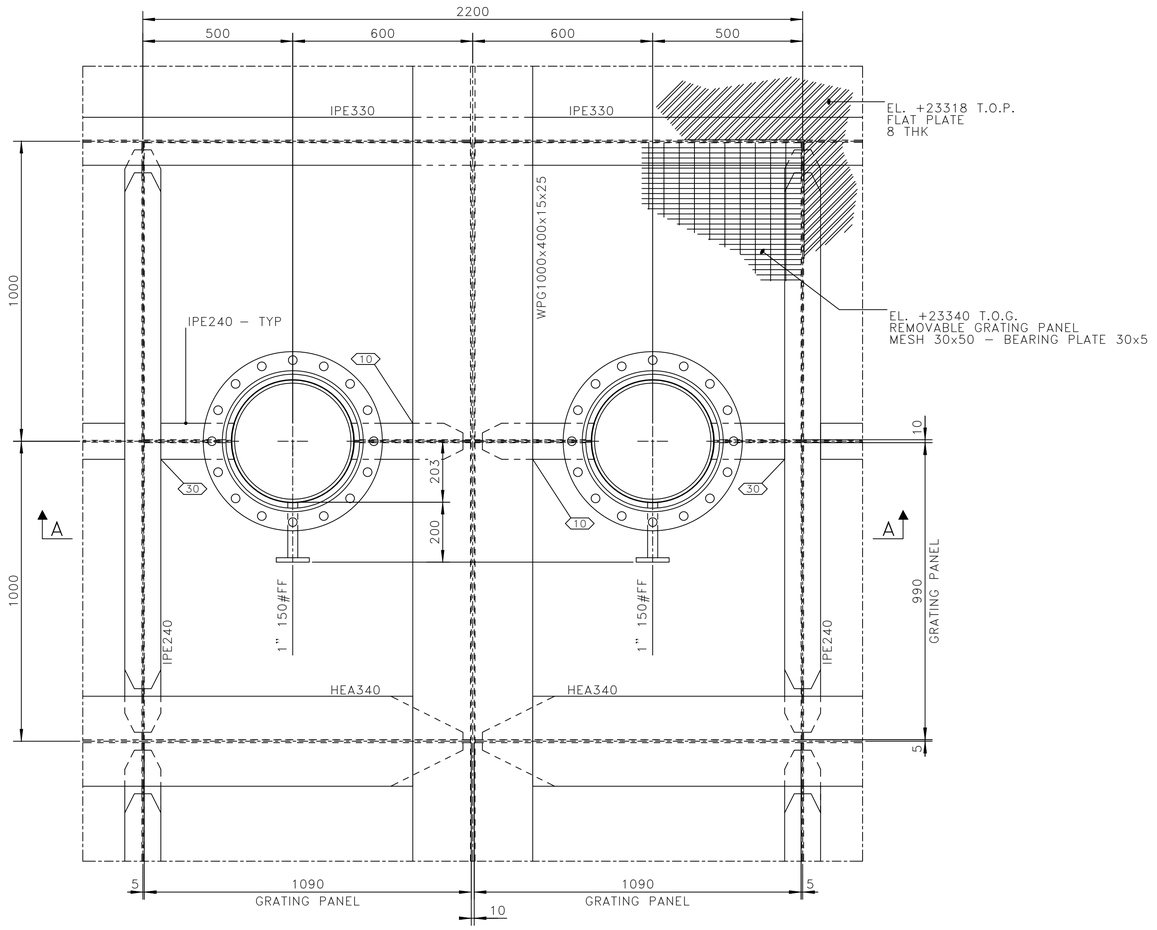


CAISSON HATCH – PLAN VIEW
SCALE 1:10

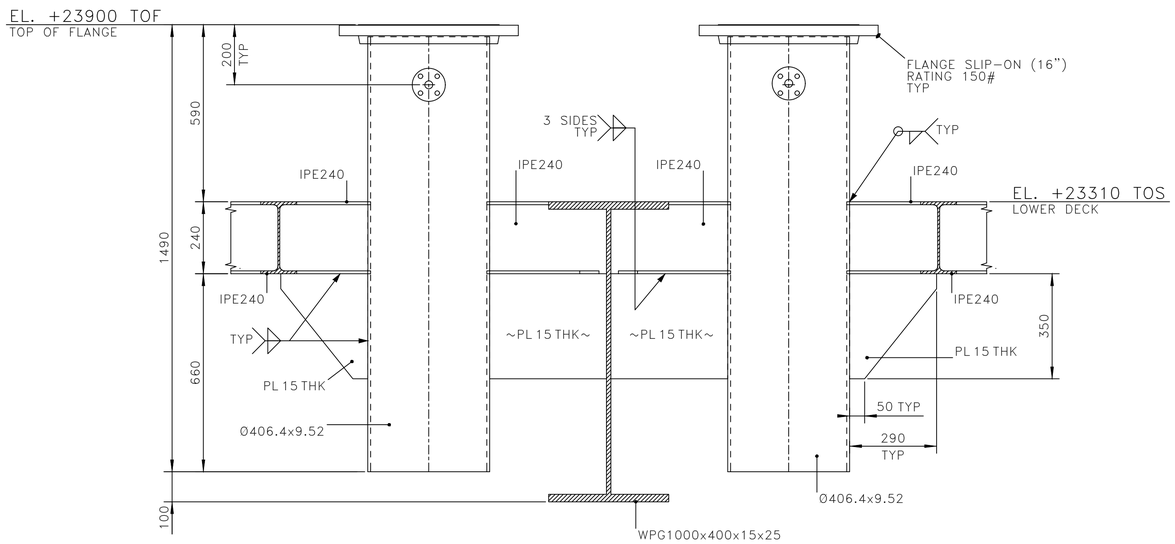


SECTION A – A
SCALE 1:10

## NOTES

1 – ALL DIMENSIONS AND ELEVATIONS ARE IN MILLIMETERS U.N.O.
2 – ALL ELEVATIONS ARE REFERED TO C.D.
3 – ALL WELDS ARE FULL PENETRATION WELDS U.N.O.
4 – ALL FILLET WELDS SHALL BE CONTINUOUS AND THE LEG SIZE SHALL BE EQUAL 0.7 THE MINIMUM THICKNESS TO BE JOINTED U.N.O.

## MATERIALS

| ITEM IDENTIFICATION | MATERIAL DESIGNATION |
|---|---|
| IPE240 | DC4–III–355–0 |
| PL 15 THK | DC4–III–355–0 |
| Ø406.4x9.52 | DC4–III–X52–0 |

## HOLDS

## REFERENCE DRAWINGS

| DWG No. | DESCRIPTION |
|---|---|
| 123A90-DDL-ST-DD-90025 | DRAWING LIST |
| 123A90-DDL-ST-DD-90026 | GENERAL NOTES |
| 123A90-DDL-ST-DD-90027 | WELDING GENERAL NOTES |
| 123A90-DDL-ST-DD-90032 | PLATES – DOUBLE SIDED WELDS |
| 123A90-DDL-ST-DD-90033 | PLATES – SINGLE SIDED WELDS |
| 123A90-DDL-ST-DD-90034 | TYPICAL BEAM CONNECTIONS |
| 123A90-DDL-ST-DD-90049 | PRIMARY STEEL – PLAN AT EL. +23310 TOS |
| 123A90-DDL-ST-DD-90057 | SEC. STEEL – PLAN AT EL. +23310 TOS – SH.1 |
| 123A90-DDL-ST-DD-90104 | SEC. STEEL – PLAN AT EL. +23310 TOS – SH.2 |

TECON

| REV. | DATE | DRN | CHKD | APPD | DESCRIPTION |
|---|---|---|---|---|---|
| 02 | 22/09/25 | SPS | AB | CGI | AS-BUILT (ASB) |
| 01 | 19/08/24 | SGR | AB | DLS | ACCEPTED FOR CONSTRUCTION (AFC) |
| 00 | 26/06/24 | SGR | AB | DLS | ISSUE FOR REVIEW (IFR) |

CROSSWIND

ROSETTI MARINO

TITLE :
BASE LOAD POWER HUB (BLPH)
TOPSIDE – LOWER DECK
CAISSON HATCH – ASSEMBLY AND DETAILS

CONTRACT NO./TITLE CW-I-WP4-2023-05/HOLLANDSE KUST NOORD WIND PARK | SCALE 1:10

DRAWN SPS | CHECKED A.BALZAROTTI | APPROVED CGI | DATE 22/09/25

A1 | DRAWING NO. 123A90-DDL-ST-DD-90124 | SHEET 001 | REV. 02

File Name : 123A90-DDL-ST-DD-90124_02.dwg