




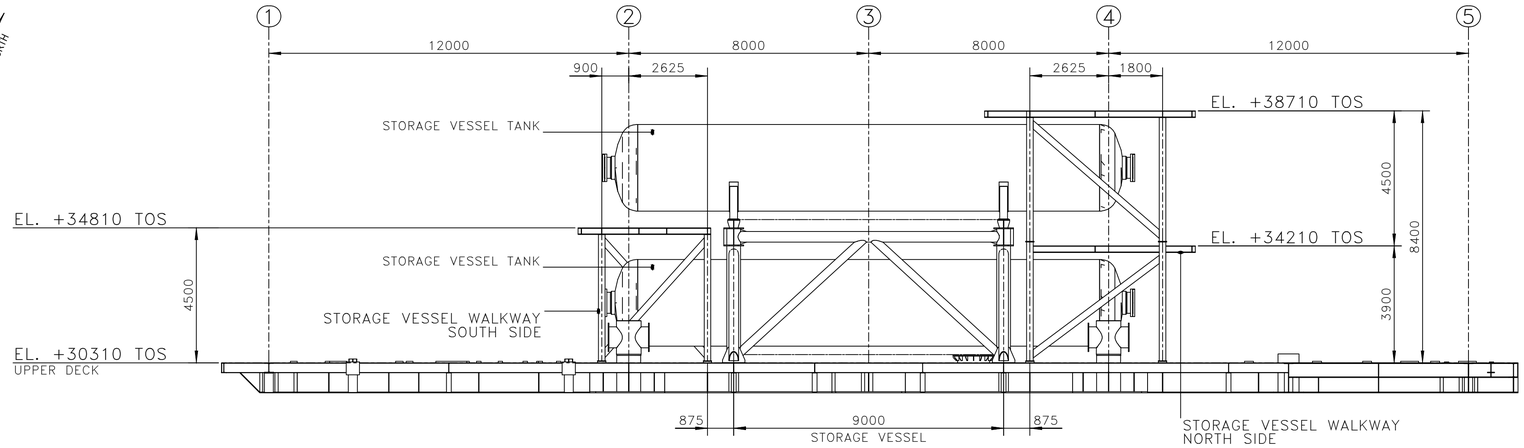


SECTION A – A
SCALE 1:100

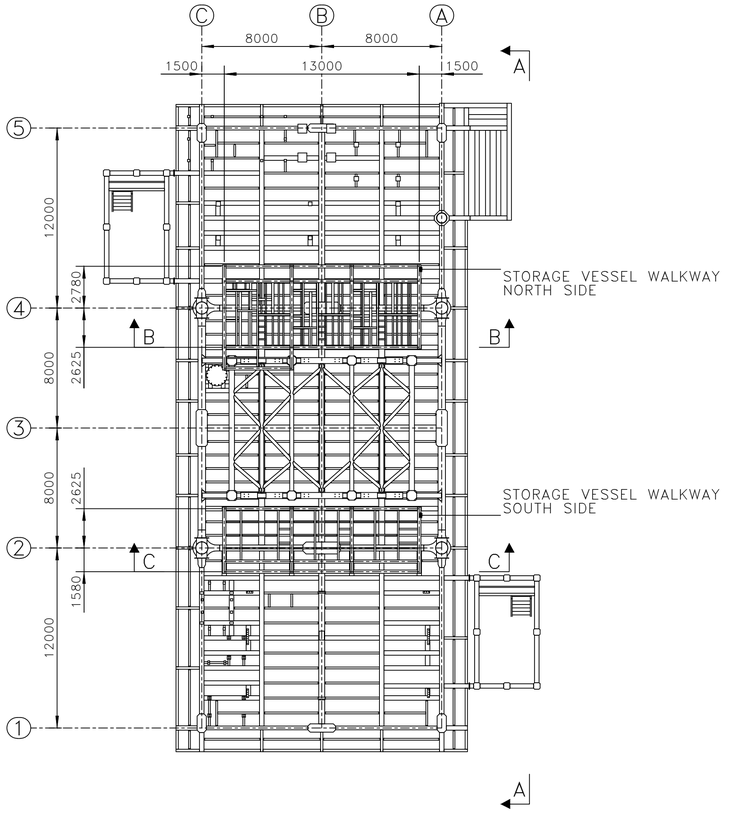

STORAGE VESSEL – WALKWAYS
KEY PLAN
SCALE 1:200

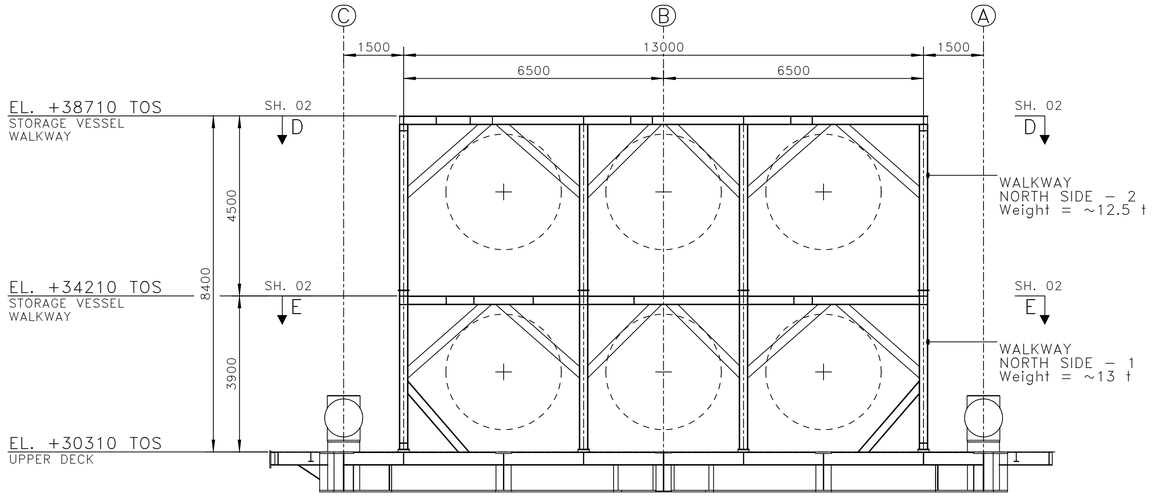

SECTION B – B
SCALE 1:75

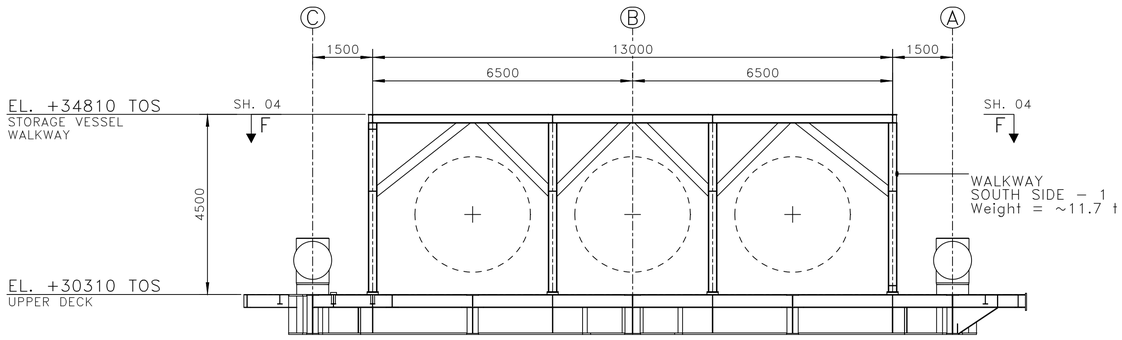

SECTION C – C
SCALE 1:75

NOTES

1 – ALL DIMENSIONS AND ELEVATIONS ARE IN MILLIMETERS U.N.O.
2 – ALL ELEVATIONS ARE REFERED TO C.D.

MATERIALS

HOLDS

REFERENCE DRAWINGS

DWG No.	DESCRIPTION
123A90-DDL-ST-DD-90025	DRAWING LIST
123A90-DDL-ST-DD-90026	GENERAL NOTES
123A90-DDL-ST-DD-90125	STORAGE VESSEL – WALKWAYS – SH.2 to SH.5

REV.	DATE	DRN	CHKD	APPD	DESCRIPTION
02	22/09/25	SPS	AB	CGI	AS-BUILT (ASB)
01	04/12/24	SGR	AB	DLS	ACCEPTED FOR CONSTRUCTION (AFC)
00	19/07/24	SGR	AB	DLS	ISSUE FOR REVIEW (IFR)

TECON

CROSSWIND

ROSETTI MARINO

TITLE :
BASE LOAD POWER HUB (BLPH)
STORAGE VESSEL – WALKWAYS
ASSEMBLY AND DETAILS


CONTRACT NO./TITLE CW-I-WP4-2023-05/HOLLANDSE KUST NOORD WIND PARK | SCALE 1:100

DRAWN SPS | CHECKED A.BALZAROTTI | APPROVED CGI | DATE 22/09/25

A1 | DRAWING NO. 123A90-DDL-ST-DD-90125 | SHEET / SHEETS 001/005 | REV. 02

DRAWING NO. 123A90-DDL-ST-DD-90125 REV. 02

File Name : 123A90-DDL-ST-DD-90125_02.dwg

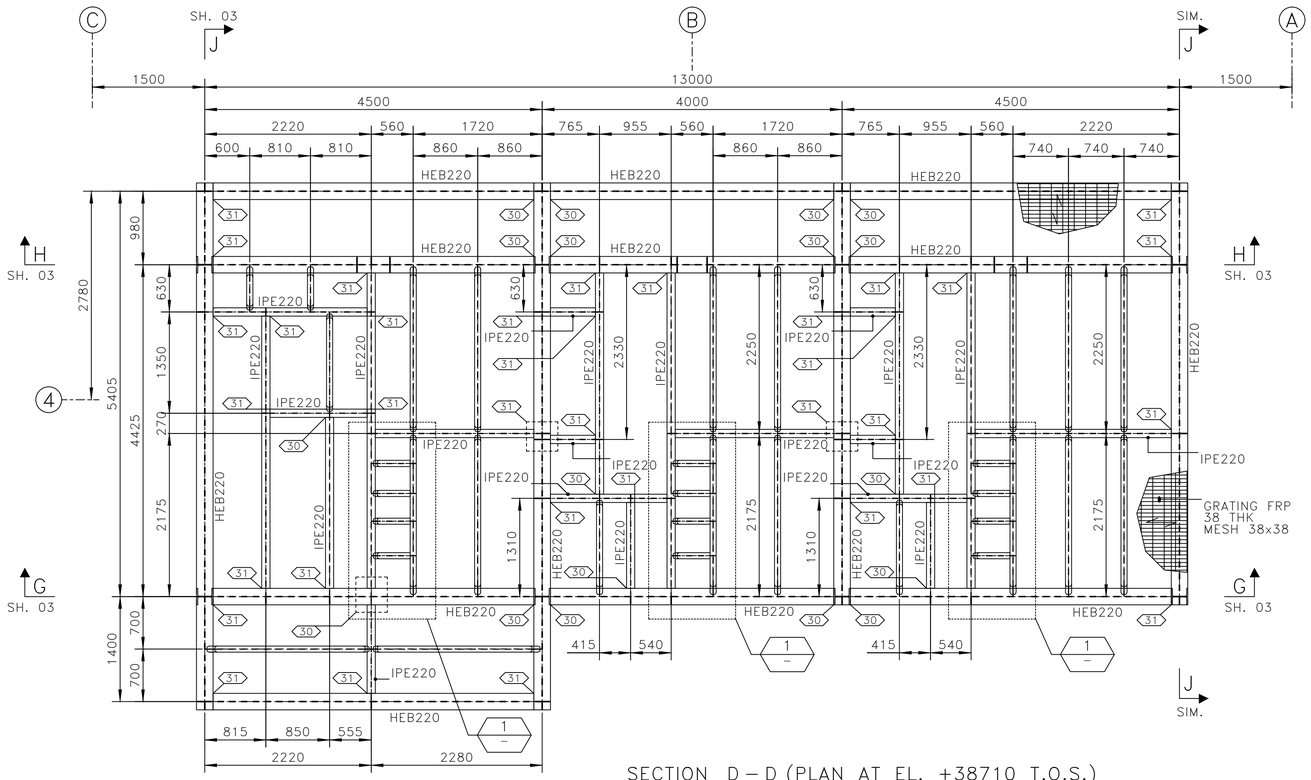

NOTES

1 – ALL DIMENSIONS AND ELEVATIONS ARE IN MILLIMETERS U.N.O.
2 – ALL ELEVATIONS ARE REFERED TO C.D.
3 – ALL WELDS ARE FULL PENETRATION WELDS U.N.O.
4 – ALL FILLET WELDS SHALL BE CONTINUOUS AND THE LEG SIZE SHALL BE EQUAL 0.7 THE MINIMUM THICKNESS TO BE JOINTED U.N.O.
5 – ALL OTHER PLATES ARE DC5–IV–355–10.

MATERIALS

ITEM IDENTIFICATION	MATERIAL DESIGNATION
HEB160	DC5–IV–355–10
HEB220	DC5–IV–355–10
IPE160	DC5–IV–355–10
IPE220	DC5–IV–355–10
PL 38 THK	FRP – GRATING 38 THK

HOLDS

REFERENCE DRAWINGS

DWG No.	DESCRIPTION
123A90–DDL–ST–DD–90025	DRAWING LIST
123A90–DDL–ST–DD–90026	GENERAL NOTES
123A90–DDL–ST–DD–90027	WELDING GENERAL NOTES
123A90–DDL–ST–DD–90032	PLATES – DOUBLE SIDED WELDS
123A90–DDL–ST–DD–90033	PLATES – SINGLE SIDED WELDS
123A90–DDL–ST–DD–90034	TYPICAL BEAM CONNECTIONS
123A90–DDL–ST–DD–90125	STORAGE VESSEL – WALKWAYS – SH.1 & SH.3

REV.	DATE	DRN	CHKD	APPD	DESCRIPTION
02	22/09/25	SPS	AB	CGI	AS–BUILT (ASB)
01	04/12/24	SGR	AB	DLS	ACCEPTED FOR CONSTRUCTION (AFC)
00	19/07/24	SGR	AB	DLS	ISSUE FOR REVIEW (IFR)

TECON

CROSSWIND

ROSETTI MARINO

TITLE :
BASE LOAD POWER HUB (BLPH)
STORAGE VESSEL – WALKWAYS
ASSEMBLY AND DETAILS

CONTRACT NO./TITLE CW–I–WP4–2023–05/HOLLANDSE KUST NOORD WIND PARK | SCALE 1:40


DRAWN SPS | CHECKED A.BALZAROTTI | APPROVED CGI | DATE 22/09/25

A1 | DRAWING NO. 123A90–DDL–ST–DD–90125 | SHEET / SHEETS 002/005 | REV. 02


DRAWING NO. 123A90–DDL–ST–DD–90125 REV. 02

File Name : 123A90–DDL–ST–DD–90125_02.dwg


DRAWING NO. 123A90-DDL-ST-DD-90125 | REV. 02

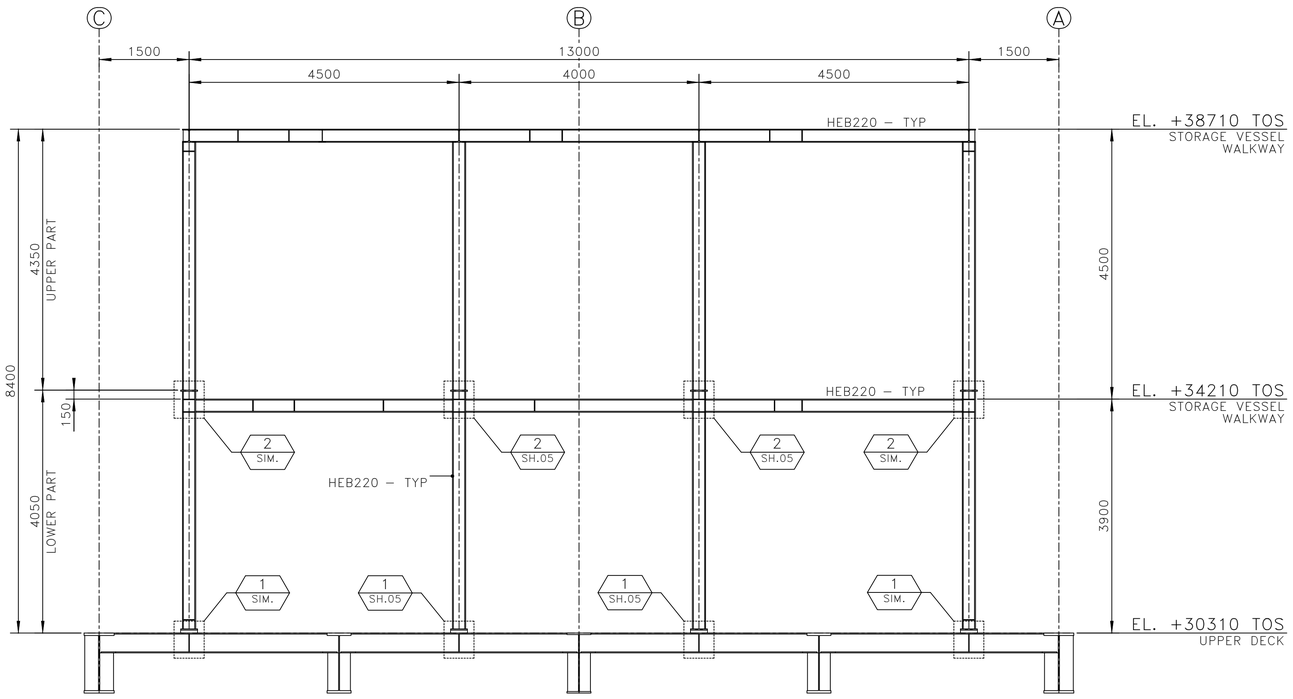

SECTION G – G
123A90-DDL-ST-DD-90125-002
SCALE 1:50

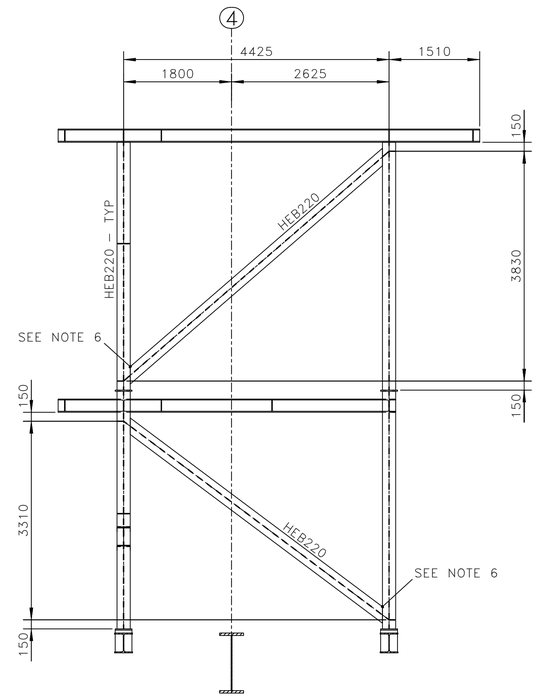


SECTION J – J
123A90-DDL-ST-DD-90125-002
SCALE 1:50

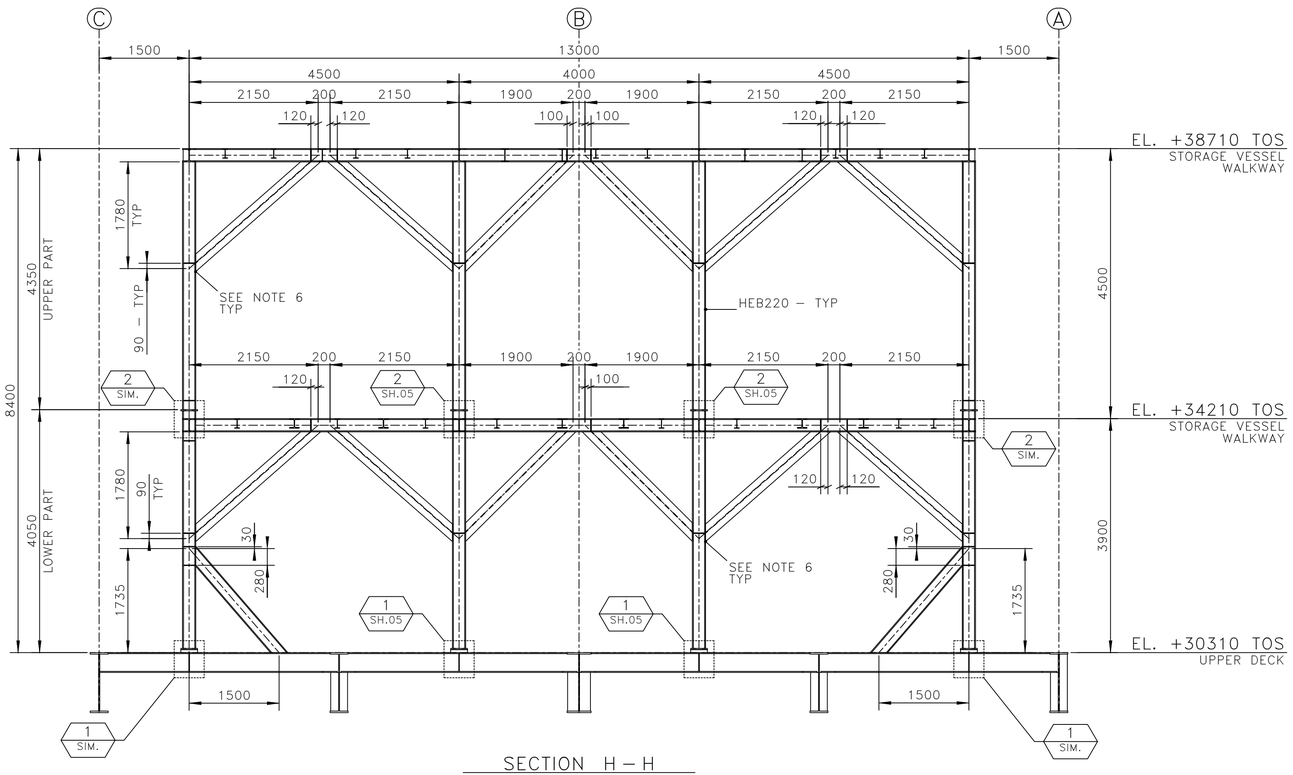

SECTION H – H
123A90-DDL-ST-DD-90125-002
SCALE 1:50

TYPICAL BEAM CONNECTION

SCALE 1:10

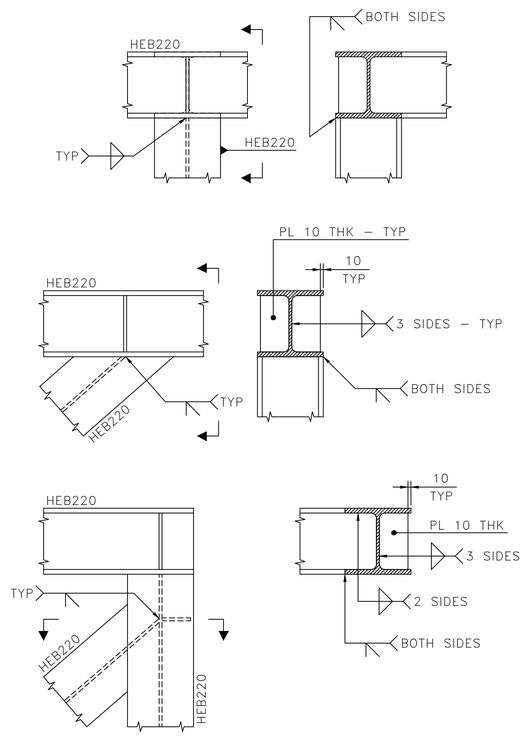

NOTES

1 – ALL DIMENSIONS AND ELEVATIONS ARE IN MILLIMETERS U.N.O.
2 – ALL ELEVATIONS ARE REFERED TO C.D.
3 – ALL WELDS ARE FULL PENETRATION WELDS U.N.O.
4 – ALL FILLET WELDS SHALL BE CONTINUOUS AND THE LEG SIZE SHALL BE EQUAL 0.7 THE MINIMUM THICKNESS TO BE JOINTED U.N.O.
5 – ALL OTHER PLATES ARE DC5-IV-355-10.
6 – DRAINAGE HOLE TO BE PROVIDED AT THE BOTTOM END OF DIAGONALS.

MATERIALS

ITEM IDENTIFICATION	MATERIAL DESIGNATION
HEB160	DC5-IV-355-10
HEB220	DC5-IV-355-10
IPE160	DC5-IV-355-10
IPE220	DC5-IV-355-10

HOLDS

REFERENCE DRAWINGS

DWG No.	DESCRIPTION
123A90-DDL-ST-DD-90025	DRAWING LIST
123A90-DDL-ST-DD-90026	GENERAL NOTES
123A90-DDL-ST-DD-90027	WELDING GENERAL NOTES
123A90-DDL-ST-DD-90032	PLATES – DOUBLE SIDED WELDS
123A90-DDL-ST-DD-90033	PLATES – SINGLE SIDED WELDS
123A90-DDL-ST-DD-90125	STORAGE VESSEL – WALKWAYS – SH.2 & SH.5

TECON

REV.	DATE	DRN	CHKD	APPD	DESCRIPTION
02	22/09/25	SPS	AB	CGI	AS-BUILT (ASB)
01	04/12/24	SGR	AB	DLS	ACCEPTED FOR CONSTRUCTION (AFC)
00	19/07/24	SGR	AB	DLS	ISSUE FOR REVIEW (IFR)


CROSSWIND | ROSETTI MARINO

TITLE :
BASE LOAD POWER HUB (BLPH)
STORAGE VESSEL – WALKWAYS
ASSEMBLY AND DETAILS


CONTRACT NO./TITLE CW-I-WP4-2023-05/HOLLANDSE KUST NOORD WIND PARK | SCALE 1:50
DRAWN SPS | CHECKED A.BALZAROTTI | APPROVED CGI | DATE 22/09/25
A1 | DRAWING NO. 123A90-DDL-ST-DD-90125 | SHEET / SHEETS 003/005 | REV. 02

File Name : 123A90-DDL-ST-DD-90125_02.dwg


DRAWING NO. 123A90-DDL-ST-DD-90125 REV. 02

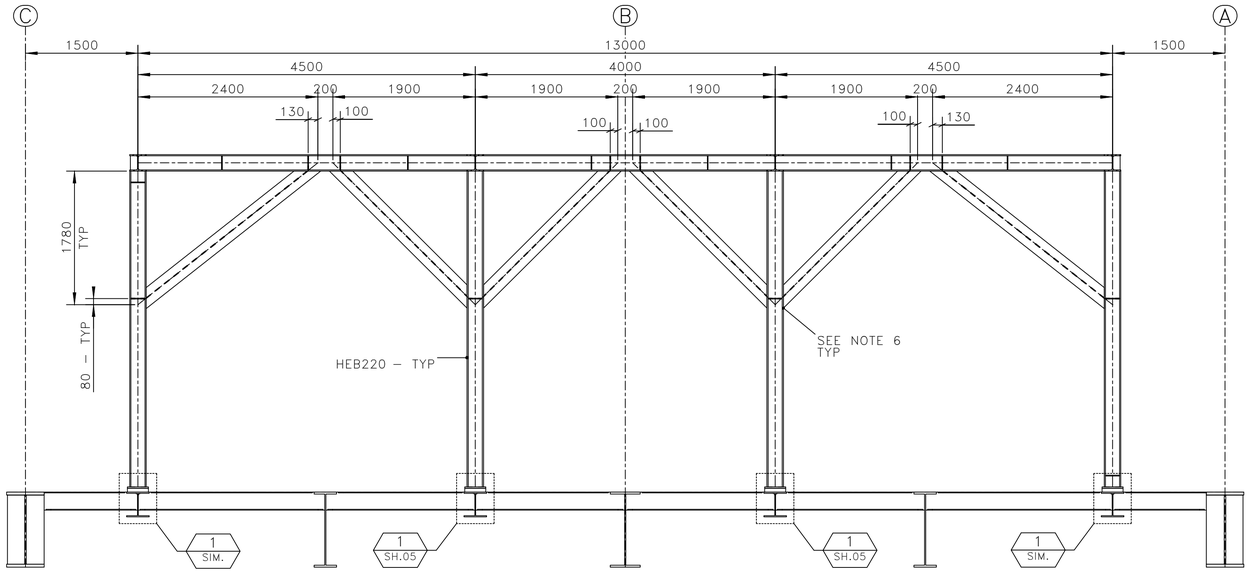


SECTION K – K
SCALE 1:40

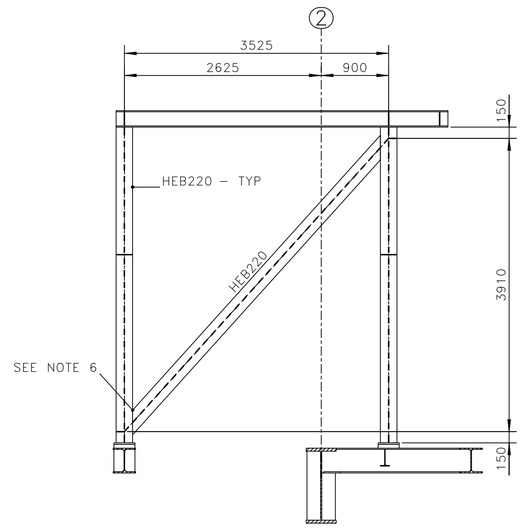

SECTION L – L
SCALE 1:40

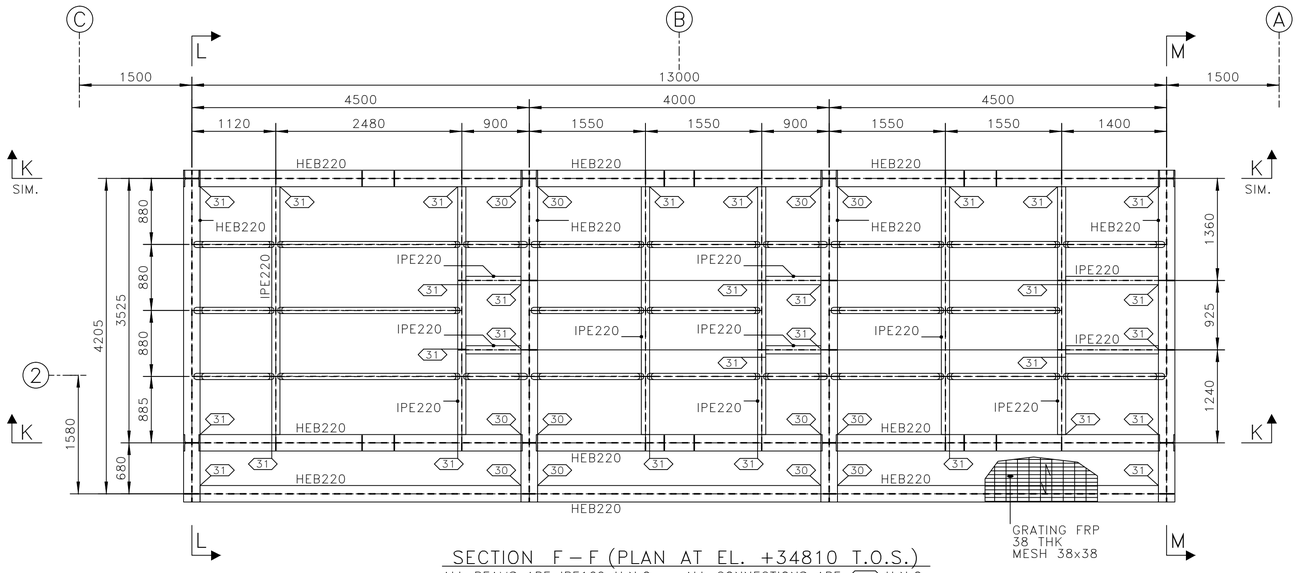


SECTION F – F (PLAN AT EL. +34810 T.O.S.)
ALL BEAMS ARE IPE160 U.N.O. – ALL CONNECTIONS ARE (11) U.N.O.
123A90-DDL-ST-DD-90125-001
SCALE 1:40

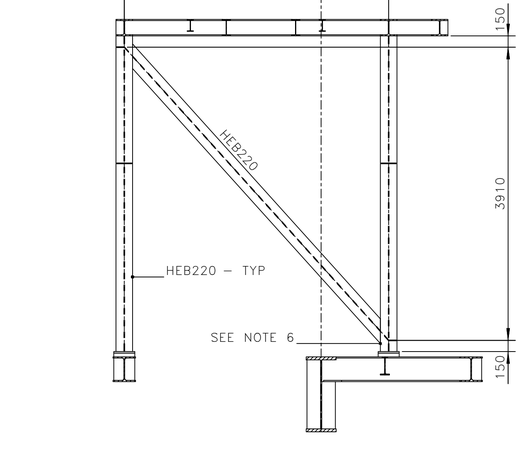

SECTION M – M
SCALE 1:40

TYPICAL BEAM CONNECTION
SCALE 1:10

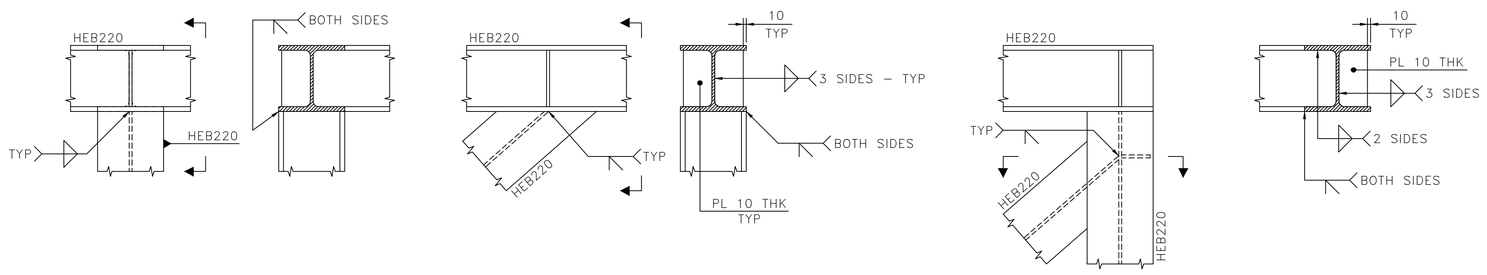

NOTES

1 – ALL DIMENSIONS AND ELEVATIONS ARE IN MILLIMETERS U.N.O.
2 – ALL ELEVATIONS ARE REFERED TO C.D.
3 – ALL WELDS ARE FULL PENETRATION WELDS U.N.O.
4 – ALL FILLET WELDS SHALL BE CONTINUOUS AND THE LEG SIZE SHALL BE EQUAL 0.7 THE MINIMUM THICKNESS TO BE JOINTED U.N.O.
5 – ALL OTHER PLATES ARE DC5-IV-355-10.
6 – DRAINAGE HOLE TO BE PROVIDED AT THE BOTTOM END OF DIAGONALS.

MATERIALS

ITEM IDENTIFICATION	MATERIAL DESIGNATION
HEB220	DC5-IV-355-10
IPE160	DC5-IV-355-10
IPE220	DC5-IV-355-10

HOLDS

REFERENCE DRAWINGS

DWG No.	DESCRIPTION
123A90-DDL-ST-DD-90025	DRAWING LIST
123A90-DDL-ST-DD-90026	GENERAL NOTES
123A90-DDL-ST-DD-90027	WELDING GENERAL NOTES
123A90-DDL-ST-DD-90032	PLATES – DOUBLE SIDED WELDS
123A90-DDL-ST-DD-90033	PLATES – SINGLE SIDED WELDS
123A90-DDL-ST-DD-90034	TYPICAL BEAM CONNECTIONS
123A90-DDL-ST-DD-90125	STORAGE VESSEL – WALKWAYS – SH.1 & SH.5

TECON

REV.	DATE	DRN	CHKD	APPD	DESCRIPTION
02	22/09/25	SPS	AB	CGI	AS-BUILT (ASB)
01	04/12/24	SGR	AB	DLS	ACCEPTED FOR CONSTRUCTION (AFC)
00	19/07/24	SGR	AB	DLS	ISSUE FOR REVIEW (IFR)

CROSSWIND

ROSETTI MARINO


TITLE :
BASE LOAD POWER HUB (BLPH)
STORAGE VESSEL – WALKWAYS
ASSEMBLY AND DETAILS

CONTRACT NO./TITLE CW-I-WP4-2023-05/HOLLANDSE KUST NOORD WIND PARK | SCALE 1:40


DRAWN SPS | CHECKED A.BALZAROTTI | APPROVED CGI | DATE 22/09/25

A1 | DRAWING NO. 123A90-DDL-ST-DD-90125 | SHEET / SHEETS 004/005 | REV. 02


File Name : 123A90-DDL-ST-DD-90125_02.dwg

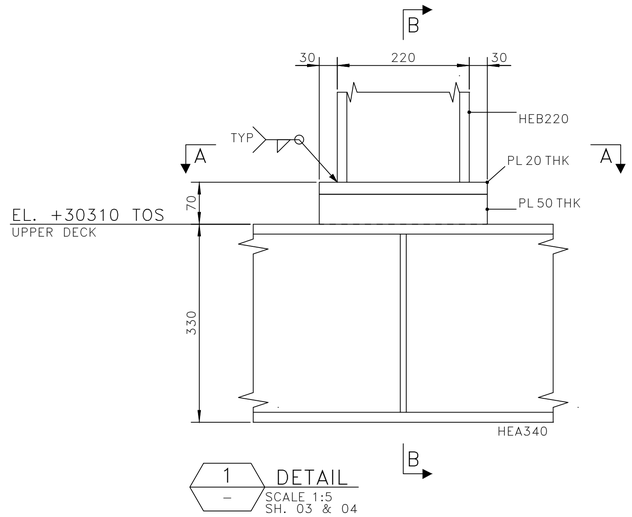


1 – DETAIL
SCALE 1:5
SH. 03 & 04

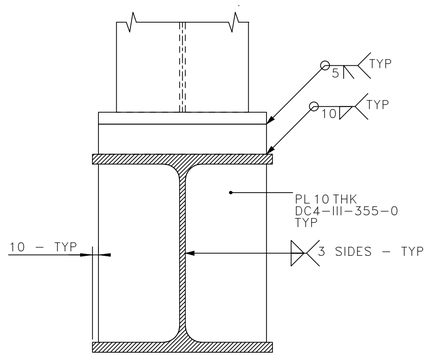


SECTION B – B
SCALE 1:5

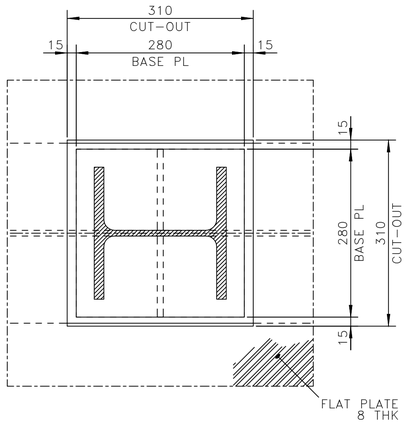


SECTION A – A
SCALE 1:5

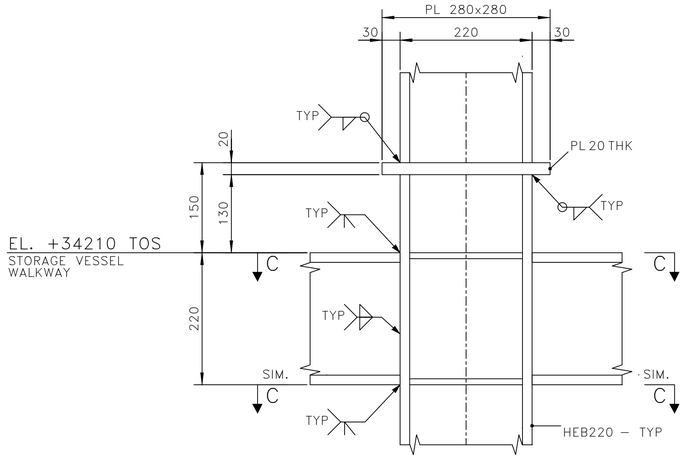


2 – DETAIL
SCALE 1:5
SH. 03 & 04

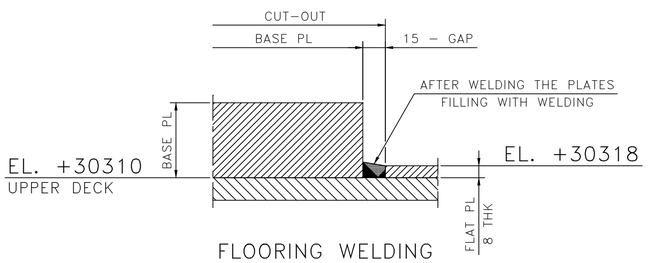

FLOORING WELDING
TYPICAL DETAILS
SCALE 1:2

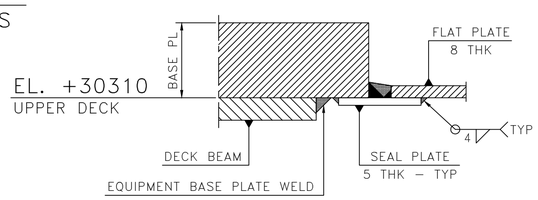

SEAL PLATE
TYPICAL DETAILS
SCALE 1:2

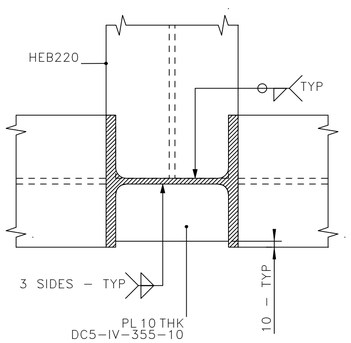

SECTION C – C
SCALE 1:5

NOTES

1 – ALL DIMENSIONS AND ELEVATIONS ARE IN MILLIMETERS U.N.O.
2 – ALL ELEVATIONS ARE REFERED TO C.D.
3 – ALL WELDS ARE FULL PENETRATION WELDS U.N.O.
4 – ALL FILLET WELDS SHALL BE CONTINUOUS AND THE LEG SIZE SHALL BE EQUAL 0.7 THE MINIMUM THICKNESS TO BE JOINTED U.N.O.

MATERIALS

ITEM IDENTIFICATION	MATERIAL DESIGNATION
PL 10 THK	DC4-III-355-0
PL 50 THK	DC4-III-355-0
HEB220	DC5-IV-355-10
PL 10 THK	DC5-IV-355-10
PL 20 THK	DC5-IV-355-10

HOLDS

REFERENCE DRAWINGS

DWG No.	DESCRIPTION
123A90-DDL-ST-DD-90025	DRAWING LIST
123A90-DDL-ST-DD-90026	GENERAL NOTES
123A90-DDL-ST-DD-90027	WELDING GENERAL NOTES
123A90-DDL-ST-DD-90032	PLATES – DOUBLE SIDED WELDS
123A90-DDL-ST-DD-90033	PLATES – SINGLE SIDED WELDS
123A90-DDL-ST-DD-90125	STORAGE VESSEL – WALKWAYS – SH.3 & SH.4

TECON

REV.	DATE	DRN	CHKD	APPD	DESCRIPTION
02	22/09/25	SPS	AB	CGI	AS-BUILT (ASB)
01	04/12/24	SGR	AB	DLS	ACCEPTED FOR CONSTRUCTION (AFC)
00	19/07/24	SGR	AB	DLS	ISSUE FOR REVIEW (IFR)

CROSSWIND

ROSETTI MARINO

TITLE :
BASE LOAD POWER HUB (BLPH)
STORAGE VESSEL – WALKWAYS
ASSEMBLY AND DETAILS

CONTRACT NO./TITLE CW-I-WP4-2023-05/HOLLANDSE KUST NOORD WIND PARK | SCALE 1:5

DRAWN SPS | CHECKED A.BALZAROTTI | APPROVED CGI | DATE 22/09/25

A1 | DRAWING NO. 123A90-DDL-ST-DD-90125 | SHEET / SHEETS 005/005 | REV. 02

File Name : 123A90-DDL-ST-DD-90125_02.dwg