

DRAWING NO. 123A90-DDL-TI-DD-99015

REV. 03

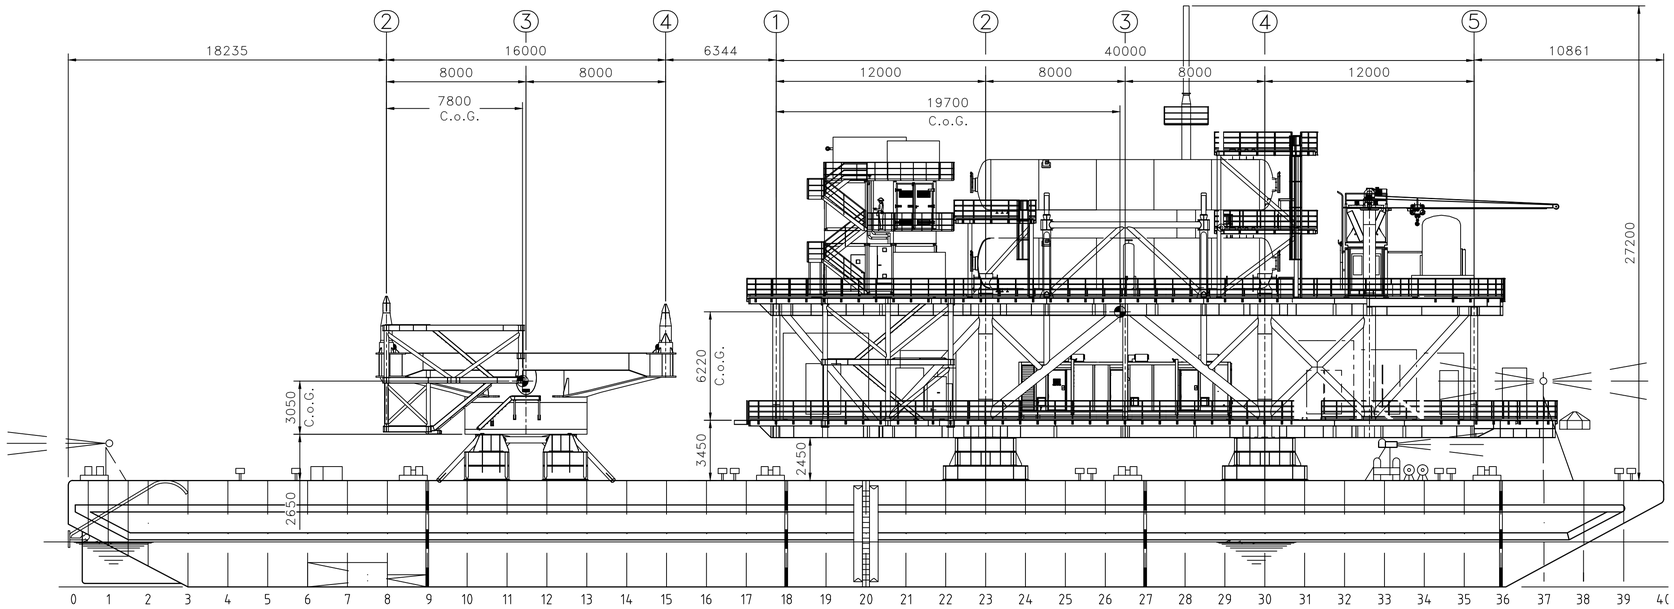


ELEVATION – LONGITUDINAL VIEW

SCALE 1:175

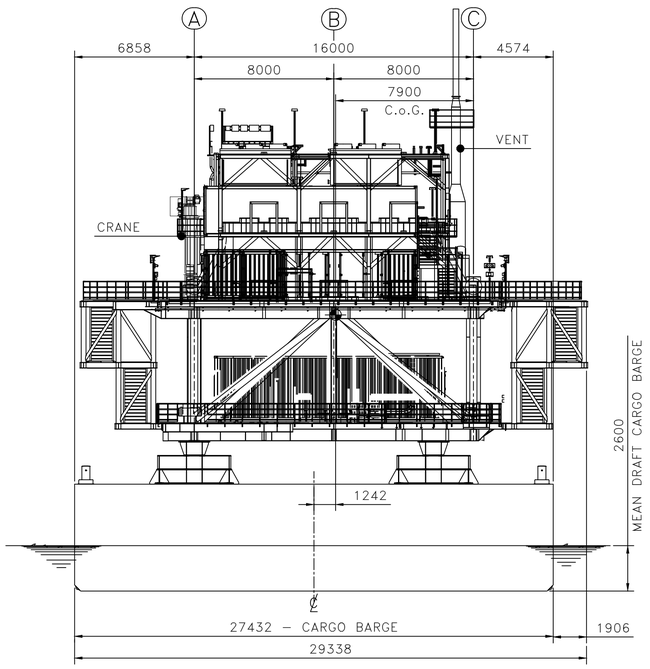


TOPSIDE – TRANSVERSAL SECTION

SCALE 1:175

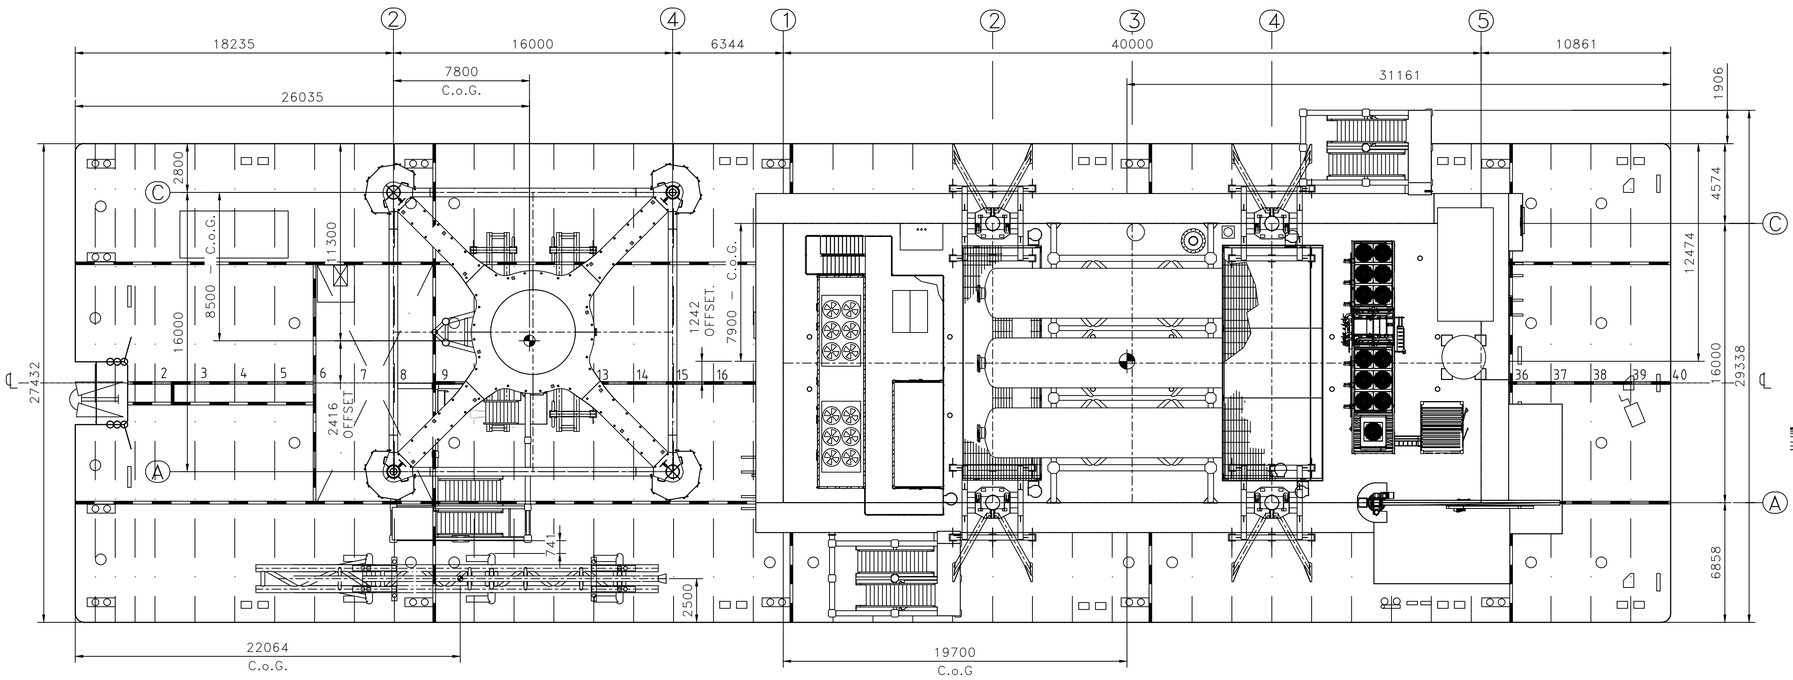

BARGE LAYOUT – VERVECE

SCALE 1:175

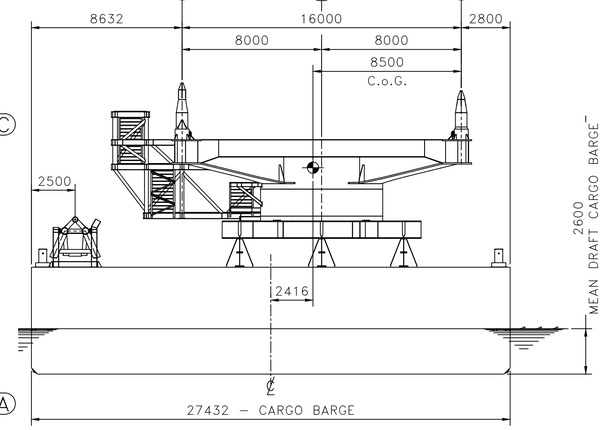

TP – TRANSVERSAL SECTION

SCALE 1:175

VERVECE		
LENGTH	300' 0"	91.440 m
BREADTH	90' 0"	27.432 m
DEPTH	20' 0"	6.096 m

UNIFORM DECK LOAD = 25 T/sqm

CLASS LR+ 100 A1 PONTOON

WELDING WHERE NOT SHOWN : ◺3.5

WEIGHT LIST	
TOPSIDE	= 1802 t
TP	= 290 t
TOPSIDE L.GRILLAGE & SF	= 75 t
TP L.GRILLAGE & SF	= 45 t
CAISSON FRAME	= 26 t
CAISSON GRILLAGE & SF	= 0.5 t

NOTES	HOLDS
1 – ALL DIMENSIONS AND ELEVATIONS ARE IN MILLIMETERS U.N.O. 2 – ALL ELEVATIONS ARE REFERED TO C.D.	

TECON

REV.	DATE	DRN	CHKD	APPD	DESCRIPTION
03	18/09/25	SPS	AB	CGI	AS-BUILT (ASB)
02	26/02/25	SGR	AB	DLS	ACCEPTED FOR CONSTRUCTION (AFC)
01	07/10/24	SGR	AB	DLS	ACCEPTED FOR CONSTRUCTION (AFC)
00	12/01/24	SGR	AB	DLS	ISSUE FOR REVIEW (IFR)

CROSSWIND

ROSETTI MARINO

TITLE : BASE LOAD POWER HUB (BLPH)
BARGE LAYOUT

CONTRACT NO./TITLE CW-I-WP4-2023-05/HOLLANDSE KUST NOORD WIND PARK | SCALE 1:175

DRAWN SPS | CHECKED A.BALZAROTTI | APPROVED CGI | DATE 18/09/25

A1 | DRAWING NO. 123A90-DDL-TI-DD-99015 | SHEET 001 | REV. 03

File Name : 123A90-DDL-TI-DD-99015 REV.03.dwg