


DRAWING NO. 123A90-DDL-TI-DD-99042 REV. 03

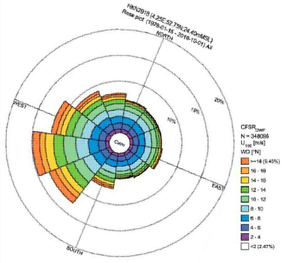


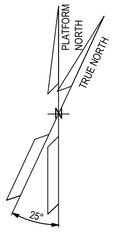

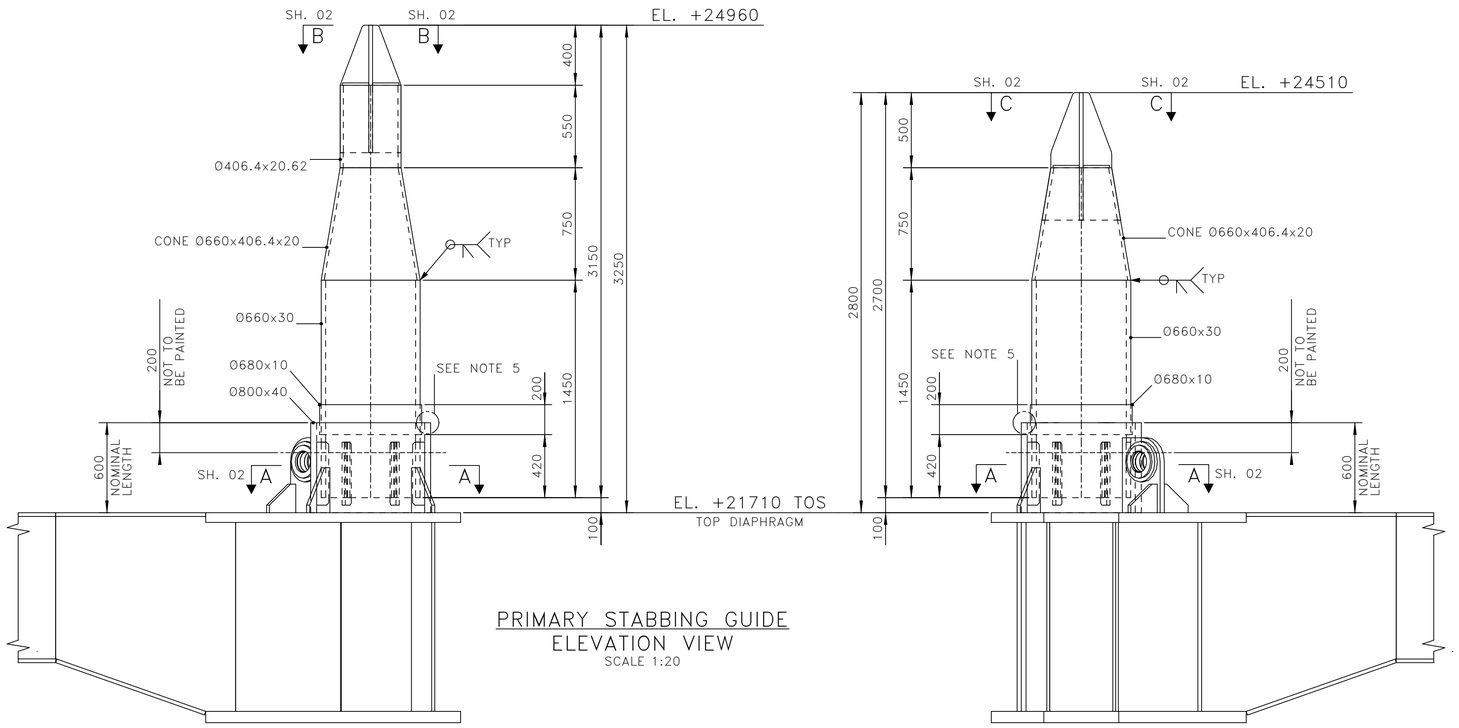


PRIMARY STABBING GUIDE
ELEVATION VIEW
SCALE 1:20

SECONDARY STABBING GUIDE
ELEVATION VIEW
SCALE 1:20

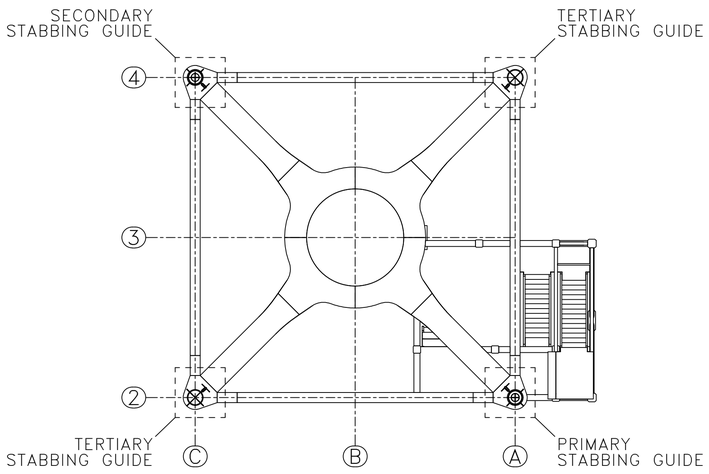

TP – KEY PLAN
SCALE 1:150

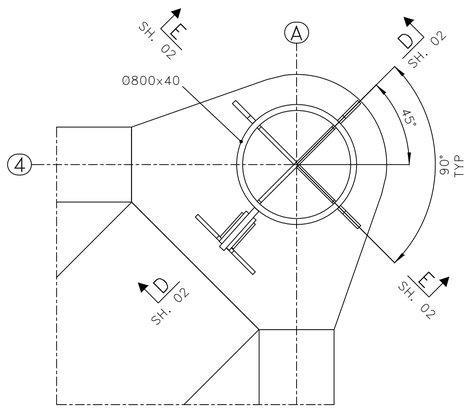

TERTIARY STABBING GUIDE
PLAN VIEW
No.2 TOT. REQ'D
SCALE 1:20

NOTES

1 – ALL DIMENSIONS AND ELEVATIONS ARE IN MILLIMETERS U.N.O.
2 – ALL ELEVATIONS ARE REFERED TO C.D.
3 – ALL WELDS ARE FULL PENETRATION WELDS U.N.O.
4 – ALL FILLET WELDS SHALL BE CONTINUOUS AND THE LEG SIZE SHALL BE EQUAL 0.7 THE MINIMUM THICKNESS TO BE JOINTED U.N.O.
5 – BEVELLED AND PRESERVED BY ROSETTI MARINO, REFERENCE DWG. No.123A90-DDL-ST-DD-90054

02

MATERIALS

ITEM IDENTIFICATION	MATERIAL DESIGNATION
Ø660x406.4x20	DC2-II-460-20
Ø660x30	DC2-II-460-40
Ø680x10	DC3-II-355-0
Ø406.4x20.62	DC3-II-355-40

HOLDS

REFERENCE DRAWINGS

DWG No.	DESCRIPTION
123A90-DDL-ST-DD-90025	DRAWING LIST
123A90-DDL-ST-DD-90026	GENERAL NOTES
123A90-DDL-ST-DD-90027	WELDING GENERAL NOTES
123A90-DDL-ST-DD-90032	PLATES – DOUBLE SIDED WELDS
123A90-DDL-ST-DD-90033	PLATES – SINGLE SIDED WELDS
123A90-DDL-ST-DD-90054	TOPSIDE TO TP WELD CONNECTION – DETAILS
123A90-DDL-ST-DD-90085	TP – PRIMARY STEEL – PLAN AT EL +21710 TOS
123A90-DDL-ST-DD-90086	TP – TOPSIDE SUPPORT POINT
123A90-DDL-TI-DD-90042	TP – STABBING GUIDES – SHEET 2

TECON

REV.	DATE	DRN	CHKD	APPD	DESCRIPTION
03	18/09/25	SPS	AB	CGI	AS-BUILT (ASB)
02	24/10/24	SGR	AB	DLS	ACCEPTED FOR CONSTRUCTION (AFC)
01	22/08/24	SGR	AB	DLS	ACCEPTED FOR CONSTRUCTION (AFC)
00	12/07/24	SGR	AB	DLS	ISSUE FOR REVIEW (IFR)

CROSSWIND

ROSETTI MARINO

TITLE :
BASE LOAD POWER HUB (BLPH)
TP – INSTALLATION AIDS
STABBING GUIDES – ASSEMBLY AND DETAILS


CONTRACT NO./TITLE CW-I-WP4-2023-05/HOLLANDSE KUST NOORD WIND PARK | SCALE 1:20

DRAWN SPS | CHECKED A.BALZAROTTI | APPROVED CGI | DATE 18/09/25


A1 | DRAWING NO. 123A90-DDL-TI-DD-99042 | SHEET / SHEETS 001/002 | REV. 03

File Name : 123A90-DDL-TI-DD-99042_03.dwg


DRAWING NO. 123A90-DDL-TI-DD-99042 | REV. 03

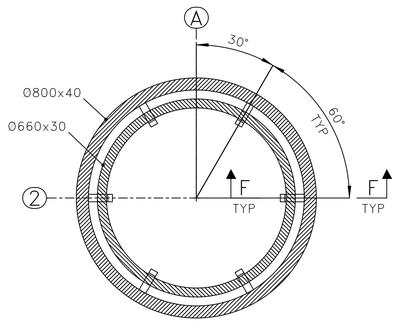


SECTION A – A
123A90-DDL-TI-DD-99042-001
SCALE 1:10

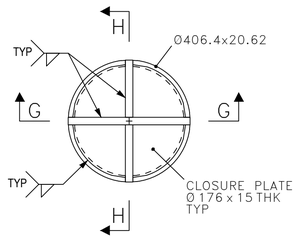


SECTION B – B
123A90-DDL-TI-DD-99042-001
SCALE 1:10

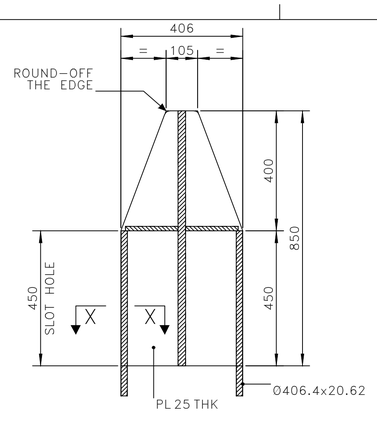


SECTION G – G
SCALE 1:10

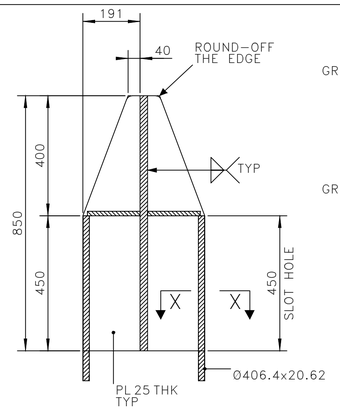


SECTION H – H
SCALE 1:10

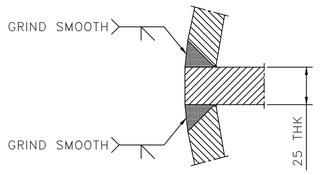


SECTION X–X
SCALE 1:2

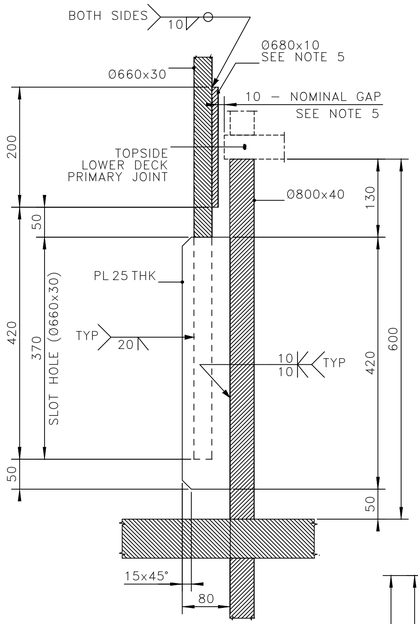


SECTION F – F
SCALE 1:5

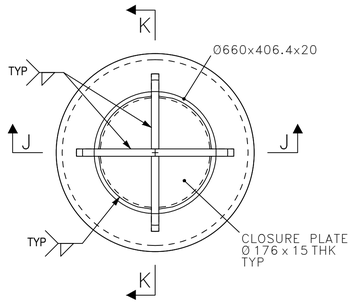


SECTION C – C
123A90-DDL-TI-DD-99042-001
SCALE 1:10

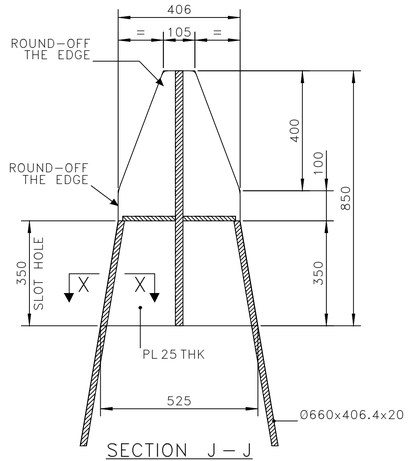


SECTION J – J
SCALE 1:10

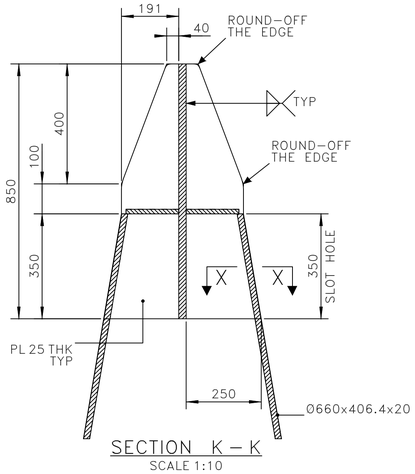

SECTION K – K
SCALE 1:10

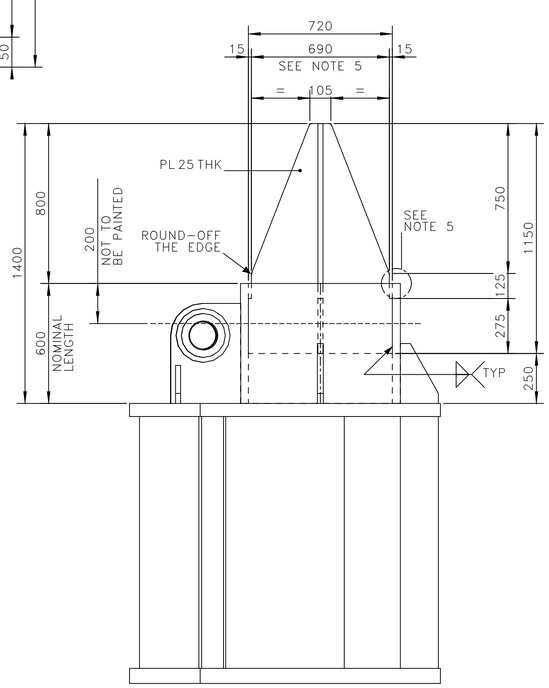

SECTION D – D
123A90-DDL-TI-DD-99042-001
SCALE 1:15

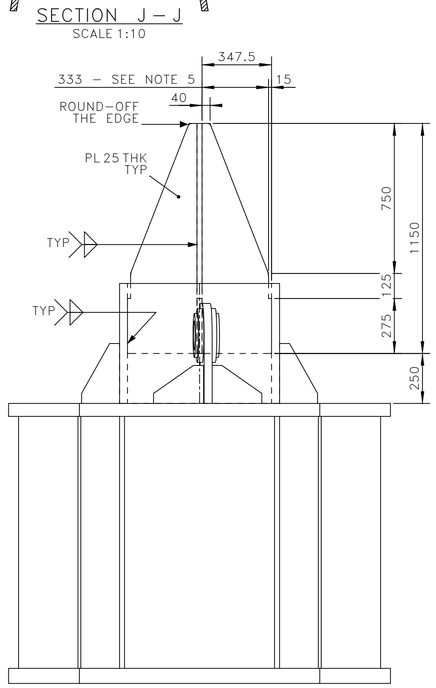

SECTION E – E
123A90-DDL-TI-DD-99042-001
SCALE 1:15

NOTES

1 – ALL DIMENSIONS AND ELEVATIONS ARE IN MILLIMETERS U.N.O.
2 – ALL ELEVATIONS ARE REFERED TO C.D.
3 – ALL WELDS ARE FULL PENETRATION WELDS U.N.O.
4 – ALL FILLET WELDS SHALL BE CONTINUOUS AND THE LEG SIZE SHALL BE EQUAL 0.7 THE MINIMUM THICKNESS TO BE JOINTED U.N.O.
5– THICKNESS/DIMENSIONS WILL BE CONFIRMED AFTER DIMENSIONAL CONTROL.
6 – BEVELLED AND PRESERVED BY ROSETTI MARINO, REFERENCE DWG. No.123A90–DDL–ST–DD–90054

MATERIALS

ITEM IDENTIFICATION	MATERIAL DESIGNATION
Ø660x406.4x20	DC2–II–460–20
Ø660x30	DC2–II–460–40
PL 15 THK	DC3–II–355–0
Ø680x10	DC3–II–355–0
PL 25 THK	DC3–II–355–20
Ø406.4x20.62	DC3–II–355–40

HOLDS

REFERENCE DRAWINGS

DWG No.	DESCRIPTION
123A90-DDL-ST-DD-90025	DRAWING LIST
123A90-DDL-ST-DD-90026	GENERAL NOTES
123A90-DDL-ST-DD-90027	WELDING GENERAL NOTES
123A90-DDL-ST-DD-90032	PLATES – DOUBLE SIDED WELDS
123A90-DDL-ST-DD-90033	PLATES – SINGLE SIDED WELDS
123A90-DDL-ST-DD-90051	TOPSIDE – LOWER DECK – JOINT –1– DETAIL
123A90-DDL-ST-DD-90085	TP – PRIMARY STEEL – PLAN AT EL +21710 TOS
123A90-DDL-ST-DD-90086	TP – TOPSIDE SUPPORT POINT
123A90-DDL-TI-DD-90042	TP – STABBING GUIDES – SHEET 1

TECON

REV.	DATE	DRN	CHKD	APPD	DESCRIPTION
03	18/09/25	SPS	AB	CGI	AS–BUILT (ASB)
02	24/10/24	SGR	AB	DLS	ACCEPTED FOR CONSTRUCTION (AFC)
01	22/08/24	SGR	AB	DLS	ACCEPTED FOR CONSTRUCTION (AFC)
00	12/07/24	SGR	AB	DLS	ISSUE FOR REVIEW (IFR)

CROSSWIND | ROSETTI MARINO

TITLE :
BASE LOAD POWER HUB (BLPH)
TP – INSTALLATION AIDS
STABBING GUIDES – ASSEMBLY AND DETAILS

CONTRACT NO./TITLE CW-I-WP4-2023-05/HOLLANDSE KUST NOORD WIND PARK | SCALE 1:20
DRAWN SPS | CHECKED A.BALZAROTTI | APPROVED CGI | DATE 18/09/25
A1 | DRAWING NO. 123A90-DDL-TI-DD-99042 | SHEET / SHEETS 002/002 | REV. 03

File Name : 123A90-DDL-TI-DD-99042_03.dwg