


DRAWING NO. 123A90-DDL-TI-DD-99043


REV. 02

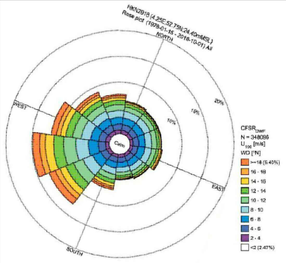

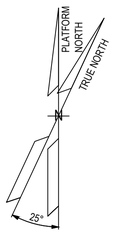

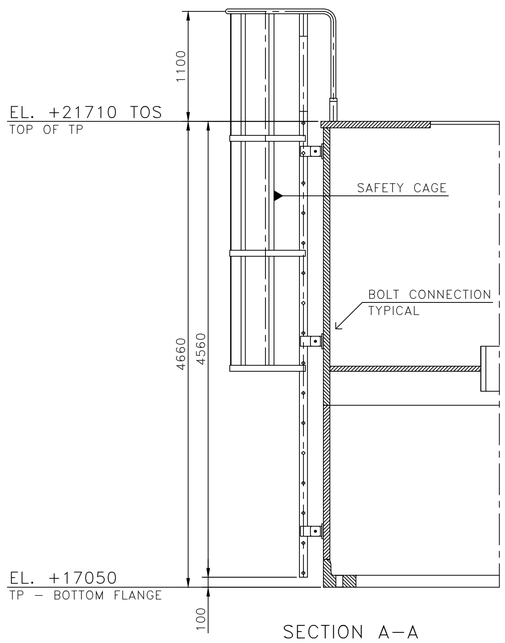

SECTION A–A
SCALE 1:30

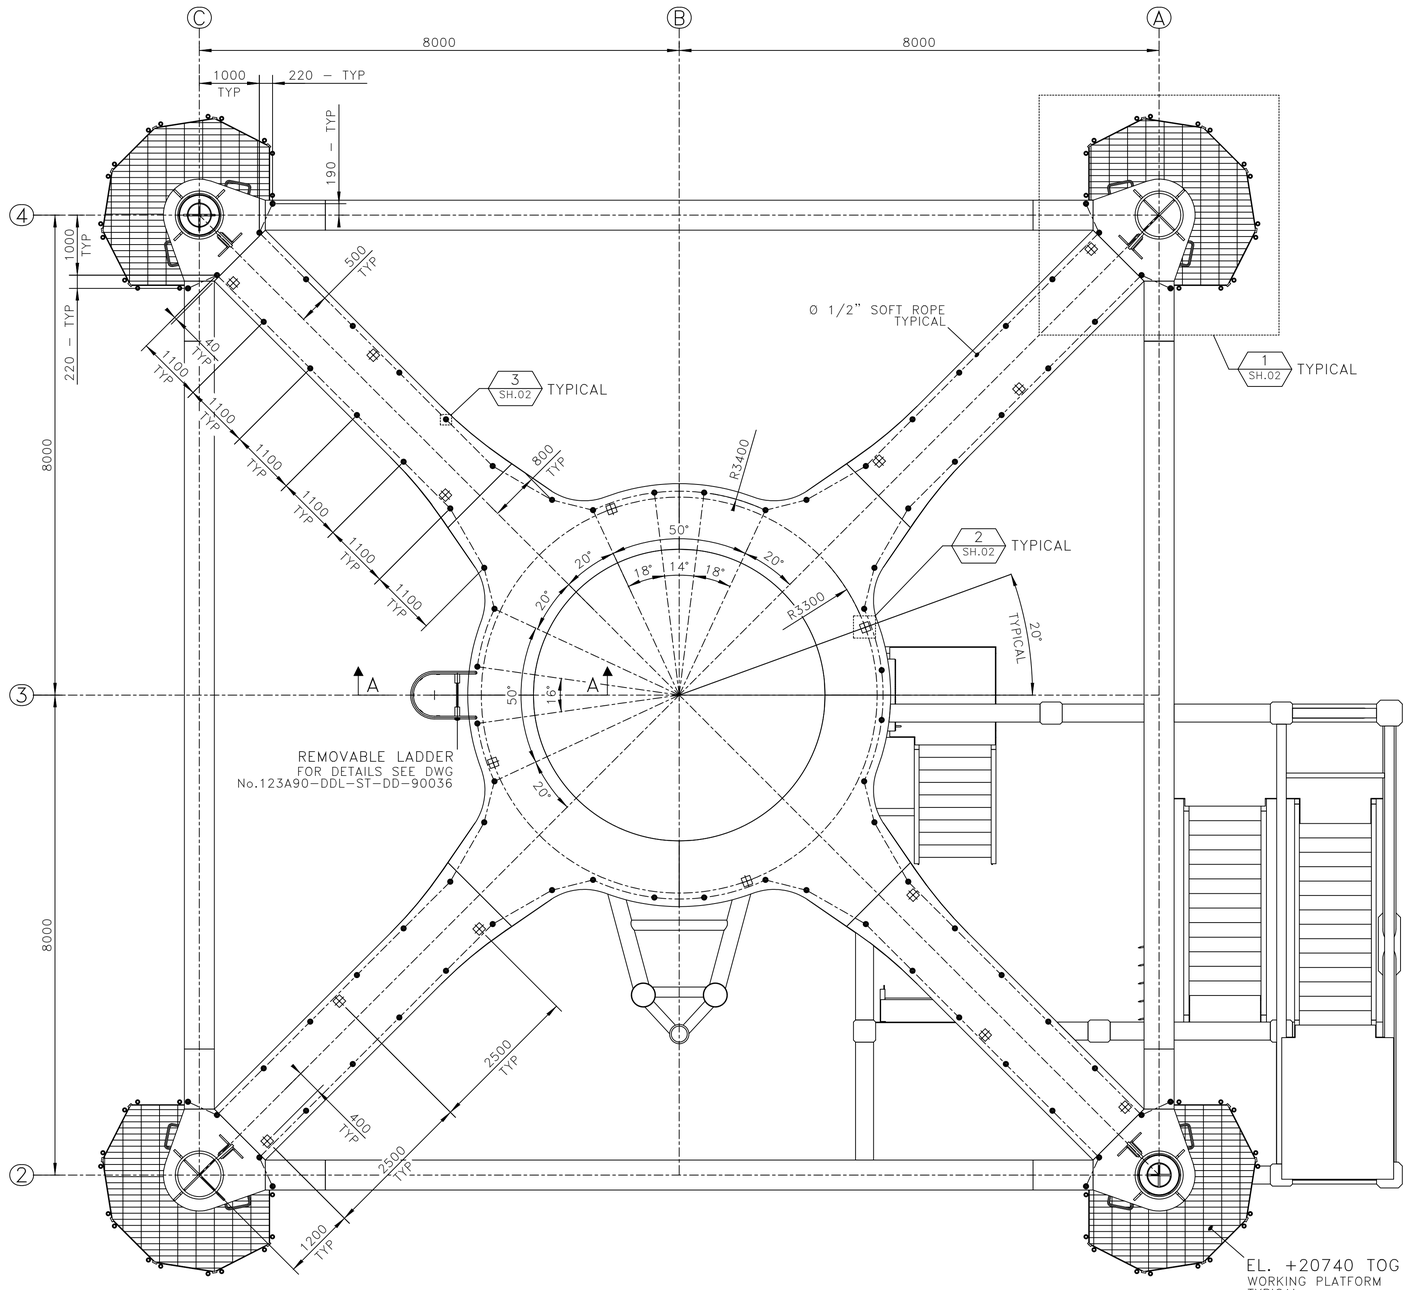

TP – TOP VIEW
SCALE 1:50

NOTES

1 – ALL DIMENSIONS AND ELEVATIONS ARE IN MILLIMETERS U.N.O.
2 – ALL ELEVATIONS ARE REFERED TO C.D.

MATERIALS

HOLDS

REFERENCE DRAWINGS

DWG No.	DESCRIPTION
123A90-DDL-ST-DD-90025	DRAWING LIST
123A90-DDL-ST-DD-90026	GENERAL NOTES
123A90-DDL-ST-DD-90036	STANDARD DRAWINGS – LADDERS
123A90-DDL-ST-DD-90085	TP – PRIMARY STEEL – PLAN AT EL +21710 TOS
123A90-DDL-TI-DD-90043	TP – WORKING PTF AND ANCHOR POINTS – SHEET 2

TECON

REV.	DATE	DRN	CHKD	APPD	DESCRIPTION
02	18/09/25	SPS	AB	CGI	AS-BUILT (ASB)
01	12/12/24	SGR	AB	DLS	ACCEPTED FOR CONSTRUCTION (AFC)
00	24/09/24	SGR	AB	DLS	ISSUE FOR REVIEW (IFR)

CROSSWIND

ROSETTI MARINO


TITLE :
BASE LOAD POWER HUB (BLPH)
TP – INSTALLATION AIDS
WORKING PLATFORM AND ANCHOR POINTS

CONTRACT NO./TITLE CW-I-WP4-2023-05/HOLLANDSE KUST NOORD WIND PARK | SCALE 1:50


DRAWN SPS | CHECKED A.BALZAROTTI | APPROVED CGI | DATE 18/09/25

A1 | DRAWING NO. 123A90-DDL-TI-DD-99043 | SHEET / SHEETS 001/002 | REV. 02


File Name : 123A90-DDL-TI-DD-99043_02.dwg

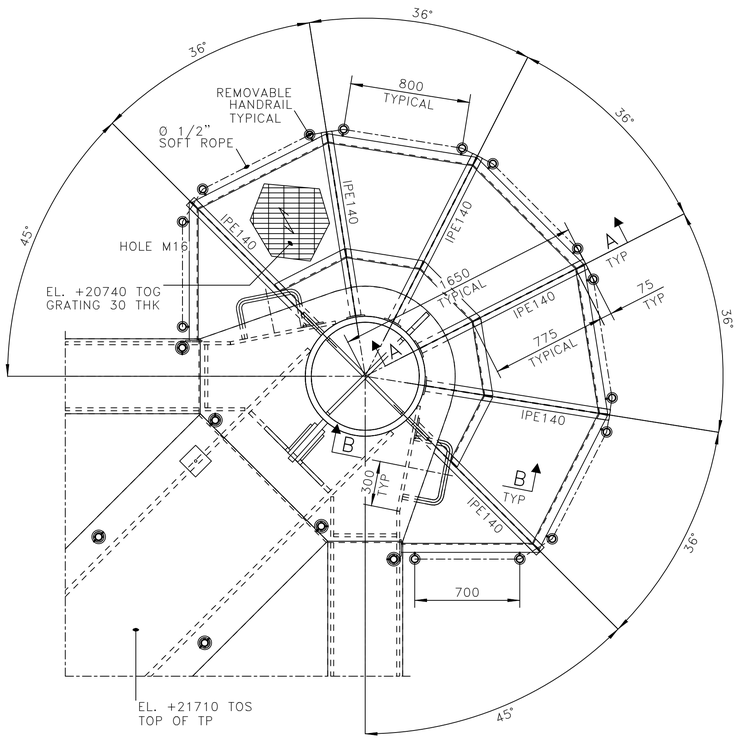


1 SH.01 DETAIL
SCALE 1:20
ALL BEAMS ARE UNP140 U.N.O.

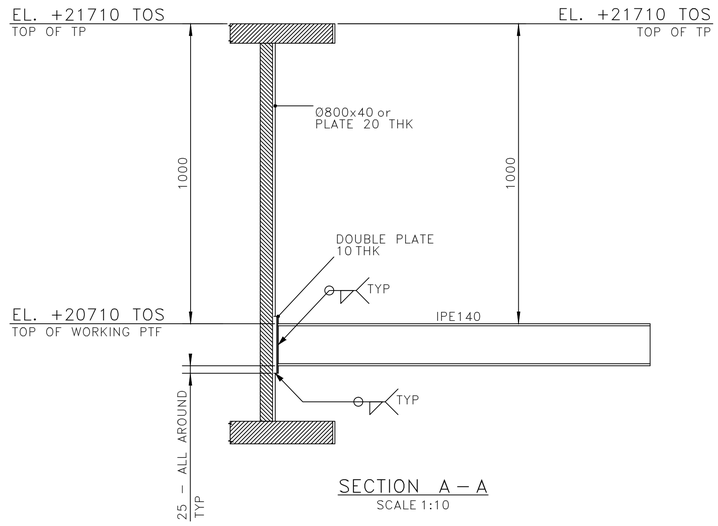


SECTION A – A
SCALE 1:10

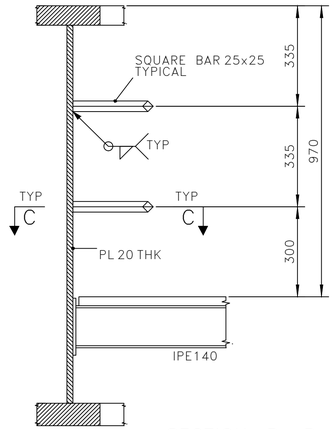


SECTION B – B
SCALE 1:10

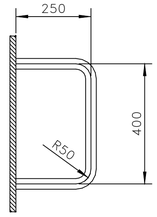

SECTION C – C
SCALE 1:10

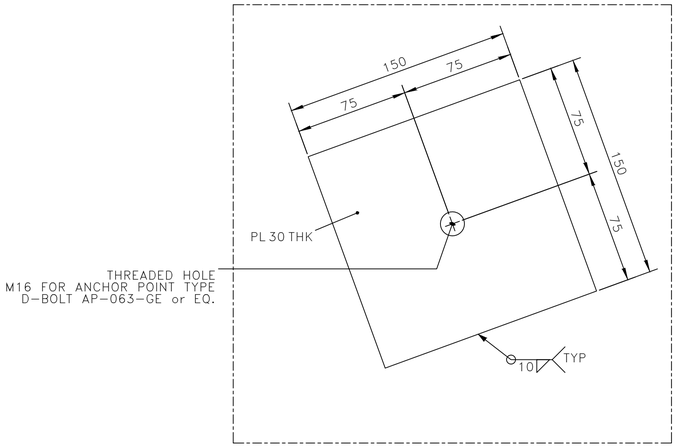

2 SH.01 DETAIL
SCALE 1:2

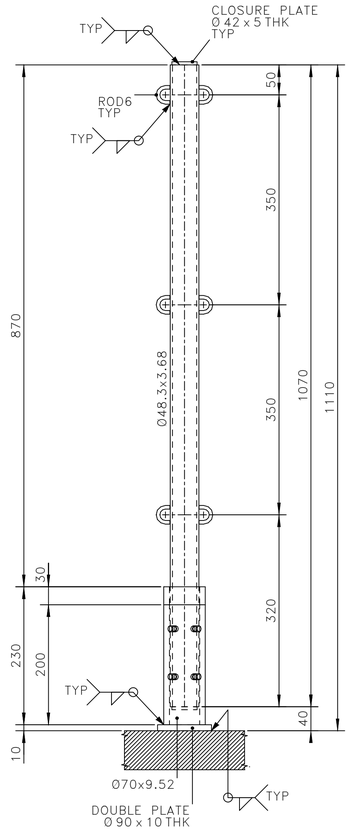

3 SH.01 DETAIL
SCALE 1:5

NOTES

1 – ALL DIMENSIONS AND ELEVATIONS ARE IN MILLIMETERS U.N.O.
2 – ALL ELEVATIONS ARE REFERED TO C.D.
3 – ALL WELDS ARE FULL PENETRATION WELDS U.N.O.
4 – ALL FILLET WELDS SHALL BE CONTINUOUS AND THE LEG SIZE SHALL BE EQUAL 0.7 THE MINIMUM THICKNESS TO BE JOINTED U.N.O.
5 – ALL MATERIALS ARE DC5-IV-275-10 U.N.O.

MATERIALS

ITEM IDENTIFICATION	MATERIAL DESIGNATION
PL 30 THK	DC5-IV-235-10_GRATING
IPE140	DC5-IV-275-10
PL 10 THK	DC5-IV-275-10
PL 30 THK	DC5-IV-275-10
UNP140	DC5-IV-275-10

HOLDS

REFERENCE DRAWINGS

DWG No.	DESCRIPTION
123A90-DDL-ST-DD-90025	DRAWING LIST
123A90-DDL-ST-DD-90026	GENERAL NOTES
123A90-DDL-ST-DD-90027	WELDING GENERAL NOTES
123A90-DDL-ST-DD-90032	PLATES – DOUBLE SIDED WELDS
123A90-DDL-ST-DD-90033	PLATES – SINGLE SIDED WELDS
123A90-DDL-ST-DD-90037	STANDARD DRAWINGS – HANDRAILS
123A90-DDL-TI-DD-90043	TP – WORKING PTF AND ANCHOR POINTS – SHEET 1

REV.	DATE	DRN	CHKD	APPD	DESCRIPTION
02	18/09/25	SPS	AB	CGI	AS-BUILT (ASB)
01	12/12/24	SGR	AB	DLS	ACCEPTED FOR CONSTRUCTION (AFC)
00	24/09/24	SGR	AB	DLS	ISSUE FOR REVIEW (IFR)

CROSSWIND

ROSETTI MARINO

TITLE :
BASE LOAD POWER HUB (BLPH)
TP – INSTALLATION AIDS
WORKING PLATFORM AND ANCHOR POINTS

CONTRACT NO./TITLE CW-I-WP4-2023-05/HOLLANDSE KUST NOORD WIND PARK | SCALE 1:20
DRAWN SPS | CHECKED A.BALZAROTTI | APPROVED CGI | DATE 18/09/25
A1 | DRAWING NO. 123A90-DDL-TI-DD-99043 | SHEET / SHEETS 002/002 | REV. 02

DRAWING NO. 123A90-DDL-TI-DD-99043
REV. 02

File Name : 123A90-DDL-TI-DD-99043_02.dwg