
DRAWING NO. 123A90-DDL-TI-DD-99047

REV. 02

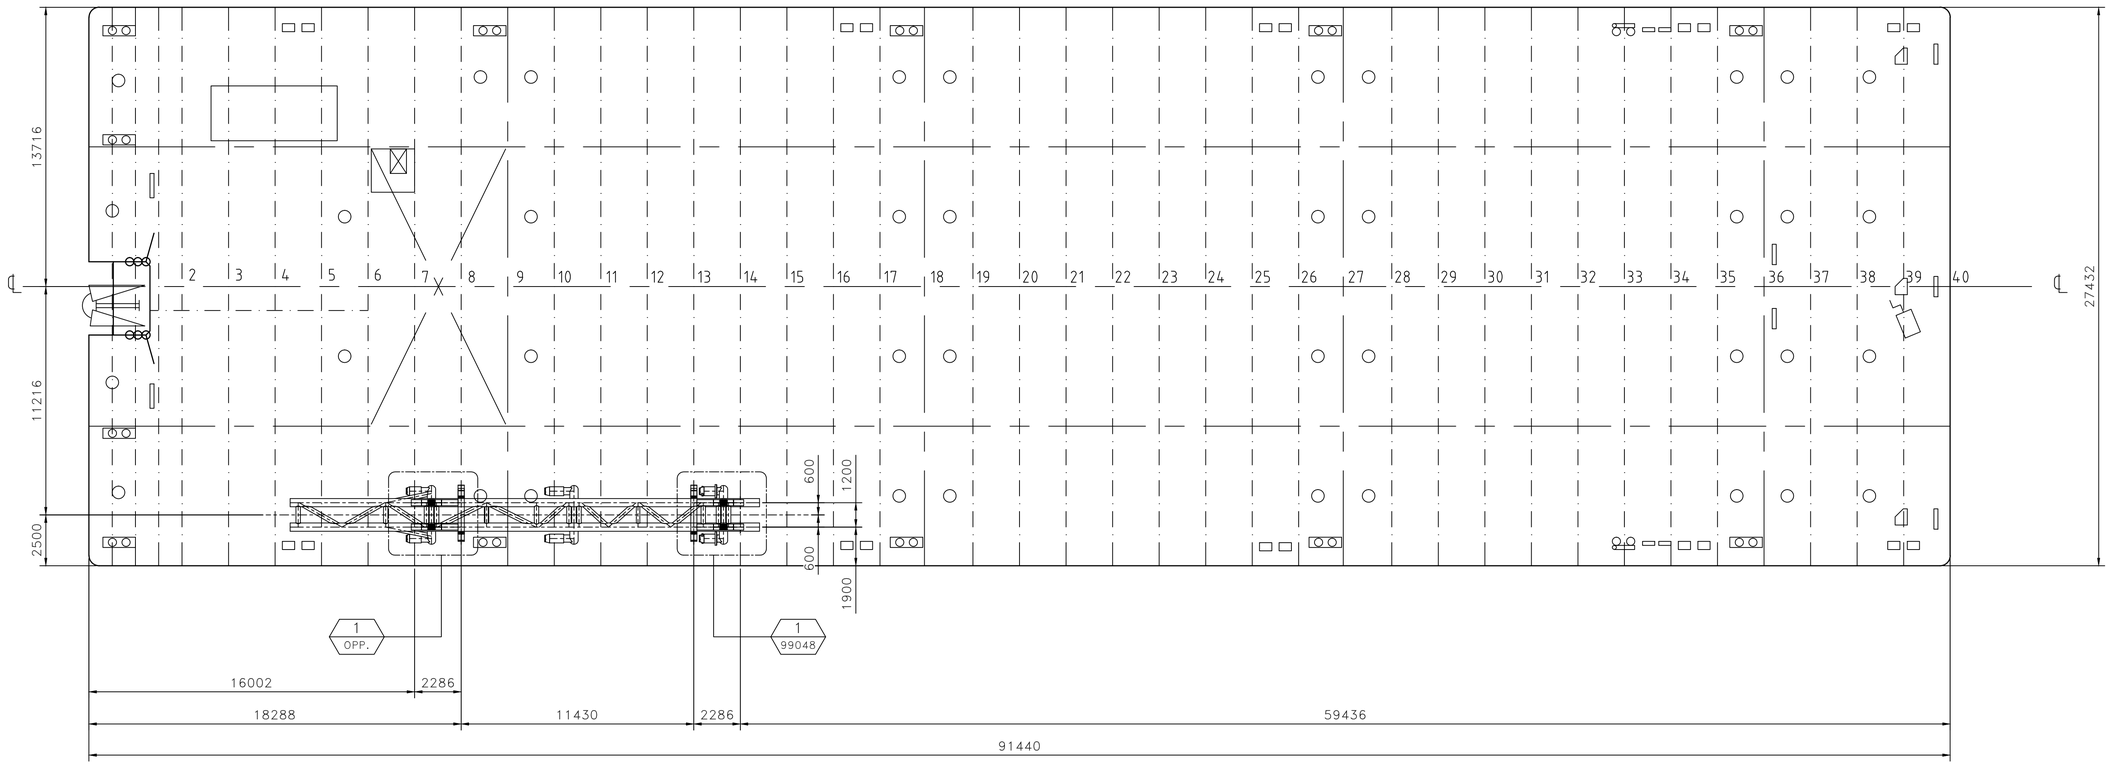

CAISSON FRAME – GRILLAGE & SEA FASTENING – ASSEMBLY

SCALE 1:150

NOTES

1 – ALL DIMENSIONS AND ELEVATIONS ARE IN MILLIMETERS U.N.O.
2 – ALL ELEVATIONS ARE REFERED TO C.D.

HOLDS

REFERENCE DRAWINGS

DWG No.	DESCRIPTION
123A90-DDL-ST-DD-90025	DRAWING LIST
123A90-DDL-ST-DD-90026	GENERAL NOTES
123A90-DDL-TI-DD-99048	CAISSON FRAME – GRILLAGE & SEA FASTENING – DETAILS

TECON

REV.	DATE	DRN	CHKD	APPD	DESCRIPTION
02	18/09/25	SPS	AB	CGI	AS-BUILT (ASB)
01	23/05/25	SGR	AB	DLS	ACCEPTED FOR CONSTRUCTION (AFC)
00	20/02/25	SGR	AB	DLS	ISSUE FOR REVIEW (IFR)

CROSSWIND

ROSETTI MARINO

TITLE :
BASE LOAD POWER HUB (BLPH)
CAISSON FRAME – GRILLAGE & SEA FASTENING ASSEMBLY

CONTRACT NO./TITLE	CW-I-WP4-2023-05/HOLLANDSE KUST NOORD WIND PARK		SCALE 1:150
DRAWN SPS	CHECKED A.BALZAROTTI	APPROVED CGI	DATE 18/09/25
A1	DRAWING NO. 123A90-DDL-TI-DD-99047	SHEET 001	REV. 02

File Name : 123A90-DDL-TI-DD-99047 REV.02.dwg