


DRAWING NO. 123A90-DDL-AR-DL-10015 REV. 02

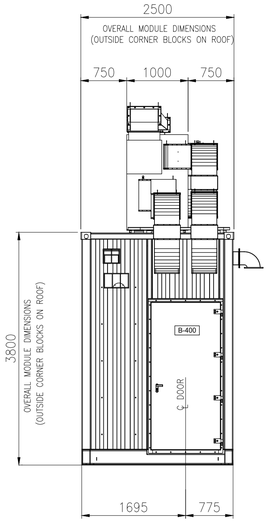


EAST VIEW

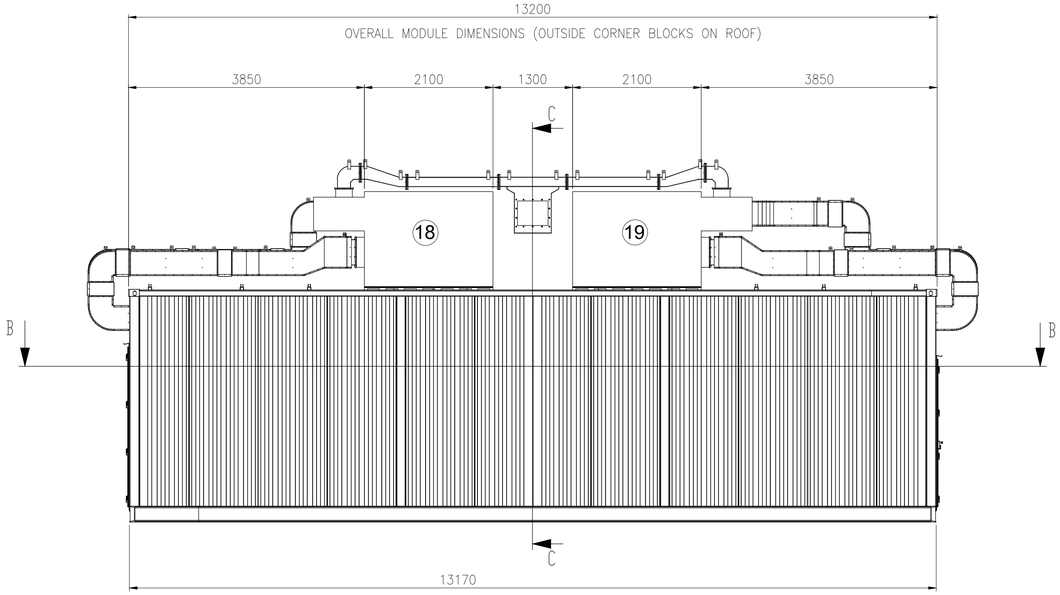

SOUTH VIEW

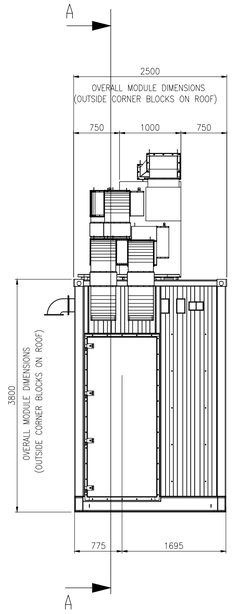

WEST VIEW

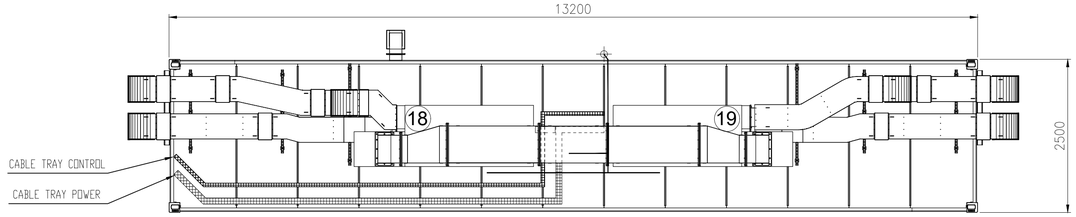


TOP VIEW

EQUIPMENT LIST

REF.	TAG No.	DESCRIPTION	LENGTH (mm)	WIDTH (mm)	HEIGHT (mm)	WEIGHT (Kg)
1	UP-200F3	AC UPS 35kVA	2400	860	1915	2258
2	UP-200F4	AC UPS 15kVA	2400	860	1915	2258
3	BA-200F3A	BATTERY RACK GEL VRLA 7y AC UPS 35kVA	1050	725	1272	914
4	BA-200F3B	BATTERY RACK GEL VRLA 7y AC UPS 35kVA	1050	725	1272	914
5	BA-200F4A	BATTERY RACK GEL VRLA 7y AC UPS 15kVA	1890	725	1761	3429
6	BA-200F4B	BATTERY RACK GEL VRLA 7y AC UPS 15kVA	1890	725	1761	3429
7	CB-200F3A	ISOLATOR BOX AC UPS 35kVA	600	300	800	100
8	CB-200F3B	ISOLATOR BOX AC UPS 35kVA	600	300	800	100
9	CB-200F4A	ISOLATOR BOX AC UPS 15kVA	600	300	800	100
10	CB-200F4B	ISOLATOR BOX AC UPS 15kVA	600	300	800	100
11	NC-200F2	NAVAID PANEL	1000	800	2600	535
12	BA-200F2	BATTERY BOX NAVAID	958	993	1210	1552
13	CB-200F2	ISOLATOR BOX NAVAID	500	400	765	70
14	B300-HSB-001	DISTRIBUTION & HVAC PANEL - AC/UPS ROOM	1600	600	2300	500
15	-	EYE WASH STATION	228	80	290	5
16	-	PORTABLE EXTINGUISHER (CO2) 5 Kg.	150	150	750	20
17	-	PORTABLE EXTINGUISHER (CO2) 5 Kg.	150	150	750	20
18	BC-200F2	BATTERY CHARGER NAVAID	607	607	2157	500
19	HHU-77005	AIR HANDLING UNIT A	2100	1000	2158	850
20	HHU-77006	AIR HANDLING UNIT B	2100	1000	2158	850
21	HSS-77-007	SPACE HEATER 1	184	145	1100	5
22	HSS-77-008	SPACE HEATER 2	184	145	1100	5
23	HSS-77-009	SPACE HEATER 3	184	145	1100	5

"B-400" I&T EQUIPMENT ROOM

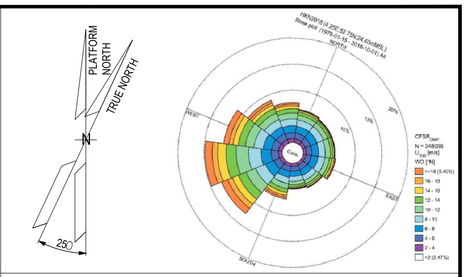

NOTES

1. U.N.O. ALL DIMENSIONS ARE IN MILLIMETERS.
2. ALL WELDS MUST BE CONTINUOUS, SPOT WELDS ARE NOT PERMITTED

LEGEND


- INTERNAL LIGHT
- E INTERNAL EMERGENCY LIGHT
- SOCKET OUTLET, INDOOR
- LIGHT SWITCH
- _____ ESCAPE CORRIDOR – WIDTH 800mm.
- _____ MAINTENANCE AREA – VENDOR REQUIREMENT
- _____ INSULATION PANEL

REFERENCE

DOCUMENT TITLE	DOCUMENT NUMBER
I&T Equipment Room – Supply Specification	123A90-DDL-AR-SP-10014
I&T Equipment Room – Material Requisition	123A90-DDL-AR-MR-10019
I&T Equipment Room – Doors Map and Schedule	123A90-DDL-AR-DL-10016
I&T Equipment Room – Flooring and Lining Layout	123A90-DDL-AR-DL-10017
I&T Equipment Room – Fire rated requirement layout (plan, section, typical detail)	123A90-DDL-AR-DL-10018
I&T Equipment Room – Equipment Layout	23A90-DDL-IN-DL-40012
B-400 General Arramgement Dwg's (by Vendor)	1724000049-AR-DA-00017
B-400 Detail Dwg's (by Vendor)	1724000049-AR-DD-00021
B-400 Structural Calculation (by Vendor)	1724000049-ST-CA-00009
B-400 Foundation Dwg (by Vendor)	1724000049-ST-DD-00013
Lifting Drawings (by Vendor)	1724000049-AR-DD-00062

HOLDS

KEY PLAN

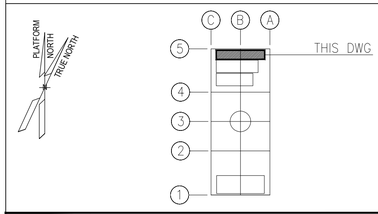

STILOG

REV.	DATE	DRN	CHKD	APPD	DESCRIPTION
02	18/09/25	SPS	M. GA	CGI	AS-BUILT (ASB)
01	23/02/24	R. BO	M. GA	D. LO	ACCEPTED FOR CONSTRUCTION (AFC)
00	30/10/23	R. BO	M. GA	D. LO	ISSUE FOR REVIEW (IFR)

CROSSWIND


ROSETTI MARINO

TITLE : BASE LOAD POWER HUB (BLPH)
I&T EQUIPMENT ROOM B-400 – ARCHITECTURAL
GENERAL LAYOUT – PLAN, WIEW, SECT. & TYP. DET.


CONTRACT NO./TITLE CW-I-WP4-2023-05/HOLLANDSE KUST NOORD WIND PARK			SCALE 1:50
DRAWN SPS	CHECKED M. GATTI	APPROVED CGI	DATE 18/09/25
A1	DRAWING NO. 123A90-DDL-AR-DL-10015	SHEET 001	REV. 02

File Name : 123A90-DDL-AR-DL-10015 REV.02


DRAWING NO. 123A90-DDL-AR-DL-10015 REV. 02

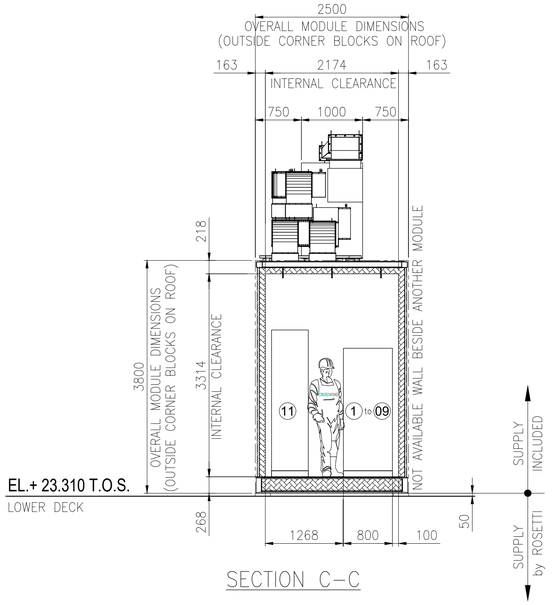



SECTION C–C

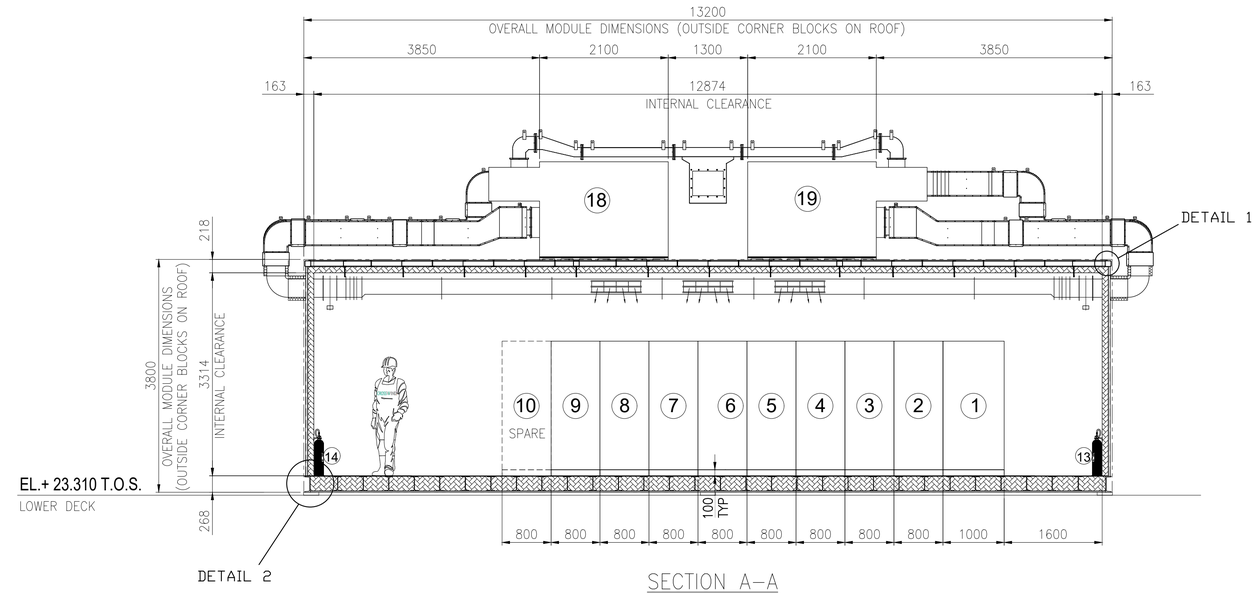


SECTION A–A

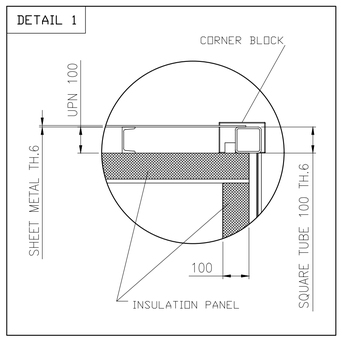


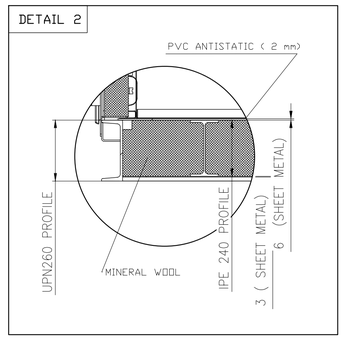

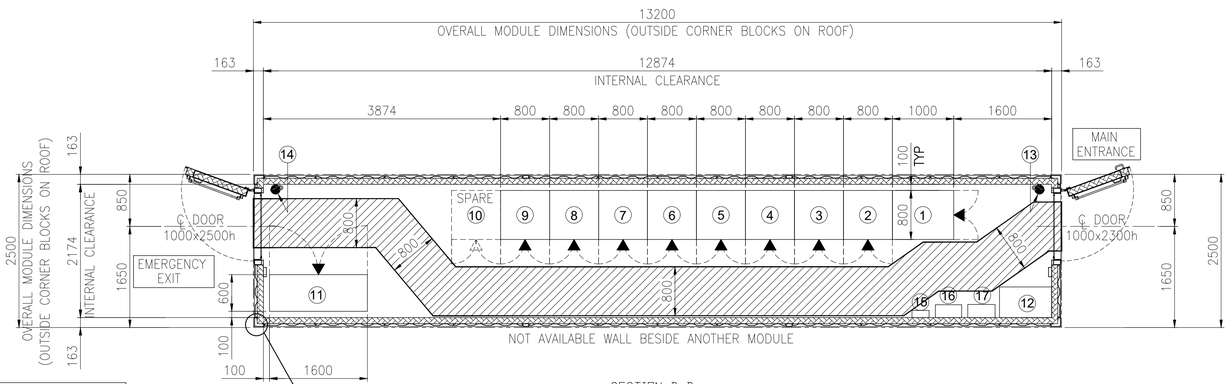

13200
OVERALL MODULE DIMENSIONS (OUTSIDE CORNER BLOCKS ON ROOF)
163
12874
INTERNAL CLEARANCE
163
3874
800
800
800
800
800
800
800
800
1000
1600
MAIN
ENTRANCE
14
100
TYP
13
2500
OVERALL MODULE DIMENSIONS
(OUTSIDE CORNER BLOCKS ON ROOF)
163
850
2174
INTERNAL CLEARANCE
1650
163
SPARE
10
9
8
7
6
5
4
3
2
1
800
800
800
800
800
800
800
800
800

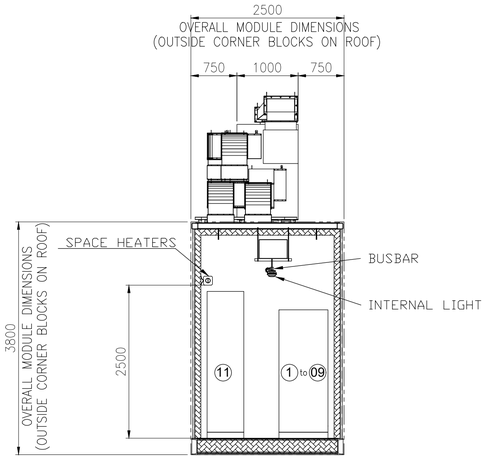

SECTION E-E

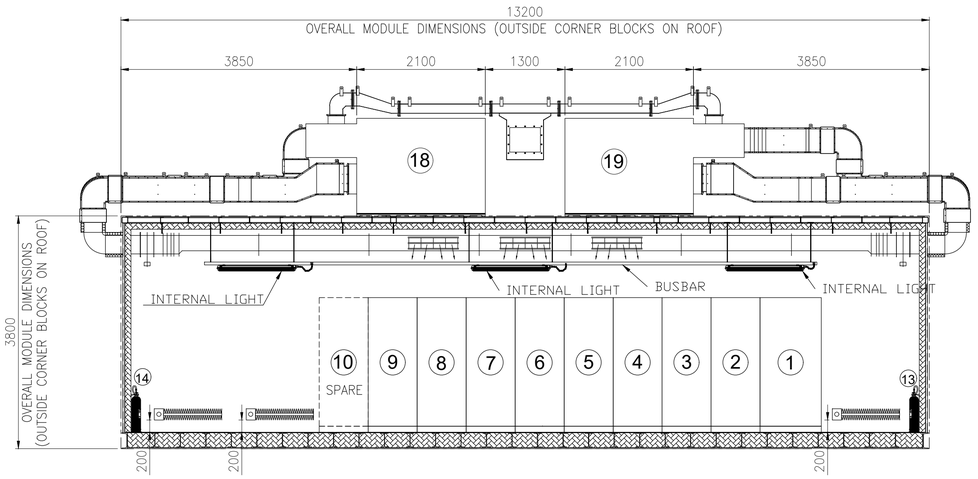


SECTION D-D

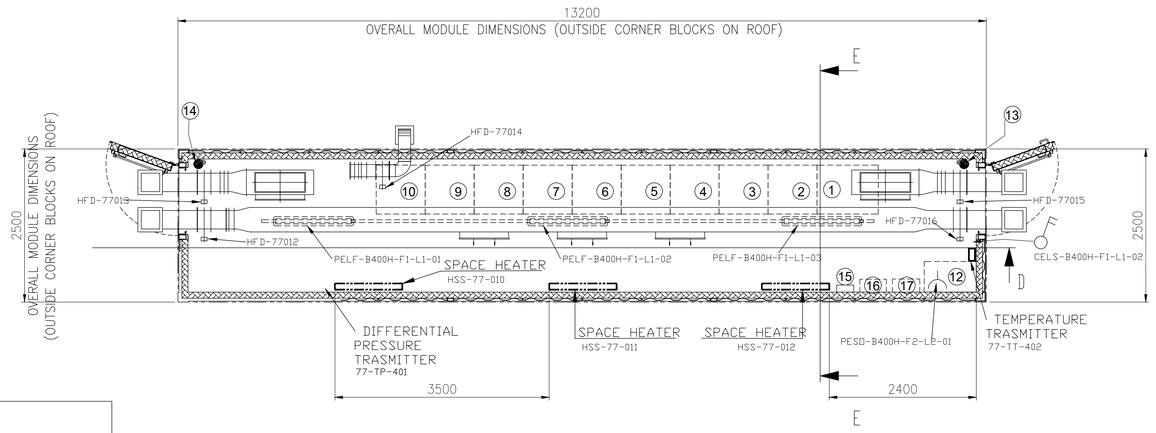

"B-400" I&T EQUIPMENT ROOM PLAN

EQUIPMENT LIST

REF.	TAG No.	DESCRIPTION	LENGTH (mm)	WIDTH (mm)	HEIGHT (mm)	WEIGHT (Kg)
1	UP-200F3	AC UPS 35kVA	2400	860	1915	2258
2	UP-200F4	AC UPS 15kVA	2400	860	1915	2258
3	BA-200F3A	BATTERY RACK GEL VRLA 7y AC UPS 35kVA	1050	725	1272	914
4	BA-200F3B	BATTERY RACK GEL VRLA 7y AC UPS 35kVA	1050	725	1272	914
5	BA-200F4A	BATTERY RACK GEL VRLA 7y AC UPS 15kVA	1890	725	1761	3429
6	BA-200F4B	BATTERY RACK GEL VRLA 7y AC UPS 15kVA	1890	725	1761	3429
7	CB-200F3A	ISOLATOR BOX AC UPS 35kVA	600	300	800	100
8	CB-200F3B	ISOLATOR BOX AC UPS 35kVA	600	300	800	100
9	CB-200F4A	ISOLATOR BOX AC UPS 15kVA	600	300	800	100
10	CB-200F4B	ISOLATOR BOX AC UPS 15kVA	600	300	800	100
11	NC-200F2	NAVAID PANEL	1000	800	2600	535
12	BA-200F2	BATTERY BOX NAVAID	958	993	1210	1552
13	CB-200F2	ISOLATOR BOX NAVAID	500	400	765	70
14	B300-HSB-001	DISTRIBUTION & HVAC PANEL - AC/UPS ROOM	1600	600	2300	500
15	-	EYE WASH STATION	228	80	290	5
16	-	PORTABLE EXTINGUISHER (CO2) 5 Kg.	150	150	750	20
17	-	PORTABLE EXTINGUISHER (CO2) 5 Kg.	150	150	750	20
18	BC-200F2	BATTERY CHARGER NAVAID	607	607	2157	500
19	HHU-77005	AIR HANDLING UNIT A	2100	1000	2158	850
20	HHU-77006	AIR HANDLING UNIT B	2100	1000	2158	850
21	HSS-77-007	SPACE HEATER 1	184	145	1100	5
22	HSS-77-008	SPACE HEATER 2	184	145	1100	5
23	HSS-77-009	SPACE HEATER 3	184	145	1100	5

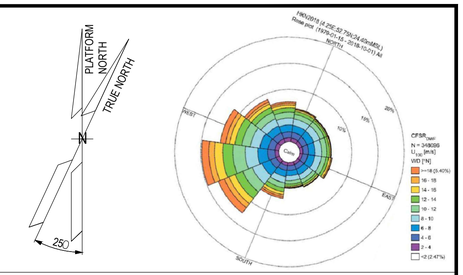

NOTES

1. U.N.O. ALL DIMENSIONS ARE IN MILLIMETERS.
2. ALL WELDS MUST BE CONTINUOUS, SPOT WELDS ARE NOT PERMITTED

LEGEND


- INTERNAL LIGHT
- E — INTERNAL EMERGENCY LIGHT
- SOCKET OUTLET, INDOOR
- LIGHT SWITCH
- ESCAPE CORRIDOR – WIDTH 800mm.
- MAINTENANCE AREA – VENDOR REQUIREMENT
- INSULATION PANEL

REFERENCE

DOCUMENT TITLE	DOCUMENT NUMBER
I&T Equipment Room – Supply Specification	123A90-DDL-AR-SP-10014
I&T Equipment Room – Material Requisition	123A90-DDL-AR-MR-10019
I&T Equipment Room – Doors Map and Schedule	123A90-DDL-AR-DL-10016
I&T Equipment Room – Flooring and Lining Layout	123A90-DDL-AR-DL-10017
I&T Equipment Room – Fire rated requirement layout (plan, section, typical detail)	123A90-DDL-AR-DL-10018
I&T Equipment Room – Equipment Layout	23A90-DDL-IN-DL-40012
B-400 General Arramgement Dwg's (by Vendor)	1724000049-AR-DA-00017
B-400 Detail Dwg's (by Vendor)	1724000049-AR-DD-00021
B-400 Structural Calculation (by Vendor)	1724000049-ST-CA-00009
B-400 Foundation Dwg (by Vendor)	1724000049-ST-DD-00013
Lifting Drawings (by Vendor)	1724000049-AR-DD-00062

HOLDS

KEY PLAN

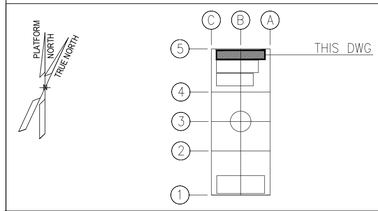

STILOG

REV.	DATE	DRN	CHKD	APPD	DESCRIPTION
02	18/09/25	SPS	M. GA	CGI	AS-BUILT (ASB)
01	23/02/24	R. BO	M. GA	D. LO	ACCEPTED FOR CONSTRUCTION (AFC)
00	30/10/23	R. BO	M. GA	D. LO	ISSUE FOR REVIEW (IFR)

CROSSWIND | ROSETTI MARINO

TITLE : BASE LOAD POWER HUB (BLPH)
I&T EQUIPMENT ROOM B-400 – ARCHITECTURAL
GENERAL LAYOUT – PLAN, WIEW, SECT. & TYP. DET.

CONTRACT NO./TITLE CW-I-WP4-2023-05/HOLLANDSE KUST NOORD WIND PARK			SCALE 1:50
DRAWN SPS	CHECKED M. GATTI	APPROVED CGI	DATE 18/09/25
A1	DRAWING NO. 123A90-DDL-AR-DL-10015	SHEET 003	REV. 02

File Name : 123A90-DDL-AR-DL-10015 REV.02