

DRAWING NO. 123A90-DDL-PP-DL-70070 REV. 04

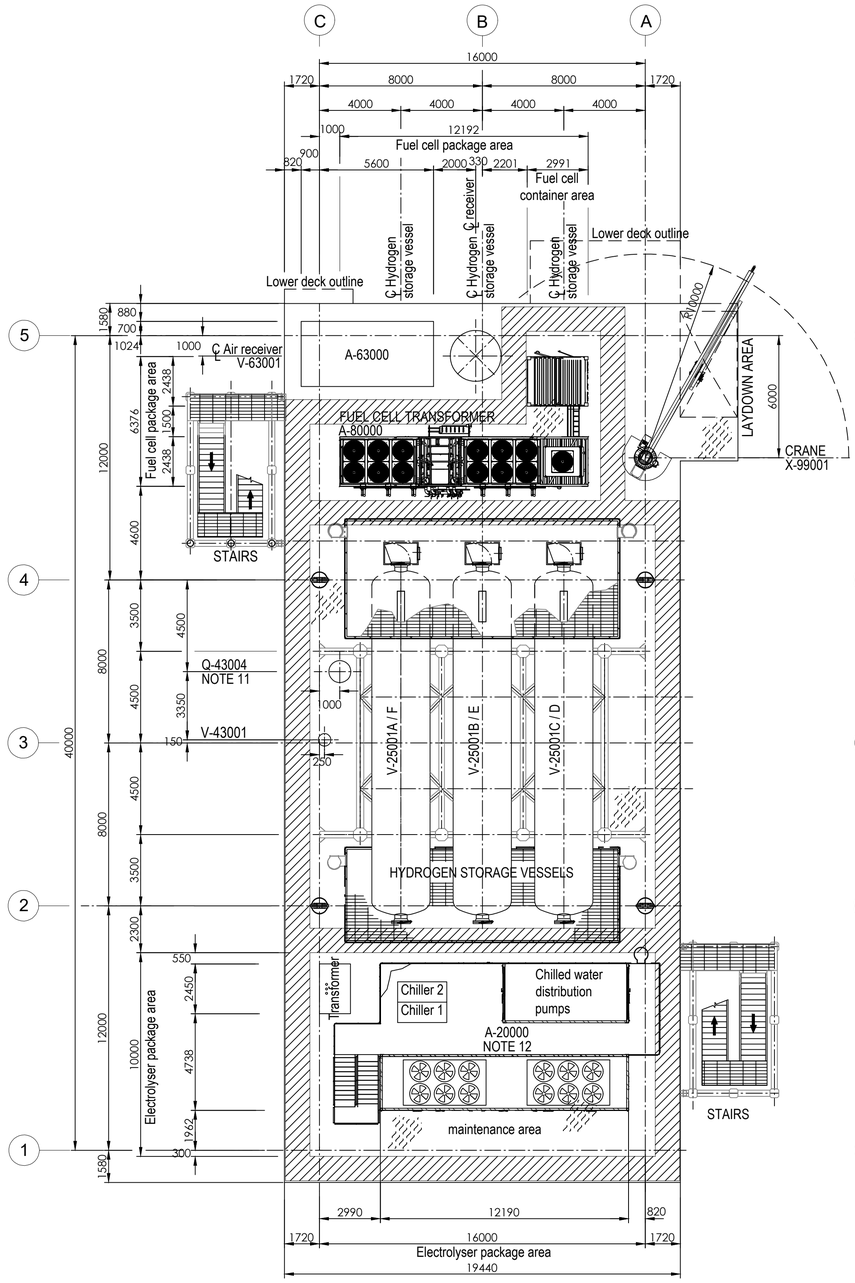


PLAN ON UPPER DECK
EL+30.310 T.O.S.

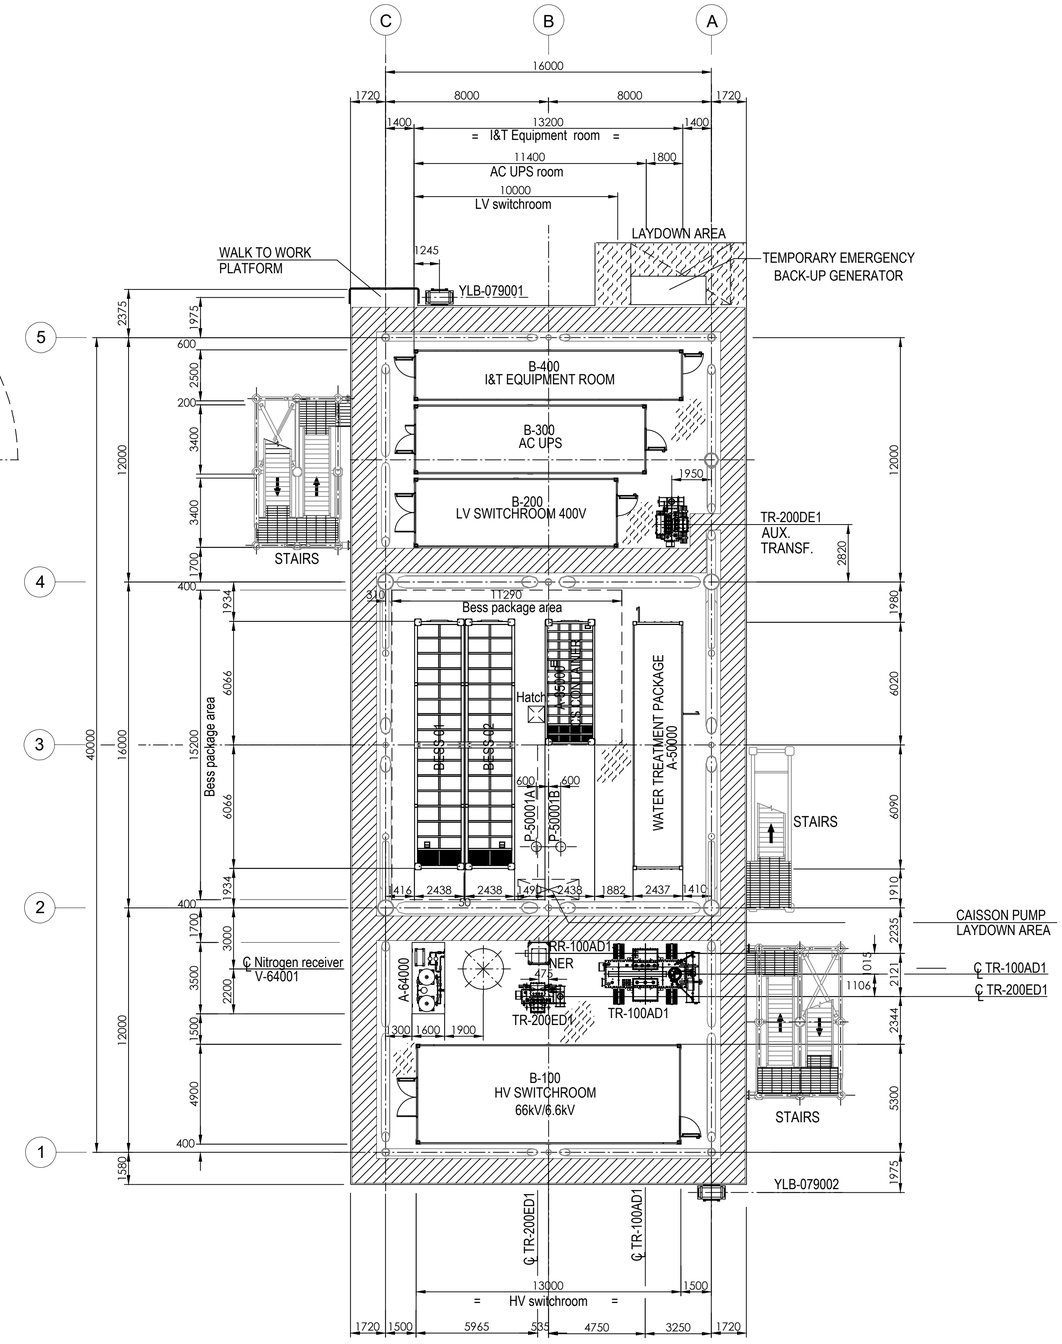

PLAN ON LOWER DECK
EL+23.310 T.O.S.

EQUIPMENT LIST

TAG NUMBER	DESCRIPTION	TAG NUMBER	DESCRIPTION
A-20000	ELECTROLYSER	V-25001A-F	HYDROGEN STORAGE VESSELS
		V-43001	HYDROGEN VENT KO DRUM
		YLB-079001/2	LIFE RAFTS
		B-100	HV/MV SWITCHROOM 66kV/6.6kV
		B-200	LV SWITCHROOM 400V
A-63000	INSTRUMENT AIR PACKAGE	B-300	AC UPS EQUIPMENT ROOM
A-80000	FUEL CELL	B-400	I&T EQUIPMENT ROOM
A-85000	BESS	TR-100AD1	TRANSFORMER MAIN 66kV/6.6kV
A-50000	WATER TREATMENT PACKAGE	TR-200DE1	TRANSFORMER AUX. 6.6kV/0.4kV
P-50001A/B	SEAWATER LIFT PUMPS	TR-200ED1	SOLAR TRANSFORMER PV FARM EQUIPMENT
		RR-100AD1-NER	NEUTRAL EARTHING RESISTOR
Q-43004	HYDROGEN VENT NOTE 11	V-63001	AIR RECEIVER
		V-64001	NITROGEN RECEIVER
		X-99001	CRANE
A-64000	NITROGEN SYSTEM		

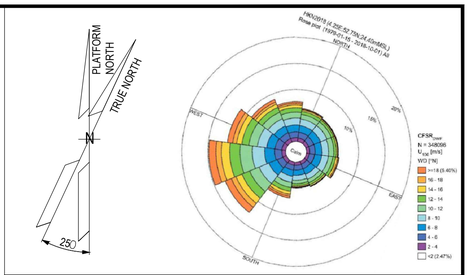

NOTES

1. ALL DIMENSIONS IN mm U.N.O
2. ALL ELEVATIONS IN METERS.
3. EQUIPMENT SIZES ARE BASED ON MASTER EQUIPMENT LIST 123A90-DDL-MAC-LIS-50000 AND VENDOR DWG. RECEIVED.
4. ALL ELEVATIONS RELATE TO LOWEST ASTRONOMICAL TIDE (LAT) = 0.000.
5. PLAN SHOWS PRIMARY ESCAPE/MATERIAL HANDLING ROUTES ONLY.
6. DELETED
7. MISCELLANEOUS SAFETY EQUIPMENT ARE SHOWN IN DOC. 123A90-DDL-SAF-DL-3002516_Escape Routes, Fire Fighting, Life Saving Equipment and Safety Equipment Layouts Drawings.
8. PREVAILING WIND DIRECTION INFLUENCING EQUIPMENT/VENT LAYOUT FROM THE SOUTH WEST.
9. PLATFORM NORTH DIRECTION IS N 25°W.
10. DELETED
11. LIQUID SEAL IS PART OF THE HYDROGEN VENT.
12. FOR ELECTROLYSER PACKAGE DETAILS SEE VENDOR DWG. C63-GAD-001
13. DELETED
14. ACCESS TO THE SECOND LEVEL OF THE PLATFORM ABOVE THE STORAGE VESSEL ON THE UPPER DECK (ELEVATION +38.6M) WILL BE PERMITTED FOR MAINTENANCE ACTIVITIES (e.g.,BDV/PSV VALVES) ONLY AFTER THE H2 STORAGE VESSELS HAVE BEEN COMPLETELY DEPRESSURIZED.
15. ACCESS TO THE ROOF OF ELECTROLYSER PACKAGE ON UPPER DECK (ELEVATION +36.8M) WILL BE PERMITTED FOR MAINTENANCE ACTIVITIES ONLY AFTER THE H2 STORAGE VESSELS HAVE BEEN COMPLETELY DEPRESSURIZED.

LEGEND

DENOTES PLATED DECK

ESCAPE/MATERIAL HANDLING ROUTE

DENOTES OPEN GRATING

HOLDS

1. DELETED
2. DELETED
3. DELETED
4. DELETED
5. DELETED
6. DELETED
7. DELETED
8. DELETED
9. DELETED

REFERENCE DOCUMENTS

123A90-DDL-PP-DS-70071	PLOT PLAN - BELOW LOWER DECK
123A90-DDL-PP-DS-70072	PLOT PLAN - ELEVATION LOOKING NORTH & EAST

REV.	DATE	DRN	CHKD	APPD	DESCRIPTION
04	17/11/25	SPS	CBO	CGI	AS-BUILT (ASB)
03	03/10/2025	SPS	CBO	CGI	AS-BUILT (ASB)
02	24/05/24	MMA	CBO	DLO	ACCEPTED FOR CONSTRUCTION (AFC)
01	07/02/24	MMA	CBO	DLO	ISSUE FOR REVIEW (IFR)
00	31/10/23	MMA	CBO	DLO	ISSUE FOR REVIEW (IFR)

CROSSWIND

ROSETTI MARINO

TITLE :
BASE LOAD POWER HUB (BLPH)
PLOT PLAN
LOWER & UPPER DECK

CONTRACT NO./TITLE CW-I-WP4-2023-05/HOLLANDSE KUST NOORD WIND PARK		SCALE 1:150	
DRAWN SPS	CHECKED C. BORTOLIN	APPROVED CGI	DATE 17/11/25
A1	DRAWING NO. 123A90-DDL-PP-DL-70070	SHEET 001	REV. 04

File Name : 123A90-DDL-PP-DL-70070 Rev04