

DRAWING NO. 123A90-DDL-ST-DA-90087

REV. 03

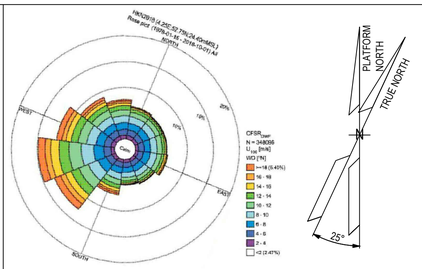


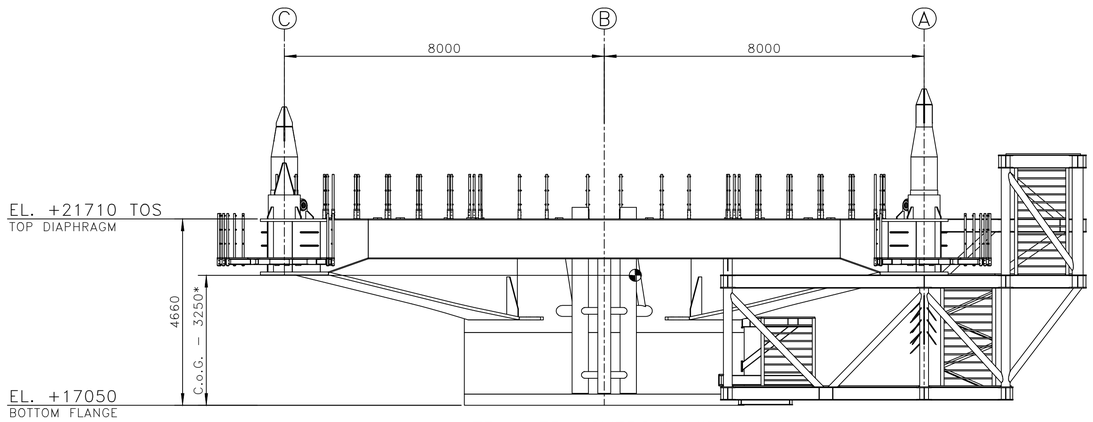

TP – TRANSVERSAL VIEW

SCALE 1:75

* FROM TEKLA

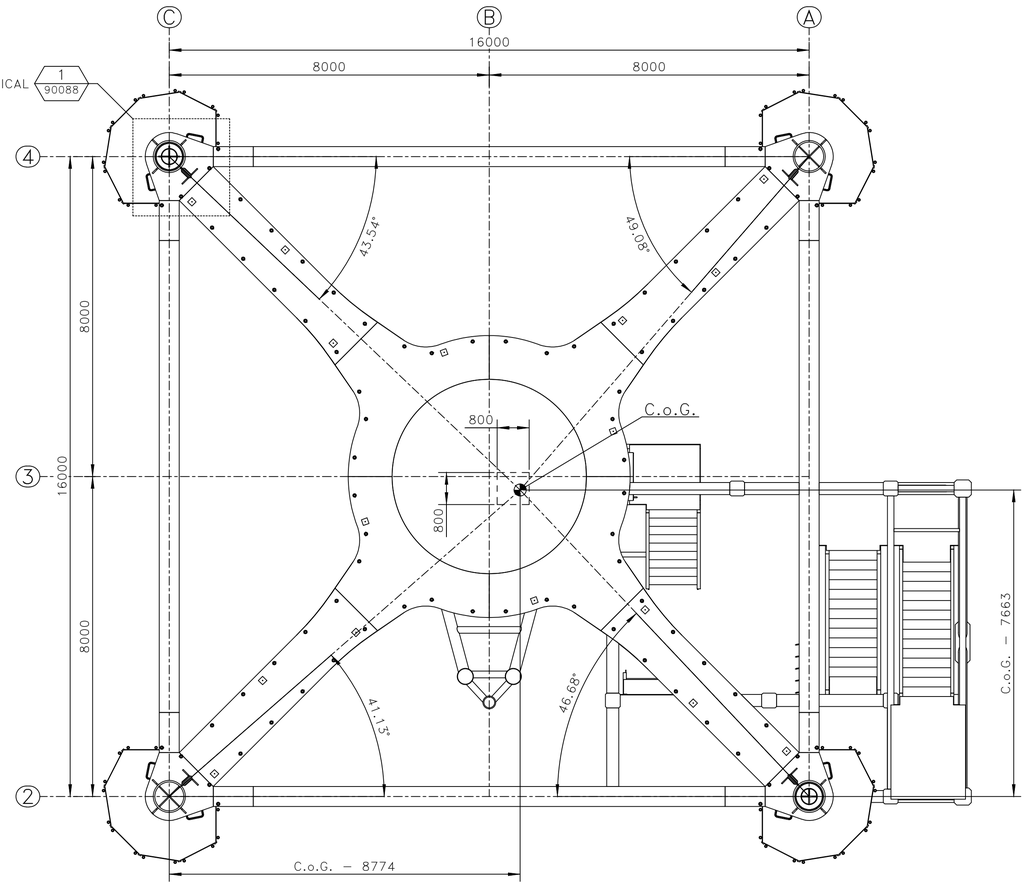

TP – PLAN VIEW

SCALE 1:75

TP NET WEIGHT = 254.5 t

(CONTINGENCY INCLUDED)

NOTES

1 – ALL DIMENSIONS AND ELEVATIONS ARE IN MILLIMETERS U.N.O.
2 – ALL ELEVATIONS ARE REFERED TO C.D.
3 – LIFTING PADEYES SHALL BE WELDED AFTER TP WEIGHING.
4 – C.o.G. POSITION:
ACCORDING TO WEIGHING CERTIFICATE DATED 19/06/2025.

MATERIALS

HOLDS

REFERENCE DRAWINGS

DWG No.	DESCRIPTION
123A90-DDL-ST-DD-90025	DRAWING LIST
123A90-DDL-ST-DD-90026	GENERAL NOTES
123A90-DDL-ST-DD-90088	TP – LIFTING POINTS – DETAILS

TECON

REV.	DATE	DRN	CHKD	APPD	DESCRIPTION
03	25/09/25	SPS	AB	CGI	AS-BUILT (ASB)
02	23/06/25	SGR	AB	DLS	ACCEPTED FOR CONSTRUCTION (AFC)
01	22/08/24	SGR	AB	DLS	ACCEPTED FOR CONSTRUCTION (AFC)
00	24/06/24	SGR	AB	DLS	ISSUE FOR REVIEW (IFR)

CROSSWIND

ROSETTI MARINO

TITLE :

BASE LOAD POWER HUB (BLPH)
TP – LIFTING POINTS
GENERAL ARRANGEMENT

CONTRACT NO./TITLE CW-I-WP4-2023-05/HOLLANDSE KUST NOORD WIND PARK | SCALE 1:75

DRAWN SPS | CHECKED A.BALZAROTTI | APPROVED CGI | DATE 25/09/25

A1 | DRAWING NO. 123A90-DDL-ST-DA-90087 | SHEET 001 | REV. 03

File Name : 123A90-DDL-ST-DA-90087_03.dwg