


DRAWING NO. 123A90-DDL-ST-DD-90076

REV. 02

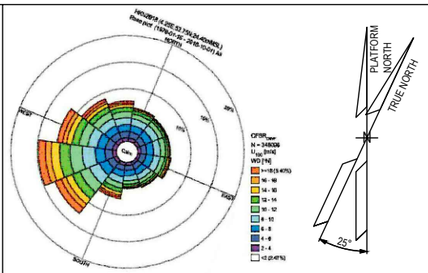


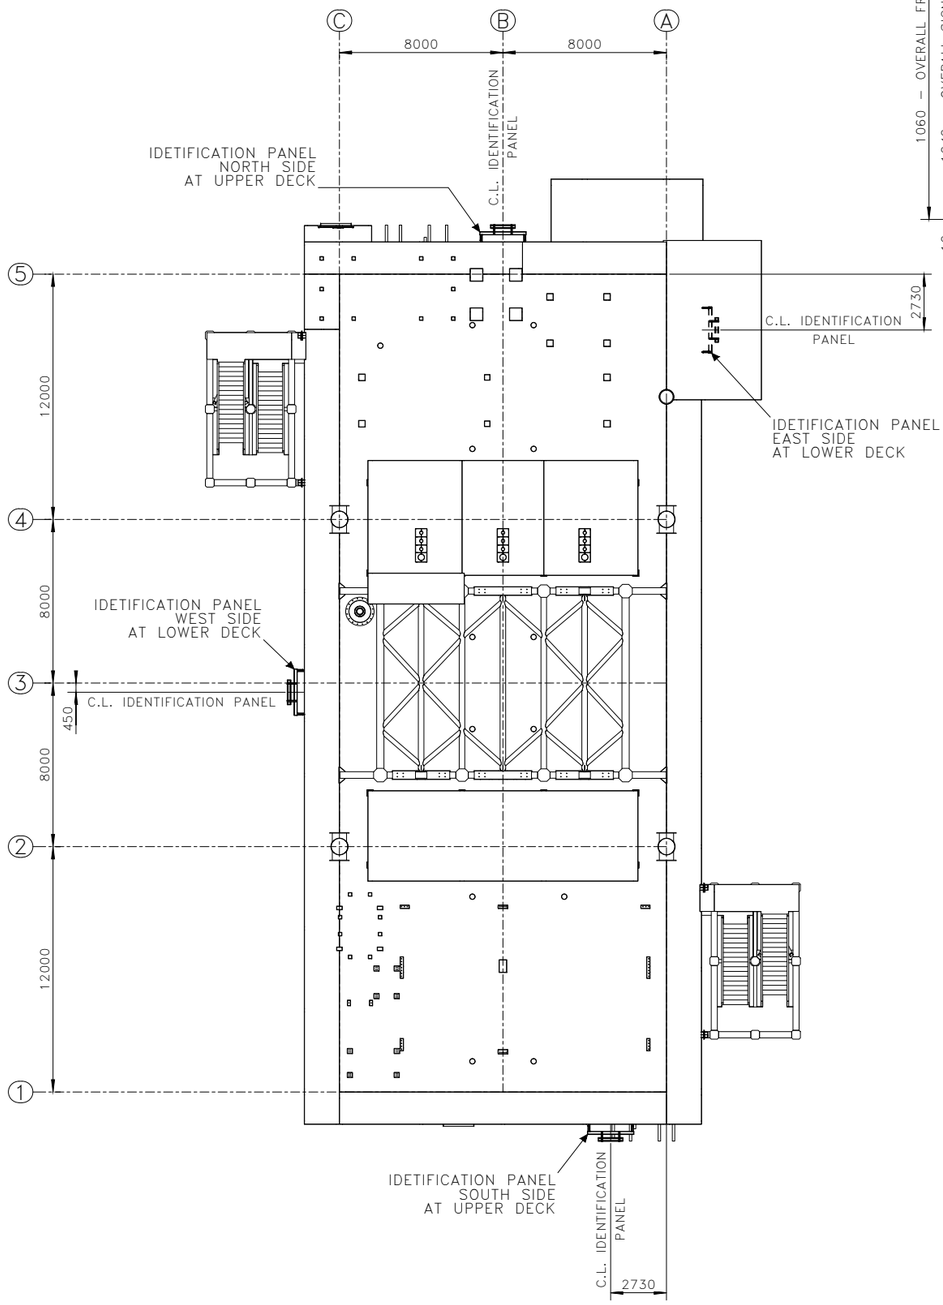

TOPSIDE – IDENTIFICATION PANELS
KEY PLAN
SCALE 1:150

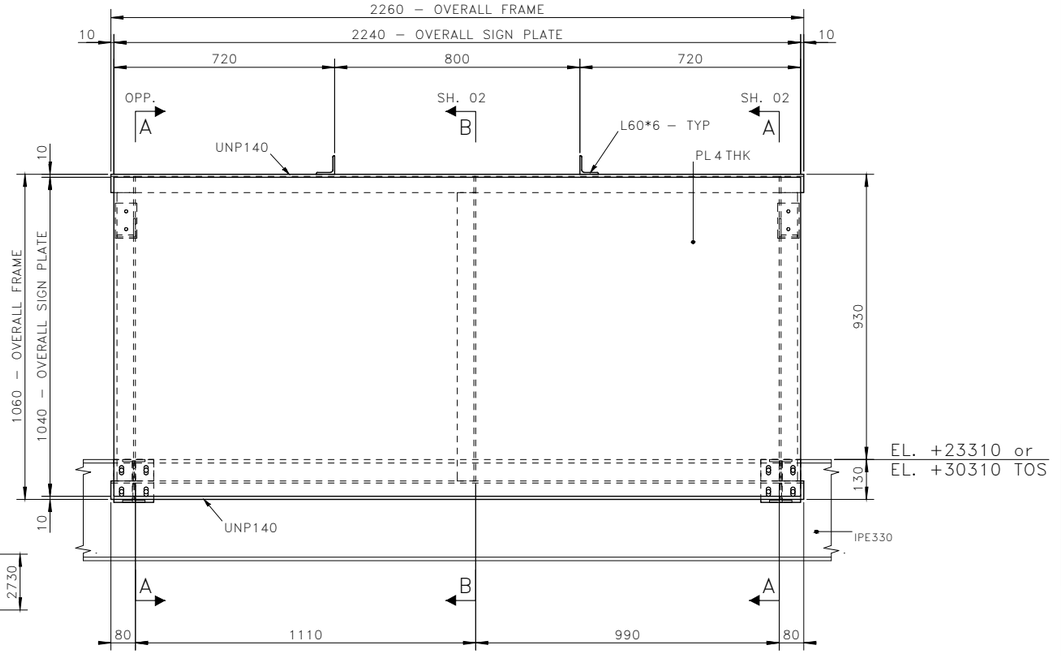

IDENTIFICATION PANEL – SIGN FRAME
LONGITUDINAL VIEW – TYPICAL
ALL BEAMS ARE L60x6 U.N.O.
SCALE 1:10

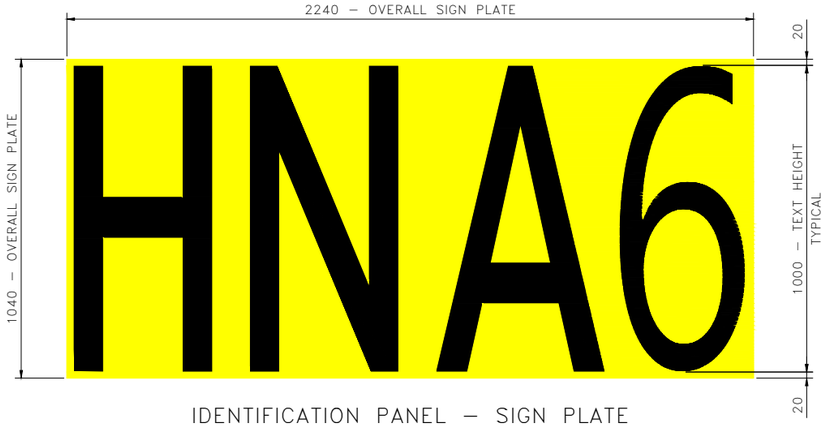

IDENTIFICATION PANEL – SIGN PLATE
COLOR : BLACK ON YELLOW BACKGROUND
FONT STYLE : DIN 1451 (67% WIDTH)
SCALE 1:10

NOTES

1 – ALL DIMENSIONS AND ELEVATIONS ARE IN MILLIMETERS U.N.O.
2 – ALL ELEVATIONS ARE REFERED TO C.D.
3 – ALL WELDS ARE FULL PENETRATION WELDS U.N.O.
4 – ALL FILLET WELDS SHALL BE CONTINUOUS AND THE LEG SIZE SHALL BE EQUAL 0.7 THE MINIMUM THICKNESS TO BE JOINTED U.N.O.

MATERIALS

ITEM IDENTIFICATION	MATERIAL DESIGNATION
IPE140	DC5-IV-275-10
L60*6	DC5-IV-275-10
PL 4 THK	DC5-IV-275-10
PL 8 THK	DC5-IV-275-10
PL 10 THK	DC5-IV-275-10
UNP140	DC5-IV-275-10

HOLDS

REFERENCE DRAWINGS

DWG No.	DESCRIPTION
123A90-DDL-ST-DD-90025	DRAWING LIST
123A90-DDL-ST-DD-90026	GENERAL NOTES
123A90-DDL-ST-DD-90027	WELDING GENERAL NOTES
123A90-DDL-ST-DD-90032	PLATES – DOUBLE SIDED WELDS
123A90-DDL-ST-DD-90033	PLATES – SINGLE SIDED WELDS
123A90-DDL-ST-DD-90057	SEC. STEEL – PLAN AT EL +23310 TOS – SH. 1
123A90-DDL-ST-DD-90058	SEC. STEEL – PLAN AT EL +30310 TOS – SH. 1
123A90-DDL-ST-DD-90076	IDENTIFICATION PANEL – ASS. AND DET. – SH. 2

TECON

REV.	DATE	DRN	CHKD	APPD	DESCRIPTION
02	18/12/25	SGR	AB	DLS	AS BUILT
01	14/01/25	SGR	AB	DLS	ACCEPTED FOR CONSTRUCTION (AFC)
00	08/11/24	SGR	AB	DLS	ISSUE FOR REVIEW (IFR)

CROSSWIND

ROSETTI MARINO


TITLE :
BASE LOAD POWER HUB (BLPH)
TOPSIDE – IDENTIFICATION PANELS
ASSEMBLY AND DETAILS

CONTRACT NO./TITLE CW-I-WP4-2023-05/HOLLANDSE KUST NOORD WIND PARK . | SCALE 1:10
DRAWN S.GRIFFINI | CHECKED A.BALZAROTTI | APPROVED D.LO STERZO | DATE 18/12/25
A1 | DRAWING NO. 123A90-DDL-ST-DD-90076 | SHEET / SHEETS 001/002 | REV. 02


File Name : 123A90-DDL-ST-DD-90076_02.dwg

DRAWING NO. 123A90-DDL-ST-DD-90076


REV. 02

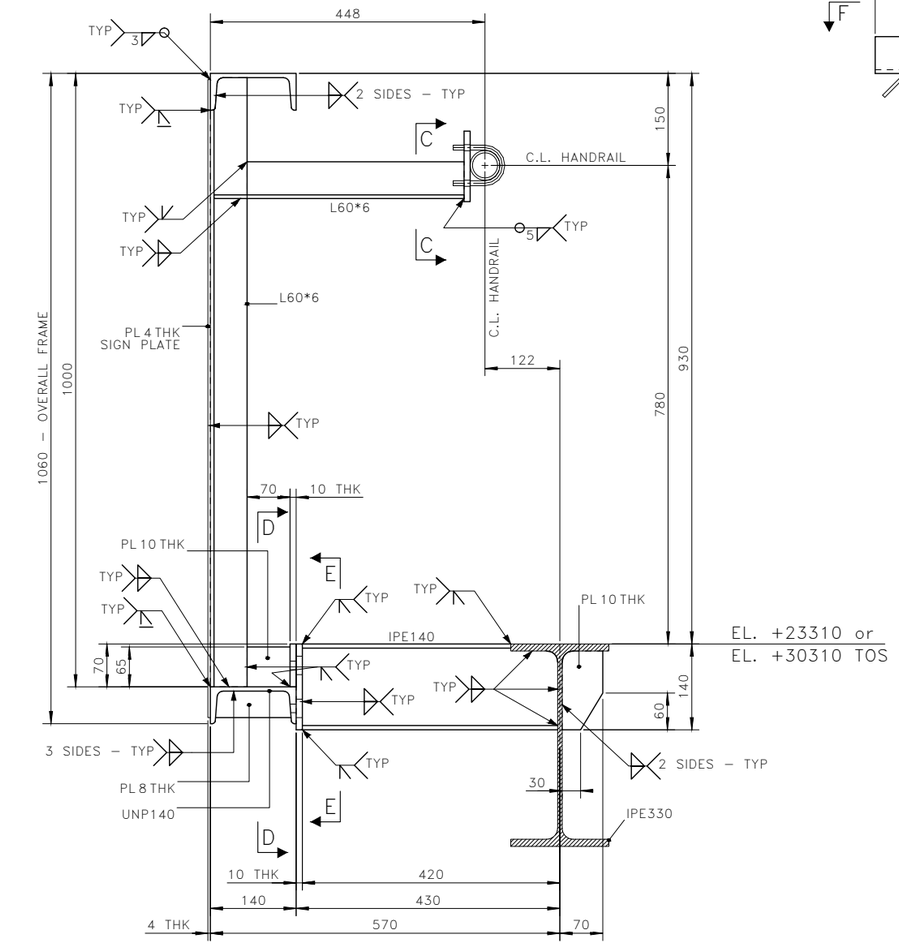


SECTION A – A
123A90-DDL-ST-DD-90076-001
SCALE 1:5

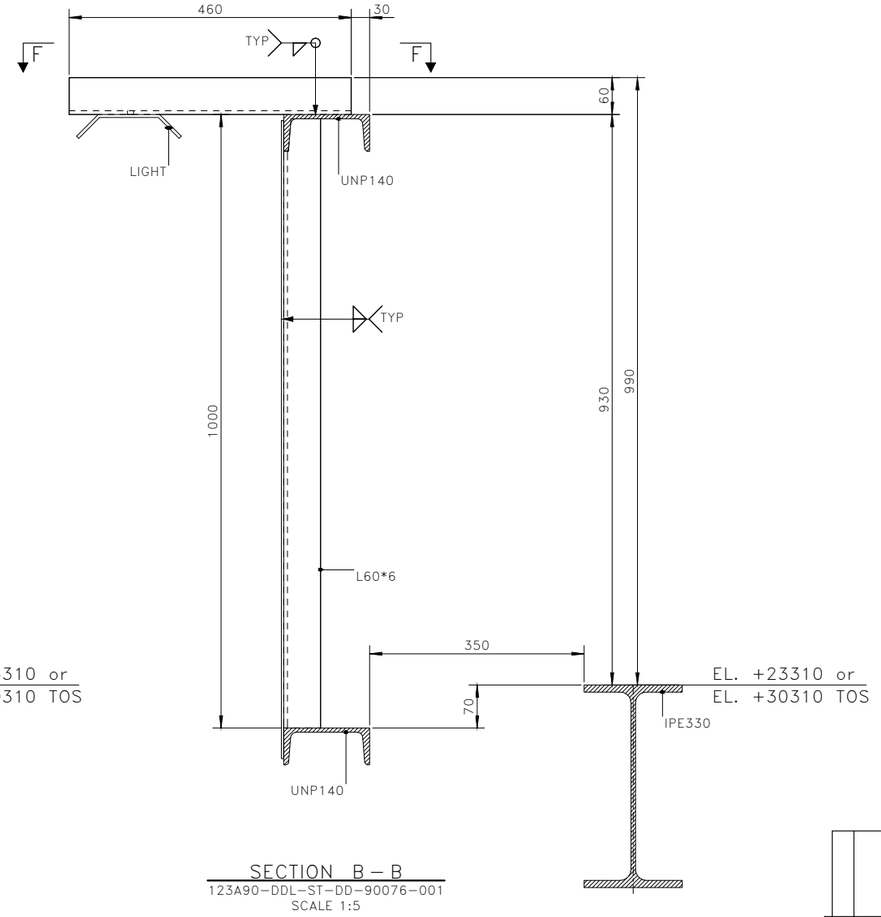


SECTION B – B
123A90-DDL-ST-DD-90076-001
SCALE 1:5

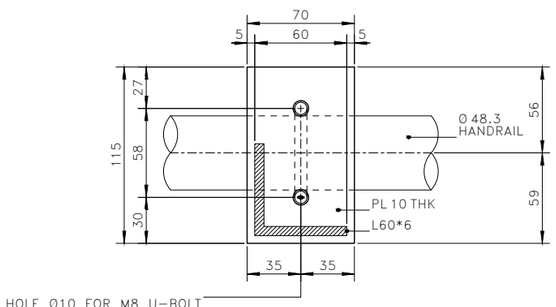


SECTION C – C
SCALE 1:2

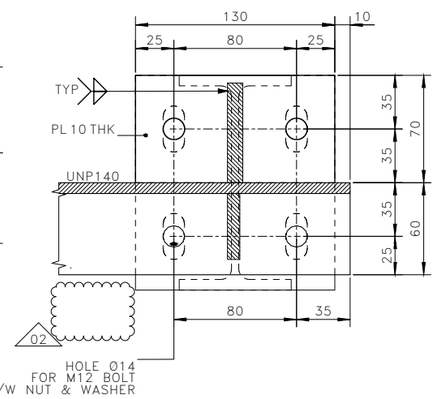

SECTION D – D
SCALE 1:2

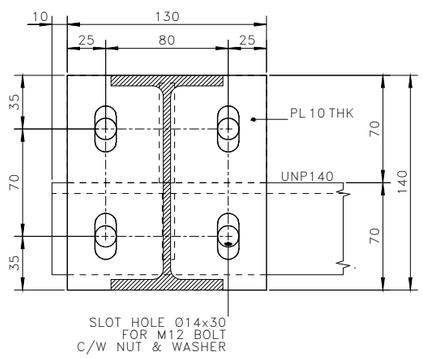

SECTION E – E
SCALE 1:2

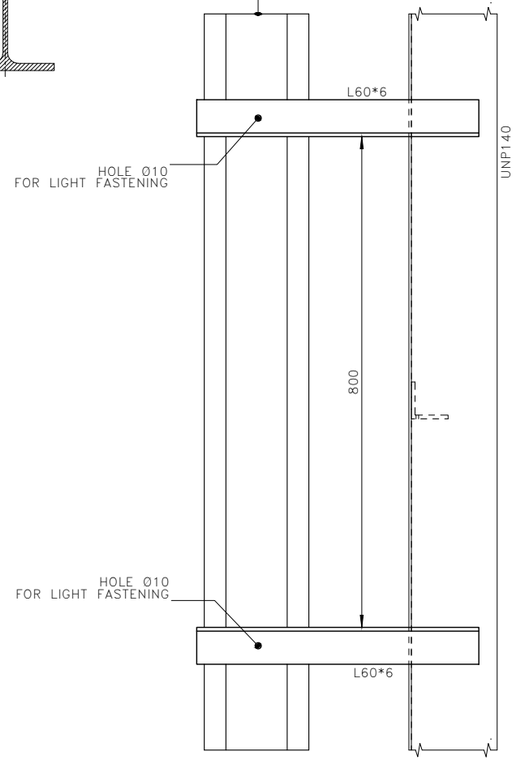

SECTION F – F
SCALE 1:5

NOTES

1 – ALL DIMENSIONS AND ELEVATIONS ARE IN MILLIMETERS U.N.O.
2 – ALL ELEVATIONS ARE REFERED TO C.D.
3 – ALL WELDS ARE FULL PENETRATION WELDS U.N.O.
4 – ALL FILLET WELDS SHALL BE CONTINUOUS AND THE LEG SIZE SHALL BE EQUAL 0.7 THE MINIMUM THICKNESS TO BE JOINTED U.N.O.

MATERIALS

ITEM IDENTIFICATION	MATERIAL DESIGNATION
IPE140	DC5-IV-275-10
L60*6	DC5-IV-275-10
PL 4 THK	DC5-IV-275-10
PL 8 THK	DC5-IV-275-10
PL 10 THK	DC5-IV-275-10
UNP140	DC5-IV-275-10

HOLDS

REFERENCE DRAWINGS

DWG No.	DESCRIPTION
123A90-DDL-ST-DD-90025	DRAWING LIST
123A90-DDL-ST-DD-90026	GENERAL NOTES
123A90-DDL-ST-DD-90027	WELDING GENERAL NOTES
123A90-DDL-ST-DD-90032	PLATES – DOUBLE SIDED WELDS
123A90-DDL-ST-DD-90033	PLATES – SINGLE SIDED WELDS
123A90-DDL-ST-DD-90076	IDENTIFICATION PANEL – ASS. AND DET. – SH. 1

TECON

REV.	DATE	DRN	CHKD	APPD	DESCRIPTION
02	18/12/25	SGR	AB	DLS	AS BUILT
01	14/01/25	SGR	AB	DLS	ACCEPTED FOR CONSTRUCTION (AFC)
00	08/11/24	SGR	AB	DLS	ISSUE FOR REVIEW (IFR)

CROSSWIND

ROSETTI MARINO

TITLE :
BASE LOAD POWER HUB (BLPH)
TOPSIDE – IDENTIFICATION PANELS
ASSEMBLY AND DETAILS

CONTRACT NO./TITLE CW-I-WP4-2023-05/HOLLANDSE KUST NOORD WIND PARK | SCALE 1:5

DRAWN S.GRIFFINI | CHECKED A.BALZAROTTI | APPROVED D.LO STERZO | DATE 18/12/25

A1 | DRAWING NO. 123A90-DDL-ST-DD-90076 | SHEET / SHEETS 002/002 | REV. 02

File Name : 123A90-DDL-ST-DD-90076_02.dwg