


DRAWING NO. 123A90-DDL-ST-DD-90090

REV. 02

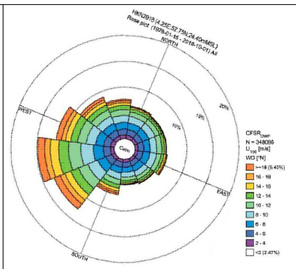


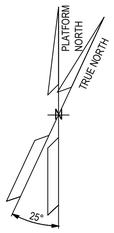

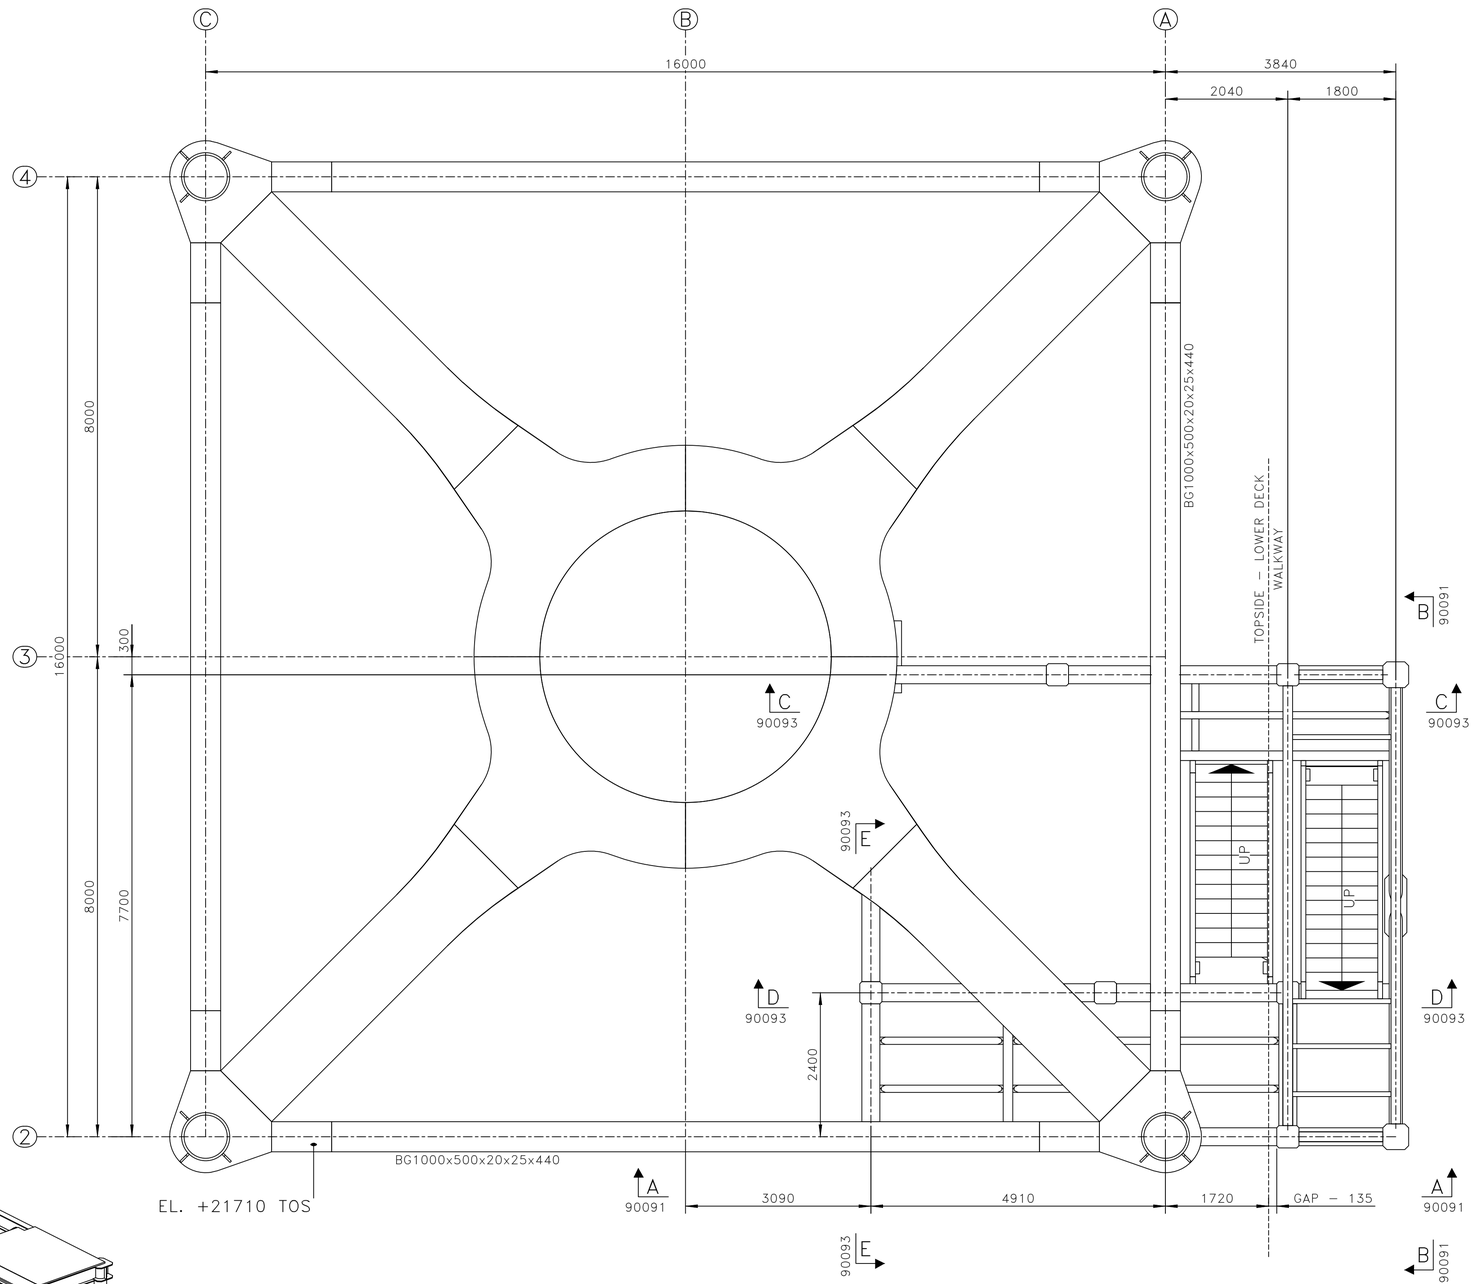

TRANSITION PIECE – PLAN AT EL. +21710 T.O.S.

SCALE 1:50

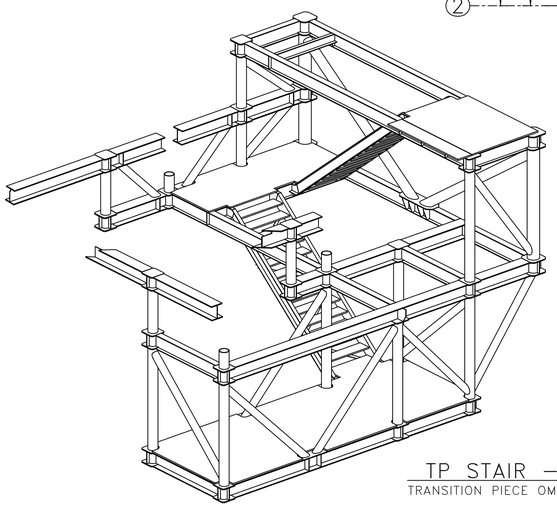

TP STAIR – 3D VIEW

TRANSITION PIECE OMITTED FOR CLARITY

NOTES

1 – ALL DIMENSIONS AND ELEVATIONS ARE IN MILLIMETERS U.N.O.
2 – ALL ELEVATIONS ARE REFERED TO C.D.

MATERIALS

HOLDS

REFERENCE DRAWINGS

DWG No.	DESCRIPTION
123A90-DDL-ST-DD-90025	DRAWING LIST
123A90-DDL-ST-DD-90026	GENERAL NOTES
123A90-DDL-ST-DD-90085	TP – PRIMARY STEEL – PLAN AT EL.+21710 TOS
123A90-DDL-ST-DD-90091	TP – WALKWAYS & STAIRS – SECTIONS – SHEET 1
123A90-DDL-ST-DD-90093	TP – WALKWAYS & STAIRS – SECTIONS – SHEET 2

REV.	DATE	DRN	CHKD	APPD	DESCRIPTION
02	22/09/25	SPS	AB	CGI	AS-BUILT (ASB)
01	04/04/24	SGR	AB	DLS	ACCEPTED FOR CONSTRUCTION (AFC)
00	10/01/24	SGR	AB	DLS	ISSUE FOR REVIEW (IFR)

CROSSWIND

ROSETTI MARINO

TITLE :

BASE LOAD POWER HUB (BLPH)
TP – WALKWAYS & STAIRS
ACCESS PLATFORM – ASSEMBLY

CONTRACT NO./TITLE CW-I-WP4-2023-05/HOLLANDSE KUST NOORD WIND PARK | SCALE 1:50

DRAWN SPS | CHECKED A.BALZAROTTI | APPROVED CGI | DATE 22/09/25

A1 | DRAWING NO. 123A90-DDL-ST-DD-90090 | SHEET 001 | REV. 02

File Name : 123A90-DDL-ST-DD-90090_02.dwg