


DRAWING NO. 123A90-DDL-ST-DD-90093 REV. 02

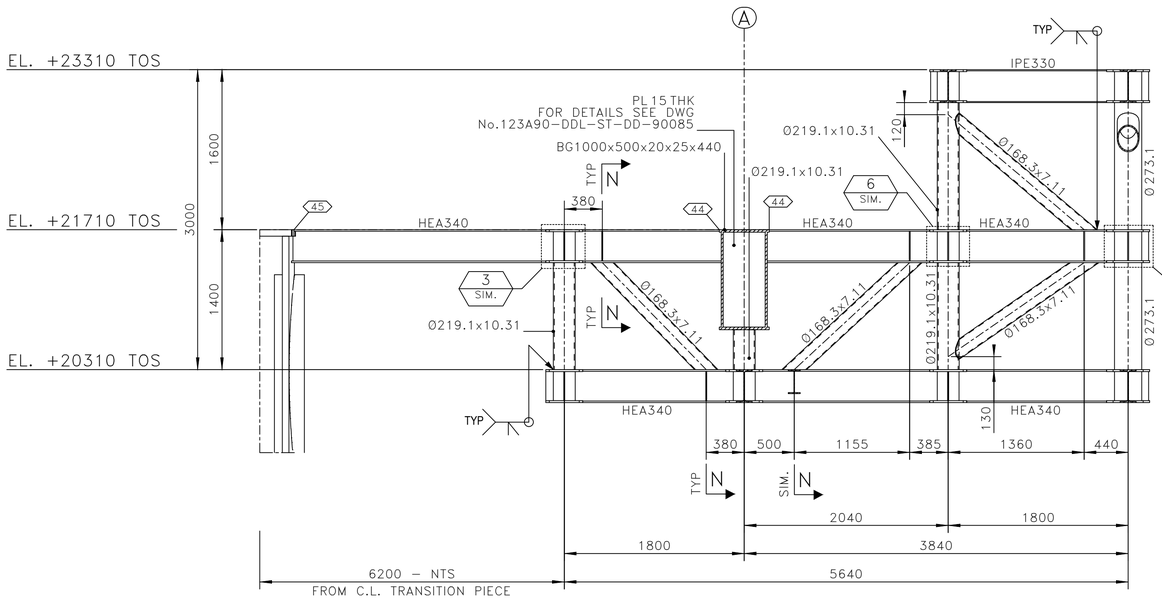


SECTION C – C
123A90-DDL-ST-DD-90090
SCALE 1:30

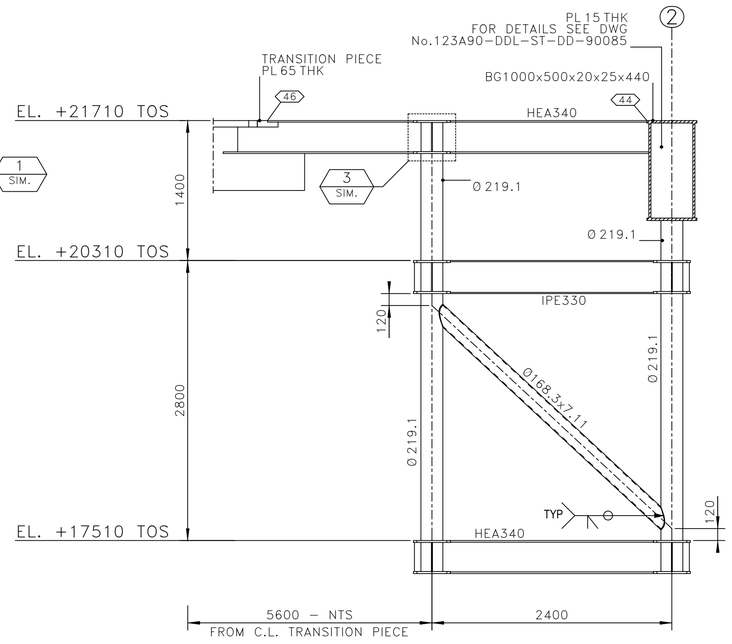


SECTION E – E
123A90-DDL-ST-DD-90090
SCALE 1:30

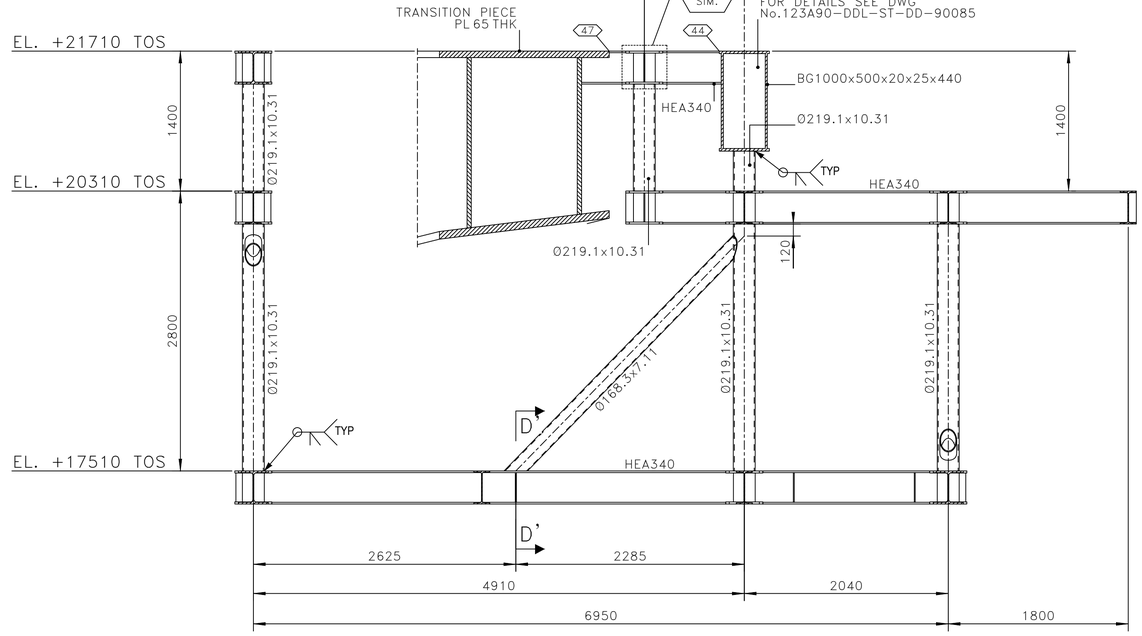


SECTION D – D
123A90-DDL-ST-DD-90090
SCALE 1:30

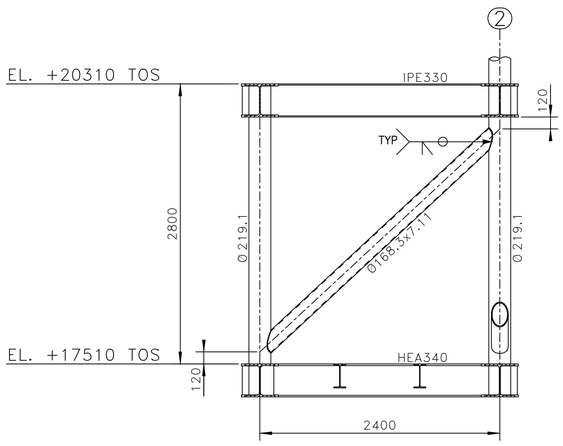

SECTION M – M
123A90-DDL-ST-DD-90092
SCALE 1:30

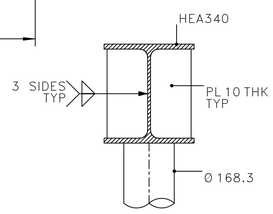

SECTION N – N
SCALE 1:10

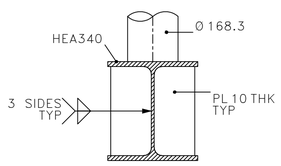

SECTION D' – D'
SCALE 1:10

NOTES

1 – ALL DIMENSIONS AND ELEVATIONS ARE IN MILLIMETERS U.N.O.
2 – ALL ELEVATIONS ARE REFERED TO C.D.
3 – ALL WELDS ARE FULL PENETRATION WELDS U.N.O.
4 – ALL FILLET WELDS SHALL BE CONTINUOUS AND THE LEG SIZE SHALL BE EQUAL 0.7 THE MINIMUM THICKNESS TO BE JOINTED U.N.O.
5 – ALL STIFFENER MATERIALS ARE DC4-III-355-0 U.N.O.

MATERIALS

ITEM IDENTIFICATION	MATERIAL DESIGNATION
HEA340	DC4-III-355-0
IPE240	DC4-III-355-0
IPE330	DC4-III-355-0
Ø168.3x7.11	DC4-III-X52-0
Ø219.1x10.31	DC4-III-X52-0
Ø273.1x12.7	DC4-III-X52-0
UNP220	DC5-IV-275-10

HOLDS

REFERENCE DRAWINGS

DWG No.	DESCRIPTION
123A90-DDL-ST-DD-90025	DRAWING LIST
123A90-DDL-ST-DD-90026	GENERAL NOTES
123A90-DDL-ST-DD-90027	WELDING GENERAL NOTES
123A90-DDL-ST-DD-90029	TUBULAR JOINTS – STANDARD WELDING DETAILS
123A90-DDL-ST-DD-90081	TP – PRIMARY STEEL – ELEVATION ROW -2-
123A90-DDL-ST-DD-90085	TP – PRIMARY STEEL – PLAN AT EL.+21710 TOS
123A90-DDL-ST-DD-90090	TP – WALKWAYS & STAIRS – ASSEMBLY
123A90-DDL-ST-DD-90092	TP – WALKWAYS & STAIRS – PLANS
123A90-DDL-ST-DD-90106	TP – WALKWAYS & STAIRS – JOINT – DETAILS
123A90-DDL-ST-DD-90108	TP – WALKWAYS & STAIRS – TYP BEAM CONNECTIONS

TECON

REV.	DATE	DRN	CHKD	APPD	DESCRIPTION
02	22/09/25	SPS	AB	CGI	AS-BUILT (ASB)
01	04/04/24	SGR	AB	DLS	ACCEPTED FOR CONSTRUCTION (AFC)
00	10/01/24	SGR	AB	DLS	ISSUE FOR REVIEW (IFR)

CROSSWIND

ROSETTI MARINO

TITLE :
BASE LOAD POWER HUB (BLPH)
TP – WALKWAYS & STAIRS
ACCESS PLATFORM – SECTIONS – SHEET 2

CONTRACT NO./TITLE CW-I-WP4-2023-05/HOLLANDSE KUST NOORD WIND PARK | SCALE 1:30

DRAWN SPS | CHECKED A.BALZAROTTI | APPROVED CGI | DATE 22/09/25

A1 | DRAWING NO. 123A90-DDL-ST-DD-90093 | SHEET 001 | REV. 02

File Name : 123A90-DDL-ST-DD-90093_02.dwg