


DRAWING NO. 123A90-DDL-ST-DD-90101 REV. 02

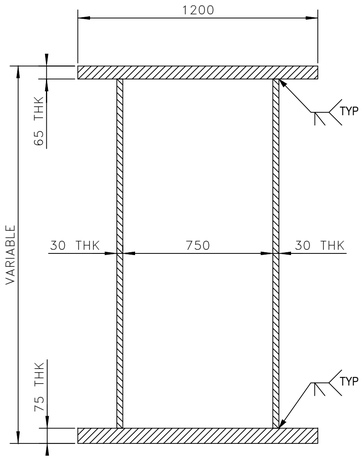


SECTION B – B
SCALE 1:15

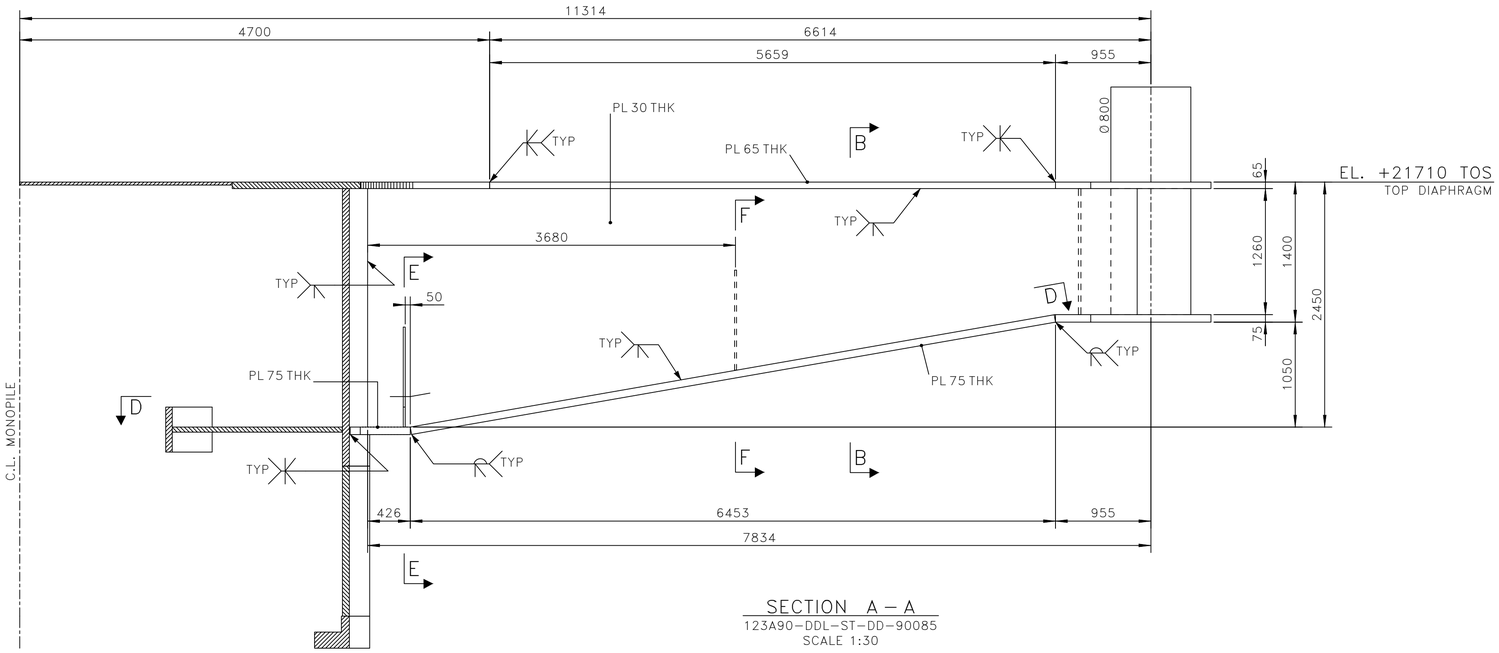


SECTION A – A
123A90-DDL-ST-DD-90085
SCALE 1:30

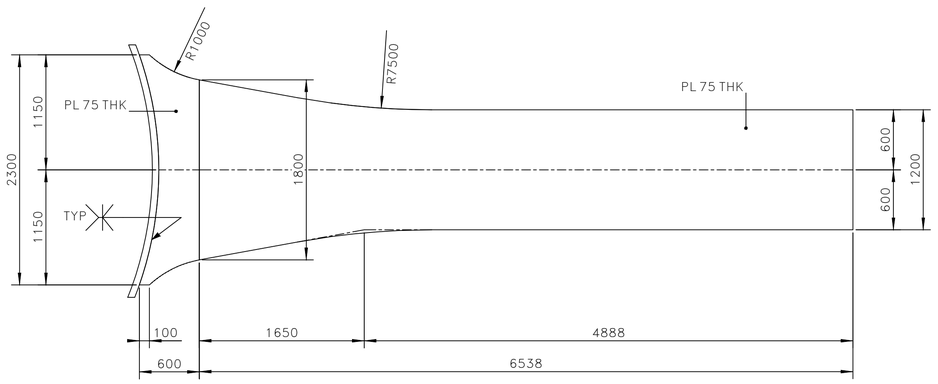


SECTION D – D
SCALE 1:30

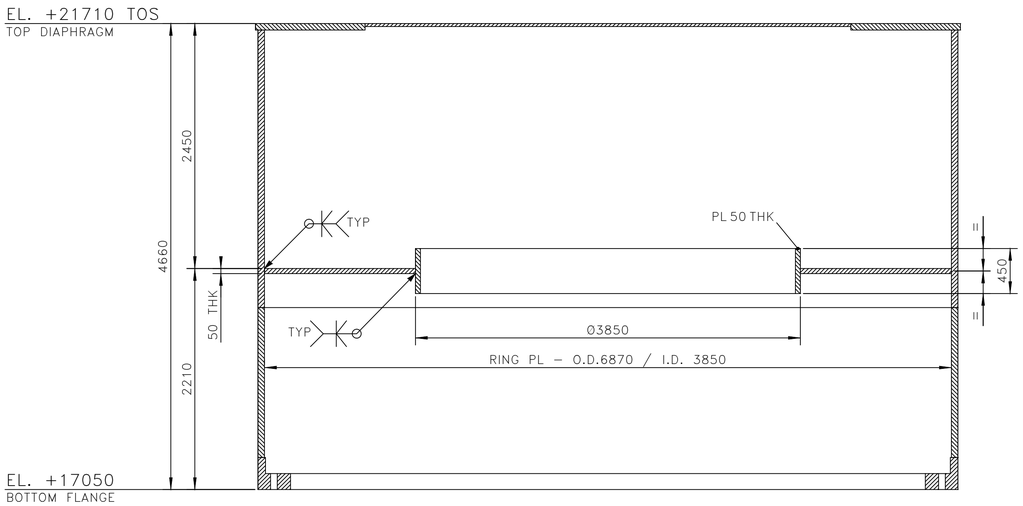

SECTION C – C
123A90-DDL-ST-DD-90085
SCALE 1:30

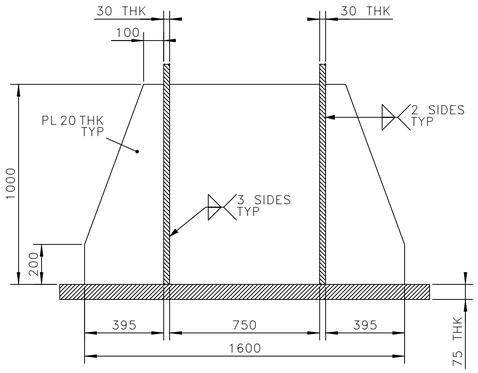

SECTION E – E
SCALE 1:15

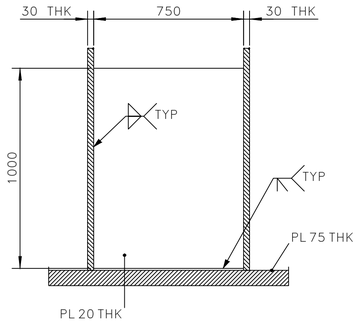

SECTION F – F
SCALE 1:15

NOTES

1 – ALL DIMENSIONS AND ELEVATIONS ARE IN MILLIMETERS U.N.O.
2 – ALL ELEVATIONS ARE REFERED TO C.D.
3 – ALL WELDS ARE FULL PENETRATION WELDS U.N.O.
4 – ALL FILLET WELDS SHALL BE CONTINUOUS AND THE LEG SIZE SHALL BE EQUAL 0.7 THE MINIMUM THICKNESS TO BE JOINTED U.N.O.

MATERIALS

ITEM IDENTIFICATION	MATERIAL DESIGNATION
PL 20 THK	DC2-II-420-20
PL 30 THK	DC2-II-420-40
PL 50 THK	DC2-II-420-40
PL 65 THK	DC2-II-420-40
PL 75 THK	DC2-II-420-40
Ø3850x50	DC2-II-420-40

HOLDS

REFERENCE DRAWINGS

DWG No.	DESCRIPTION
123A90-DDL-ST-DD-90025	DRAWING LIST
123A90-DDL-ST-DD-90026	GENERAL NOTES
123A90-DDL-ST-DD-90027	WELDING GENERAL NOTES
123A90-DDL-ST-DD-90032	PLATES – DOUBLE SIDED WELDS
123A90-DDL-ST-DD-90033	PLATES – SINGLE SIDED WELDS
123A90-DDL-ST-DD-90085	TP – PRIMARY STEEL – PLAN AT EL. +21710 TOS

TECON

REV.	DATE	DRN	CHKD	APPD	DESCRIPTION
02	22/09/25	SPS	AB	CGI	AS-BUILT (ASB)
01	20/12/23	SGR	AB	DLS	ACCEPTED FOR CONSTRUCTION (AFC)
00	08/11/23	SGR	AB	DLS	ISSUE FOR REVIEW (IFR)

CROSSWIND ROSETTI MARINO

TITLE :
BASE LOAD POWER HUB (BLPH)
TP – PRIMARY STEEL
SECTIONS

CONTRACT NO./TITLE CW-I-WP4-2023-05/HOLLANDSE KUST NOORD WIND PARK | SCALE 1:30
DRAWN SPS | CHECKED A.BALZAROTTI | APPROVED CGI | DATE 22/09/25
A1 | DRAWING NO. 123A90-DDL-ST-DD-90101 | SHEET 001 | REV. 02

File Name : 123A90-DDL-ST-DD-90101_02.dwg