


DRAWING NO. 123A90-DDL-ST-DD-90117

REV. 02

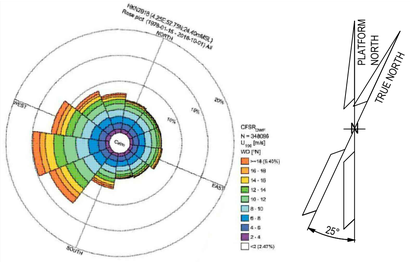


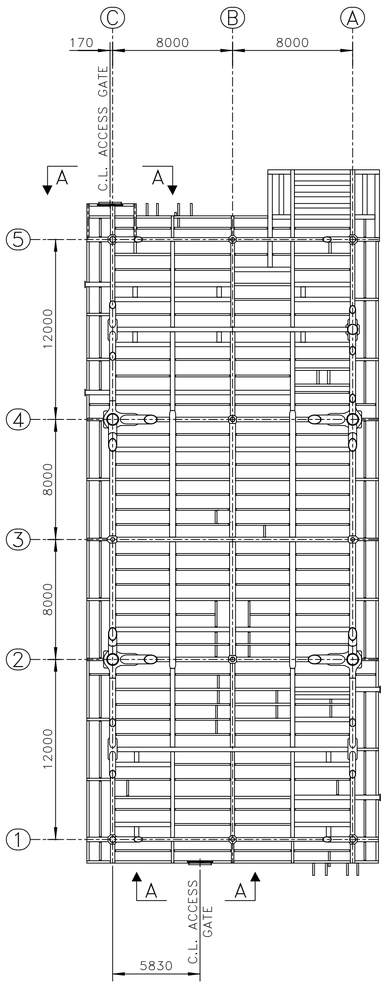


TOPSIDE – LOWER DECK
PLAN AT EL. +23310 T.O.S.
SCALE 1:200

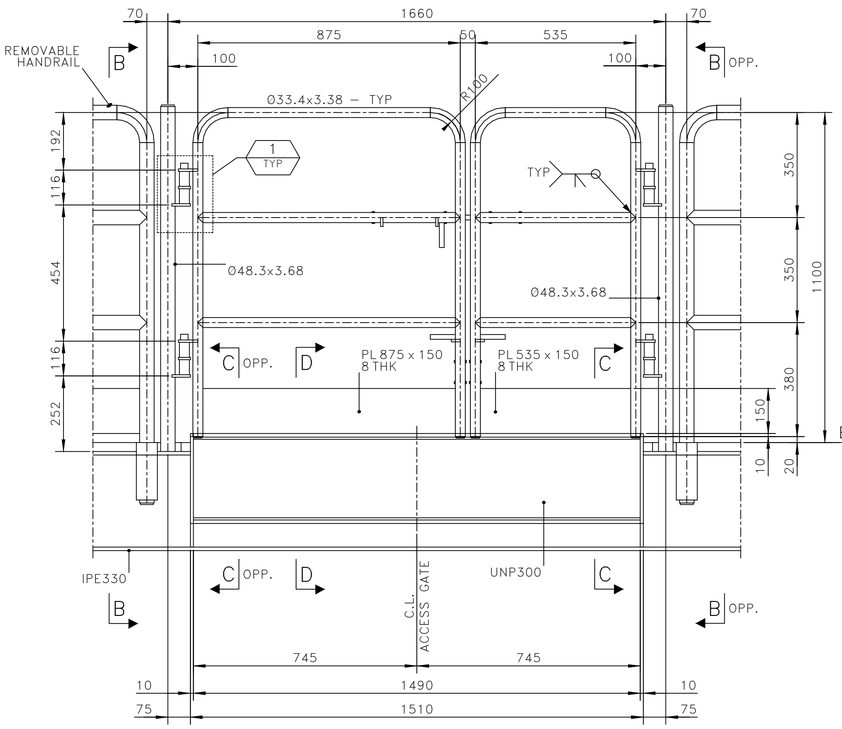


VIEW A – A
SCALE 1:10

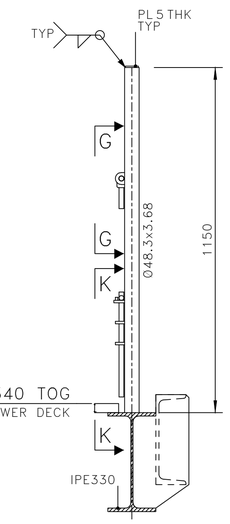


SECTION B – B
SCALE 1:10

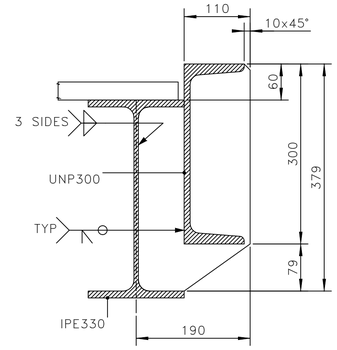


SECTION C – C
SCALE 1:5

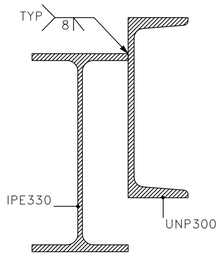

SECTION D – D
SCALE 1:5

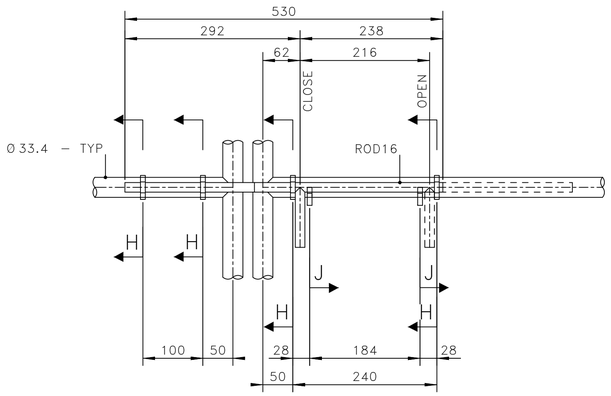


SECTION G – G
SCALE 1:5

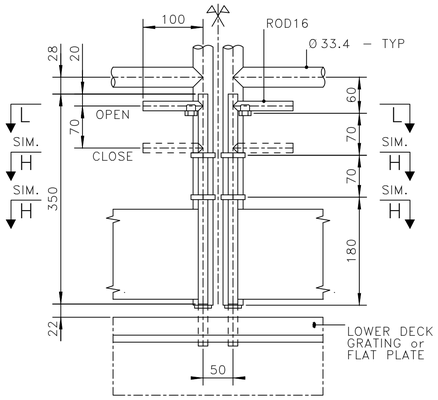


SECTION K – K
SCALE 1:5


01

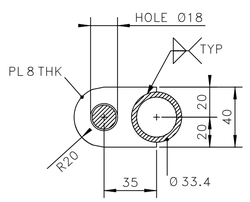


SECTION H – H
SCALE 1:2

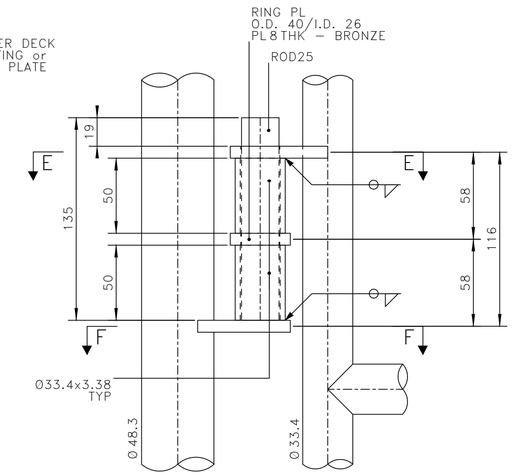


1 TYP DETAIL
SCALE 1:2

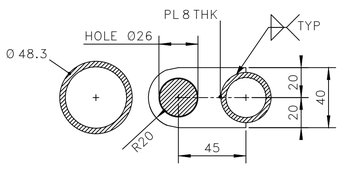


SECTION E – E
SCALE 1:2

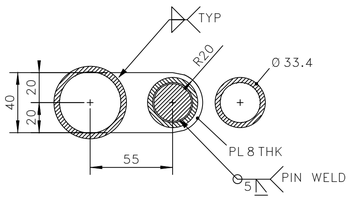

SECTION F – F
SCALE 1:2

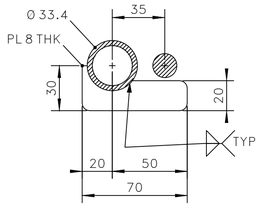

SECTION J – J
SCALE 1:2

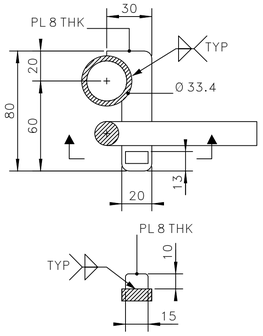

SECTION L – L
SCALE 1:2

NOTES

1 – ALL DIMENSIONS AND ELEVATIONS ARE IN MILLIMETERS U.N.O.
2 – ALL ELEVATIONS ARE REFERED TO C.D.
3 – ALL WELDS ARE FULL PENETRATION WELDS U.N.O.
4 – ALL FILLET WELDS SHALL BE CONTINUOUS AND THE LEG SIZE SHALL BE EQUAL 0.7 THE MINIMUM THICKNESS TO BE JOINTED U.N.O.
5 – PROVIDE Ø26 HOLES ON THE FLOORING PLATE, TO BLOCK THE GATE IN OPEN AND CLOSED POSITION. VALID ONLY FOR THE NORTH SIDE ACCESS GATE.

MATERIALS

ITEM IDENTIFICATION	MATERIAL DESIGNATION
PL 8 THK	BRONZE
PL 5 THK	DC5-IV-275-10
PL 8 THK	DC5-IV-275-10
PL 10 THK	DC5-IV-275-10
ROD16	DC5-IV-275-10
ROD25	DC5-IV-275-10
UNP300	DC5-IV-275-10
Ø33.4x3.38	DC5-IV-275-10
Ø48.3x3.68	DC5-IV-275-10

HOLDS

REFERENCE DRAWINGS

DWG No.	DESCRIPTION
123A90-DDL-ST-DD-90025	DRAWING LIST
123A90-DDL-ST-DD-90026	GENERAL NOTES
123A90-DDL-ST-DD-90027	WELDING GENERAL NOTES
123A90-DDL-ST-DD-90036	STANDARD DRAWINGS – LADDERS
123A90-DDL-ST-DD-90037	STANDARD DRAWINGS – HANDRAILS
123A90-DDL-ST-DD-90057	SEC. STEEL – PLAN AT EL +23310 TOS – SH. 1
123A90-DDL-ST-DD-90104	SEC. STEEL – PLAN AT EL +23310 TOS – SH. 2

TECON

REV.	DATE	DRN	CHKD	APPD	DESCRIPTION
02	22/09/25	SPS	AB	CGI	AS-BUILT (ASB)
01	02/07/24	SGR	AB	DLS	ACCEPTED FOR CONSTRUCTION (AFC)
00	08/04/24	SGR	AB	DLS	ISSUE FOR REVIEW (IFR)

CROSSWIND

ROSETTI MARINO

TITLE :
BASE LOAD POWER HUB (BLPH)
TOPSIDE – LOWER DECK
ACCESS GATES – ASSEMBLY AND DETAILS

CONTRACT NO./TITLE CW-I-WP4-2023-05/HOLLANDSE KUST NOORD WIND PARK | SCALE 1:10

DRAWN SPS | CHECKED A.BALZAROTTI | APPROVED CGI | DATE 22/09/25

A1 | DRAWING NO. 123A90-DDL-ST-DD-90117 | SHEET 001 | REV. 02

File Name : 123A90-DDL-ST-DD-90117_02.dwg