RLMU LIST

REV. 02A: Sheets 14

BASE LOAD POWER HUB (BLPH)

"SG-200N1" LV SWBD 400/230V

ELECTRICAL

LV SWG FUNCTIONAL DIAGRAMS - TYPICAL FEEDERS

ROSETTI MARINO	RED LINE AS BUILT STAMP
RLMU	✖ Yes ☐ No
Description	This document represents the final as-built version incorporating the latest approved information.
Reviewed & Confirmed by	Rosetti Marino S.P.A.
Signature /Date	Claudia Giunchi

Notes: Tick"Yes" only when the document reflects the final as-commissioned condition and the red-line mark-up (RLMU) has been incorporated without a new revision.
Tick "No" if the last approved revision already represents the final condition, with no redline markup required.

Claudia Giunchi
Autore firma digitale: Claudia Giunchi
Nome distintivo: CN = Claudia Giunchi email = claudia.giunchi@rosetti.it C = IT O = Rosetti Marino
Data: 2025.12.18 12:55:15 +01'00'

VALID FOR CONSTRUCTION
VENDOR DOCUMENT - FDL DWG:
123A90-FDL-1724002197-EL-DG-00031

REV.:	DATE:	SIGNATURE:
2_A	18/03/25	G.Randi

ROSETTI MARINO SpA

CROSSWIND

IMESA ELECTRICAL ENGINEERING

ROSETTI MARINO

DWG n° : 231298/SD/31
Item n° : PF1002983/26

REV.	DATE	DRN	CHKD	APPD	DESCRIPTION
2	18/09/2024	Santinelli	Flamminio	Sigismondi	As Built (ASB)
1	10/07/2024	Santinelli	Flamminio	Sigismondi	Accepted for Construction (AFC)
0	09/05/2024	Santinelli	Flamminio	Sigismondi	Issued for review (IFR)

TITLE : "SG-200N1"
LV SWG FUNCTIONAL DIAGRAMS - TYPICAL FEEDERS
Cover

CONTRACT NO./TITLE CW-I-WP4-2023-05/HOLLANDSE KUST NOORD WIND PARK | SCALE : NTS

A3 | DRAWING NO. 1723002197-EL-DG-00031 | SHEET 001 | REV. 02

F.to UNI A3: 420mmx297mm

File Name : 1723002197-EL-DG-00031 Rev. 02

INDEX SHEETS

Sheet	Description	Revision 0	1	2	3	4	5	6	7	8	9
001	Cover	X	X	X							
002	Index	X	X	X							
003	Index	X	X	X							
004	Graphical Symbols	X	X	X							
005	Graphical Symbols	X	X	X							
006	General Notes	X	X	X							
007	Door Front Lay-Out - Typical "M1-n"	X	X	X							
008	Users Legend - Typical "M1-n"	X	X	X							
009	Functional Drawing - Typical "M1-n"	X	X	X							
010	Functional Drawing - Typical "M1-n"	X	X	X							
011	Functional Drawing - Typical "M1-n"	X	X	X							
012	Functional Drawing - Typical "M1-n"	X	X	X							
013	Functional Drawing - Typical "M1-n"	X	X	X							
014	Functional Drawing - Typical "M1-n"	X	X	X							
015	Functional Drawing - Typical "M1-n"	X	X	X							
016	UMC100 Internal Function Logic - Typical "M1-n"	X	X	X							
017	UMC100 Internal Function Logic - Typical "M1-n"	X	X	X							
018	UMC100 Internal Function Logic - Typical "M1-n"	X	X	X							
019	UMC100 Internal Function Logic - Typical "M1-n"	X	X	X							
020	Functional Drawing - Typical "M1-n"	X	X	X							
021	Functional Drawing - Typical "M1-n"	X	X	X							
022	Functional Drawing - Typical "M1-n"	X	X	X							
023	Door Front Lay-Out - Typical "L1-n" & "L2-n"	X	X	X							
024	Door Front Lay-Out - Typical "L1-n" & "L2-n"	X	X	X							
025	Users Legend - Typical "L1-n" & "L2-n"	X	X	X							
026	Items Acronym - Typical "L1-n" & "L2-n"	X	X	X							
027	Functional Drawing - Typical "L1-n" & "L2-n"	X	X	X							
028	Functional Drawing - Typical "L1-n" & "L2-n"	X	X	X							
029	Functional Drawing - Typical "L1-n" & "L2-n"	X	X	X							
030	Functional Drawing - Typical "L1-n" & "L2-n"	X	X	X							
031	Functional Drawing - Typical "L1-n" & "L2-n"	X	X	X							
032	Functional Drawing - Typical "L1-n" & "L2-n"	X	X	X							
033	Functional Drawing - Typical "L1-n" & "L2-n"	X	X	X							
034	Door Front Lay-Out - Typical "LK1-n" & "LK2-n"	X	X	X							
035	Door Front Lay-Out - Typical "LK1-n" & "LK2-n"	X	X	X							
036	Users Legend - Typical "LK1-n" & "LK2-n"	X	X	X							
037	Items Acronym - Typical "LK1-n" & "LK2-n"	X	X	X							
038	Functional Drawing - Typical "LK1-n" & "LK2-n"	X	X	X							
039	Functional Drawing - Typical "LK1-n" & "LK2-n"	X	X	X							
040	Functional Drawing - Typical "LK1-n" & "LK2-n"	X	X	X							
041	Functional Drawing - Typical "LK1-n" & "LK2-n"	X	X	X							
042	Functional Drawing - Typical "LK1-n" & "LK2-n"	X	X	X							
043	Functional Drawing - Typical "LK1-n" & "LK2-n"	X	X	X							
044	Functional Drawing - Typical "LK1-n" & "LK2-n"	X	X	X							
045	Functional Drawing - Typical "LK1-n" & "LK2-n"	X	X	X							
046	Functional Drawing - Typical "LK1-n" & "LK2-n"	X	X	X							
047	Functional Drawing - Typical "LK1-n" & "LK2-n"	X	X	X							
048	Door Front Lay-Out - Typical "LE2-320"	X	X	X							
049	Users Legend - Typical "LE2-320"	X	X	X							
050	Functional Drawing - Typical "LE2-320"	X	X	X							
051	Functional Drawing - Typical "LE2-320"	X	X	X							
052	Functional Drawing - Typical "LE2-320"	X	X	X							

ROSETTI MARINO — RED LINE AS BUILT STAMP

RLMU	✖ Yes ☐ No
Description	This document represents the final as-built version incorporating the latest approved information.
Reviewed & Confirmed by	Rosetti Marino S.P.A.
Signature /Date	

Notes: Tick"Yes" only when the document reflects the final as-commissioned condition and the red-line mark-up (RLMU) has been incorporated without a new revision.
Tick "No" if the last approved revision already represents the final condition, with no redline markup required.

ESA ENGINEERING

DWG n° : 231298/SD/31
Item n° : PF1002983/26

ROSETTI MARINO

REV.	DATE	DRN	CHKD	APPD	DESCRIPTION
=					
+					
2	18/09/2024	Santinelli	Flamminio	Sigismondi	As Built (ASB)
1	10/07/2024	Santinelli	Flamminio	Sigismondi	Accepted for Construction (AFC)
0	09/05/2024	Santinelli	Flamminio	Sigismondi	Issued for review (IFR)

TITLE : "SG-200N1"
LV SWG FUNCTIONAL DIAGRAMS - TYPICAL FEEDERS
Index

CONTRACT NO./TITLE CW-I-WP4-2023-05/HOLLANDSE KUST NOORD WIND PARK | SCALE : NTS

A3 | DRAWING NO. 1723002197-EL-DG-00031 | SHEET 002 | REV. 02

F.to UNI A3: 420mmx297mm

File Name : 1723002197-EL-DG-00031 Rev. 02

INDEX SHEETS

Sheet	Description	Revision 0	1	2	3	4	5	6	7	8	9
053	Functional Drawing - Typical "LE2-320"	X	X	X							
054	Functional Drawing - Typical "LE2-320"	X	X	X							
055	Functional Drawing - Typical "LE2-320"	X	X	X							
056	Functional Drawing - Typical "LE2-320"	X	X	X							

Sheet	Description	Revision 0	1	2	3	4	5	6	7	8	9

RED LINE AS BUILT STAMP

RLMU	✖ Yes ☐ No
Description	This document represents the final as-built version incorporating the latest approved information.
Reviewed & Confirmed by	Rosetti Marino S.P.A.
Signature /Date	Claudia Fiorucci

Notes: Tick"Yes" only when the document reflects the final as-commissioned condition and the red-line mark-up (RLMU) has been incorporated without a new revision.
Tick "No" if the last approved revision already represents the final condition, with no redline markup required.

DWG n° : 231298/SD/31
Item n° : PF1002983/26

REV.	DATE	DRN	CHKD	APPD	DESCRIPTION
=					
+					
2	18/09/2024	Santinelli	Flamminio	Sigismondi	As Built (ASB)
1	10/07/2024	Santinelli	Flamminio	Sigismondi	Accepted for Construction (AFC)
0	09/05/2024	Santinelli	Flamminio	Sigismondi	Issued for review (IFR)

ROSETTI MARINO

TITLE : "SG-200N1"
LV SWG FUNCTIONAL DIAGRAMS - TYPICAL FEEDERS
Index

CONTRACT NO./TITLE CW-I-WP4-2023-05/HOLLANDSE KUST NOORD WIND PARK | SCALE : NTS

A3 | DRAWING NO. 1723002197-EL-DG-00031 | SHEET 003 | REV. 02

F.to UNI A3: 420mmx297mm

File Name : 1723002197-EL-DG-00031 Rev. 02

SYMBOLS LEGEND

GRAPHICAL SYMBOLS	DESCRIPTION	GRAPHICAL SYMBOLS	DESCRIPTION	GRAPHICAL SYMBOLS	DESCRIPTION	GRAPHICAL SYMBOLS	DESCRIPTION
QF1	CIRCUIT BREAKER WITH AUTOMATIC RELEASE		CAPACITIVE VOLTAGE DIVIDER		COIL OF A MECHANICALLY LATCHED RELAY		DELAYED ACTION (IN THE DIRECTION OF MOVEMENT FROM THE ARC TOWARDS ITS CENTRE)
	CIRCUIT BREAKER WITH AUTOMATIC RELEASE AND BUILT-IN THERMOMAGNETIC RELEASE		CURRENT TRANSFORMER		INDICATOR, ELECTROMECHANICAL ELEMENT		POSITION SWITCH (LIMIT SWITCH), MAKE CONTACT
	SWITCH DISCONNECTOR		CURRENT TRANSFORMER WITH TWO CORES AND TWO SECONDARY WINDINGS		LAMP (GENERAL SYMBOL)		POSITION SWITCH (LIMIT SWITCH), BREAK CONTACT
d	CONTACTOR		INDICATING INSTRUMENT GENERAL SYMBOL		SEMICONDUCTOR DIODE	E –	OPERATED BY PUSHING
	LOCK WITH FREE KEY WHEN THE DEVICE IS IN OPEN POSITION		INTEGRATING INSTRUMENT (GENERAL SYMBOL)		LED	F –	OPERATED BY TURNING
	LOCK WITH FREE KEY WHEN THE DEVICE IS IN CLOSE POSITION		DISCONNECTING FUSE, NOT WITH LIVE CIRCUIT AND WITH MECHANICAL LINKAGE (STRIKER FUSE)	I DC / I AC	TRANSDUCER OF ALTERNATING CURRENT MEASURE INTO DIRECT CURRENT SIGNAL		THREE HELD POSITIONS TURNING SWITCH
	PLUG AND SOCKET (MALE AND FEMALE)		OPERATING DEVICE (GENERAL SYMBOL)		EARTH, GROUND (GENERAL SYMBOL)		THREE POSITIONS TURNING SWITCH, WITH SPRING THROWBACK TO THE CENTRAL POSITION
	VOLTAGE TRANSFORMER WITH TWO WINDINGS		COIL OF A TIME DELAYED OPERATING RELAY		MAKE CONTACT		MECHANICAL, PNEUMATIC OR HYDRAULIC CONNECTION
	VOLTAGE TRANSFORMER WITH THREE WINDINGS		COIL OF A TIME DELAYED RELEASING RELAY		BREAK CONTACT		MECHANICAL INTERLOCK BETWEEN TWO DEVICES
	CAPACITOR (GENERAL SYMBOL)		BISTABLE RELAY		CHANGE-OVER BREAK BEFORE MAKE CONTACT		RESISTOR (GENERAL SYMBOL)

RED LINE AS BUILT STAMP

RLMU	✖ Yes ☐ No
Description	This document represents the final as-built version incorporating the latest approved information.
Reviewed & Confirmed by	Rosetti Marino S.P.A.
Signature /Date	Claudia Gorchi

Notes: Tick"Yes" only when the document reflects the final as-commissioned condition and the red-line mark-up (RLMU) has been incorporated without a new revision.
Tick "No" if the last approved revision already represents the final condition, with no redline markup required.

REV.	DATE	DRN	CHKD	APPD	DESCRIPTION
=					
+					
2	18/09/2024	Santinelli	Flamminio	Sigismondi	As Built (ASB)
1	10/07/2024	Santinelli	Flamminio	Sigismondi	Accepted for Construction (AFC)
0	09/05/2024	Santinelli	Flamminio	Sigismondi	Issued for review (IFR)

DWG n° : 231298/SD/31
Item n° : PF1002983/26

ROSETTI MARINO

TITLE : "SG-200N1"
LV SWG FUNCTIONAL DIAGRAMS - TYPICAL FEEDERS
Graphical Symbols

CONTRACT NO./TITLE CW-I-WP4-2023-05/HOLLANDSE KUST NOORD WIND PARK | SCALE : NTS

A3 | DRAWING NO. 1723002197-EL-DG-00031 | SHEET 004 | REV. 02

F.to UNI A3: 420mmx297mm

File Name : 1723002197-EL-DG-00031 Rev. 02

GENERAL NOTES

THE DIAGRAM INDICATES THE FOLLOWING CONDITIONS :


- CIRCUIT-BREAKER IN OPEN POSITION
- DE-ENERGIZED CIRCUITS
- DRAWER INSERTED

THE AUXILIARY CIRCUITS WILL HAVE THE FOLLOWING CHARACTERISTICS :


- 24VDC (+) 1,5mmq RED TYPE CABLE SH-W
- 24vdc (-) 1,5mmq WHITE TYPE CABLE SH-W
- AUXILIARY CONTACTS TO TERMINAL STRIP 1,5mmq BLACK TYPE CABLE SH-W
- 230Vac 1,5mmq BLACK TYPE SH-W
- VOLTMETRICAL CIRCUITS 1,5mmq BLACK TYPE CABLE SH-W
- AMMETRICAL CIRCUIT 2,5mmq BLACK TYPE CABLE SH-W

ACCESSORIES REMOVABLE DRAWERS :


- THROUGH THE ACCESSORY (LEVER + PADLOCK) SHOWN IN THE PHOTO IT WILL BE POSSIBLE TO LOCK THE CIRCUIT-BREAKER OF THE WITHDRAWABLE DRAWER IN THE OPEN POSITION

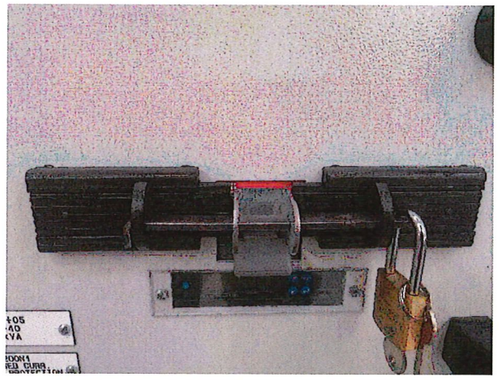

DETAIL OF CABLE ATTACHMENT ON CU BARS FOR WITHDRAWABLE DRAWERS :

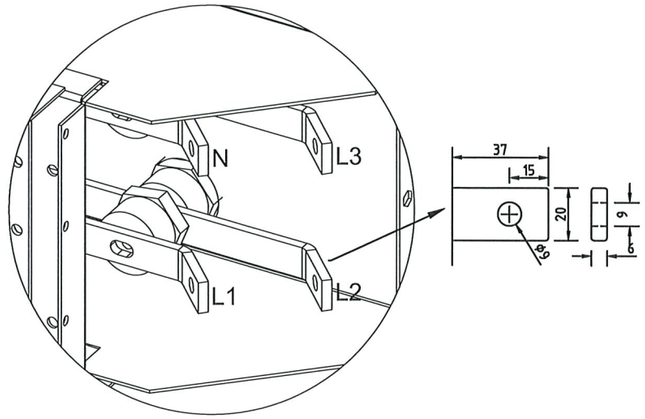

MARKING DETAIL OF TERMINAL BLOCKS :

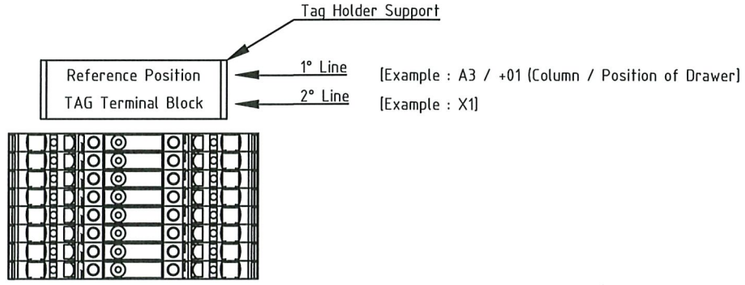

RED LINE AS BUILT STAMP

RLMU	✖ Yes ☐ No
Description	This document represents the final as-built version incorporating the latest approved information.
Reviewed & Confirmed by	Rosetti Marino S.P.A.
Signature /Date	

Notes: Tick"Yes" only when the document reflects the final as-commissioned condition and the red-line mark-up (RLMU) has been incorporated without a new revision.
Tick "No" if the last approved revision already represents the final condition, with no redline markup required.

REV.	DATE	DRN	CHKD	APPD	DESCRIPTION
=					
+					
2	18/09/2024	Santinelli	Flamminio	Sigismondi	As Built (ASB)
1	10/07/2024	Santinelli	Flamminio	Sigismondi	Accepted for Construction (AFC)
0	09/05/2024	Santinelli	Flamminio	Sigismondi	Issued for review (IFR)

DWG n° : 231298/SD/31
Item n° : PF1002983/26

ROSETTI MARINO

TITLE : "SG-200N1"
LV SWG FUNCTIONAL DIAGRAMS - TYPICAL FEEDERS
General Notes

CONTRACT NO./TITLE CW-I-WP4-2023-05/HOLLANDSE KUST NOORD WIND PARK | SCALE : NTS


A3 | DRAWING NO. 1723002197-EL-DG-00031 | SHEET 006 | REV. 02

F.to UNI A3: 420mmx297mm

File Name : 1723002197-EL-DG-00031 Rev. 02

DOOR FRONT LAY-OUT

TYPICAL : MOTOR FEEDER (M1)

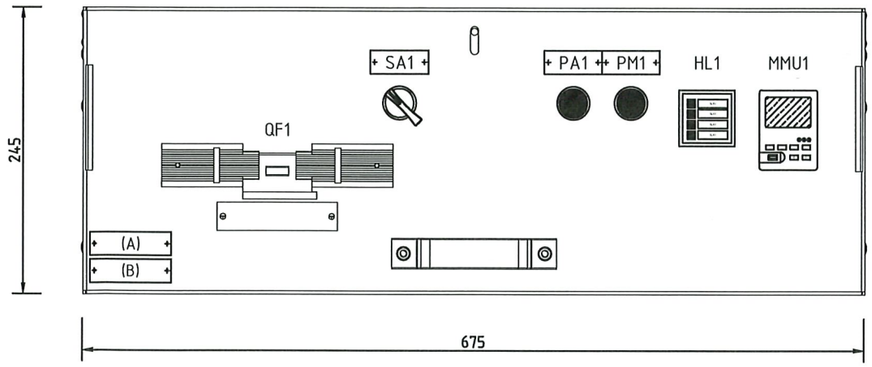


NOTE :


A) IDENTIFICATION name plate (type-1A) , with :
- Drawer position [Column / Position inside SWB]
- Typical name [reference applicability typical used]
- Power [reference applicability typical used]


B) USER name plate (type-1B), with :
- Item User [to see SLD diagrams]
- User Description [to see SLD diagrams]

DEVICES name plate			
ITEM	DESCRIPTION 1	DESCRIPTION 2	NOTE
MMU1	Unit Motor Control HMI		NO plate
QF1	Circuit Breaker		NO plate
SA1	LOC-REM	SELECTOR	Type-2A
PA1	STOP	MOTOR	Type-2A
PM1	RUN	MOTOR	Type-2A
HL1	Multiled	Signalling	NO plate

NO MARK UP
AS COMMISSIONED: MARIA GIROTTI 31/3/25

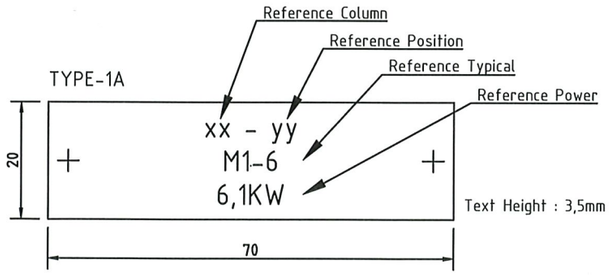

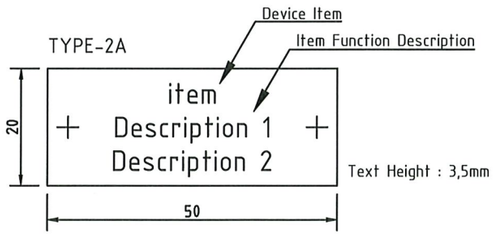

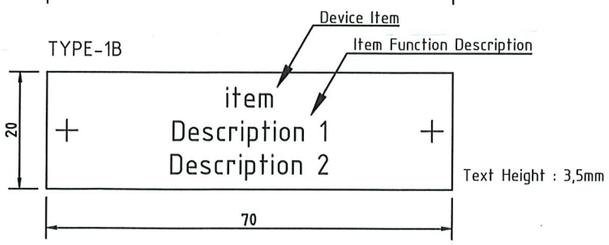

RED LINE AS BUILT STAMP

RLMU	✖ Yes ☐ No
Description	This document represents the final as-built version incorporating the latest approved information.
Reviewed & Confirmed by	Rosetti Marino S.P.A.
Signature /Date	

Notes: Tick"Yes" only when the document reflects the final as-commissioned condition and the red-line mark-up (RLMU) has been incorporated without a new revision.
Tick "No" if the last approved revision already represents the final condition, with no redline markup required.

=	TYPICAL
+	M1
DWG n° :	231298/SD/31
Item n° :	PF1002983/26

ROSETTI MARINO

REV.	DATE	DRN	CHKD	APPD	DESCRIPTION
2	18/09/2024	Santinelli	Flamminio	Sigismondi	As Built (ASB)
1	10/07/2024	Santinelli	Flamminio	Sigismondi	Accepted for Construction (AFC)
0	09/05/2024	Santinelli	Flamminio	Sigismondi	Issued for review (IFR)

TITLE : "SG-200N1"
LV SWG FUNCTIONAL DIAGRAMS - TYPICAL FEEDERS
Door Front Lay-Out - Typical "M1-n"

CONTRACT NO./TITLE CW-I-WP4-2023-05/HOLLANDSE KUST NOORD WIND PARK | SCALE : NTS

A3 | DRAWING NO. 1723002197-EL-DG-00031 | SHEET 007 | REV. 02

F.to UNI A3: 420mmx297mm

File Name : 1723002197-EL-DG-00031 Rev. 02

USERS LEGEND

TYPICAL : MOTOR FEEDER (M1)

TYPICAL APPLICABILITY					
ITEM	ITEM TAG	DESCRIPTION TAG	REFERENCE POSITION (written on name name plate "type-1A)	REFERENCE POWER (written on name name plate "type-1A)	REFERENCE TYPICAL (written on name name plate "type-1A)
1	PM-50001A	SEA WATER PUMP A	A6 / +01	6,1 kW	M1-6
2	PM-50001B	SEA WATER PUMP B	A7 / +01	6,1 kW	M1-6

NO MARK UP
AS COMMISSIONED : M.M.A GIROT.
31/3/25

RED LINE AS BUILT STAMP

RLMU	✖ Yes ☐ No
Description	This document represents the final as-built version incorporating the latest approved information.
Reviewed & Confirmed by	Rosetti Marino S.P.A.
Signature /Date	Claudia Zanchi

Notes: Tick"Yes" only when the document reflects the final as-commissioned condition and the red-line mark-up (RLMU) has been incorporated without a new revision.
Tick "No" if the last approved revision already represents the final condition, with no redline markup required.

= TYPICAL
\+ M1

DWG n° : 231298/SD/31
Item n° : PF1002983/26

REV.	DATE	DRN	CHKD	APPD	DESCRIPTION
2	18/09/2024	Santinelli	Flamminio	Sigismondi	As Built (ASB)
1	10/07/2024	Santinelli	Flamminio	Sigismondi	Accepted for Construction (AFC)
0	09/05/2024	Santinelli	Flamminio	Sigismondi	Issued for review (IFR)

ROSETTI MARINO


TITLE : "SG-200N1"
LV SWG FUNCTIONAL DIAGRAMS - TYPICAL FEEDERS
Users Legend - Typical "M1-n"

CONTRACT NO./TITLE CW-I-WP4-2023-05/HOLLANDSE KUST NOORD WIND PARK | SCALE : NTS

A3 | DRAWING NO. 1723002197-EL-DG-00031 | SHEET 008 | REV. 02

F.to UNI A3: 420mmx297mm

File Name : 1723002197-EL-DG-00031 Rev. 02

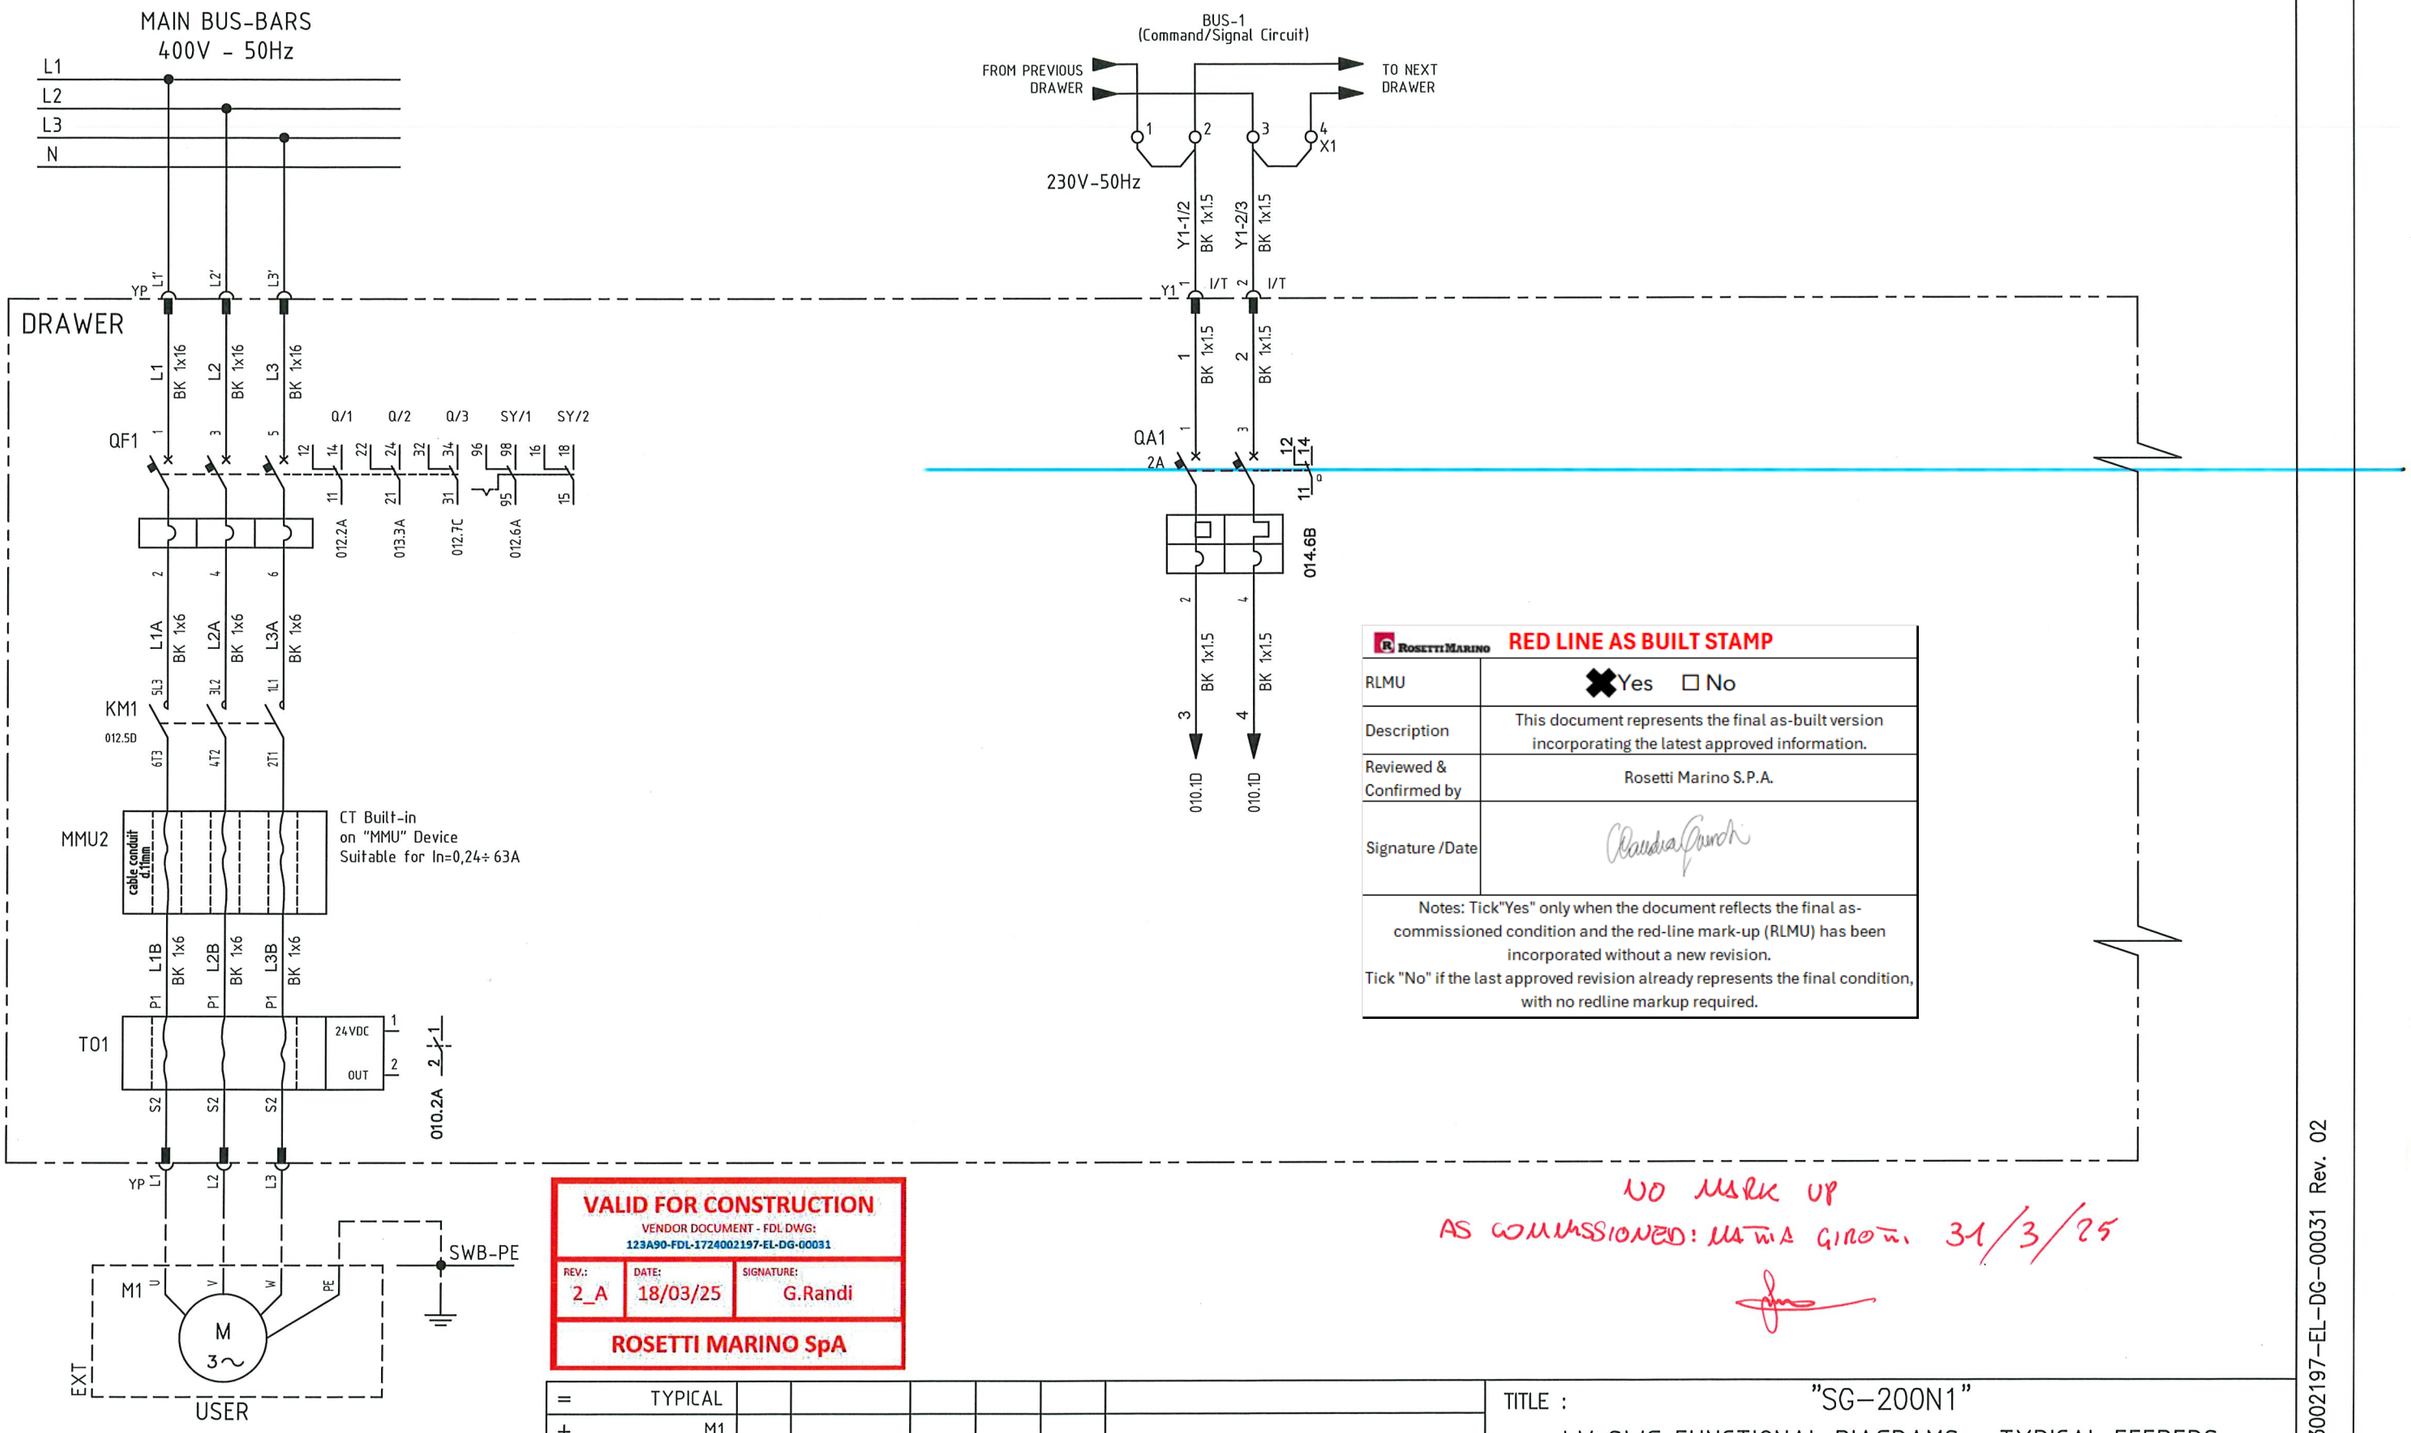

ROSETTI MARINO	RED LINE AS BUILT STAMP
RLMU	✖ Yes ☐ No
Description	This document represents the final as-built version incorporating the latest approved information.
Reviewed & Confirmed by	Rosetti Marino S.P.A.
Signature /Date	

Notes: Tick"Yes" only when the document reflects the final as-commissioned condition and the red-line mark-up (RLMU) has been incorporated without a new revision.
Tick "No" if the last approved revision already represents the final condition, with no redline markup required.

VALID FOR CONSTRUCTION
VENDOR DOCUMENT - FDL DWG:
123A90-FDL-17240002197-EL-DG-00031

REV.:	DATE:	SIGNATURE:
2_A	18/03/25	G.Randi

ROSETTI MARINO SpA

NO MARK UP
AS COMMISSIONED: MARINA GIRONI 31/3/25

=	TYPICAL
+	M1
DWG n° :	231298/SD/31
Item n° :	PF1002983/26

REV.	DATE	DRN	CHKD	APPD	DESCRIPTION
2	18/09/2024	Santinelli	Flamminio	Sigismondi	As Built (ASB)
1	10/07/2024	Santinelli	Flamminio	Sigismondi	Accepted for Construction (AFC)
0	09/05/2024	Santinelli	Flamminio	Sigismondi	Issued for review (IFR)

IMESA ELECTRICAL ENGINEERING
CROSSWIND
ROSETTI MARINO


TITLE : "SG-200N1"
LV SWG FUNCTIONAL DIAGRAMS - TYPICAL FEEDERS
Functional Drawing - Typical "M1-n"

CONTRACT NO./TITLE CW-I-WP4-2023-05/HOLLANDSE KUST NOORD WIND PARK | SCALE : NTS

A3 | DRAWING NO. 1723002197-EL-DG-00031 | SHEET 009 | REV. 02

F.to UNI A3: 420mmx297mm

File Name : 1723002197-EL-DG-00031 Rev. 02

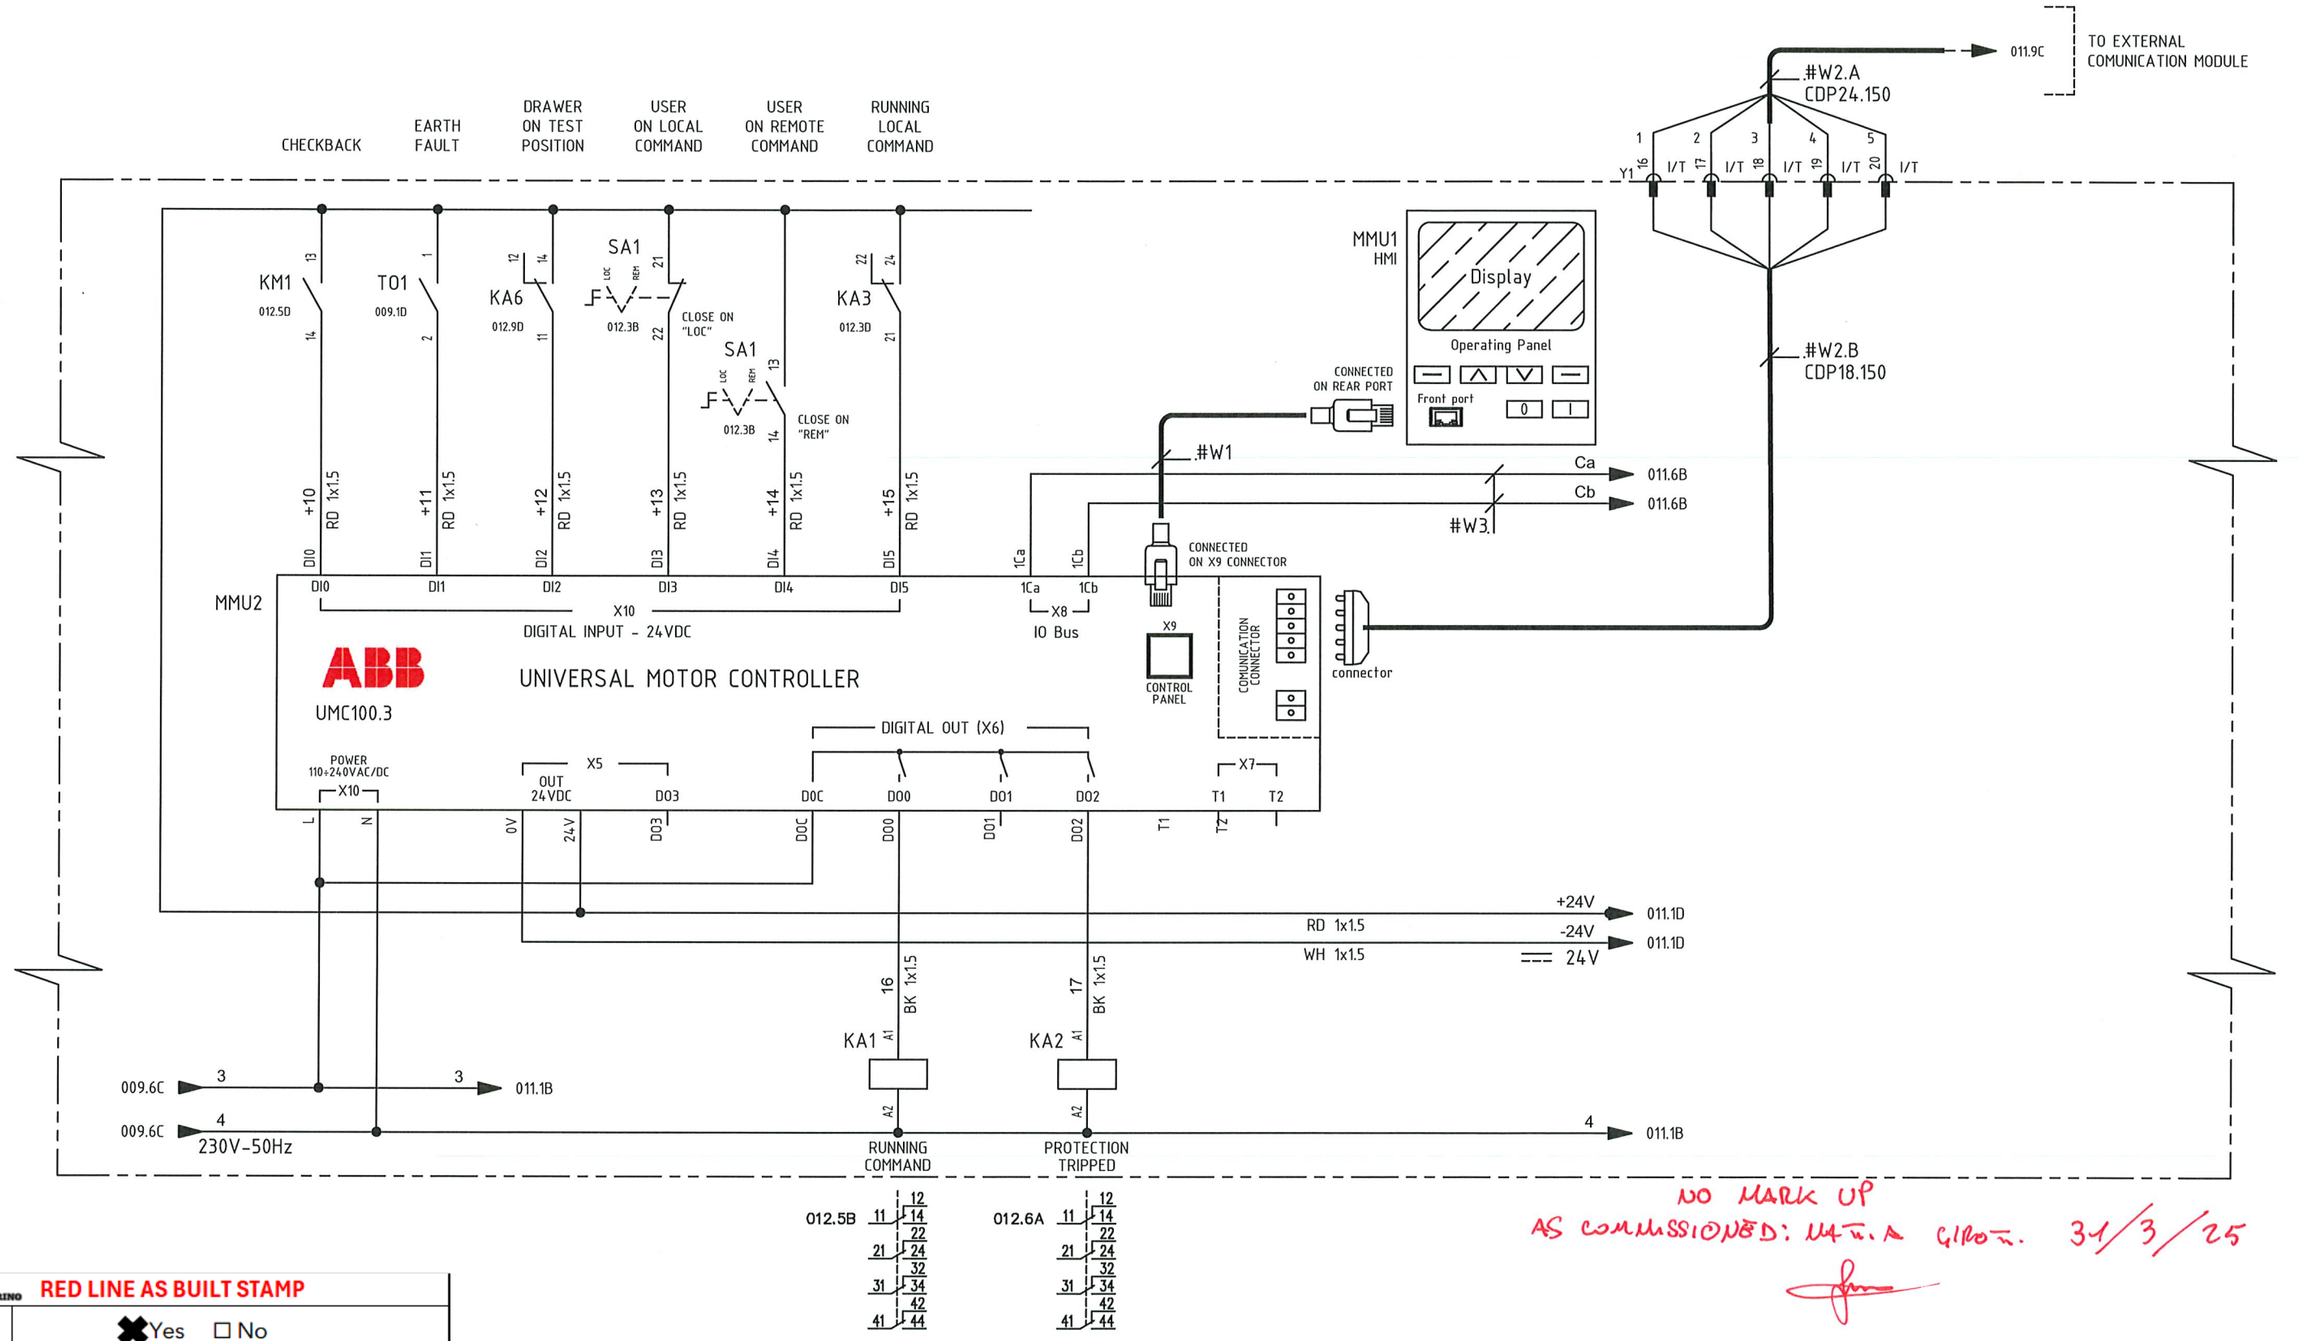

NO MARK UP
AS COMMISSIONED: MATTIA GIROTTI 31/3/25

RED LINE AS BUILT STAMP

RLMU	✖ Yes ☐ No
Description	This document represents the final as-built version incorporating the latest approved information.
Reviewed & Confirmed by	Rosetti Marino S.P.A.
Signature /Date	

Notes: Tick"Yes" only when the document reflects the final as-commissioned condition and the red-line mark-up (RLMU) has been incorporated without a new revision.
Tick "No" if the last approved revision already represents the final condition, with no redline markup required.

=	TYPICAL
+	M1
DWG n° :	231298/SD/31
Item n° :	PF1002983/26

REV.	DATE	DRN	CHKD	APPD	DESCRIPTION
2	18/09/2024	Santinelli	Flamminio	Sigismondi	As Built (ASB)
1	10/07/2024	Santinelli	Flamminio	Sigismondi	Accepted for Construction (AFC)
0	09/05/2024	Santinelli	Flamminio	Sigismondi	Issued for review (IFR)

ROSETTI MARINO


TITLE : "SG-200N1"
LV SWG FUNCTIONAL DIAGRAMS - TYPICAL FEEDERS
Functional Drawing - Typical "M1-n"

CONTRACT NO./TITLE CW-I-WP4-2023-05/HOLLANDSE KUST NOORD WIND PARK | SCALE : NTS

A3 | DRAWING NO. 1723002197-EL-DG-00031 | SHEET 010 | REV. 02

F.to UNI A3: 420mmx297mm

File Name : 1723002197-EL-DG-00031 Rev. 02

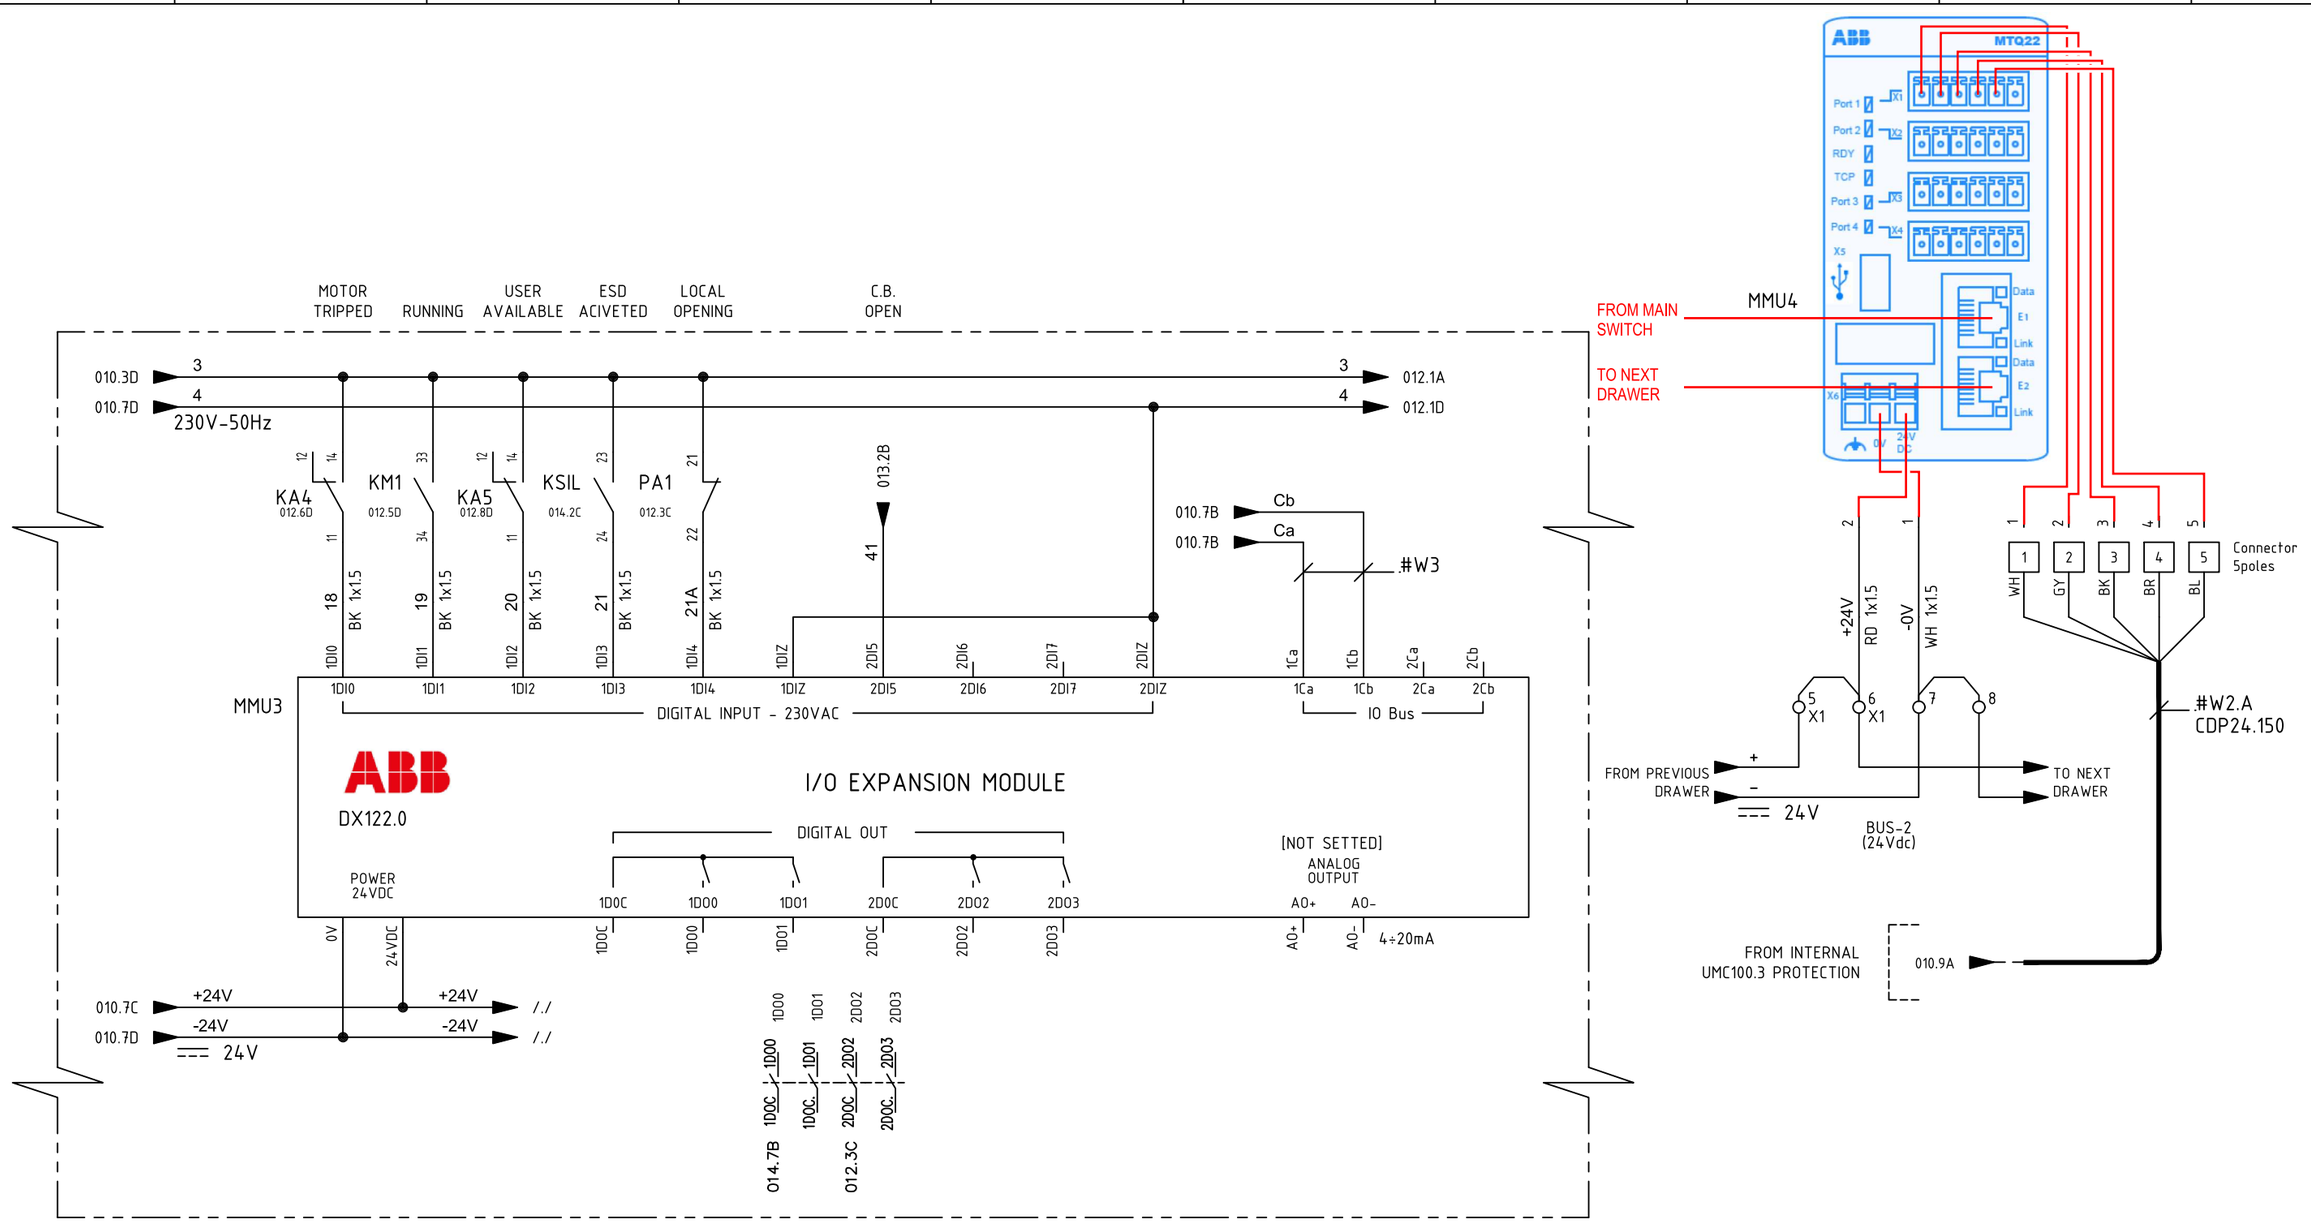

RED LINE AS BUILT STAMP

RLMU	✖ Yes ☐ No
Description	This document represents the final as-built version incorporating the latest approved information.
Reviewed & Confirmed by	Rosetti Marino S.P.A.
Signature /Date	

Notes: Tick"Yes" only when the document reflects the final as-commissioned condition and the red-line mark-up (RLMU) has been incorporated without a new revision.
Tick "No" if the last approved revision already represents the final condition, with no redline markup required.

REV.	DATE	DRN	CHKD	APPD	DESCRIPTION
2	18/09/2024	Santinelli	Flamminio	Sigismondi	As Built (ASB)
1	10/07/2024	Santinelli	Flamminio	Sigismondi	Accepted for Construction (AFC)
0	09/05/2024	Santinelli	Flamminio	Sigismondi	Issued for review (IFR)

TYPICAL
M1
231298/SD/31
PF1002983/26

TITLE : "SG-200N1"

LV SWG FUNCTIONAL DIAGRAMS - TYPICAL FEEDERS


Functional Drawing - Typical "M1-n"

CONTRACT NO./TITLE CW-I-WP4-2023-05/HOLLANDSE KUST NOORD WIND PARK | SCALE : NTS

A3 | DRAWING NO. 1723002197-EL-DG-00031 | SHEET 011 | REV. 02

F.to UNI A3: 420mmx297mm

File Name : 1723002197-EL-DG-00031 Rev. 02

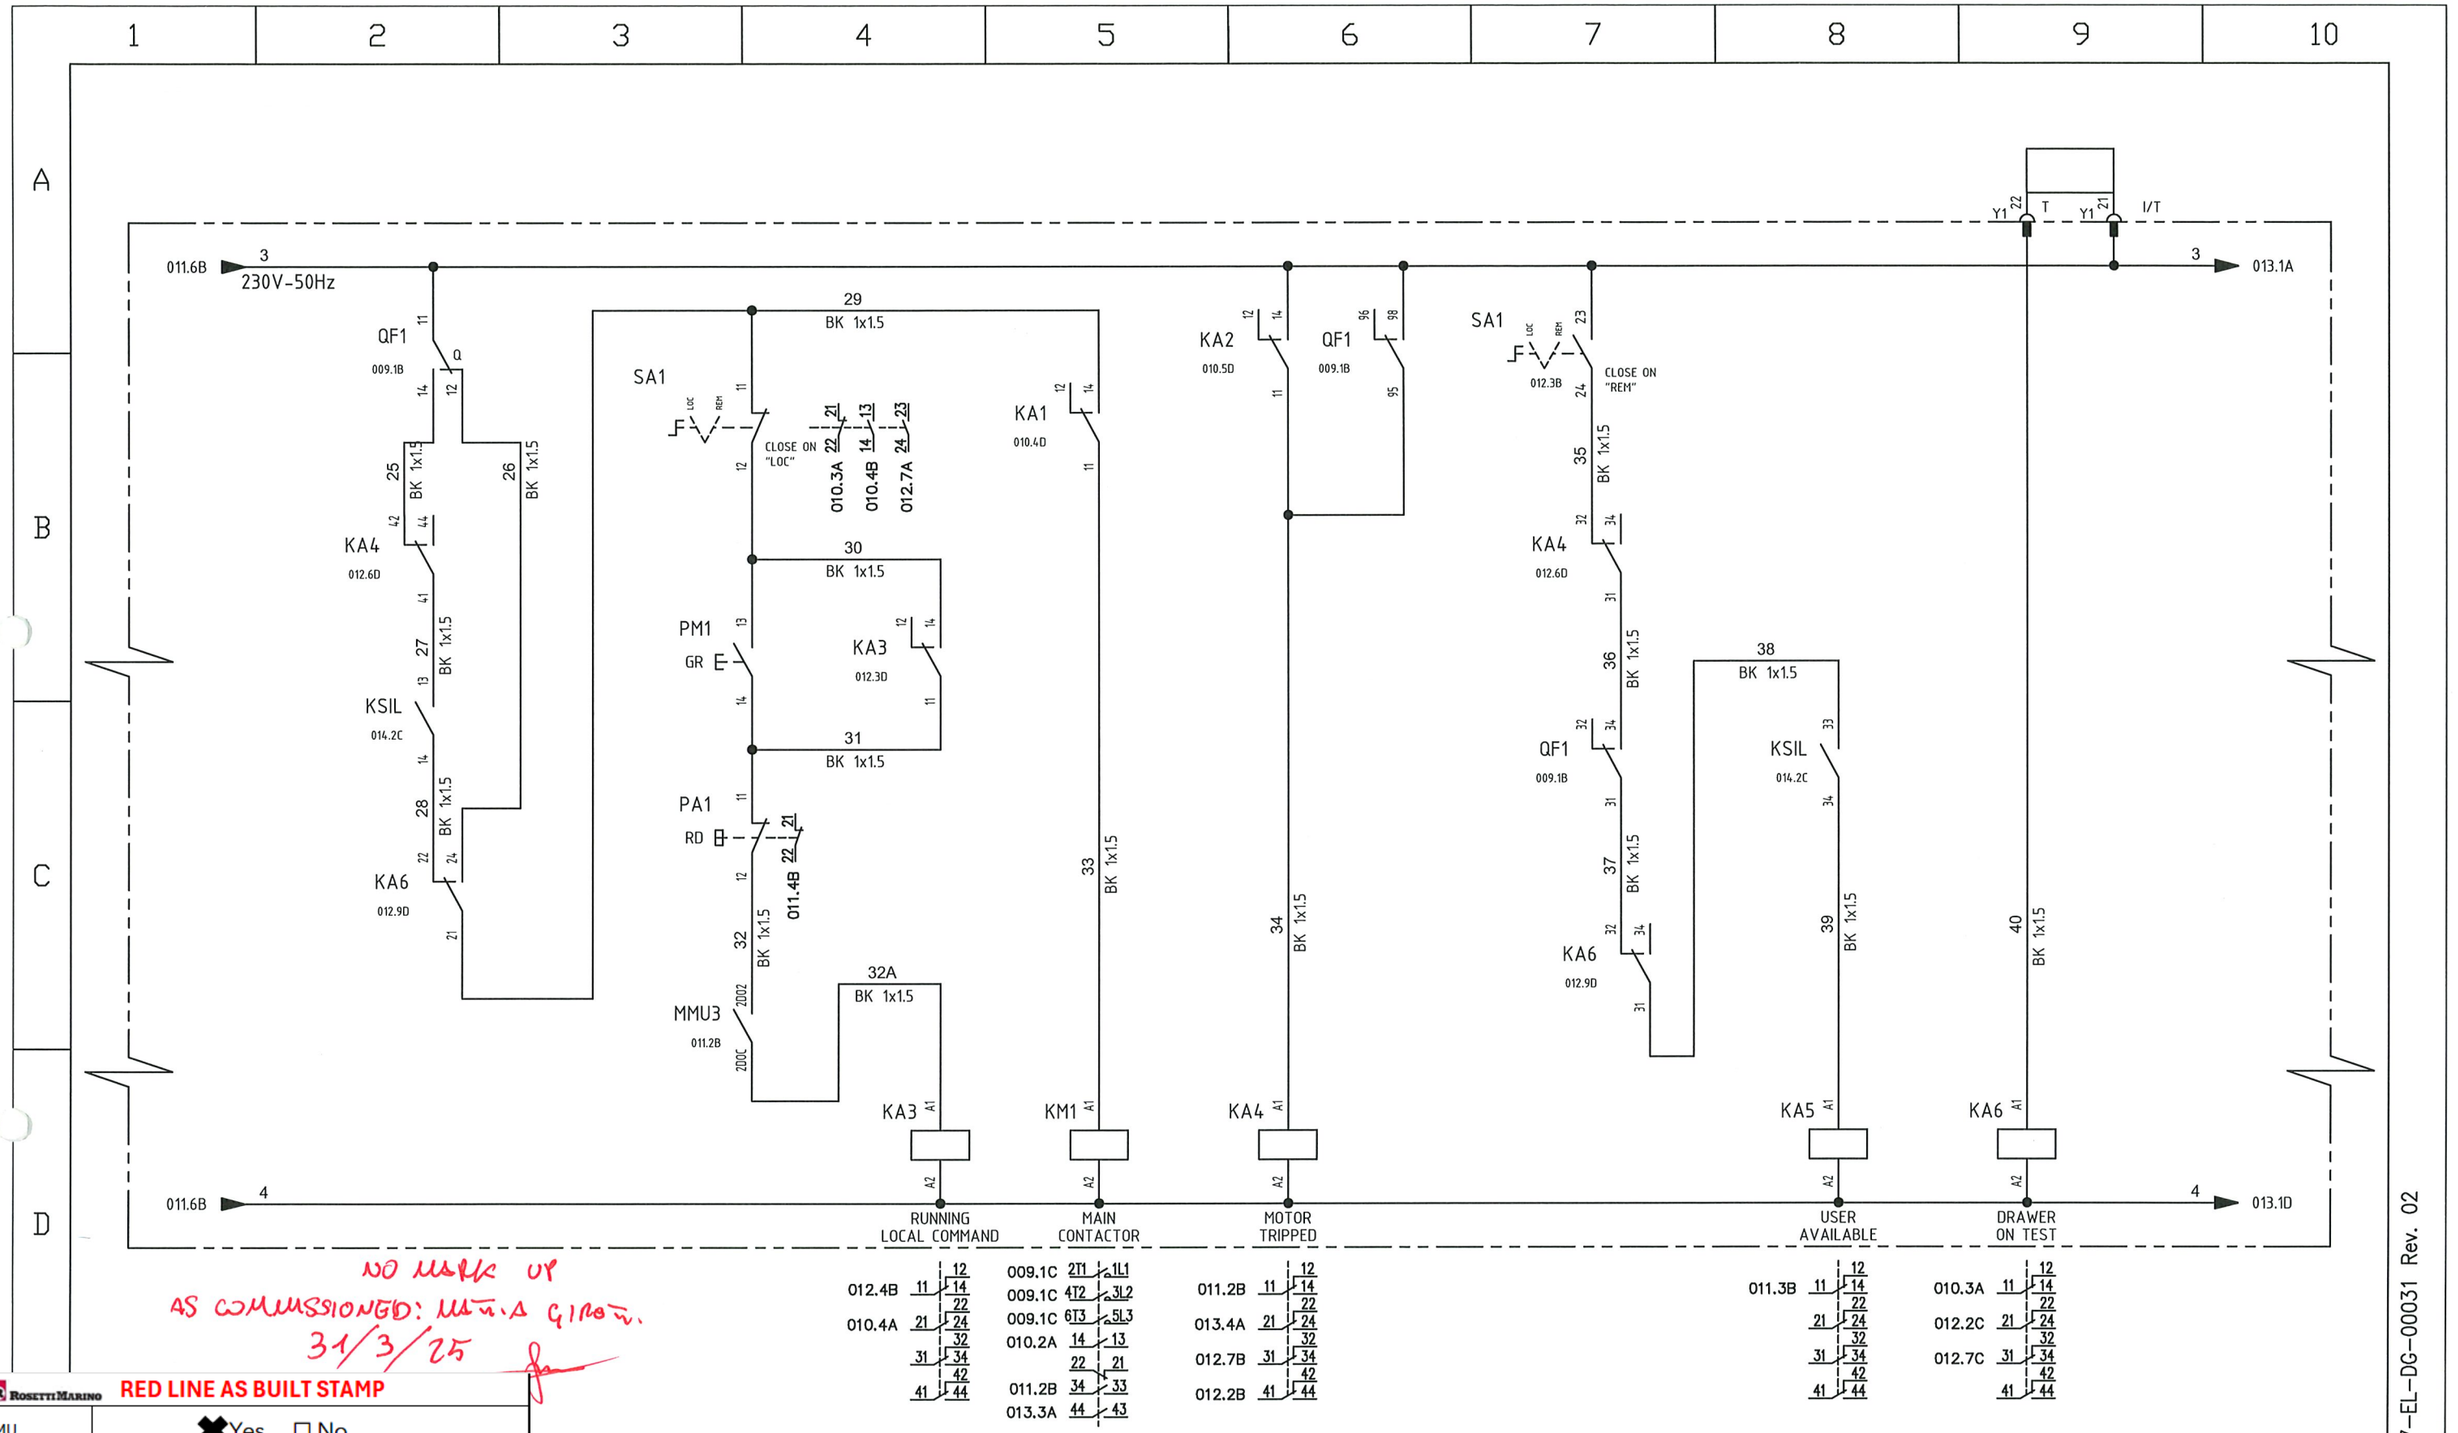

NO MARK UP
AS COMMISSIONED: MUMA GIROTTI
31/3/25

RED LINE AS BUILT STAMP

RLMU	✖ Yes ☐ No
Description	This document represents the final as-built version incorporating the latest approved information.
Reviewed & Confirmed by	Rosetti Marino S.P.A.
Signature /Date	

Notes: Tick"Yes" only when the document reflects the final as-commissioned condition and the red-line mark-up (RLMU) has been incorporated without a new revision.
Tick "No" if the last approved revision already represents the final condition, with no redline markup required.

=	TYPICAL
+	M1
DWG n° :	231298/SD/31
Item n° :	PF1002983/26

REV.	DATE	DRN	CHKD	APPD	DESCRIPTION
2	18/09/2024	Santinelli	Flamminio	Sigismondi	As Built (ASB)
1	10/07/2024	Santinelli	Flamminio	Sigismondi	Accepted for Construction (AFC)
0	09/05/2024	Santinelli	Flamminio	Sigismondi	Issued for review (IFR)

ROSETTI MARINO

TITLE : "SG-200N1"

LV SWG FUNCTIONAL DIAGRAMS - TYPICAL FEEDERS


Functional Drawing - Typical "M1-n"

CONTRACT NO./TITLE CW-I-WP4-2023-05/HOLLANDSE KUST NOORD WIND PARK | SCALE : NTS

A3 | DRAWING NO. 1723002197-EL-DG-00031 | SHEET 012 | REV. 02

F.to UNI A3: 420mmx297mm

File Name : 1723002197-EL-DG-00031 Rev. 02

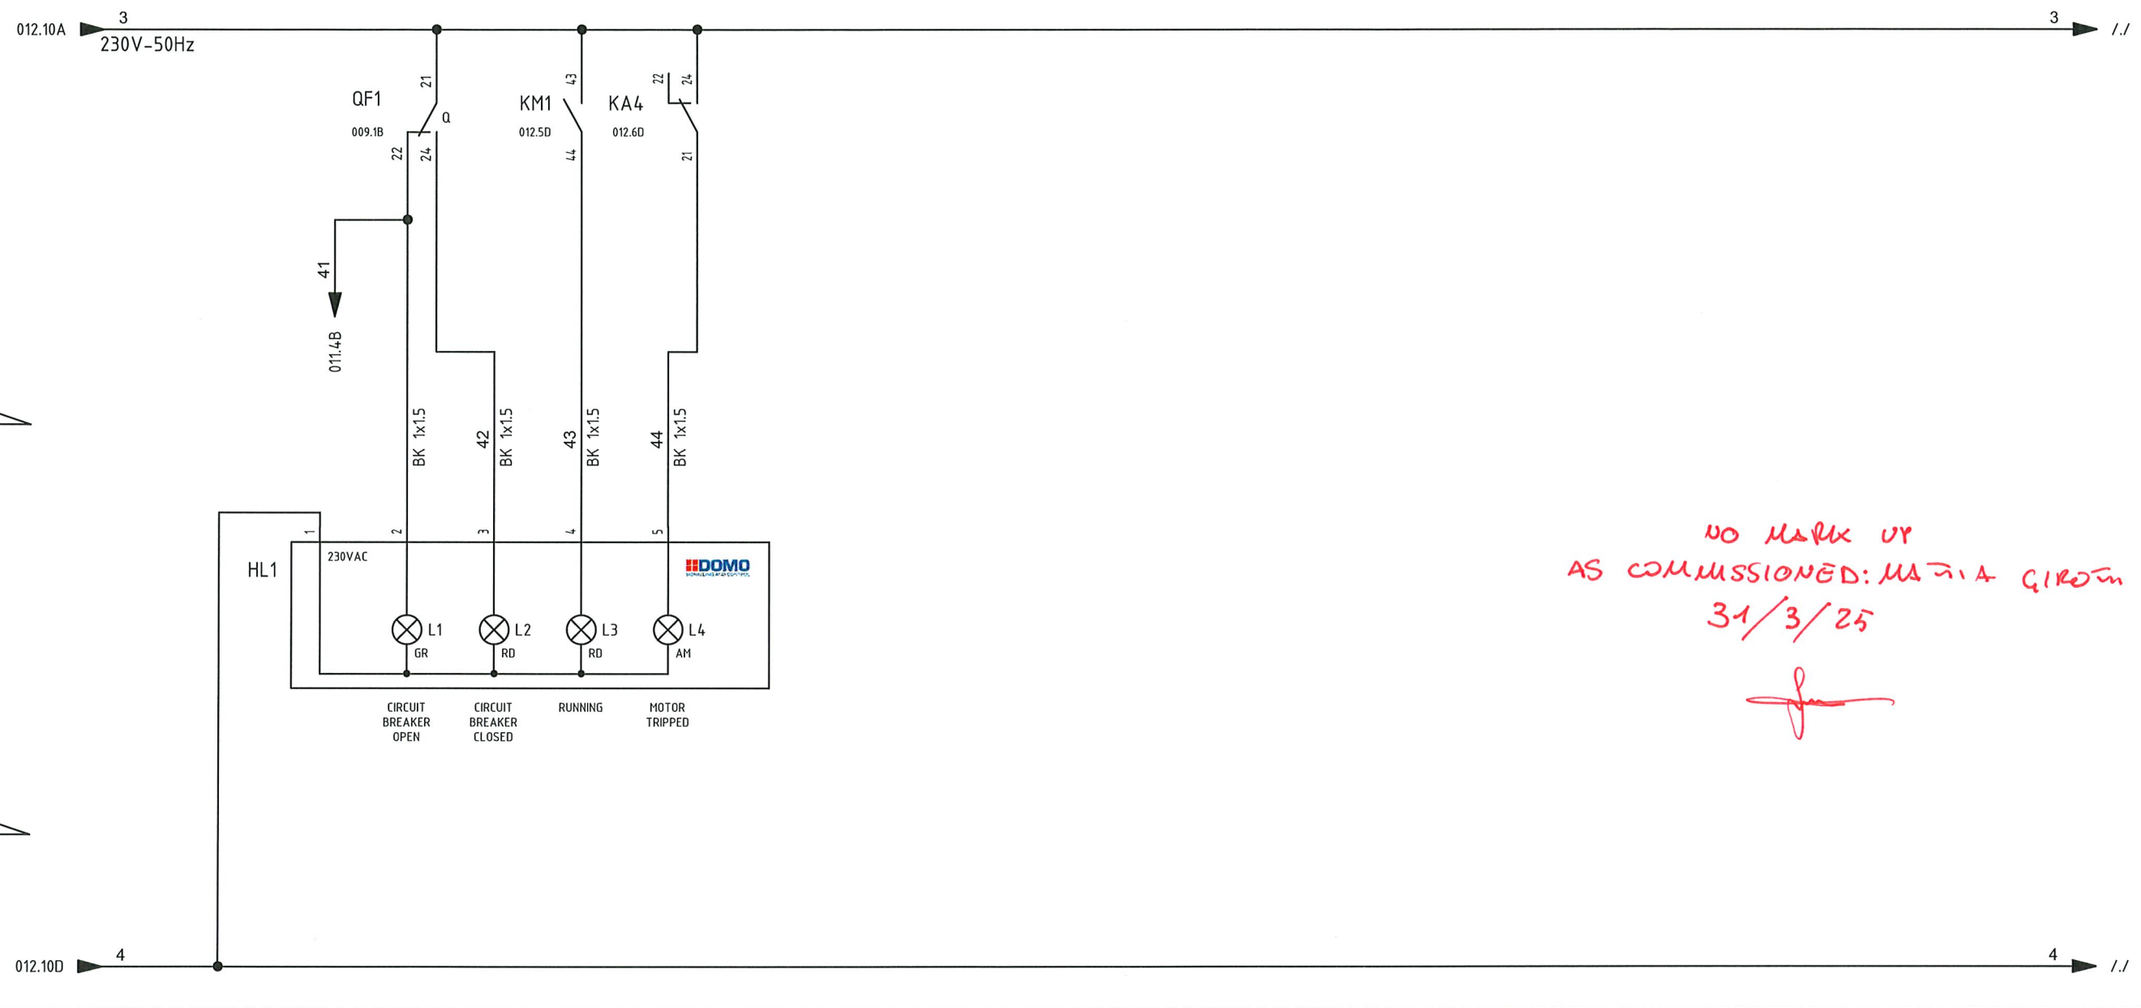

NO MARK UP
AS COMMISSIONED: MARIA GIROTTI
31/3/25

RED LINE AS BUILT STAMP

RLMU	✖ Yes ☐ No
Description	This document represents the final as-built version incorporating the latest approved information.
Reviewed & Confirmed by	Rosetti Marino S.P.A.

Notes: Tick"Yes" only when the document reflects the final as-commissioned condition and the red-line mark-up (RLMU) has been incorporated without a new revision.
Tick "No" if the last approved revision already represents the final condition, with no redline markup required.

=	TYPICAL					
+	M1					
DWG n° :	231298/SD/31					
Item n° :	PF1002983/26					
2	18/09/2024	Santinelli	Flamminio	Sigismondi	As Built (ASB)	
1	10/07/2024	Santinelli	Flamminio	Sigismondi	Accepted for Construction (AFC)	
0	09/05/2024	Santinelli	Flamminio	Sigismondi	Issued for review (IFR)	
REV.	DATE	DRN	CHKD	APPD	DESCRIPTION	

ROSETTI MARINO

TITLE : "SG-200N1"

LV SWG FUNCTIONAL DIAGRAMS - TYPICAL FEEDERS


Functional Drawing - Typical "M1-n"

CONTRACT NO./TITLE	SCALE	
CW-I-WP4-2023-05/HOLLANDSE KUST NOORD WIND PARK	NTS	
A3	DRAWING NO. 1723002197-EL-DG-00031	SHEET 013 / REV. 02

F.to UNI A3: 420mmx297mm

File Name : 1723002197-EL-DG-00031 Rev. 02

ONLY FOR REPRESENTATION
FOR DETTAILS TO SEE RELEVANT
DOCUMENT N°1723002197-EL-DG-00030

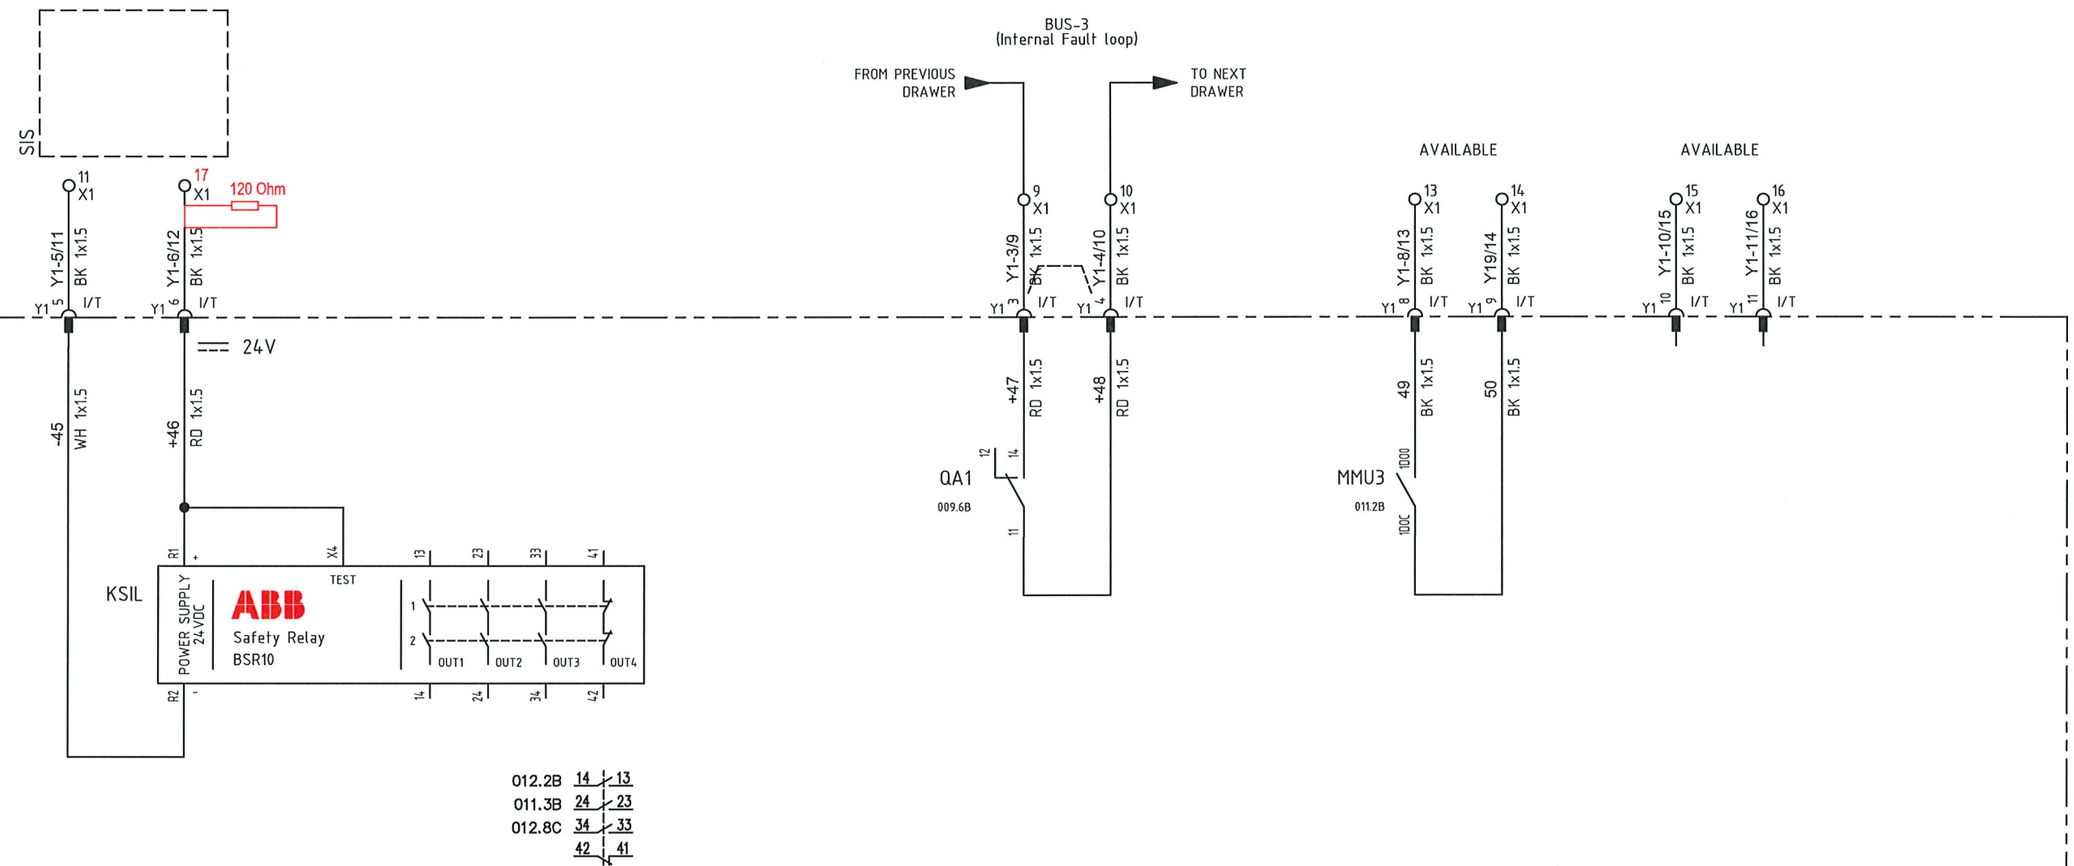

NO MARK UP
AS COMMISSIONED: MA. A GIROTTI
31/3/25

RED LINE AS BUILT STAMP	
RLMU	✖ Yes ☐ No
Description	This document represents the final as-built version incorporating the latest approved information.
Reviewed & Confirmed by	Rosetti Marino S.P.A.
Signature /Date	

Notes: Tick"Yes" only when the document reflects the final as-commissioned condition and the red-line mark-up (RLMU) has been incorporated without a new revision.
Tick "No" if the last approved revision already represents the final condition, with no redline markup required.

=	TYPICAL
+	M1
DWG n° :	231298/SD/31
Item n° :	PF1002983/26

REV.	DATE	DRN	CHKD	APPD	DESCRIPTION
2	18/09/2024	Santinelli	Flamminio	Sigismondi	As Built (ASB)
1	10/07/2024	Santinelli	Flamminio	Sigismondi	Accepted for Construction (AFC)
0	09/05/2024	Santinelli	Flamminio	Sigismondi	Issued for review (IFR)

ROSETTI MARINO

TITLE : "SG-200N1"
LV SWG FUNCTIONAL DIAGRAMS - TYPICAL FEEDERS
Functional Drawing - Typical "M1-n"

CONTRACT NO./TITLE CW-I-WP4-2023-05/HOLLANDSE KUST NOORD WIND PARK | SCALE : NTS

A3 | DRAWING NO. 1723002197-EL-DG-00031 | SHEET 014 | REV. 02

F.to UNI A3: 420mmx297mm

File Name : 1723002197-EL-DG-00031 Rev. 02

TYPICAL - M1 - Y1

AUXILIARY SOCKET
136450/001 (PF – 1 pcs) + 136458/005 (PM – 1 pcs)

N° PIN	1	2	3	4	5	6	7	8	9	10	11	12	13	14	15	16	17	18	19	20	21	22
JUMP			●	●																		
RACKED-OUT			X	X																		
TEST	X	X	X	X	X	X	X	X	X	X	X	X	X	X	X	X	X	X	X	X	X	X
RACKED-IN	X	X	X	X	X	X	X	X	X	X	X	X	X	X	X	X	X	X	X	X	X	
PIN USED	009.6A	009.6A	014.6B	014.6B	014.2B	014.2B		014.7B	014.8B	014.9B	014.9B					010.8A	010.8A	010.8A	010.8A	010.9A	012.9A	012.9A

1 2 3 4 5 6 7 8 9 10 11 12 13 14 15 16 17 18 19 20 21 22

← FIELD WHIT "X" - CONTACT CLOSE WHEN DRAWER IS IN RACKED-OUT POSITION
← FIELD WHIT "X" - CONTACT CLOSE WHEN DRAWER IS IN TEST POSITION
← FIELD WHIT "X" - CONTACT CLOSE WHEN DRAWER IS IN RACKED-IN POSITION
← CROS-REFERENCE USED PIN

NO MARK UP
31/3/25

ROSETTI MARINO RED LINE AS BUILT STAMP

RLMU	✖ Yes ☐ No
Description	This document represents the final as-built version incorporating the latest approved information.
Reviewed & Confirmed by	Rosetti Marino S.P.A.

Notes: Tick"Yes" only when the document reflects the final as-commissioned condition and the red-line mark-up (RLMU) has been incorporated without a new revision.
Tick "No" if the last approved revision already represents the final condition, with no redline markup required.

= TYPICAL
\+ M1

DWG n° : 231298/SD/31
Item n° : PF1002983/26

ENGINEERING

ROSETTI MARINO

REV.	DATE	DRN	CHKD	APPD	DESCRIPTION
2	18/09/2024	Santinelli	Flamminio	Sigismondi	As Built (ASB)
1	10/07/2024	Santinelli	Flamminio	Sigismondi	Accepted for Construction (AFC)
0	09/05/2024	Santinelli	Flamminio	Sigismondi	Issued for review (IFR)

TITLE : "SG-200N1"
LV SWG FUNCTIONAL DIAGRAMS - TYPICAL FEEDERS
Functional Drawing - Typical "M1-n"

CONTRACT NO./TITLE CW-I-WP4-2023-05/HOLLANDSE KUST NOORD WIND PARK | SCALE : NTS

A3 | DRAWING NO. 1723002197-EL-DG-00031 | SHEET 015 | REV. 02

F.to UNI A3: 420mmx297mm

File Name : 1723002197-EL-DG-00031 Rev. 02

UMC100 INTERNAL FUNCTION LOGIC

INPUT | INTERNAL LOGIC | OUTPUT

-KA3 LOCAL COMMAND RUNNIG 0/1 — DI5

-KA5 USER AVAILABLE 0/1 — 1DI2

to Modbus RTU 0/1 USER AVAILABLE

GREEN led

017.5D CHCBK 1

-QF1 CIRCUIT-BREAKER OPEN 0/1 — 2DI5

-KA6 DRAWER ON TEST POSITION 0/1 — DI2

-PA1 OPEN PUSH-BOTTOM 0/1 — 1DI4

-SA1 SELECTOR IN "REMOTE" POSITION 0/1 — DI4

from Modbus RTU RUN COMMAND 0/1

from Modbus RTU STOP COMMAND 0/1

RED led

ModBus RTU command

-SA1 SELECTOR IN "LOCAL" POSITION 0/1 — DI3

to Modbus RTU 0/1 -SA1 ON "LOCAL" POSITION

& ≥1 SET RESET Q

DO0 — -KA1 0/1 MAIN RUNNING COMMAND

KM 017.3D

2DO2 — -MMU3 0/1 LOCAL CONSENT TO CLOSE

NO MARK UP
AS COMMISSIONED: MARIA GIROTTI
31/3/25

ROSETTI MARINO RED LINE AS BUILT STAMP

RLMU	✖ Yes ☐ No
Description	This document represents the final as-built version incorporating the latest approved information.
Reviewed & Confirmed by	Rosetti Marino S.P.A.
Signature /Date	

Notes: Tick"Yes" only when the document reflects the final as-commissioned condition and the red-line mark-up (RLMU) has been incorporated without a new revision.
Tick "No" if the last approved revision already represents the final condition, with no redline markup required.

DWG n° : 231298/SD/31
Item n° : PF1002983/26

ROSETTI MARINO

REV.	DATE	DRN	CHKD	APPD	DESCRIPTION
=					
+					
2	18/09/2024	Santinelli	Flamminio	Sigismondi	As Built (ASB)
1	10/07/2024	Santinelli	Flamminio	Sigismondi	Accepted for Construction (AFC)
0	09/05/2024	Santinelli	Flamminio	Sigismondi	Issued for review (IFR)

TITLE : "SG-200N1"
LV SWG FUNCTIONAL DIAGRAMS - TYPICAL FEEDERS
UMC100 Internal Function Logic - Typical "M1-n"

CONTRACT NO./TITLE CW-I-WP4-2023-05/HOLLANDSE KUST NOORD WIND PARK | SCALE : NTS


A3 | DRAWING NO. 1723002197-EL-DG-00031 | SHEET 016 | REV. 02

F.to UNI A3: 420mmx297mm

File Name : 1723002197-EL-DG-00031 Rev. 02

UMC100 INTERNAL FUNCTION LOGIC

INPUT | INTERNAL LOGIC | OUTPUT

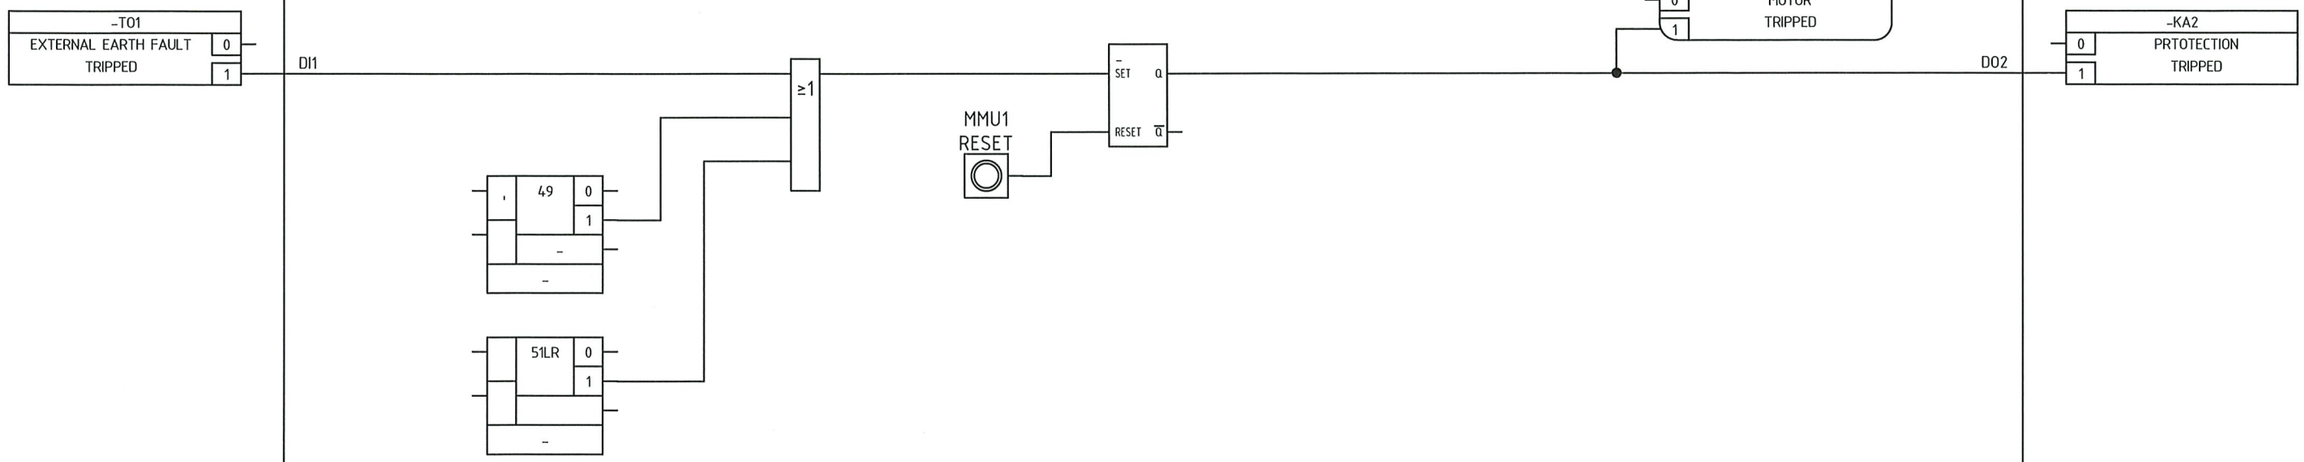

ROSETTI MARINO RED LINE AS BUILT STAMP	
RLMU	✖ Yes ☐ No
Description	This document represents the final as-built version incorporating the latest approved information.
Reviewed & Confirmed by	Rosetti Marino S.P.A.
Signature /Date	

Notes: Tick"Yes" only when the document reflects the final as-commissioned condition and the red-line mark-up (RLMU) has been incorporated without a new revision.
Tick "No" if the last approved revision already represents the final condition, with no redline markup required.

VALID FOR CONSTRUCTION
VENDOR DOCUMENT - FDL DWG:
123A90-FDL-1724002197-EL-DG-00031

REV.:	DATE:	SIGNATURE:
2_A	18/03/25	G.Randi

ROSETTI MARINO SpA

CROSSWIND

IMESA ELECTRICAL ENGINEERING

ROSETTI MARINO

DWG n° : 231298/SD/31
Item n° : PF1002983/26

REV.	DATE	DRN	CHKD	APPD	DESCRIPTION
2	18/09/2024	Santinelli	Flamminio	Sigismondi	As Built (ASB)
1	10/07/2024	Santinelli	Flamminio	Sigismondi	Accepted for Construction (AFC)
0	09/05/2024	Santinelli	Flamminio	Sigismondi	Issued for review (IFR)

TITLE : "SG-200N1"
LV SWG FUNCTIONAL DIAGRAMS - TYPICAL FEEDERS
UMC100 Internal Function Logic - Typical "M1-n"

CONTRACT NO./TITLE CW-I-WP4-2023-05/HOLLANDSE KUST NOORD WIND PARK | SCALE : NTS

A3 | DRAWING NO. 1723002197-EL-DG-00031 | SHEET 017 | REV. 02

F.to UNI A3: 420mmx297mm

File Name : 1723002197-EL-DG-00031 Rev. 02

UMC100 INTERNAL FUNCTION LOGIC

INPUT | INTERNAL LOGIC | OUTPUT


-KSIL
ESD ACTIVETED
0
1
1DI3
to Modbus RTU
0 ESD
1 ACTIVETED

-KM1
MOTOR RUNNING
0
1
1DI1
to Modbus RTU
0 MOTOR
1 RUNNING

-PA1
PUSH-BUTTON ACTIVATED
0
1
1DI4
to Modbus RTU
0 STOPPED
1 RUNNING

Aavr
to Modbus RTU
0 AVERAGE CURRENT
1 MEASURE

MMU1 [Drawer Front Dispaly]

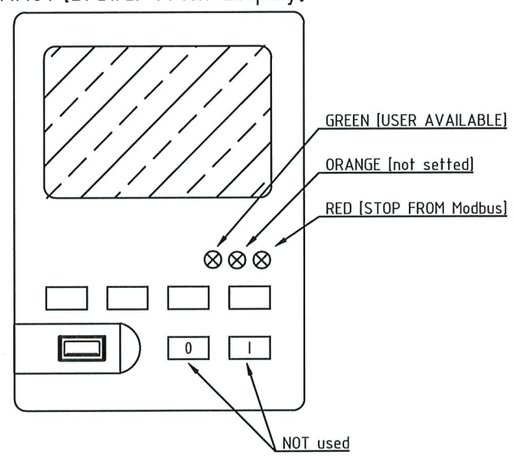

RED LINE AS BUILT STAMP

RLMU	✖ Yes ☐ No
Description	This document represents the final as-built version incorporating the latest approved information.
Reviewed & Confirmed by	Rosetti Marino S.P.A.
Signature /Date	

Notes: Tick"Yes" only when the document reflects the final as-commissioned condition and the red-line mark-up (RLMU) has been incorporated without a new revision.
Tick "No" if the last approved revision already represents the final condition, with no redline markup required.

NO MARK UP
AS COMMISSIONED: MATTIA GIROTTI
31/3/25

VALID FOR CONSTRUCTION
VENDOR DOCUMENT - FDL DWG:
123A90-FDL-1724002197-EL-DG-00031

REV.:	DATE:	SIGNATURE:
2_A	18/03/25	G.Randi

ROSETTI MARINO SpA

CROSSWIND

IMESA ELECTRICAL ENGINEERING

ROSETTI MARINO

=
+
DWG n° : 231298/SD/31
Item n° : PF1002983/26

REV.	DATE	DRN	CHKD	APPD	DESCRIPTION
2	18/09/2024	Santinelli	Flamminio	Sigismondi	As Built (ASB)
1	10/07/2024	Santinelli	Flamminio	Sigismondi	Accepted for Construction (AFC)
0	09/05/2024	Santinelli	Flamminio	Sigismondi	Issued for review (IFR)

TITLE : "SG-200N1"
LV SWG FUNCTIONAL DIAGRAMS - TYPICAL FEEDERS
UMC100 Internal Function Logic - Typical "M1-n"

CONTRACT NO./TITLE CW-I-WP4-2023-05/HOLLANDSE KUST NOORD WIND PARK | SCALE : NTS

A3 | DRAWING NO. 1723002197-EL-DG-00031 | SHEET 018 | REV. 02

F.to UNI A3: 420mmx297mm

File Name : 1723002197-EL-DG-00031 Rev. 02

1 | 2 | 3 | 4 | 5 | 6 | 7 | 8 | 9 | 10

A | B | C | D | E

UMC100 INTERNAL FUNCTION LOGIC

INPUT	INTERNAL LOGIC	OUTPUT

AVAILABLE SHEET

ROSETTI MARINO RED LINE AS BUILT STAMP	
RLMU	✖ Yes ☐ No
Description	This document represents the final as-built version incorporating the latest approved information.
Reviewed & Confirmed by	Rosetti Marino S.P.A.
Signature /Date	

Notes: Tick"Yes" only when the document reflects the final as-commissioned condition and the red-line mark-up (RLMU) has been incorporated without a new revision.
Tick "No" if the last approved revision already represents the final condition, with no redline markup required.

NO MARK UP
AS COMMISSIONED: MARIA GIROTTI
31/3/25

VALID FOR CONSTRUCTION
VENDOR DOCUMENT - FDL DWG:
123A90-FDL-1724002197-EL-DG-00031

REV.:	DATE:	SIGNATURE:
2_A	18/03/25	G.Randi

ROSETTI MARINO SpA

CROSSWIND

IMESA ELECTRICAL ENGINEERING

ROSETTI MARINO

DWG n° : 231298/SD/31
Item n° : PF1002983/26

REV.	DATE	DRN	CHKD	APPD	DESCRIPTION
=					
+					
2	18/09/2024	Santinelli	Flamminio	Sigismondi	As Built (ASB)
1	10/07/2024	Santinelli	Flamminio	Sigismondi	Accepted for Construction (AFC)
0	09/05/2024	Santinelli	Flamminio	Sigismondi	Issued for review (IFR)

TITLE : "SG-200N1"
LV SWG FUNCTIONAL DIAGRAMS - TYPICAL FEEDERS
UMC100 Internal Function Logic - Typical "M1-n"

CONTRACT NO./TITLE CW-I-WP4-2023-05/HOLLANDSE KUST NOORD WIND PARK | SCALE : NTS

A3 | DRAWING NO. 1723002197-EL-DG-00031 | SHEET 019 | REV. 02

File Name : 1723002197-EL-DG-00031 Rev. 02

F.to UNI A3: 420mmx297mm

TYPICAL - M1

X1

NumM	Fg.	Sez.	Tipo	Descrizione	Costruttore
			BT003	BT/3 End bracket	Cabur
1	009.5A	2.5	HD100GR_	HMD.2/GR Two-level feed-through Terminal Block - Grey (2.5 mmq) - Spring type	Cabur
2	009.6A	2.5	HD100GR_	HMD.2/GR Two-level feed-through Terminal Block - Grey (2.5 mmq) - Spring type	Cabur
3	009.6A	2.5	HD100GR_	HMD.2/GR Two-level feed-through Terminal Block - Grey (2.5 mmq) - Spring type	Cabur
4	009.6A	2.5	HD100GR_	HMD.2/GR Two-level feed-through Terminal Block - Grey (2.5 mmq) - Spring type	Cabur
5	011.8C	2.5	HD100GR_	HMD.2/GR Two-level feed-through Terminal Block - Grey (2.5 mmq) - Spring type	Cabur
6	011.8C	2.5	HD100GR_	HMD.2/GR Two-level feed-through Terminal Block - Grey (2.5 mmq) - Spring type	Cabur
7	011.9C	2.5	HD100GR_	HMD.2/GR Two-level feed-through Terminal Block - Grey (2.5 mmq) - Spring type	Cabur
8	011.9C	2.5	HD100GR_	HMD.2/GR Two-level feed-through Terminal Block - Grey (2.5 mmq) - Spring type	Cabur
			HD101GR	HMD/PT/GR End section - Grey	Cabur
9	014.6A	2.5	HD400GR_	HMD.2N/GR Two-level feed-through Terminal Block - Grey (2.5 mmq) - Spring type	Cabur
10	014.6A	2.5	HD400GR_	HMD.2N/GR Two-level feed-through Terminal Block - Grey (2.5 mmq) - Spring type	Cabur
11	014.2A	2.5	HD400GR_	HMD.2N/GR Two-level feed-through Terminal Block - Grey (2.5 mmq) - Spring type	Cabur
12	014.2A	2.5	HD400GR_	HMD.2N/GR Two-level feed-through Terminal Block - Grey (2.5 mmq) - Spring type	Cabur
13	014.7A	2.5	HD400GR_	HMD.2N/GR Two-level feed-through Terminal Block - Grey (2.5 mmq) - Spring type	Cabur
14	014.8A	2.5	HD400GR_	HMD.2N/GR Two-level feed-through Terminal Block - Grey (2.5 mmq) - Spring type	Cabur
15	014.9A	2.5	HD400GR_	HMD.2N/GR Two-level feed-through Terminal Block - Grey (2.5 mmq) - Spring type	Cabur
16	014.9A	2.5	HD400GR_	HMD.2N/GR Two-level feed-through Terminal Block - Grey (2.5 mmq) - Spring type	Cabur
			HD201GR	HMD.1/PT/GR End section - Grey	Cabur
			BT003	BT/3 End bracket	Cabur

ROSETTI MARINO RED LINE AS BUILT STAMP

RLMU	✖ Yes ☐ No
Description	This document represents the final as-built version incorporating the latest approved information.
Reviewed & Confirmed by	Rosetti Marino S.P.A.
Signature /Date	

Notes: Tick"Yes" only when the document reflects the final as-commissioned condition and the red-line mark-up (RLMU) has been incorporated without a new revision.
Tick "No" if the last approved revision already represents the final condition, with no redline markup required.

NO MARK UP
AS COMMISSIONED: MARIA GIROTTI
31/3/25

VALID FOR CONSTRUCTION
VENDOR DOCUMENT - FDL DWG:
123A90-FDL-1724002197-EL-DG-00031

REV.:	DATE:	SIGNATURE:
2_A	18/03/25	G.Randi

ROSETTI MARINO SpA

CROSSWIND

IMESA ELECTRICAL ENGINEERING

ROSETTI MARINO

= TYPICAL
\+ M1
DWG n° : 231298/SD/31
Item n° : PF1002983/26

REV.	DATE	DRN	CHKD	APPD	DESCRIPTION
2	18/09/2024	Santinelli	Flamminio	Sigismondi	As Built (ASB)
1	10/07/2024	Santinelli	Flamminio	Sigismondi	Accepted for Construction (AFC)
0	09/05/2024	Santinelli	Flamminio	Sigismondi	Issued for review (IFR)

TITLE : "SG-200N1"
LV SWG FUNCTIONAL DIAGRAMS - TYPICAL FEEDERS
Functional Drawing - Typical "M1-n"

CONTRACT NO./TITLE CW-I-WP4-2023-05/HOLLANDSE KUST NOORD WIND PARK | SCALE : NTS

A3 | DRAWING NO. 1723002197-EL-DG-00031 | SHEET 020 | REV. 02

F.to UNI A3: 420mmx297mm

File Name : 1723002197-EL-DG-00031 Rev. 02

NO MARK UP AS COMMISSIONED: MARA GIROTTI 31/3/25

Nome/Item	Fg/Sh	Tipo/Type	Q.tà	Descrizione/Description	Costruttore/Manufacturer	Ubicazione (descrizione)	Quadro (descrizione)
HL1	013	ML22/484L230STLTTR	1	MULTILED 48x48 - 4 LED - Vaux=230Vac/dc + LAMP TEST + TROP	DOMO		TYPICAL M1
KA1	010	ER 592 6	1	CR-M230AC4L SUPPLY 230VAC 4C/O 250V/6A LED	ABB		TYPICAL M1
		ER 609 8	1	CR-MH HOLDER FOR CR-M RELAY	ABB		TYPICAL M1
		ER 686 6	1	CR-M4SS SOCKET STANDARD X 2/4 C/O(CR-M)	ABB		TYPICAL M1
KA2	010	ER 592 6	1	CR-M230AC4L SUPPLY 230VAC 4C/O 250V/6A LED	ABB		TYPICAL M1
		ER 609 8	1	CR-MH HOLDER FOR CR-M RELAY	ABB		TYPICAL M1
		ER 686 6	1	CR-M4SS SOCKET STANDARD X 2/4 C/O(CR-M)	ABB		TYPICAL M1
KA3	012	ER 592 6	1	CR-M230AC4L SUPPLY 230VAC 4C/O 250V/6A LED	ABB		TYPICAL M1
		ER 609 8	1	CR-MH HOLDER FOR CR-M RELAY	ABB		TYPICAL M1
		ER 686 6	1	CR-M4SS SOCKET STANDARD X 2/4 C/O(CR-M)	ABB		TYPICAL M1
KA4	012	ER 592 6	1	CR-M230AC4L SUPPLY 230VAC 4C/O 250V/6A LED	ABB		TYPICAL M1
		ER 609 8	1	CR-MH HOLDER FOR CR-M RELAY	ABB		TYPICAL M1
		ER 686 6	1	CR-M4SS SOCKET STANDARD X 2/4 C/O(CR-M)	ABB		TYPICAL M1
KA5	012	ER 592 6	1	CR-M230AC4L SUPPLY 230VAC 4C/O 250V/6A LED	ABB		TYPICAL M1
		ER 609 8	1	CR-MH HOLDER FOR CR-M RELAY	ABB		TYPICAL M1
		ER 686 6	1	CR-M4SS SOCKET STANDARD X 2/4 C/O(CR-M)	ABB		TYPICAL M1
KA6	012	ER 592 6	1	CR-M230AC4L SUPPLY 230VAC 4C/O 250V/6A LED	ABB		TYPICAL M1
		ER 609 8	1	CR-MH HOLDER FOR CR-M RELAY	ABB		TYPICAL M1
		ER 686 6	1	CR-M4SS SOCKET STANDARD X 2/4 C/O(CR-M)	ABB		TYPICAL M1
KM1	012	AF38300013	1	AF38-30-00-13 CONTACTOR 3P 38A 100-250V AC/DC	ABB		TYPICAL M1
		CA431E	1	CA4-31E CONTACTS BLOCK AUX 3NA+1NC FRONT	ABB		TYPICAL M1
KSIL	014	2TLA010040R0000	1	BSR10 Vaux=24VDC SAFETY RELAY	ABB		TYPICAL M1
MMU1	010	1SAJ590000R0103	1	UMC100-PAN - CONTROL PANEL FOR UMC100	ABB		TYPICAL M1
		1SAJ510003R0002	1	UMCPAN-CAB.070 - 0.7mt ext. cable with door mounting set	ABB		TYPICAL M1
MMU2	010	1SAJ530000R1100	1	UMC100.3 UC - UNIVERSAL MOTOR CONTROLLER Vaux=110-240VAC/DC	ABB		TYPICAL M1
		1SAJ691000R0001	1	UMCIO-CAB.030 - Connection cable UMC100-I/O module, lenght 0.3mt	ABB		TYPICAL M1
MMU3	011	1SAJ622000R0102	1	DX122.0 - I/O module for UMC100, 110-230 VAC digital input	ABB		TYPICAL M1
MMU4	011	1SAJ929600R0001	1	SMK3.0 - Adapter for separate mounting of a communication interface; terminal block for 24 V DC supply included	ABB		TYPICAL M1
		1SAJ251000R0001	1	MRP31.0 - Modbus RTU communication interface; terminal block for fieldbus connection included	ABB		TYPICAL M1
		1SAJ929240R0015	1	CDP24.150 - Cable from SMK3.0 to drawer's outside, length 1.5 mt	ABB		TYPICAL M1
PA1	012	KW 075 2	1	MP1-10R PUSH BUTTON RED WITH BLACK RING	ABB		TYPICAL M1
		EO 569 7	1	MCBH-00 FIXING SUPPORT 3 CONTACTS	ABB		TYPICAL M1
		EO 571 3	2	MCB-01 CONTACT NC FOR PUSHBUTTOM	ABB		TYPICAL M1
PM1	012	KW 076 0	1	MP1-10G PUSH BUTTON GREEN WITH BLACK RING	ABB		TYPICAL M1
		EO 569 7	1	MCBH-00 FIXING SUPPORT 3 CONTACTS	ABB		TYPICAL M1
		EO 570 5	2	MCB-10 CONTACT NO FOR PUSHBUTTONS	ABB		TYPICAL M1
QA1	009	S550239	1	S202M C 2 AUTOMATIC CIRCUIT BREAKER 10KA 2P	ABB		TYPICAL M1
		A563819	1	S2-CS/H6R AUXILIARY STATE CONTACT 1CO	ABB		TYPICAL M1
QF1	009	XT2S20MA3	1	XT2S 160 MA 20 Im=120...280 3p F F	ABB		TYPICAL M1
		1SDA066436R1	1	AUX-C 3Q+2SY 250Vac/dc XT2-XT4 F/P	ABB		TYPICAL M1
SA1	012	KW 329 3	1	M2SS2-10B HANDLE SELECTOR 2P 90° BLACK RING BLACK	ABB		TYPICAL M1

VALID FOR CONSTRUCTION
VENDOR DOCUMENT - FDL DWG:
123A90-FDL-1724002197-EL-DG-00031
REV.: 2_A | DATE: 18/03/25 | SIGNATURE: G.Randi
ROSETTI MARINO SpA

ROSETTI MARINO RED LINE AS BUILT STAMP

RLMU	✖ Yes ☐ No
Description	This document represents the final as-built version incorporating the latest approved information.
Reviewed & Confirmed by	Rosetti Marino S.P.A.
Signature /Date	

Notes: Tick"Yes" only when the document reflects the final as-commissioned condition and the red-line mark-up (RLMU) has been incorporated without a new revision.
Tick "No" if the last approved revision already represents the final condition, with no redline markup required.

IMESA ELECTRICAL ENGINEERING

ROSETTI MARINO

= TYPICAL
+ M1
DWG n° : 231298/SD/31
Item n° : PF1002983/26

REV.	DATE	DRN	CHKD	APPD	DESCRIPTION
2	18/09/2024	Santinelli	Flamminio	Sigismondi	As Built (ASB)
1	10/07/2024	Santinelli	Flamminio	Sigismondi	Accepted for Construction (AFC)
0	09/05/2024	Santinelli	Flamminio	Sigismondi	Issued for review (IFR)

TITLE : "SG-200N1"
LV SWG FUNCTIONAL DIAGRAMS - TYPICAL FEEDERS
Functional Drawing - Typical "M1-n"

CONTRACT NO./TITLE CW-I-WP4-2023-05/HOLLANDSE KUST NOORD WIND PARK | SCALE : NTS

A3 | DRAWING NO. 1723002197-EL-DG-00031 | SHEET 021 | REV. 02

F.to UNI A3: 420mmx297mm

File Name : 1723002197-EL-DG-00031 Rev. 02

Nome/Item	Fg/Sh	Tipo/Type	Q.tà	Descrizione/Description	Costruttore/Manufacturer	Ubicazione (descrizione)	Quadro (descrizione)
SA1	012	EO 569 7	1	MCBH-00 FIXING SUPPORT 3 CONTACTS	ABB		TYPICAL M1
		EO 570 5	2	MCB-10 CONTACT NO FOR PUSHBUTTONS	ABB		TYPICAL M1
		EO 571 3	2	MCB-01 CONTACT NC FOR PUSHBUTTOM	ABB		TYPICAL M1
TO1	009	1SAJ929200R0035	1	CEM11-FBP.35 Earth fault monitor UMC100.3	ABB		TYPICAL M1
X1		HD100GR_	8	HMD.2/GR Two-level feed-through Terminal Block - Grey (2.5 mmq) - Spring type	Cabur		TYPICAL M1
		HD400GR_	8	HMD.2N/GR Two-level feed-through Terminal Block - Grey (2.5 mmq) - Spring type	Cabur		TYPICAL M1
		BT003	2	BT/3 End bracket	Cabur		TYPICAL M1
		HD101GR	1	HMD/PT/GR End section - Grey	Cabur		TYPICAL M1
		HD201GR	1	HMD.1/PT/GR End section - Grey	Cabur		TYPICAL M1

ROSETTI MARINO	RED LINE AS BUILT STAMP
RLMU	✖ Yes ☐ No
Description	This document represents the final as-built version incorporating the latest approved information.
Reviewed & Confirmed by	Rosetti Marino S.P.A.
Signature /Date	

Notes: Tick"Yes" only when the document reflects the final as-commissioned condition and the red-line mark-up (RLMU) has been incorporated without a new revision.
Tick "No" if the last approved revision already represents the final condition, with no redline markup required.

NO MARK UP
AS COMMISSIONED: MATTIA GIROTTI
31/3/25

VALID FOR CONSTRUCTION
VENDOR DOCUMENT - FDL DWG:
123A90-FDL-1724002197-EL-DG-00031
REV.: 2_A | DATE: 18/03/25 | SIGNATURE: G.Randi
ROSETTI MARINO SpA

CROSSWIND

IMESA ELECTRICAL ENGINEERING

ROSETTI MARINO

= TYPICAL
\+ M1
DWG n° : 231298/SD/31
Item n° : PF1002983/26

REV.	DATE	DRN	CHKD	APPD	DESCRIPTION
2	18/09/2024	Santinelli	Flamminio	Sigismondi	As Built (ASB)
1	10/07/2024	Santinelli	Flamminio	Sigismondi	Accepted for Construction (AFC)
0	09/05/2024	Santinelli	Flamminio	Sigismondi	Issued for review (IFR)

TITLE : "SG-200N1"
LV SWG FUNCTIONAL DIAGRAMS - TYPICAL FEEDERS
Functional Drawing - Typical "M1-n"

CONTRACT NO./TITLE CW-I-WP4-2023-05/HOLLANDSE KUST NOORD WIND PARK | SCALE : NTS


A3 | DRAWING NO. 1723002197-EL-DG-00031 | SHEET 022 | REV. 02

F.to UNI A3: 420mmx297mm

File Name : 1723002197-EL-DG-00031 Rev. 02

DOOR FRONT LAY-OUT

TYPICAL : LINE FEEDER "L1-n"

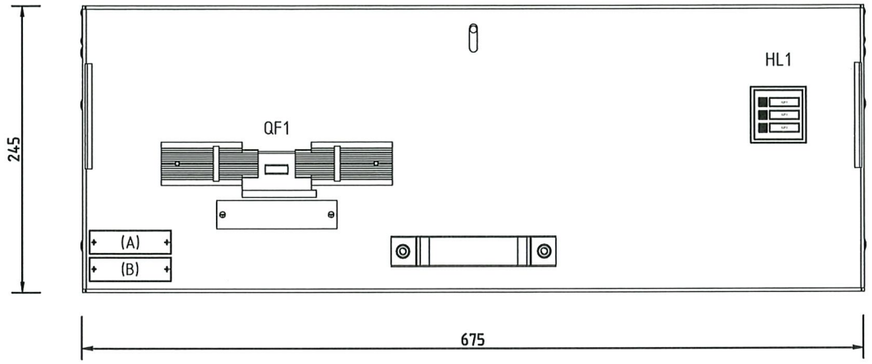


NOTE :

A) IDENTIFICATION name plate (type-1A) , with :
- Drawer position [Column / Position inside SWB]
- Typical name [reference applicability typical used]
- Power [reference applicability typical used]


B) USER name plate (type-1B), with :
- Item User [to see SLD diagrams]
- User Description [to see SLD diagrams]

DEVICES name plate			
ITEM	DESCRIPTION 1	DESCRIPTION 2	NOTE
QF1	Circuit Breaker	Signalling	NO plate
HL1	Multiled	Signalling	NO plate


TYPE-1A

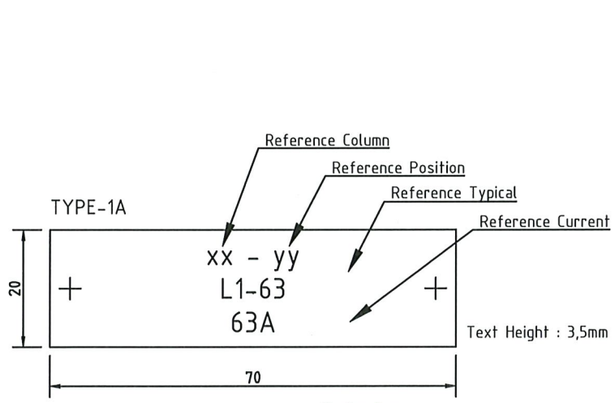

TYPE-2A

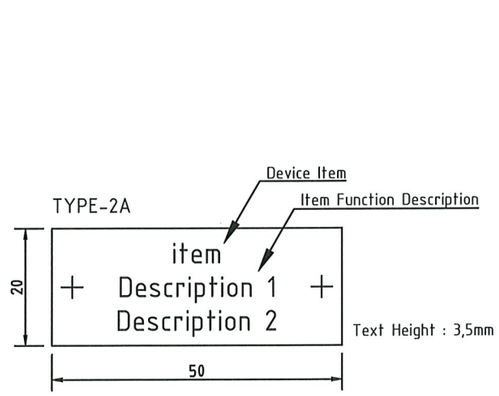

TYPE-1B

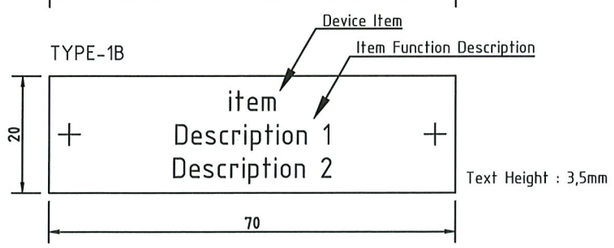

ROSETTI MARINO	RED LINE AS BUILT STAMP
RLMU	✖ Yes ☐ No
Description	This document represents the final as-built version incorporating the latest approved information.
Reviewed & Confirmed by	Rosetti Marino S.P.A.
Signature /Date	

Notes: Tick"Yes" only when the document reflects the final as-commissioned condition and the red-line mark-up (RLMU) has been incorporated without a new revision.
Tick "No" if the last approved revision already represents the final condition, with no redline markup required.

VALID FOR CONSTRUCTION
VENDOR DOCUMENT - FDL DWG:
123A90-FDL-1724002197-EL-DG-00031

REV.:	DATE:	SIGNATURE:
2_A	18/03/25	G.Randi

ROSETTI MARINO SpA

CROSSWIND

IMESA ELECTRICAL ENGINEERING

ROSETTI MARINO

= TYPICAL
+ L-x
DWG n° : 231298/SD/31
Item n° : PF1002983/26

REV.	DATE	DRN	CHKD	APPD	DESCRIPTION
2	18/09/2024	Santinelli	Flamminio	Sigismondi	As Built (ASB)
1	10/07/2024	Santinelli	Flamminio	Sigismondi	Accepted for Construction (AFC)
0	09/05/2024	Santinelli	Flamminio	Sigismondi	Issued for review (IFR)

TITLE : "SG-200N1"
LV SWG FUNCTIONAL DIAGRAMS - TYPICAL FEEDERS
Door Front Lay-Out - Typical "L1-n" & "L2-n"

CONTRACT NO./TITLE CW-I-WP4-2023-05/HOLLANDSE KUST NOORD WIND PARK | SCALE : NTS


A3 | DRAWING NO. 1723002197-EL-DG-00031 | SHEET 023 | REV. 02


F.to UNI A3: 420mmx297mm


File Name : 1723002197-EL-DG-00031 Rev. 02


DOOR FRONT LAY-OUT

TYPICAL : LINE FEEDER "L2-n"

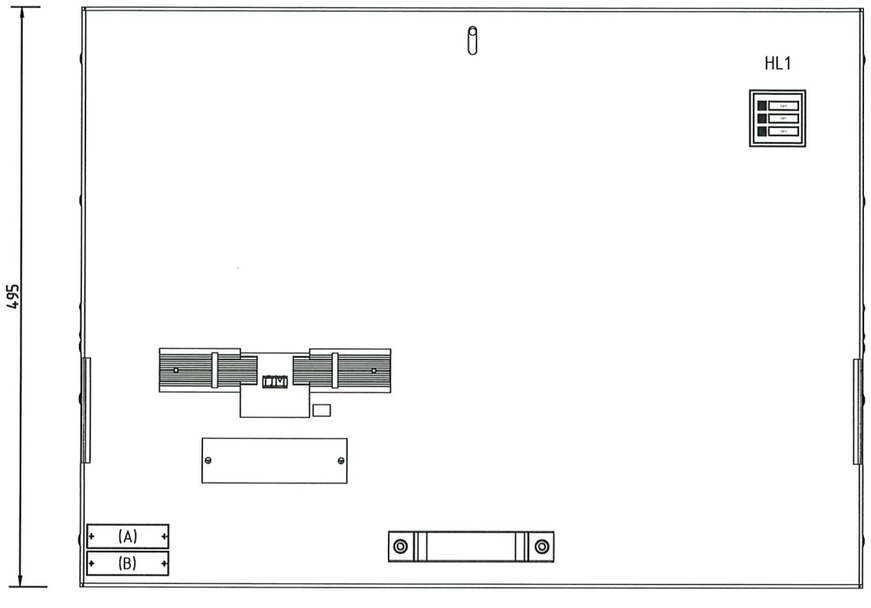

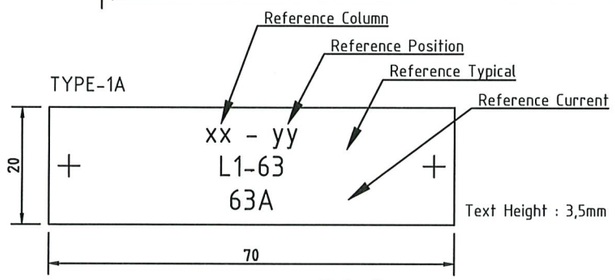

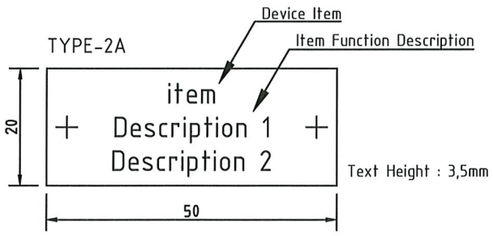

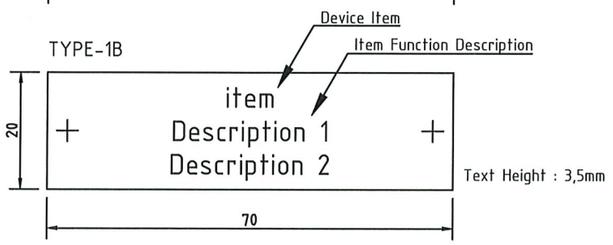

NOTE :

A) IDENTIFICATION name plate (type-1A) , with :
- Drawer position [Column / Position inside SWB]
- Typical name [reference applicability typical used]
- Power [reference applicability typical used]

B) USER name plate (type-1B), with :
- Item User [to see SLD diagrams]
- User Description [to see SLD diagrams]

DEVICES name plate			
ITEM	DESCRIPTION 1	DESCRIPTION 2	NOTE
QF1	Circuit Breaker	Signalling	NO plate
HL1	Multiled	Signalling	NO plate

ROSETTI MARINO RED LINE AS BUILT STAMP	
RLMU	✖ Yes ☐ No
Description	This document represents the final as-built version incorporating the latest approved information.
Reviewed & Confirmed by	Rosetti Marino S.P.A.
Signature /Date	

Notes: Tick"Yes" only when the document reflects the final as-commissioned condition and the red-line mark-up (RLMU) has been incorporated without a new revision.
Tick "No" if the last approved revision already represents the final condition, with no redline markup required.

VALID FOR CONSTRUCTION
VENDOR DOCUMENT - FDL DWG:
123A90-FDL-1724002197-EL-DG-00031
REV.: 2_A | DATE: 18/03/25 | SIGNATURE: G.Randi
ROSETTI MARINO SpA

CROSSWIND

IMESA ELECTRICAL ENGINEERING

ROSETTI MARINO

= TYPICAL
+ L-x
DWG n° : 231298/SD/31
Item n° : PF1002983/26

REV.	DATE	DRN	CHKD	APPD	DESCRIPTION
2	18/09/2024	Santinelli	Flamminio	Sigismondi	As Built (ASB)
1	10/07/2024	Santinelli	Flamminio	Sigismondi	Accepted for Construction (AFC)
0	09/05/2024	Santinelli	Flamminio	Sigismondi	Issued for review (IFR)

TITLE : "SG-200N1"
LV SWG FUNCTIONAL DIAGRAMS - TYPICAL FEEDERS
Door Front Lay-Out - Typical "L1-n" & "L2-n"

CONTRACT NO./TITLE CW-I-WP4-2023-05/HOLLANDSE KUST NOORD WIND PARK | SCALE : NTS

A3 | DRAWING NO. 1723002197-EL-DG-00031 | SHEET 024 | REV. 02

F.to UNI A3: 420mmx297mm

File Name : 1723002197-EL-DG-00031 Rev. 02

USERS LEGEND

TYPICAL : LINE FEEDER "L1-n" & "L2-n"

TYPICAL APPLICABILITY					
ITEM	ITEM TAG	DESCRIPTION TAG	REFERENCE POSITION (written on name name plate "type-1A)	REFERENCE NOMINAL CURRENT C.B. TRIP UNIT (written on name name plate "type-1A)	REFERENCE TYPICAL (written on name name plate "type-1A)
1	UP-200F4	AC UPS F&G - 8H UP-200F4 - BYPASS	A2 / +04	63A	L1-63
2	UP-200F3	AC UPS PAS - 30 MIN UP-200F3 - LINE A	A3 / +01	100A	L1-100
3	UP-200F3	AC UPS PAS - 30 MIN UP-200F3 - LINE B	A4 / +01	100A	L1-100
4	UP-200F4	AC UPS F&G - 8H UP-200F4 - LINE A	A6 / +05	63A	L1-63
5	UP-200F4	AC UPS F&G - 8H UP-200F4 - LINE B	A6 / +06	63A	L1-63
6	ESW-200N1	WELDING SOCKETS (TOP DECK)	A6 / +08	160A	L2-160
7	UP-200F3	AC UPS PAS - 30 MIN UP-200F3 (BYPASS)	A7 / +02	100A	L1-100
8	UP-200F1	DC BATTERY SYSTEM SWTG CONTROL - FEEDER A	A7 / +03	63A	L1-63
9	UP-200F1	DC BATTERY SYSTEM SWTG CONTROL - FEEDER B	A7 / +04	63A	L1-63
10	UP-200F2	NAVAID SYSTEM FEEDER A	A7 / +05	63A	L1-63
11	UP-200F2	NAVAID SYSTEM FEEDER B	A7 / +06	63A	L1-63
12	ESW-200N2	WELDING SOCKETS (LOWER DECK)	A7 / +08	160A	L2-160

NO MARK UP
AS COMMISSIONED: MARIA GIRONI
25/3/25

ROSETTI MARINO RED LINE AS BUILT STAMP

RLMU	✖ Yes ☐ No
Description	This document represents the final as-built version incorporating the latest approved information.
Reviewed & Confirmed by	Rosetti Marino S.P.A.
Signature /Date	Claudia Giunchi

Notes: Tick"Yes" only when the document reflects the final as-commissioned condition and the red-line mark-up (RLMU) has been incorporated without a new revision.
Tick "No" if the last approved revision already represents the final condition, with no redline markup required.

= TYPICAL
+ L-x

DWG n° : 231298/SD/31
Item n° : PF1002983/26

REV.	DATE	DRN	CHKD	APPD	DESCRIPTION
2	18/09/2024	Santinelli	Flamminio	Sigismondi	As Built (ASB)
1	10/07/2024	Santinelli	Flamminio	Sigismondi	Accepted for Construction (AFC)
0	09/05/2024	Santinelli	Flamminio	Sigismondi	Issued for review (IFR)

ROSETTI MARINO

TITLE : "SG-200N1"
LV SWG FUNCTIONAL DIAGRAMS - TYPICAL FEEDERS
Users Legend - Typical "L1-n" & "L2-n"

CONTRACT NO./TITLE CW-I-WP4-2023-05/HOLLANDSE KUST NOORD WIND PARK | SCALE : NTS

A3 | DRAWING NO. 1723002197-EL-DG-00031 | SHEET 025 | REV. 02

F.to UNI A3: 420mmx297mm

File Name : 1723002197-EL-DG-00031 Rev. 02

ITEMS ACRONYM

TYPICAL : LINE FEEDER "L1-n" & "L2-n"

Composition of Typical :

L-x = Common Parts
L1-"nn" or L2-"nn"= Specific Parts

Example for Composition of L1-63:
- to take "L-x" plus "L1-63"

Example for Composition of L2-160:
- to take "L-x" plus "L2-160"

	ACRONYM ITEMS [Comun parts]	ACRONYM ITEMS [Specific parts]				
	L-x	L1-40 [In=40A] [Current Trip Unit]	L1-63 [In=63A] [Current Trip Unit]	L1-100 [In=100A] [Current Trip Unit]	L2-160 [In=160A] [Current Trip Unit]	
ASSOCIATED TYPICAL	This Item include all devices that are comun for both "Specific Parts" Items	This Items include only devices that are detail for "Specific Parts" Items				
L1-40	X	X				
L1-63	X		X			
L1-100	X			X		
L2-160	X				X	

NO MARK UP
AS COMMISSIONED: MARIA GIROTTI
25/3/25

RED LINE AS BUILT STAMP

RLMU	✖ Yes ☐ No
Description	This document represents the final as-built version incorporating the latest approved information.
Reviewed & Confirmed by	Rosetti Marino S.P.A.
Signature /Date	

Notes: Tick"Yes" only when the document reflects the final as-commissioned condition and the red-line mark-up (RLMU) has been incorporated without a new revision.
Tick "No" if the last approved revision already represents the final condition, with no redline markup required.

=	TYPICAL					
+	L-x					
DWG n° :	231298/SD/31					
Item n° :	PF1002983/26					
2	18/09/2024	Santinelli	Flamminio	Sigismondi	As Built (ASB)	
1	10/07/2024	Santinelli	Flamminio	Sigismondi	Accepted for Construction (AFC)	
0	09/05/2024	Santinelli	Flamminio	Sigismondi	Issued for review (IFR)	
REV.	DATE	DRN	CHKD	APPD	DESCRIPTION	

ROSETTI MARINO


TITLE : "SG-200N1"
LV SWG FUNCTIONAL DIAGRAMS - TYPICAL FEEDERS
Items Acronym - Typical "L1-n" & "L2-n"

CONTRACT NO./TITLE CW-I-WP4-2023-05/HOLLANDSE KUST NOORD WIND PARK | SCALE : NTS

A3 | DRAWING NO. 1723002197-EL-DG-00031 | SHEET 026 | REV. 02

F.to UNI A3: 420mmx297mm

File Name : 1723002197-EL-DG-00031 Rev. 02

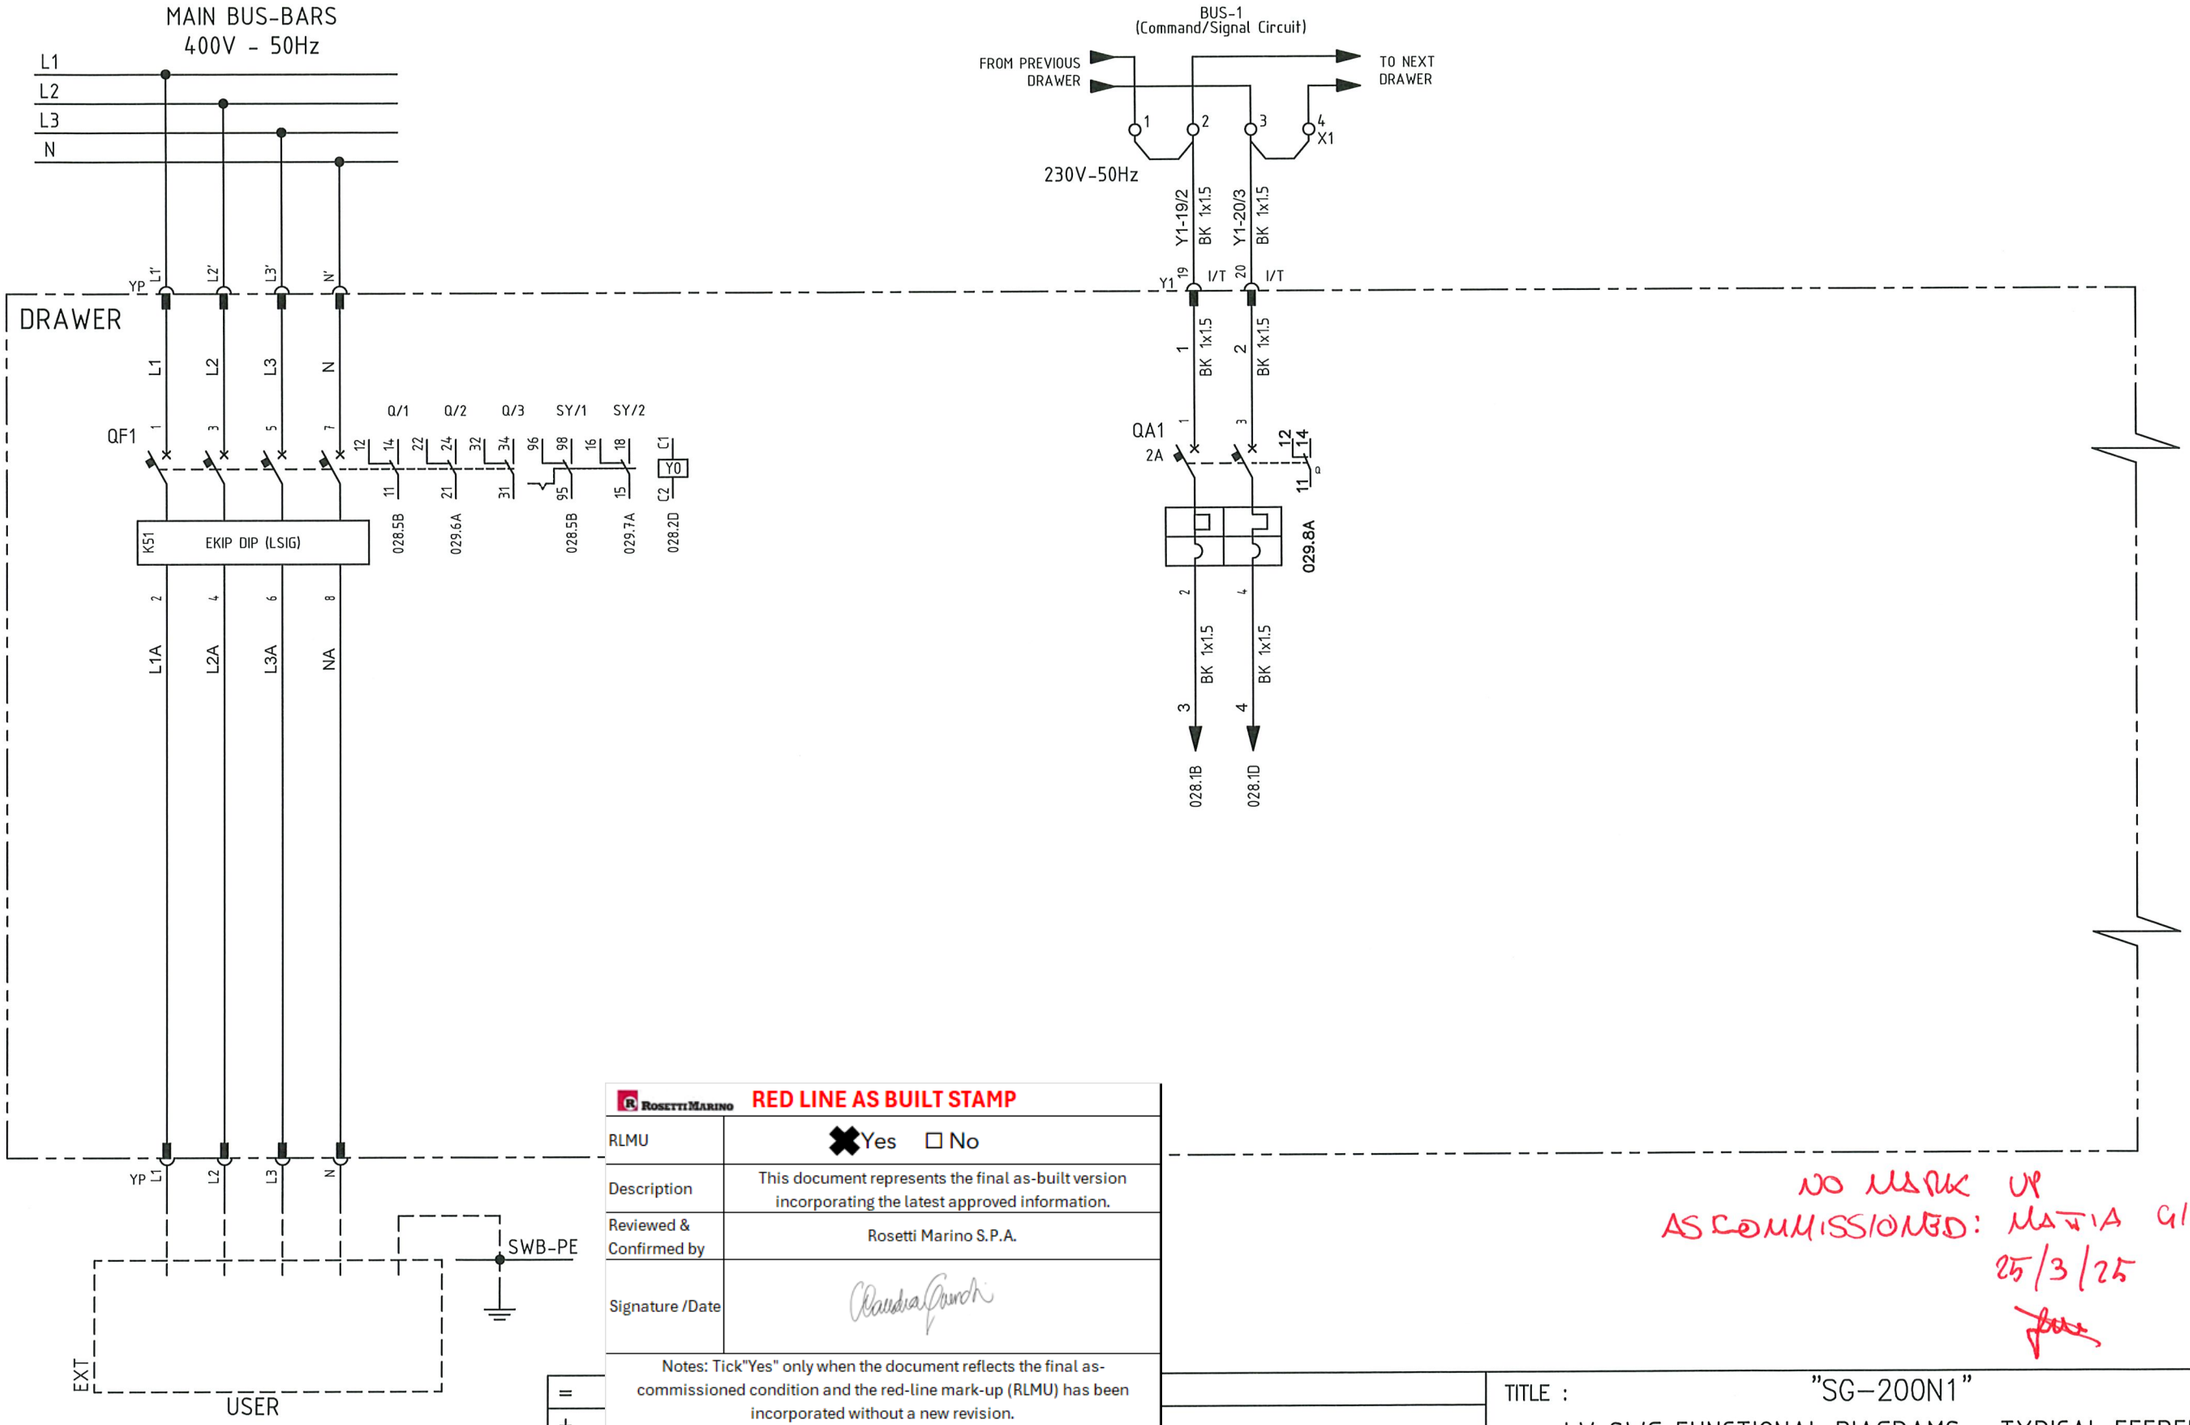

NO MARK UP
AS COMMISSIONED: MARIA GIROTTI
25/3/25

ROSETTI MARINO	RED LINE AS BUILT STAMP
RLMU	✖ Yes ☐ No
Description	This document represents the final as-built version incorporating the latest approved information.
Reviewed & Confirmed by	Rosetti Marino S.P.A.
Signature /Date	

Notes: Tick"Yes" only when the document reflects the final as-commissioned condition and the red-line mark-up (RLMU) has been incorporated without a new revision.
Tick "No" if the last approved revision already represents the final condition, with no redline markup required.

REV.	DATE	DRN	CHKD	APPD	DESCRIPTION
2	18/09/2024	Santinelli	Flamminio	Sigismondi	As Built (ASB)
1	10/07/2024	Santinelli	Flamminio	Sigismondi	Accepted for Construction (AFC)
0	09/05/2024	Santinelli	Flamminio	Sigismondi	Issued for review (IFR)

=
+
DWG n° :
Item n° : PF1002983/26

IMESA ELECTRICAL ENGINEERING

CROSSWIND

ROSETTI MARINO

TITLE : "SG-200N1"

LV SWG FUNCTIONAL DIAGRAMS - TYPICAL FEEDERS

Functional Drawing - Typical "L1-n" & "L2-n"

CONTRACT NO./TITLE CW-I-WP4-2023-05/HOLLANDSE KUST NOORD WIND PARK

SCALE : NTS

A3

DRAWING NO. 1723002197-EL-DG-00031

SHEET 027

REV. 02

F.to UNI A3: 420mmx297mm

File Name : 1723002197-EL-DG-00031 Rev. 02

NO MARK UP
AS COMMISSIONED: MARIA GIROTTI
25/3/25

EXT
9 X1
10 X1
11 X1
12 X1
Y1-17/10 BK 1x1.5
Y1-18/11 BK 1x1.5
Y1 17 I/T
18 I/T
22 T
21 I/T
027.6C 3 230V-50Hz
3 /./
QF1 027.1B 11 Q 12 14
QF1 027.1B 96 98 SY 95
5 BK 1x1.5
6 BK 1x1.5
7 BK 1x1.5
8 BK 1x1.5
9 BK 1x1.5
HL1 1 2 3 4 230VAC
L1 GR
L2 RD
L3 AM
CIRCUIT BREAKER OPEN
CIRCUIT BREAKER CLOSE
FEEDER TRIPPED
C1 Y0 C2
QF1 027.1B
KA1 A1 A2
027.6C 4
4 /./
DRAWER ON TEST
029.7A 11 12 14 21 22 24 31 32 34 41 42 44

ROSETTI MARINO RED LINE AS BUILT STAMP	
RLMU	✖ Yes ☐ No
Description	This document represents the final as-built version incorporating the latest approved information.
Reviewed & Confirmed by	Rosetti Marino S.P.A.
Signature /Date	Claudia Gandi

Notes: Tick"Yes" only when the document reflects the final as-commissioned condition and the red-line mark-up (RLMU) has been incorporated without a new revision.
Tick "No" if the last approved revision already represents the final condition, with no redline markup required.

VALID FOR CONSTRUCTION
VENDOR DOCUMENT - FDL DWG:
123A90-FDL-1724002197-EL-DG-00031

REV.:	DATE:	SIGNATURE:
2_A	18/03/25	G.Randi

ROSETTI MARINO SpA

CROSSWIND

IMESA ELECTRICAL ENGINEERING

ROSETTI MARINO

= TYPICAL
\+ L-x
DWG n° : 231298/SD/31
Item n° : PF1002983/26

REV.	DATE	DRN	CHKD	APPD	DESCRIPTION
2	18/09/2024	Santinelli	Flamminio	Sigismondi	As Built (ASB)
1	10/07/2024	Santinelli	Flamminio	Sigismondi	Accepted for Construction (AFC)
0	09/05/2024	Santinelli	Flamminio	Sigismondi	Issued for review (IFR)


TITLE : "SG-200N1"
LV SWG FUNCTIONAL DIAGRAMS - TYPICAL FEEDERS
Functional Drawing - Typical "L1-n" & "L2-n"

CONTRACT NO./TITLE CW-I-WP4-2023-05/HOLLANDSE KUST NOORD WIND PARK | SCALE : NTS

A3 | DRAWING NO. 1723002197-EL-DG-00031 | SHEET 028 | REV. 02

F.to UNI A3: 420mmx297mm

File Name : 1723002197-EL-DG-00031 Rev. 02

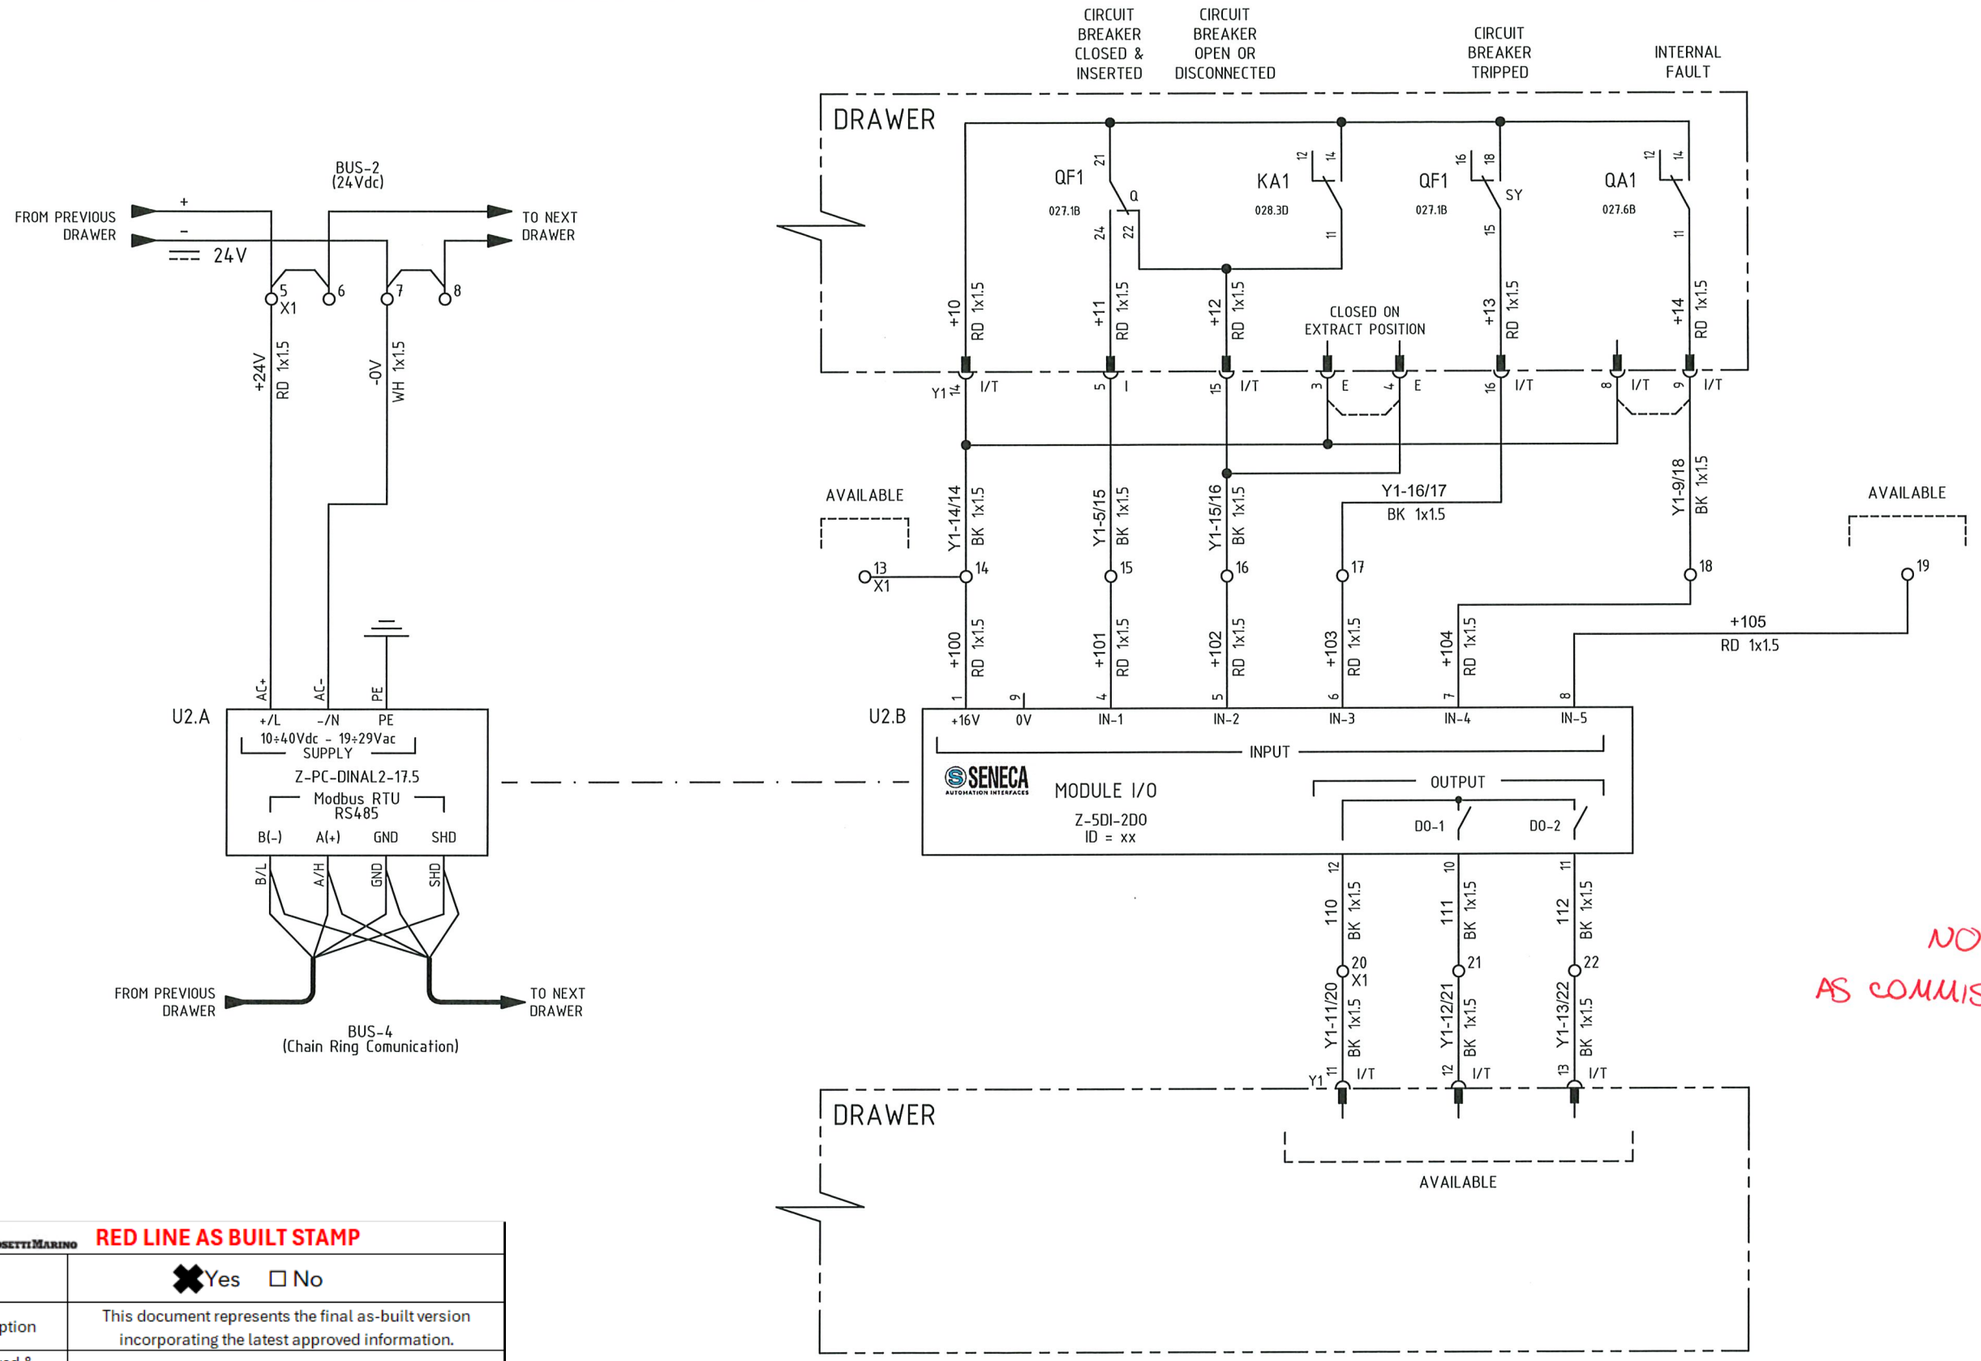

NO MARK UP
AS COMMISSIONED: MARIA GIROTTI
25/3/25

ROSETTI MARINO	RED LINE AS BUILT STAMP
RLMU	✖ Yes ☐ No
Description	This document represents the final as-built version incorporating the latest approved information.
Reviewed & Confirmed by	Rosetti Marino S.P.A.
Signature /Date	

Notes: Tick"Yes" only when the document reflects the final as-commissioned condition and the red-line mark-up (RLMU) has been incorporated without a new revision.
Tick "No" if the last approved revision already represents the final condition, with no redline markup required.

= TYPICAL
\+ L-x
DWG n° : 231298/SD/31
Item n° : PF1002983/26

TI MARINO

REV.	DATE	DRN	CHKD	APPD	DESCRIPTION
2	18/09/2024	Santinelli	Flamminio	Sigismondi	As Built (ASB)
1	10/07/2024	Santinelli	Flamminio	Sigismondi	Accepted for Construction (AFC)
0	09/05/2024	Santinelli	Flamminio	Sigismondi	Issued for review (IFR)

TITLE : "SG-200N1"
LV SWG FUNCTIONAL DIAGRAMS - TYPICAL FEEDERS
Functional Drawing - Typical "L1-n" & "L2-n"

CONTRACT NO./TITLE CW-I-WP4-2023-05/HOLLANDSE KUST NOORD WIND PARK | SCALE : NTS


A3 | DRAWING NO. 1723002197-EL-DG-00031 | SHEET 029 | REV. 02

F.to UNI A3: 420mmx297mm

File Name : 1723002197-EL-DG-00031 Rev. 02

SPECIFIC PARTS

TYPICAL : LINE FEEDER "L1-n" & "L2-n"

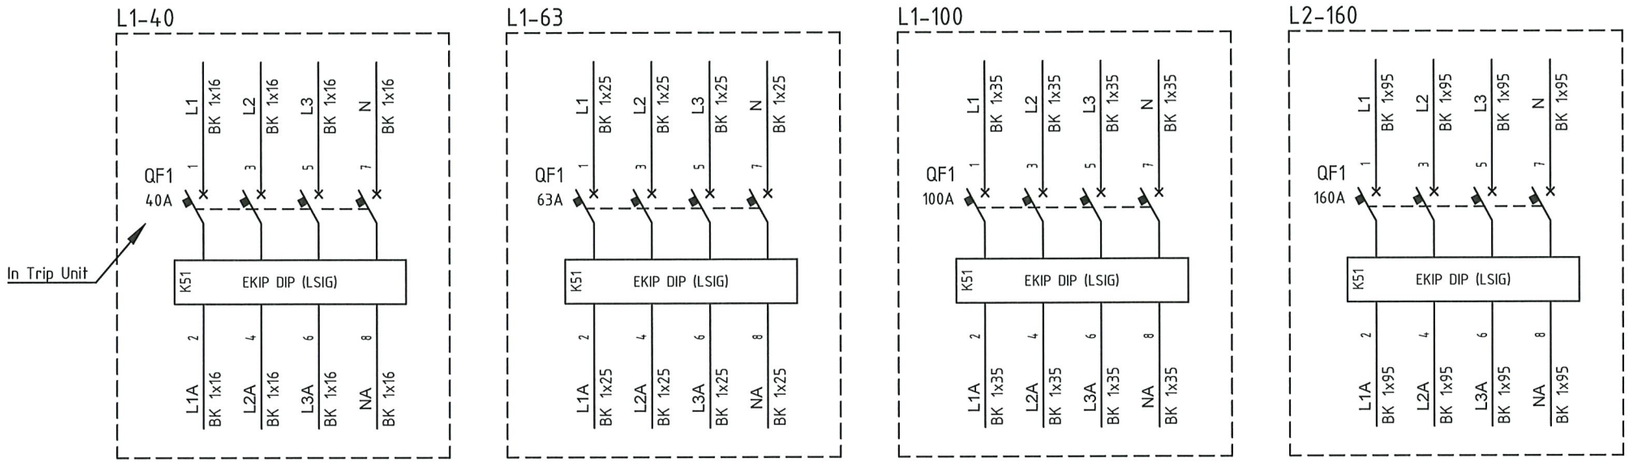

NO MARK UP
AS COMMISSIONED: MARIA GIROTTI
25/3/25

ROSETTI MARINO — RED LINE AS BUILT STAMP

RLMU	✖ Yes ☐ No
Description	This document represents the final as-built version incorporating the latest approved information.
Reviewed & Confirmed by	Rosetti Marino S.P.A.
Signature /Date	

Notes: Tick"Yes" only when the document reflects the final as-commissioned condition and the red-line mark-up (RLMU) has been incorporated without a new revision.
Tick "No" if the last approved revision already represents the final condition, with no redline markup required.

=	TYPICAL					
+	L-x					
DWG n° :	231298/SD/31					
Item n° :	PF1002983/26					
2	18/09/2024	Santinelli	Flamminio	Sigismondi	As Built (ASB)	
1	10/07/2024	Santinelli	Flamminio	Sigismondi	Accepted for Construction (AFC)	
0	09/05/2024	Santinelli	Flamminio	Sigismondi	Issued for review (IFR)	
REV.	DATE	DRN	CHKD	APPD	DESCRIPTION	

ROSETTI MARINO

TITLE : "SG-200N1"
LV SWG FUNCTIONAL DIAGRAMS - TYPICAL FEEDERS
Functional Drawing - Typical "L1-n" & "L2-n"

CONTRACT NO./TITLE CW-I-WP4-2023-05/HOLLANDSE KUST NOORD WIND PARK | SCALE : NTS

A3 | DRAWING NO. 1723002197-EL-DG-00031 | SHEET 030 | REV. 02

F.to UNI A3: 420mmx297mm


File Name : 1723002197-EL-DG-00031 Rev. 02

AUXILIARY SOCKET

136450/001 (PF – 1 pcs) + 136458/004 (PM – 1 pcs)

N° PIN	1	2	3	4	5	6	7	8	9	10	11	12	13	14	15	16	17	18	19	20	21	22
JUMP			●	●				●	●													
RACKED–OUT			X	X				X	X													
TEST								X	X	X	X	X	X	X	X	X	X	X	X	X	X	X
RACKED–IN					X	X	X	X	X	X	X	X	X	X	X	X	X	X	X	X	X	
PIN USED			029.6B	029.7B	029.6B			029.8B	029.8B		029.7D	029.7D	029.8D	029.5B	029.6B	029.7B	028.2B	028.3B	027.6A	027.6A	028.4B	028.3B

TYPICAL - L-x - Y1

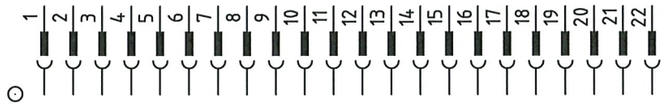

← FIELD WHIT "X" - CONTACT CLOSE WHEN DRAWER IS IN RACKED-OUT POSITION

← FIELD WHIT "X" - CONTACT CLOSE WHEN DRAWER IS IN TEST POSITION

← FIELD WHIT "X" - CONTACT CLOSE WHEN DRAWER IS IN RACKED-IN POSITION

← CROS-REFERENCE USED PIN

NO MARK UP
AS COMMISSIONED: MARIA GIRON
25/3/25

ROSETTI MARINO RED LINE AS BUILT STAMP

RLMU	✖ Yes ☐ No
Description	This document represents the final as-built version incorporating the latest approved information.
Reviewed & Confirmed by	Rosetti Marino S.P.A.
Signature /Date	

Notes: Tick"Yes" only when the document reflects the final as-commissioned condition and the red-line mark-up (RLMU) has been incorporated without a new revision.
Tick "No" if the last approved revision already represents the final condition, with no redline markup required.

ESA ENGINEERING

ROSETTI MARINO

= TYPICAL
+ L-x
DWG n° : 231298/SD/31
Item n° : PF1002983/26

REV.	DATE	DRN	CHKD	APPD	DESCRIPTION
2	18/09/2024	Santinelli	Flamminio	Sigismondi	As Built (ASB)
1	10/07/2024	Santinelli	Flamminio	Sigismondi	Accepted for Construction (AFC)
0	09/05/2024	Santinelli	Flamminio	Sigismondi	Issued for review (IFR)

TITLE : "SG–200N1"
LV SWG FUNCTIONAL DIAGRAMS - TYPICAL FEEDERS
Functional Drawing - Typical "L1-n" & "L2-n"

CONTRACT NO./TITLE CW–I–WP4–2023–05/HOLLANDSE KUST NOORD WIND PARK | SCALE : NTS

A3 | DRAWING NO. 1723002197–EL–DG–00031 | SHEET 031 | REV. 02

F.to UNI A3: 420mmx297mm

File Name : 1723002197–EL–DG–00031 Rev. 02

TYPICAL - L-x

X1

NumM	Fg.	Sez.	Tipo	Descrizione	Costruttore
			BT003	BT/3 End bracket	Cabur
1	027.5A	2.5	HD100GR_	HMD.2/GR Two-level feed-through Terminal Block - Grey (2.5 mmq) - Spring type	Cabur
2	027.6A	2.5	HD100GR_	HMD.2/GR Two-level feed-through Terminal Block - Grey (2.5 mmq) - Spring type	Cabur
3	027.6A	2.5	HD100GR_	HMD.2/GR Two-level feed-through Terminal Block - Grey (2.5 mmq) - Spring type	Cabur
4	027.6A	2.5	HD100GR_	HMD.2/GR Two-level feed-through Terminal Block - Grey (2.5 mmq) - Spring type	Cabur
5	029.2A	2.5	HD100GR_	HMD.2/GR Two-level feed-through Terminal Block - Grey (2.5 mmq) - Spring type	Cabur
6	029.2A	2.5	HD100GR_	HMD.2/GR Two-level feed-through Terminal Block - Grey (2.5 mmq) - Spring type	Cabur
7	029.2A	2.5	HD100GR_	HMD.2/GR Two-level feed-through Terminal Block - Grey (2.5 mmq) - Spring type	Cabur
8	029.3A	2.5	HD100GR_	HMD.2/GR Two-level feed-through Terminal Block - Grey (2.5 mmq) - Spring type	Cabur
			HD101GR	HMD/PT/GR End section - Grey	Cabur
9	028.2A	2.5	HD400GR_	HMD.2N/GR Two-level feed-through Terminal Block - Grey (2.5 mmq) - Spring type	Cabur
10	028.2A	2.5	HD400GR_	HMD.2N/GR Two-level feed-through Terminal Block - Grey (2.5 mmq) - Spring type	Cabur
11	028.3A	2.5	HD400GR_	HMD.2N/GR Two-level feed-through Terminal Block - Grey (2.5 mmq) - Spring type	Cabur
12	028.3A	2.5	HD400GR_	HMD.2N/GR Two-level feed-through Terminal Block - Grey (2.5 mmq) - Spring type	Cabur
13	029.4B	2.5	HD400GR_	HMD.2N/GR Two-level feed-through Terminal Block - Grey (2.5 mmq) - Spring type	Cabur
14	029.5B	2.5	HD400GR_	HMD.2N/GR Two-level feed-through Terminal Block - Grey (2.5 mmq) - Spring type	Cabur
15	029.6B	2.5	HD400GR_	HMD.2N/GR Two-level feed-through Terminal Block - Grey (2.5 mmq) - Spring type	Cabur
16	029.6B	2.5	HD400GR_	HMD.2N/GR Two-level feed-through Terminal Block - Grey (2.5 mmq) - Spring type	Cabur
17	029.7B	2.5	HD400GR_	HMD.2N/GR Two-level feed-through Terminal Block - Grey (2.5 mmq) - Spring type	Cabur
18	029.8B	2.5	HD400GR_	HMD.2N/GR Two-level feed-through Terminal Block - Grey (2.5 mmq) - Spring type	Cabur
19	029.9B	2.5	HD400GR_	HMD.2N/GR Two-level feed-through Terminal Block - Grey (2.5 mmq) - Spring type	Cabur
20	029.7D	2.5	HD400GR_	HMD.2N/GR Two-level feed-through Terminal Block - Grey (2.5 mmq) - Spring type	Cabur
21	029.7D	2.5	HD400GR_	HMD.2N/GR Two-level feed-through Terminal Block - Grey (2.5 mmq) - Spring type	Cabur
22	029.8D	2.5	HD400GR_	HMD.2N/GR Two-level feed-through Terminal Block - Grey (2.5 mmq) - Spring type	Cabur
			HD201GR	HMD.1/PT/GR End section - Grey	Cabur
			BT003	BT/3 End bracket	Cabur

NO MARK UP
AS COMMISSIONED: MARIA GIROT.
25/3/25

RED LINE AS BUILT STAMP

RLMU	✖ Yes ☐ No
Description	This document represents the final as-built version incorporating the latest approved information.
Reviewed & Confirmed by	Rosetti Marino S.P.A.
Signature /Date	

Notes: Tick"Yes" only when the document reflects the final as-commissioned condition and the red-line mark-up (RLMU) has been incorporated without a new revision.
Tick "No" if the last approved revision already represents the final condition, with no redline markup required.

=	TYPICAL
+	L-x
DWG n° :	231298/SD/31
Item n° :	PF1002983/26

REV.	DATE	DRN	CHKD	APPD	DESCRIPTION
2	18/09/2024	Santinelli	Flamminio	Sigismondi	As Built (ASB)
1	10/07/2024	Santinelli	Flamminio	Sigismondi	Accepted for Construction (AFC)
0	09/05/2024	Santinelli	Flamminio	Sigismondi	Issued for review (IFR)

ROSETTI MARINO

TITLE : "SG-200N1"

LV SWG FUNCTIONAL DIAGRAMS - TYPICAL FEEDERS

Functional Drawing - Typical "L1-n" & "L2-n"

CONTRACT NO./TITLE	SCALE :
CW-I-WP4-2023-05/HOLLANDSE KUST NOORD WIND PARK	NTS

A3	DRAWING NO.	SHEET	REV.
	1723002197-EL-DG-00031	032	02

F.to UNI A3: 420mmx297mm

File Name : 1723002197-EL-DG-00031 Rev. 02

Nome/Item	Fg/Sh	Tipo/Type	Q.ta/Q.ty	Descrizione/Description	Costruttore/Manufacturer	Quadro (descrizione)
HL1	028	ML22/483L230STLTTR	1	MULTILED 48x48 - 3 LED - Vaux=230Vac/dc + LAMP TEST + TROP	DOMO	TYPICAL L-x
KA1	028	ER 592 6	1	CR-M230AC4L SUPPLY 230VAC 4C/O 250V/6A LED	ABB	TYPICAL L-x
		ER 609 8	1	CR-MH HOLDER FOR CR-M RELAY	ABB	TYPICAL L-x
		ER 686 6	1	CR-M4SS SOCKET STANDARD X 2/4 C/O(CR-M)	ABB	TYPICAL L-x
QA1	027	S550239	1	S202M C 2 AUTOMATIC CIRCUIT BREAKER 10KA 2P	ABB	TYPICAL L-x
		A563819	1	S2-CS/H6R AUXILIARY STATE CONTACT 1CO	ABB	TYPICAL L-x
U2.A	029	Z-PC-DINAL2-17.5	1	DIN RAIL 2SLOT WITH HEAD FOR "Z-5DI-2DO"	SENECA	TYPICAL L-x
U2.B	029	Z-5DI-2DO	1	I/O MODUL 5DI+2DO modbus RS485 Vaux=10÷40Vdc 19÷28Vac	SENECA	TYPICAL L-x
X1		HD100GR_	8	HMD.2/GR Two-level feed-through Terminal Block - Grey (2.5 mmq) - Spring type	Cabur	TYPICAL L-x
		HD400GR_	14	HMD.2N/GR Two-level feed-through Terminal Block - Grey (2.5 mmq) - Spring type	Cabur	TYPICAL L-x
		BT003	2	BT/3 End bracket	Cabur	TYPICAL L-x
		HD101GR	1	HMD/PT/GR End section - Grey	Cabur	TYPICAL L-x
		HD201GR	1	HMD.1/PT/GR End section - Grey	Cabur	TYPICAL L-x

NO MARK UP
AS COMMISSIONED: MARIA GIROTTI
25/3/25

Nome/Item	Fg/Sh	Tipo/Type	Q.ta/Q.ty	Descrizione/Description	Costruttore/Manufacturer	Quadro (descrizione)
QF1	030	XT2S40LSIG4	1	XT2S 160 Ekip LSIG In=40A 4p F F	ABB	TYPICAL L1-40
		1SDA066436R1	1	AUX-C 3Q+2SY 250Vac/dc XT2-XT4 F/P	ABB	TYPICAL L1-40
		1SDA066325R1	1	SOR-C XT1..XT4 F/P 220-240Vac-220-250Vdc	ABB	TYPICAL L1-40

Nome/Item	Fg/Sh	Tipo/Type	Q.ta/Q.ty	Descrizione/Description	Costruttore/Manufacturer	Quadro (descrizione)
QF1	030	XT2S63LSIG4	1	XT2S 160 Ekip LSIG In=63A 4p F F	ABB	TYPICAL L1-63
		1SDA066436R1	1	AUX-C 3Q+2SY 250Vac/dc XT2-XT4 F/P	ABB	TYPICAL L1-63
		1SDA066325R1	1	SOR-C XT1..XT4 F/P 220-240Vac-220-250Vdc	ABB	TYPICAL L1-63

Nome/Item	Fg/Sh	Tipo/Type	Q.ta/Q.ty	Descrizione/Description	Costruttore/Manufacturer	Quadro (descrizione)
QF1	030	XT2S100LSIG4	1	XT2S 160 Ekip LSIG In=100A 4p F F	ABB	TYPICAL L1-100
		1SDA066436R1	1	AUX-C 3Q+2SY 250Vac/dc XT2-XT4 F/P	ABB	TYPICAL L1-100
		1SDA066325R1	1	SOR-C XT1..XT4 F/P 220-240Vac-220-250Vdc	ABB	TYPICAL L1-100

Nome/Item	Fg/Sh	Tipo/Type	Q.ta/Q.ty	Descrizione/Description	Costruttore/Manufacturer	Quadro (descrizione)
QF1	030	1SDA068179R1	1	XT4S 250 BREAKING PART 4p F F	ABB	TYPICAL L2-160
		1SDA067536R1	1	SG.EL.Ekip LSIG In=160A XT4 4p	ABB	TYPICAL L2-160
			1	AUX-C 3Q+2SY 250Vac/dc XT2-XT4 F/P	ABB	TYPICAL L2-160
			1	SOR-C XT1..XT4 F/P 220-240Vac-220-250Vdc	ABB	TYPICAL L2-160

ROSETTI MARINO **RED LINE AS BUILT STAMP**

RLMU	✖ Yes ☐ No
Description	This document represents the final as-built version incorporating the latest approved information.
Reviewed & Confirmed by	Rosetti Marino S.P.A.
Signature /Date	

Notes: Tick"Yes" only when the document reflects the final as-commissioned condition and the red-line mark-up (RLMU) has been incorporated without a new revision.
Tick "No" if the last approved revision already represents the final condition, with no redline markup required.

=	TYPICAL
+	L-x
DWG n° :	231298/SD/31
Item n° :	PF1002983/26

ENGINEERING

ROSETTI MARINO

REV.	DATE	DRN	CHKD	APPD	DESCRIPTION
2	18/09/2024	Santinelli	Flamminio	Sigismondi	As Built (ASB)
1	10/07/2024	Santinelli	Flamminio	Sigismondi	Accepted for Construction (AFC)
0	09/05/2024	Santinelli	Flamminio	Sigismondi	Issued for review (IFR)

TITLE : "SG-200N1"

LV SWG FUNCTIONAL DIAGRAMS - TYPICAL FEEDERS

Functional Drawing - Typical "L1-n" & "L2-n"

CONTRACT NO./TITLE CW-I-WP4-2023-05/HOLLANDSE KUST NOORD WIND PARK | SCALE : NTS


A3 | DRAWING NO. 1723002197-EL-DG-00031 | SHEET 033 | REV. 02

F.to UNI A3: 420mmx297mm

File Name : 1723002197-EL-DG-00031 Rev. 02

DOOR FRONT LAY-OUT

TYPICAL : LINE FEEDER "LK1-n"

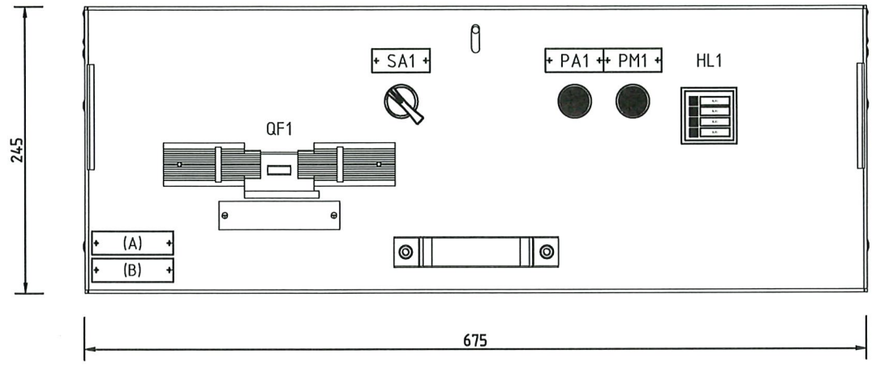


NOTE :

A) IDENTIFICATION name plate (type-1A) , with :
- Drawer position [Column / Position inside SWB]
- Typical name [reference applicability typical used]
- Power [reference applicability typical used]


B) USER name plate (type-1B), with :
- Item User [to see SLD diagrams]
- User Description [to see SLD diagrams]

DEVICES name plate			
ITEM	DESCRIPTION 1	DESCRIPTION 2	NOTE
QF1	Circuit Breaker		NO plate
SA1	LOC-REM	SELECTOR	Type-2A
PA1	STOP	MOTOR	Type-2A
PM1	RUN	MOTOR	Type-2A
HL1	Multiled	Signalling	NO plate


TYPE-1A

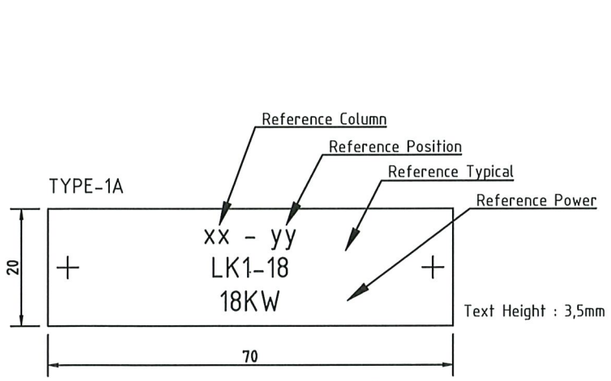

TYPE-2A

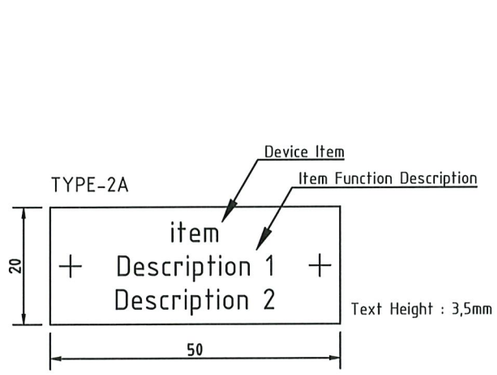

TYPE-1B

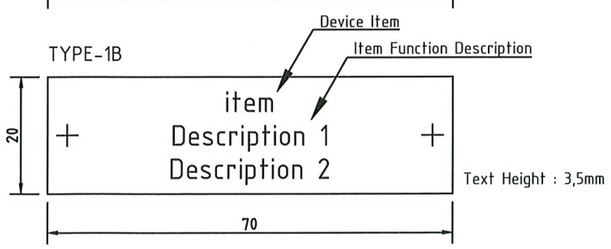

RED LINE AS BUILT STAMP

AS

RLMU	✖ Yes ☐ No
Description	This document represents the final as-built version incorporating the latest approved information.
Reviewed & Confirmed by	Rosetti Marino S.P.A.
Signature /Date	

Notes: Tick"Yes" only when the document reflects the final as-commissioned condition and the red-line mark-up (RLMU) has been incorporated without a new revision.
Tick "No" if the last approved revision already represents the final condition, with no redline markup required.

VALID FOR CONSTRUCTION
VENDOR DOCUMENT - FDL DWG:
123A90-FDL-1724002197-EL-DG-00031

REV.:	DATE:	SIGNATURE:
2_A	18/03/25	G.Randi

ROSETTI MARINO SpA

CROSSWIND

IMESA ELECTRICAL ENGINEERING

ROSETTI MARINO

= TYPICAL
+ LK-x
DWG n° : 231298/SD/31
Item n° : PF1002983/26

REV.	DATE	DRN	CHKD	APPD	DESCRIPTION
2	18/09/2024	Santinelli	Flamminio	Sigismondi	As Built (ASB)
1	10/07/2024	Santinelli	Flamminio	Sigismondi	Accepted for Construction (AFC)
0	09/05/2024	Santinelli	Flamminio	Sigismondi	Issued for review (IFR)

TITLE : "SG-200N1"
LV SWG FUNCTIONAL DIAGRAMS - TYPICAL FEEDERS
Door Front Lay-Out - Typical "LK1-n" & "LK2-n"

CONTRACT NO./TITLE CW-I-WP4-2023-05/HOLLANDSE KUST NOORD WIND PARK | SCALE : NTS


A3 | DRAWING NO. 1723002197-EL-DG-00031 | SHEET 034 | REV. 02


F.to UNI A3: 420mmx297mm


File Name : 1723002197-EL-DG-00031 Rev. 02


DOOR FRONT LAY-OUT

TYPICAL : LINE FEEDER "LK2-n"

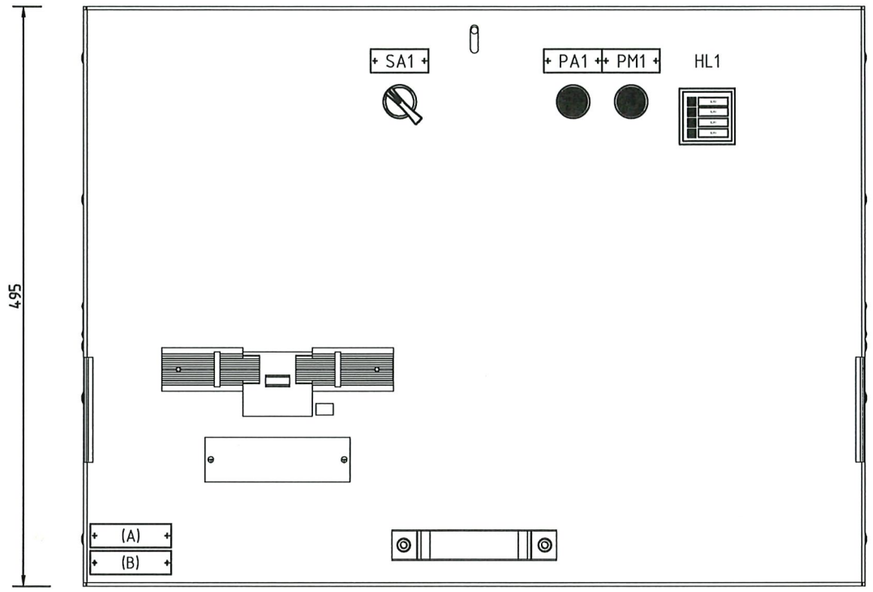

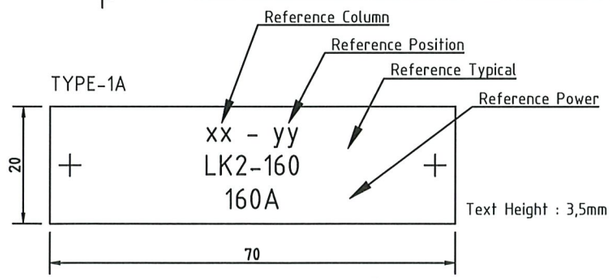

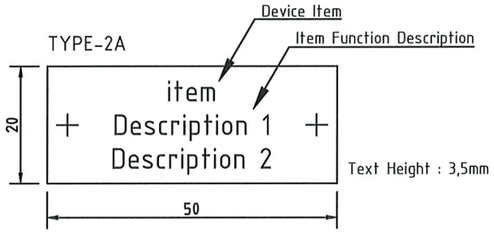

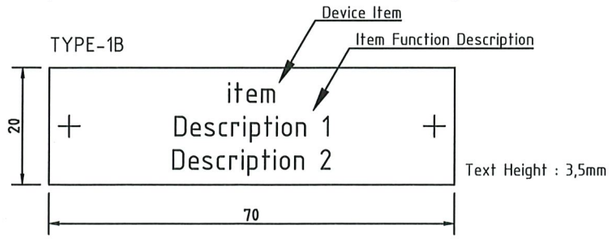

NOTE :

A) IDENTIFICATION name plate (type-1A) , with :
- Drawer position [Column / Position inside SWB]
- Typical name [reference applicability typical used]
- Power [reference applicability typical used]

B) USER name plate (type-1B), with :
- Item User [to see SLD diagrams]
- User Description [to see SLD diagrams]

DEVICES name plate

ITEM	DESCRIPTION 1	DESCRIPTION 2	NOTE
QF1	Circuit Breaker		NO plate
SA1	LOC-REM	SELECTOR	Type-2A
PA1	STOP	MOTOR	Type-2A
PM1	RUN	MOTOR	Type-2A
HL1	Multiled	Signalling	NO plate

ROSETTI MARINO	RED LINE AS BUILT STAMP
RLMU	✖ Yes ☐ No
Description	This document represents the final as-built version incorporating the latest approved information.
Reviewed & Confirmed by	Rosetti Marino S.P.A.
Signature /Date	

Notes: Tick"Yes" only when the document reflects the final as-commissioned condition and the red-line mark-up (RLMU) has been incorporated without a new revision.
Tick "No" if the last approved revision already represents the final condition, with no redline markup required.

VALID FOR CONSTRUCTION
VENDOR DOCUMENT - FDL DWG:
123A90-FDL-1724002197-EL-DG-00031

REV.:	DATE:	SIGNATURE:
2_A	18/03/25	G.Randi

ROSETTI MARINO SpA

CROSSWIND

IMESA ELECTRICAL ENGINEERING

ROSETTI MARINO

= TYPICAL
+ LK-x
DWG n° : 231298/SD/31
Item n° : PF1002983/26

REV.	DATE	DRN	CHKD	APPD	DESCRIPTION
2	18/09/2024	Santinelli	Flamminio	Sigismondi	As Built (ASB)
1	10/07/2024	Santinelli	Flamminio	Sigismondi	Accepted for Construction (AFC)
0	09/05/2024	Santinelli	Flamminio	Sigismondi	Issued for review (IFR)

TITLE : "SG-200N1"
LV SWG FUNCTIONAL DIAGRAMS - TYPICAL FEEDERS
Door Front Lay-Out - Typical "LK1-n" & "LK2-n"

CONTRACT NO./TITLE CW-I-WP4-2023-05/HOLLANDSE KUST NOORD WIND PARK | SCALE : NTS

A3 | DRAWING NO. 1723002197-EL-DG-00031 | SHEET 035 | REV. 02

F.to UNI A3: 420mmx297mm

File Name : 1723002197-EL-DG-00031 Rev. 02

USERS LEGEND

TYPICAL : LINE FEEDER "LK1-n" "LK2-n"

TYPICAL APPLICABILITY					
ITEM	ITEM TAG	DESCRIPTION TAG	REFERENCE POSITION (written on name name plate "type-1A)	REFERENCE NOMINAL CURRENT C.B. TRIP UNIT (written on name name plate "type-1A)	REFERENCE TYPICAL (written on name name plate "type-1A)
1	SPARE	SPARE	A2 / +05	40A	LK1-40
2	SPARE	SPARE	A3 / +02	40A	LK1-40
3	DP-200N1	DB-LIGHTING & SMALL POWER BoP	A3 / +03	100A	LK1-100
4	JB-200E3	CRANE	A3 / +04	63A	LK1-63
5	SPARE	SPARE	A3 / +05	40A	LK1-40
6	JB-500E8	WATER PACKAGE	A3 / +08	160A	LK2-160
7	B100-HSB-001	HVAC PANELS HV ROOM	A4 / +02	40A	LK1-40
8	A-80000	FUELL CELL AUXIALIRY LOAD	A4 / +03	63A	LK1-63
9	CP-850F03	BESS PCS CABINET	A4 / +04	40A	LK1-40
10	SPARE	SPARE	A4 / +05	40A	LK1-40
11	SPARE	SPARE	A4 / +06	40A	LK1-40
12	K-63001-A	INSTRUMENTS AIR PACKAGE 01A	A4 / +08	160A	LK2-160
13	SPARE	SPARE	A5 / +01	40A	LK1-40
14	B200-HSB-001	HVAC PANELS - LV ROOM	A5 / +02	40A	LK1-40
15	B300-HSB-001	HVAC PANELS - UPS ROOM	A5 / +03	63A	LK1-63
16	B400-HSB-001	HVAC PANELS - ITER	A5 / +04	63A	LK1-63
17	CN-200N1	IMPRESSED CURR. CATHODIC PROTECTION (ICCP) SYSTEM	A5 / +05	40A	LK1-40
18	SPARE	SPARE	A5 / +06	40A	LK1-40
19	K-63001-B	INSTRUMENTS AIR PACKAGE 01B	A5 / +08	160A	LK2-160
20	CP-850E1	BESS LV1 CABINAT (+DISTR 1)	A6 / +02	40A	LK1-40
21	CP-850E2	BESS LV2 CABINAT (+DISTR 2)	A6 / +03	40A	LK1-40
22	SPARE	SPARE	A6 / +04	40A	LK1-40

AS COMMISSIONED: NATALIA GINORI
24/3/25
NO MARK UP

ROSETTI MARINO RED LINE AS BUILT STAMP

RLMU	✖ Yes ☐ No
Description	This document represents the final as-built version incorporating the latest approved information.
Reviewed & Confirmed by	Rosetti Marino S.P.A.
Signature /Date	Claudia Giunchi

Notes: Tick"Yes" only when the document reflects the final as-commissioned condition and the red-line mark-up (RLMU) has been incorporated without a new revision.
Tick "No" if the last approved revision already represents the final condition, with no redline markup required.

=	TYPICAL
+	LK-x
DWG n° :	231298/SD/31
Item n° :	PF1002983/26

REV.	DATE	DRN	CHKD	APPD	DESCRIPTION
2	18/09/2024	Santinelli	Flamminio	Sigismondi	As Built (ASB)
1	10/07/2024	Santinelli	Flamminio	Sigismondi	Accepted for Construction (AFC)
0	09/05/2024	Santinelli	Flamminio	Sigismondi	Issued for review (IFR)

ROSETTI MARINO

TITLE : "SG-200N1"
LV SWG FUNCTIONAL DIAGRAMS - TYPICAL FEEDERS
Users Legend - Typical "LK1-n" & "LK2-n"

CONTRACT NO./TITLE CW-I-WP4-2023-05/HOLLANDSE KUST NOORD WIND PARK | SCALE : NTS

A3 | DRAWING NO. 1723002197-EL-DG-00031 | SHEET 036 | REV. 02

F.to UNI A3: 420mmx297mm

File Name : 1723002197-EL-DG-00031 Rev. 02

ITEMS ACRONYM

TYPICAL : LINE FEEDER "LK1-n" "LK2-n"

Composition of Typical :

LK-x = Common Parts
LK1-"nn" or LK2-"nn"= Specific Parts

Example for Composition of LK1-63:
- to take "LK-x" plus "LK1-63"

Example for Composition of LK2-160:
- to take "LK-x" plus "LK2-160"

	ACRONYM ITEMS (Comun parts)	ACRONYM ITEMS (Specific parts)					
	LK-x	LK1-40 (In=40A) (Current Trip Unit)	LK1-63 (In=63A) (Current Trip Unit)	LK1-100 (In=100A) (Current Trip Unit)	LK2-160 (In=160A) (Current Trip Unit)		
ASSOCIATED TYPICAL	This Item include all devices that are comun for both "Specific Parts" Items	This Items include only devices that are detail for "Specific Parts" Items					
LK1-40	X	X					
LK1-63	X		X				
LK1-100	X			X			
LK2-160	X				X		
-							

AS COMMISSIONED: NATALIA GIRON
24/3/25
NO MARK UP

ROSETTI MARINO RED LINE AS BUILT STAMP

RLMU	✖ Yes ☐ No
Description	This document represents the final as-built version incorporating the latest approved information.
Reviewed & Confirmed by	Rosetti Marino S.P.A.
Signature /Date	Claudia Gorchi

Notes: Tick"Yes" only when the document reflects the final as-commissioned condition and the red-line mark-up (RLMU) has been incorporated without a new revision.
Tick "No" if the last approved revision already represents the final condition, with no redline markup required.

ROSETTI MARINO

=	TYPICAL					
+	LK-x					
DWG n° :	231298/SD/31					
Item n° :	PF1002983/26					
2	18/09/2024	Santinelli	Flamminio	Sigismondi	As Built (ASB)	
1	10/07/2024	Santinelli	Flamminio	Sigismondi	Accepted for Construction (AFC)	
0	09/05/2024	Santinelli	Flamminio	Sigismondi	Issued for review (IFR)	
REV.	DATE	DRN	CHKD	APPD	DESCRIPTION	


TITLE : "SG-200N1"
LV SWG FUNCTIONAL DIAGRAMS - TYPICAL FEEDERS
Items Acronym - Typical "LK1-n" & "LK2-n"

CONTRACT NO./TITLE CW-I-WP4-2023-05/HOLLANDSE KUST NOORD WIND PARK | SCALE : NTS

A3 | DRAWING NO. 1723002197-EL-DG-00031 | SHEET 037 | REV. 02

F.to UNI A3: 420mmx297mm

File Name : 1723002197-EL-DG-00031 Rev. 02

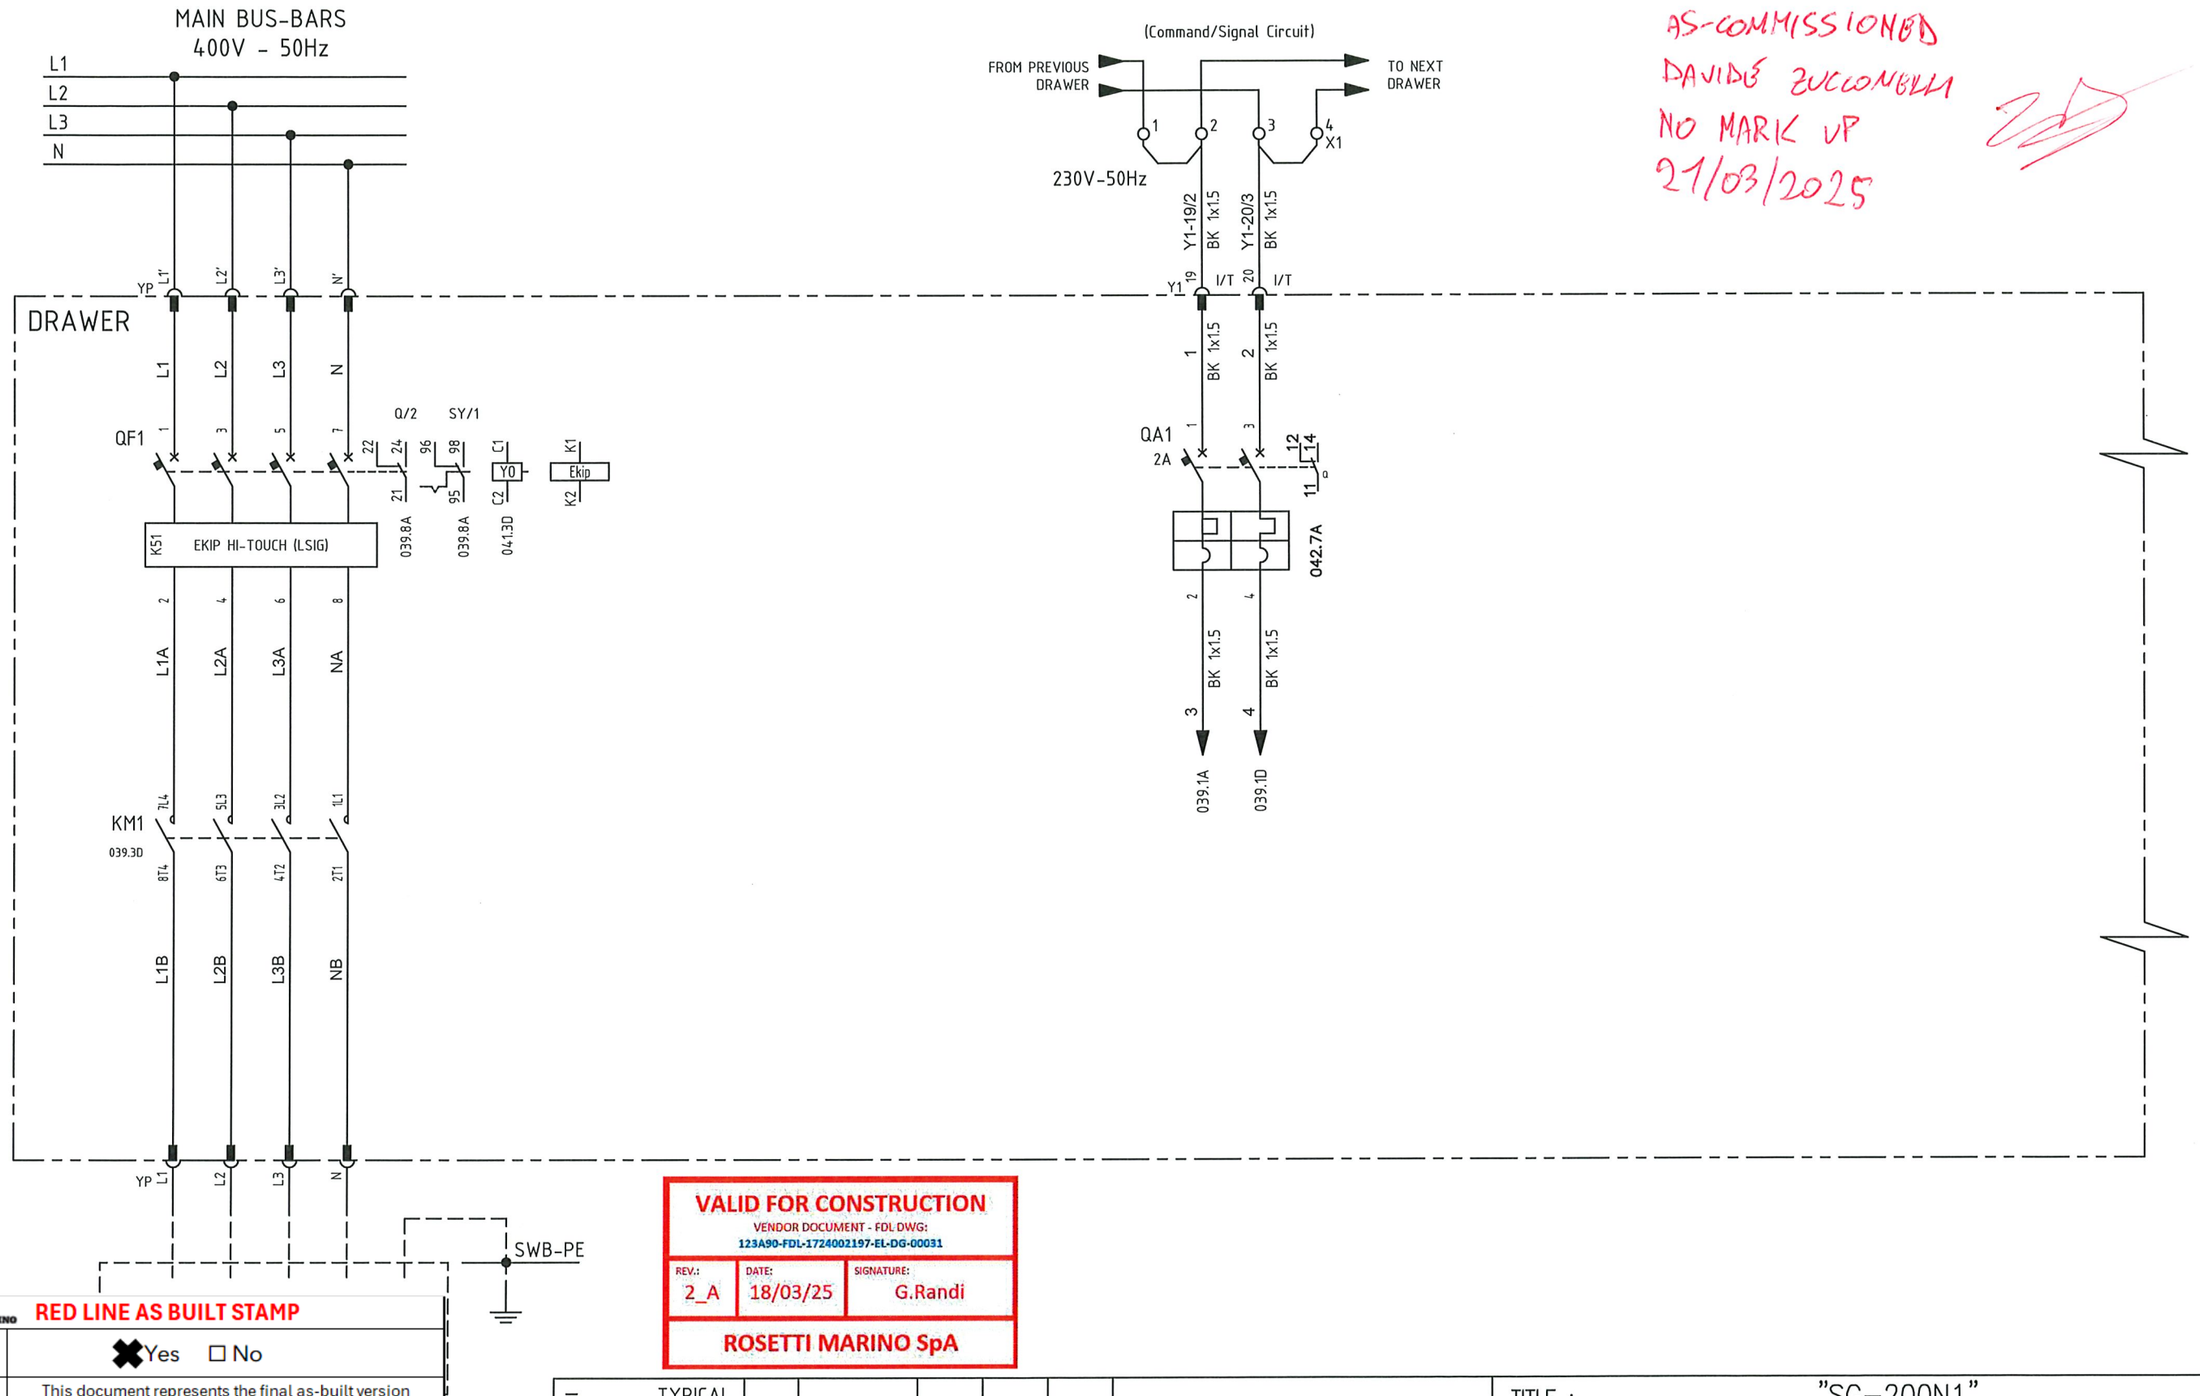

AS-COMMISSIONED
DAVIDE ZUCCONELLI
NO MARK UP
21/03/2025

VALID FOR CONSTRUCTION
VENDOR DOCUMENT - FDL DWG:
123A90-FDL-1724002197-EL-DG-00031

REV.:	DATE:	SIGNATURE:
2_A	18/03/25	G.Randi

ROSETTI MARINO SpA

RED LINE AS BUILT STAMP

RLMU	✖ Yes ☐ No
Description	This document represents the final as-built version incorporating the latest approved information.
Reviewed & Confirmed by	Rosetti Marino S.P.A.
Signature /Date	

Notes: Tick"Yes" only when the document reflects the final as-commissioned condition and the red-line mark-up (RLMU) has been incorporated without a new revision.
Tick "No" if the last approved revision already represents the final condition, with no redline markup required.

=	TYPICAL
+	LK-x

DWG n° : 231298/SD/31
Item n° : PF1002983/26

ROSETTI MARINO

REV.	DATE	DRN	CHKD	APPD	DESCRIPTION
2	18/09/2024	Santinelli	Flamminio	Sigismondi	As Built (ASB)
1	10/07/2024	Santinelli	Flamminio	Sigismondi	Accepted for Construction (AFC)
0	09/05/2024	Santinelli	Flamminio	Sigismondi	Issued for review (IFR)


TITLE : "SG-200N1"
LV SWG FUNCTIONAL DIAGRAMS - TYPICAL FEEDERS
Functional Drawing - Typical "LK1-n" & "LK2-n"

CONTRACT NO./TITLE CW-I-WP4-2023-05/HOLLANDSE KUST NOORD WIND PARK | SCALE : NTS

A3 | DRAWING NO. 1723002197-EL-DG-00031 | SHEET 038 | REV. 02

F.to UNI A3: 420mmx297mm

File Name : 1723002197-EL-DG-00031 Rev. 02

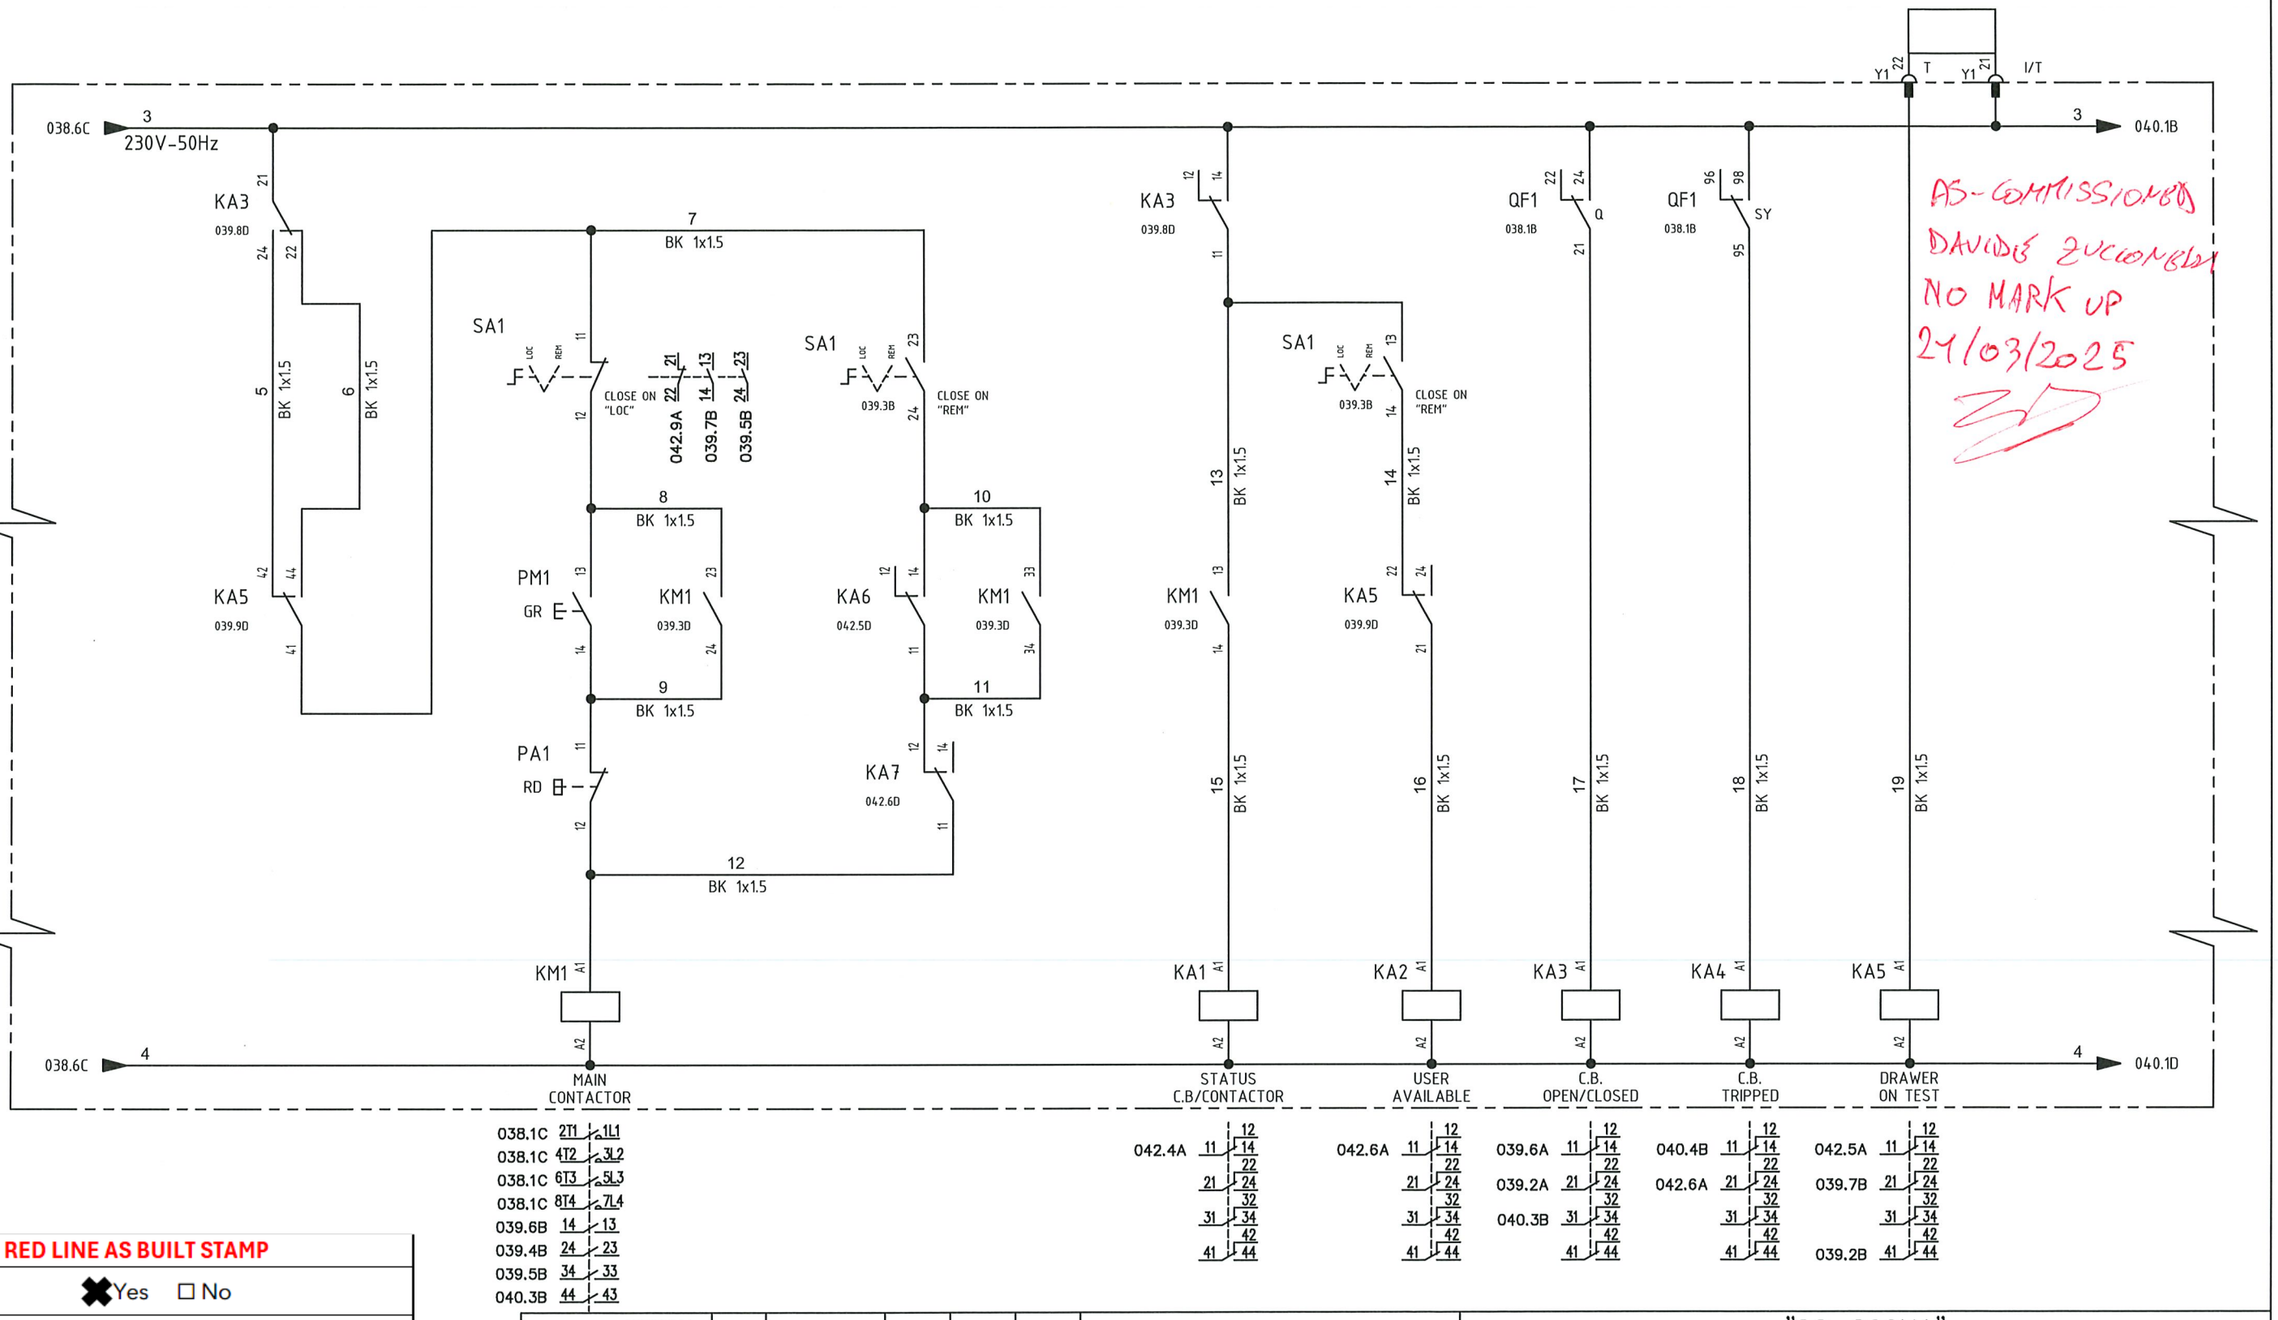

AS-COMMISSIONED
DAVIDE ZUCCONELLI
NO MARK UP
24/03/2025

RED LINE AS BUILT STAMP

RLMU	✖ Yes ☐ No
Description	This document represents the final as-built version incorporating the latest approved information.
Reviewed & Confirmed by	Rosetti Marino S.P.A.
Signature /Date	

Notes: Tick"Yes" only when the document reflects the final as-commissioned condition and the red-line mark-up (RLMU) has been incorporated without a new revision.
Tick "No" if the last approved revision already represents the final condition, with no redline markup required.

=	TYPICAL
+	LK-x

DWG n° : 231298/SD/31
Item n° : PF1002983/26

ROSETTI MARINO

REV.	DATE	DRN	CHKD	APPD	DESCRIPTION
2	18/09/2024	Santinelli	Flamminio	Sigismondi	As Built (ASB)
1	10/07/2024	Santinelli	Flamminio	Sigismondi	Accepted for Construction (AFC)
0	09/05/2024	Santinelli	Flamminio	Sigismondi	Issued for review (IFR)

TITLE : "SG-200N1"

LV SWG FUNCTIONAL DIAGRAMS - TYPICAL FEEDERS

Functional Drawing - Typical "LK1-n" & "LK2-n"

CONTRACT NO./TITLE CW-I-WP4-2023-05/HOLLANDSE KUST NOORD WIND PARK

SCALE : NTS

A3

DRAWING NO. 1723002197-EL-DG-00031


SHEET 039

REV. 02

F.to UNI A3: 420mmx297mm

File Name : 1723002197-EL-DG-00031 Rev. 02

AS-COMMISSIONED
DAVIDE ZUCCONELLI
NO MARK UP
27/03/2025

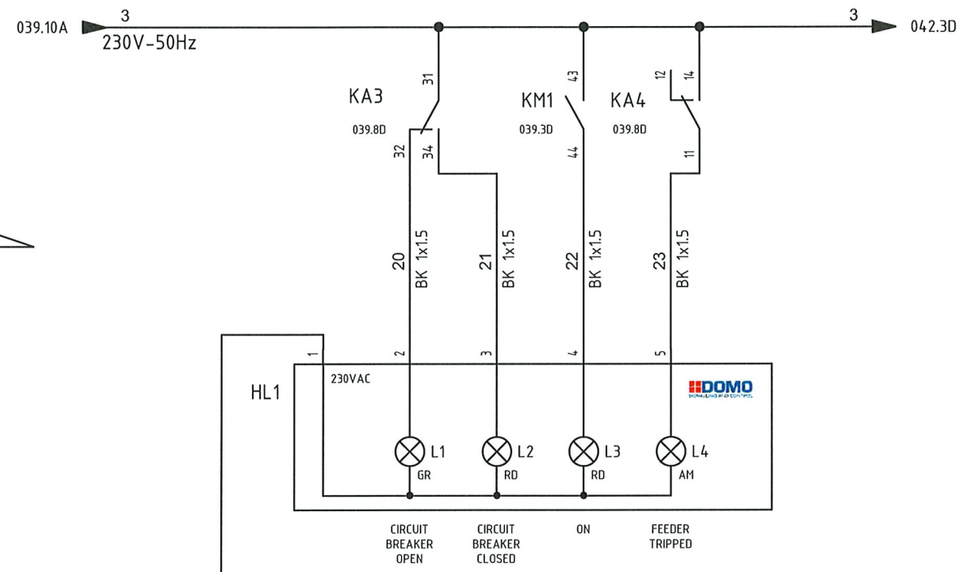

RED LINE AS BUILT STAMP

RLMU	✖ Yes ☐ No
Description	This document represents the final as-built version incorporating the latest approved information.
Reviewed & Confirmed by	Rosetti Marino S.P.A.
Signature /Date	

Notes: Tick"Yes" only when the document reflects the final as-commissioned condition and the red-line mark-up (RLMU) has been incorporated without a new revision.
Tick "No" if the last approved revision already represents the final condition, with no redline markup required.

=	TYPICAL
+	LK-x
DWG n° :	231298/SD/31
Item n° :	PF1002983/26

ROSETTI MARINO

REV.	DATE	DRN	CHKD	APPD	DESCRIPTION
2	18/09/2024	Santinelli	Flamminio	Sigismondi	As Built (ASB)
1	10/07/2024	Santinelli	Flamminio	Sigismondi	Accepted for Construction (AFC)
0	09/05/2024	Santinelli	Flamminio	Sigismondi	Issued for review (IFR)

TITLE : "SG-200N1"
LV SWG FUNCTIONAL DIAGRAMS - TYPICAL FEEDERS
Functional Drawing - Typical "LK1-n" & "LK2-n"


CONTRACT NO./TITLE CW-I-WP4-2023-05/HOLLANDSE KUST NOORD WIND PARK | SCALE : NTS

A3 | DRAWING NO. 1723002197-EL-DG-00031 | SHEET 040 | REV. 02

F.to UNI A3: 420mmx297mm

File Name : 1723002197-EL-DG-00031 Rev. 02

AS-COMMISSIONED
DAVIDE ZUCCONELLI
NO MARK UP
21/03/2025

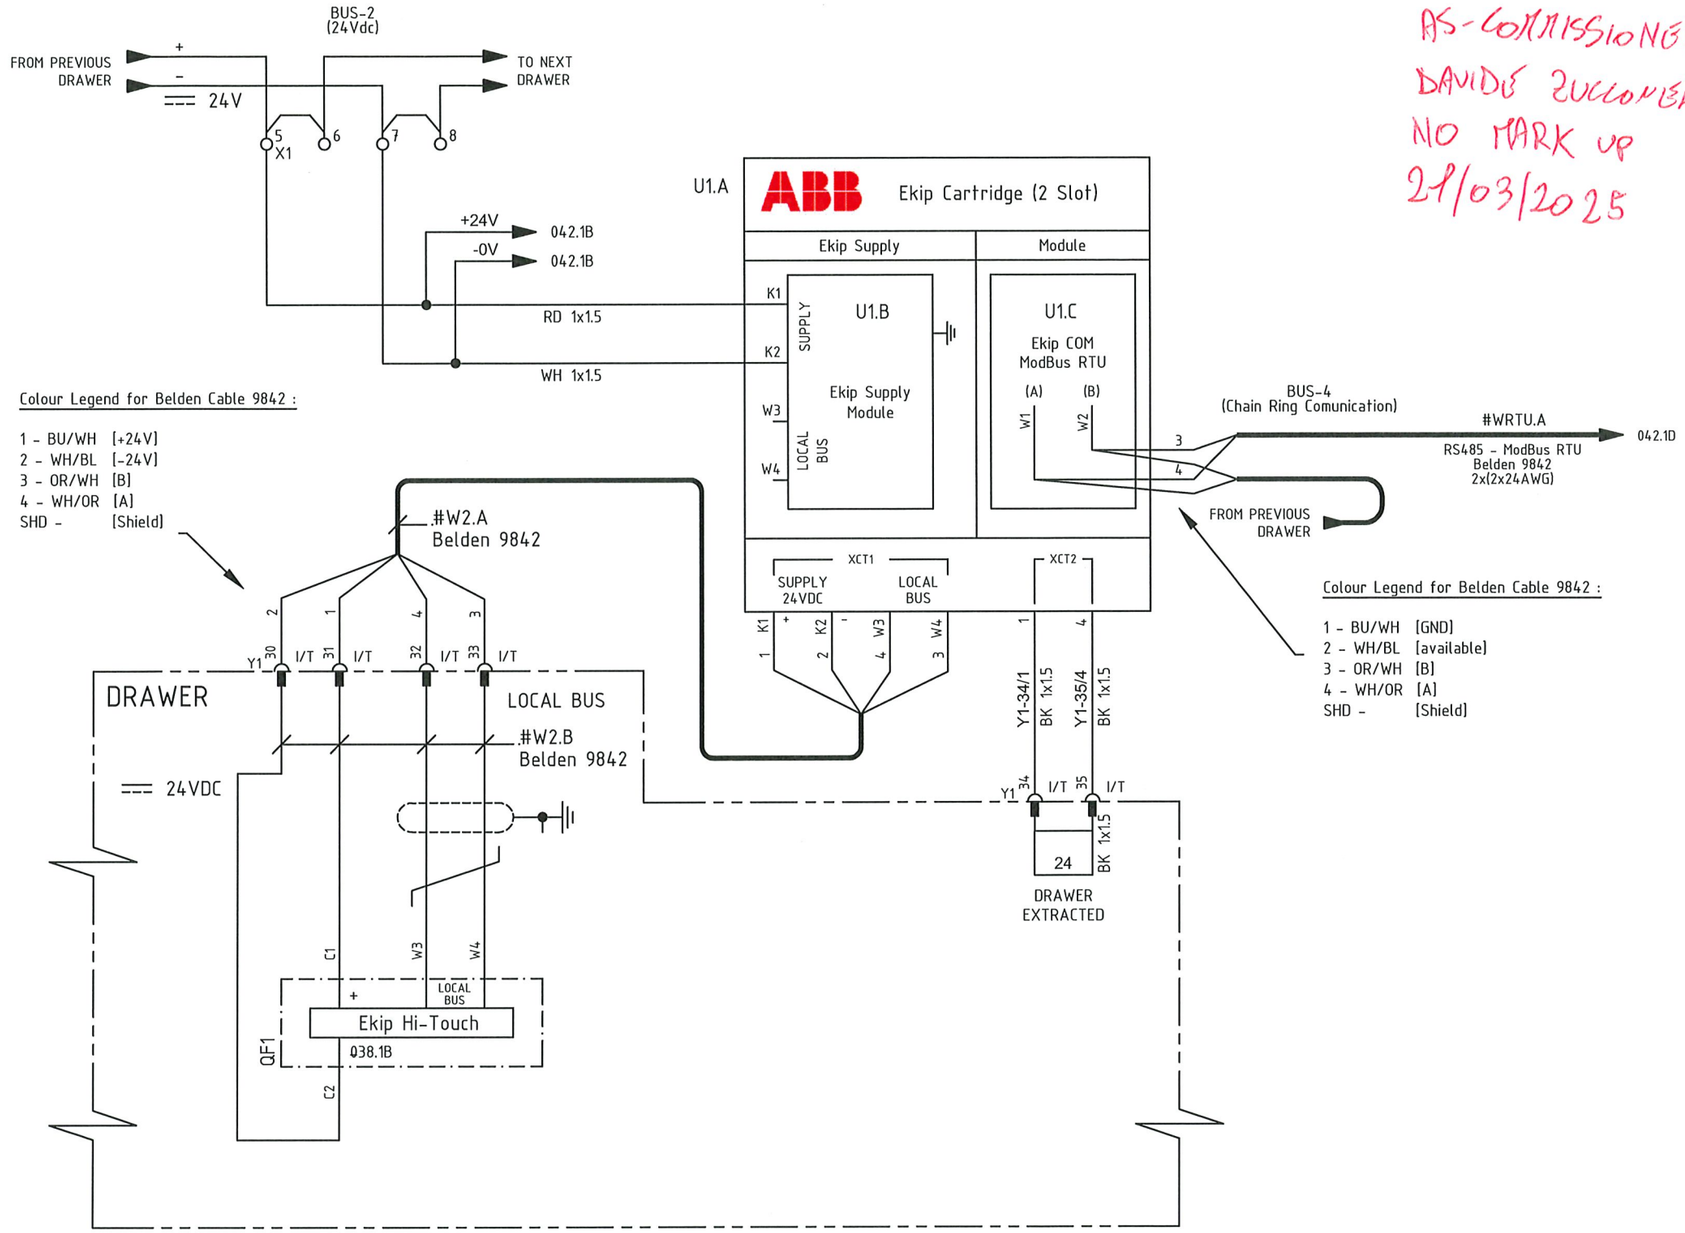

RED LINE AS BUILT STAMP

RLMU	✖ Yes ☐ No
Description	This document represents the final as-built version incorporating the latest approved information.
Reviewed & Confirmed by	Rosetti Marino S.P.A.
Signature /Date	

Notes: Tick"Yes" only when the document reflects the final as-commissioned condition and the red-line mark-up (RLMU) has been incorporated without a new revision.
Tick "No" if the last approved revision already represents the final condition, with no redline markup required.

=	TYPICAL					
+	LK-x					
OWG n° :	231298/SD/31					
Item n° :	PF1002983/26					
2	18/09/2024	Santinelli	Flamminio	Sigismondi	As Built (ASB)	
1	10/07/2024	Santinelli	Flamminio	Sigismondi	Accepted for Construction (AFC)	
0	09/05/2024	Santinelli	Flamminio	Sigismondi	Issued for review (IFR)	
REV.	DATE	DRN	CHKD	APPD	DESCRIPTION	

ROSETTI MARINO

TITLE : "SG-200N1"

LV SWG FUNCTIONAL DIAGRAMS - TYPICAL FEEDERS

Functional Drawing - Typical "LK1-n" & "LK2-n"

CONTRACT NO./TITLE CW-I-WP4-2023-05/HOLLANDSE KUST NOORD WIND PARK | SCALE : NTS

A3 | DRAWING NO. 1723002197-EL-DG-00031 | SHEET 041 | REV. 02

F.to UNI A3: 420mmx297mm

File Name : 1723002197-EL-DG-00031 Rev. 02

AS-COMMISSIONED
DAVIDE ZUCCOMELLA
NO MARK UP
21/03/2025

DRAWER

C.B. - CONTACTOR CLOSED & INSERTED
C.B. - CONTACTOR OPEN OR DISCONNECTED
CIRCUIT BREAKER TRIPPED
FEEDER AVAILABLE
INTERNAL FAULT
USER ON LOCAL

KA1 039.6D
KA5 039.9D
KA4 039.8D
KA2 039.7D
QA1 038.6B
SA1 039.3B
CLOSE ON "LOC"

+25 RD 1x1.5 … +32 RD 1x1.5
Y1 14 I/T | 5 I | 15 I/T | 3 E | 4 E | 16 I/T | 10 I/T | 8 I/T | 9 I/T | 36 I/T | 37 I/T

Y1-14/9 BK 1x1.5
Y1-5/10 BK 1x1.5
Y1-15/11 BK 1x1.5
Y1-16/12 BK 1x1.5
Y1-10/13 BK 1x1.5
Y1-9/14 BK 1x1.5
Y1-36/15 BK 1x1.5
Y1-37/19 BK 1x1.5
9 X1 | 10 | 11 | 12 | 13 | 14 X1 | 15 X1 | 16 X1 | 17 X1 | 18 X1 | 19 X1

AVAILABLE

+103 RD 1x1.5 | +104 RD 1x1.5 | +105 RD 1x1.5 | +106 RD 1x1.5 | +107 RD 1x1.5 | +108 RD 1x1.5 | +115 RD 1x1.5 | +116 RD 1x1.5 | +117 RD 1x1.5 | +118 RD 1x1.5

041.4A +24V
041.4A -0V
24V

U2.A
AC+ AC- PE
+/L -/N PE
10÷40Vdc - 19÷29Vac SUPPLY
Z-PC-DINAL2-17.5
Modbus RTU RS485
B(-) A(+) GND SHD
B/L A/H GND SHD
3 4 1 SHD
041.9B
TO NEXT DRAWER
BUS-4 (Chain Ring Comunication)

U2.B
+16V 0V IN-1 IN-2 IN-3 IN-4 IN-5
INPUT
SENECA AUTOMATION INTERFACES
MODULE I/O
Z-5DI-2DO
ID = 01
OUTPUT
DO-1 DO-2

U2.C
+16V 0V IN-1 IN-2 IN-3 IN-4 IN-5
INPUT
SENECA AUTOMATION INTERFACES
MODULE I/O
Z-5DI-2DO
ID = 02
OUTPUT
DO-1 DO-2

Colour Legend for Belden Cable 9842 :

1 - BU/WH [GND]
2 - WH/BL [available]
3 - OR/WH [B]
4 - WH/OR [A]
SHD - [Shield]

109 BK 1x1.5 | 110 BK 1x1.5 | 111 BK 1x1.5
Y1-11/20 BK 1x1.5 | Y1-12/21 BK 1x1.5 | Y1-13/22 BK 1x1.5
20 X1 | 21 | 22
Y1 11 I/T | 12 I/T | 13 I/T

112 BK 1x1.5 | 113 BK 1x1.5 | 114 BK 1x1.5
23 X1 | 24 X1 | 25 X1

DRAWER
040.5B 3 230V-50Hz
040.5D 4
33 | 34
KA6 A1 A2 | KA7 A1 A2
CONTACTOR CLOSE COMMAND
CONTACTOR OPEN COMMAND

KA6 039.5B
KA7 039.5C
11 12 14 21 22 24 31 32 34 41 42 44

ROSETTI MARINO **RED LINE AS BUILT STAMP**

RLMU	✖ Yes ☐ No
Description	This document represents the final as-built version incorporating the latest approved information.
Reviewed & Confirmed by	Rosetti Marino S.P.A.
Signature /Date	Claudia Cianchi

Notes: Tick"Yes" only when the document reflects the final as-commissioned condition and the red-line mark-up (RLMU) has been incorporated without a new revision.
Tick "No" if the last approved revision already represents the final condition, with no redline markup required.

= TYPICAL
+ LK-x
DWG n° : 231298/SD/31
Item n° : PF1002983/26

REV.	DATE	DRN	CHKD	APPD	DESCRIPTION
2	18/09/2024	Santinelli	Flamminio	Sigismondi	As Built (ASB)
1	10/07/2024	Santinelli	Flamminio	Sigismondi	Accepted for Construction (AFC)
0	09/05/2024	Santinelli	Flamminio	Sigismondi	Issued for review (IFR)

ESA ENGINEERING
ROSETTI MARINO

TITLE : "SG-200N1"
LV SWG FUNCTIONAL DIAGRAMS - TYPICAL FEEDERS
Functional Drawing - Typical "LK1-n" & "LK2-n"


CONTRACT NO./TITLE CW-I-WP4-2023-05/HOLLANDSE KUST NOORD WIND PARK
SCALE : NTS
A3
DRAWING NO. 1723002197-EL-DG-00031
SHEET 042
REV. 02
F.to UNI A3: 420mmx297mm

File Name : 1723002197-EL-DG-00031 Rev. 02

SPECIFIC PARTS

TYPICAL : LINE FEEDER "LK1-n" "LK2-n"

AS-COMMISSIONED
DAVIDE ZUCCONELLI
NO MARK UP
21/03/2025

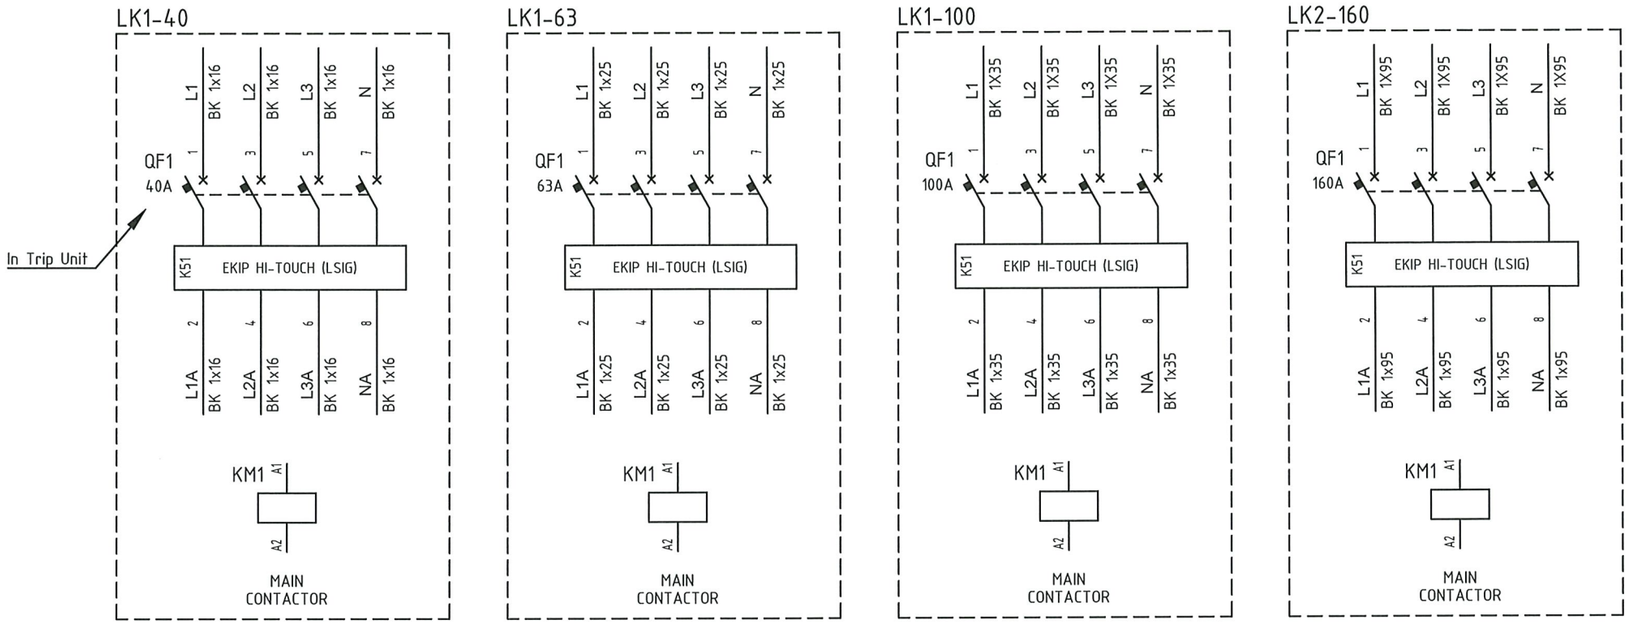

RED LINE AS BUILT STAMP

RLMU	✖ Yes ☐ No
Description	This document represents the final as-built version incorporating the latest approved information.
Reviewed & Confirmed by	Rosetti Marino S.P.A.
Signature /Date	

Notes: Tick"Yes" only when the document reflects the final as-commissioned condition and the red-line mark-up (RLMU) has been incorporated without a new revision.
Tick "No" if the last approved revision already represents the final condition, with no redline markup required.

ROSETTI MARINO

= TYPICAL
+ LK-x
DWG n° : 231298/SD/31
Item n° : PF1002983/26

REV.	DATE	DRN	CHKD	APPD	DESCRIPTION
2	18/09/2024	Santinelli	Flamminio	Sigismondi	As Built (ASB)
1	10/07/2024	Santinelli	Flamminio	Sigismondi	Accepted for Construction (AFC)
0	09/05/2024	Santinelli	Flamminio	Sigismondi	Issued for review (IFR)

TITLE : "SG-200N1"
LV SWG FUNCTIONAL DIAGRAMS - TYPICAL FEEDERS
Functional Drawing - Typical "LK1-n" & "LK2-n"

CONTRACT NO./TITLE CW-I-WP4-2023-05/HOLLANDSE KUST NOORD WIND PARK | SCALE : NTS

A3 | DRAWING NO. 1723002197-EL-DG-00031 | SHEET 043 | REV. 02

F.to UNI A3: 420mmx297mm

File Name : 1723002197-EL-DG-00031 Rev. 02

TYPICAL - LK-x - Y1

AUXILIARY SOCKET
136450/001 (PF – 2 pcs) + 136458/004 (PM – 2 pcs)

N° PIN	1	2	3	4	5	6	7	8	9	10	11	12	13	14	15	16	17	18	19	20	21	22	23	24	25	26	27	28	29	30	31	32	33	34	35	36	37	38	39	40	41	42	43	44
JUMP			●	●				●	●																																			
RACKED-OUT			X	X				X	X																																			
TEST								X	X	X	X	X	X	X	X	X	X	X	X	X	X	X								X	X	X	X	X	X	X	X	X	X	X	X	X	X	X
RACKED-IN					X	X	X	X	X	X	X	X	X	X	X	X	X	X	X	X	X	X					X	X	X	X	X	X	X	X	X	X	X	X	X	X	X	X	X	
PIN USED			042.5B	042.5B	042.4B			042.6B	042.7B	042.6B	042.5D	042.5D	042.6D	042.3B	042.4B	042.6B			038.6A	038.6A	039.9A	039.9A								041.3C	041.3C	041.4C	041.4C	041.6C	041.7C	042.7B	042.9B							

1	2	3	4	5	6	7	8	9	10	11	12	13	14	15	16	17	18	19	20	21	22	23	24	25	26	27	28	29	30	31	32	33	34	35	36	37	38	39	40	41	42	43	44

← FIELD WHIT "X" - CONTACT CLOSE WHEN DRAWER IS IN RACKED-OUT POSITION
← FIELD WHIT "X" - CONTACT CLOSE WHEN DRAWER IS IN TEST POSITION
← FIELD WHIT "X" - CONTACT CLOSE WHEN DRAWER IS IN RACKED-IN POSITION

← CROS-REFERENCE USED PIN

AS COMMISSIONED
DAVIDE ZUCCONELLI
NO MARK UP
21/03/2025

RED LINE AS BUILT STAMP

RLMU	✖Yes ☐ No
Description	This document represents the final as-built version incorporating the latest approved information.
Reviewed & Confirmed by	Rosetti Marino S.P.A.
Signature /Date	

Notes: Tick"Yes" only when the document reflects the final as-commissioned condition and the red-line mark-up (RLMU) has been incorporated without a new revision.
Tick "No" if the last approved revision already represents the final condition, with no redline markup required.

ROSETTI MARINO

=	TYPICAL
+	LK-x
DWG n° :	231298/SD/31
Item n° :	PF1002983/26

REV.	DATE	DRN	CHKD	APPD	DESCRIPTION
2	18/09/2024	Santinelli	Flamminio	Sigismondi	As Built (ASB)
1	10/07/2024	Santinelli	Flamminio	Sigismondi	Accepted for Construction (AFC)
0	09/05/2024	Santinelli	Flamminio	Sigismondi	Issued for review (IFR)

TITLE : "SG-200N1"
LV SWG FUNCTIONAL DIAGRAMS - TYPICAL FEEDERS
Functional Drawing - Typical "LK1-n" & "LK2-n"

CONTRACT NO./TITLE CW-I-WP4-2023-05/HOLLANDSE KUST NOORD WIND PARK | SCALE : NTS

A3 | DRAWING NO. 1723002197-EL-DG-00031 | SHEET 044 | REV. 02

F.to UNI A3: 420mmx297mm

File Name : 1723002197-EL-DG-00031 Rev. 02

TYPICAL - LK-x

X1

NumM	Fg.	Sez.	Tipo	Descrizione	Costruttore
			BT003	BT/3 End bracket	Cabur
1	038.5A	2.5	HD100GR_	HMD.2/GR Two-level feed-through Terminal Block - Grey (2.5 mmq) - Spring type	Cabur
2	038.6A	2.5	HD100GR_	HMD.2/GR Two-level feed-through Terminal Block - Grey (2.5 mmq) - Spring type	Cabur
3	038.6A	2.5	HD100GR_	HMD.2/GR Two-level feed-through Terminal Block - Grey (2.5 mmq) - Spring type	Cabur
4	038.6A	2.5	HD100GR_	HMD.2/GR Two-level feed-through Terminal Block - Grey (2.5 mmq) - Spring type	Cabur
5	041.3A	2.5	HD100GR_	HMD.2/GR Two-level feed-through Terminal Block - Grey (2.5 mmq) - Spring type	Cabur
6	041.3A	2.5	HD100GR_	HMD.2/GR Two-level feed-through Terminal Block - Grey (2.5 mmq) - Spring type	Cabur
7	041.4A	2.5	HD100GR_	HMD.2/GR Two-level feed-through Terminal Block - Grey (2.5 mmq) - Spring type	Cabur
8	041.4A	2.5	HD100GR_	HMD.2/GR Two-level feed-through Terminal Block - Grey (2.5 mmq) - Spring type	Cabur
			HD101GR	HMD/PT/GR End section - Grey	Cabur
9	042.3B	2.5	HD400GR_	HMD.2N/GR Two-level feed-through Terminal Block - Grey (2.5 mmq) - Spring type	Cabur
10	042.4B	2.5	HD400GR_	HMD.2N/GR Two-level feed-through Terminal Block - Grey (2.5 mmq) - Spring type	Cabur
11	042.4B	2.5	HD400GR_	HMD.2N/GR Two-level feed-through Terminal Block - Grey (2.5 mmq) - Spring type	Cabur
12	042.5B	2.5	HD400GR_	HMD.2N/GR Two-level feed-through Terminal Block - Grey (2.5 mmq) - Spring type	Cabur
13	042.6B	2.5	HD400GR_	HMD.2N/GR Two-level feed-through Terminal Block - Grey (2.5 mmq) - Spring type	Cabur
14	042.7B	2.5	HD400GR_	HMD.2N/GR Two-level feed-through Terminal Block - Grey (2.5 mmq) - Spring type	Cabur
15	042.7B	2.5	HD400GR_	HMD.2N/GR Two-level feed-through Terminal Block - Grey (2.5 mmq) - Spring type	Cabur
16	042.7B	2.5	HD400GR_	HMD.2N/GR Two-level feed-through Terminal Block - Grey (2.5 mmq) - Spring type	Cabur
17	042.8B	2.5	HD400GR_	HMD.2N/GR Two-level feed-through Terminal Block - Grey (2.5 mmq) - Spring type	Cabur
18	042.8B	2.5	HD400GR_	HMD.2N/GR Two-level feed-through Terminal Block - Grey (2.5 mmq) - Spring type	Cabur
19	042.9B	2.5	HD400GR_	HMD.2N/GR Two-level feed-through Terminal Block - Grey (2.5 mmq) - Spring type	Cabur
20	042.5C	2.5	HD400GR_	HMD.2N/GR Two-level feed-through Terminal Block - Grey (2.5 mmq) - Spring type	Cabur
21	042.5C	2.5	HD400GR_	HMD.2N/GR Two-level feed-through Terminal Block - Grey (2.5 mmq) - Spring type	Cabur
22	042.6C	2.5	HD400GR_	HMD.2N/GR Two-level feed-through Terminal Block - Grey (2.5 mmq) - Spring type	Cabur
23	042.9C	2.5	HD400GR_	HMD.2N/GR Two-level feed-through Terminal Block - Grey (2.5 mmq) - Spring type	Cabur
24	042.9C	2.5	HD400GR_	HMD.2N/GR Two-level feed-through Terminal Block - Grey (2.5 mmq) - Spring type	Cabur
25	042.10C	2.5	HD400GR_	HMD.2N/GR Two-level feed-through Terminal Block - Grey (2.5 mmq) - Spring type	Cabur
			HD201GR	HMD.1/PT/GR End section - Grey	Cabur
			BT003	BT/3 End bracket	Cabur

AS-COMMISSIONED
DAVIDE ZUCCHELLI
NO MARK UP
21/03/2025

ROSETTI MARINO — RED LINE AS BUILT STAMP

RLMU	✖ Yes ☐ No
Description	This document represents the final as-built version incorporating the latest approved information.
Reviewed & Confirmed by	Rosetti Marino S.P.A.
Signature /Date	

Notes: Tick"Yes" only when the document reflects the final as-commissioned condition and the red-line mark-up (RLMU) has been incorporated without a new revision.
Tick "No" if the last approved revision already represents the final condition, with no redline markup required.

= TYPICAL
\+ LK-x

DWG n° : 231298/SD/31
Item n° : PF1002983/26

ROSETTI MARINO

REV.	DATE	DRN	CHKD	APPD	DESCRIPTION
2	18/09/2024	Santinelli	Flamminio	Sigismondi	As Built (ASB)
1	10/07/2024	Santinelli	Flamminio	Sigismondi	Accepted for Construction (AFC)
0	09/05/2024	Santinelli	Flamminio	Sigismondi	Issued for review (IFR)

TITLE : "SG-200N1"
LV SWG FUNCTIONAL DIAGRAMS - TYPICAL FEEDERS
Functional Drawing - Typical "LK1-n" & "LK2-n"

CONTRACT NO./TITLE CW-I-WP4-2023-05/HOLLANDSE KUST NOORD WIND PARK | SCALE : NTS

A3 | DRAWING NO. 1723002197-EL-DG-00031 | SHEET 045 | REV. 02

F.to UNI A3: 420mmx297mm

File Name : 1723002197-EL-DG-00031 Rev. 02

Nome/Item	Fg/Sh	Tipo/Type	Q.ta/Q.ty	Descrizione/Description	Costruttore/Manufacturer	Quadro (descrizione)
HL1	040	ML22/484L230STLTTR	1	MULTILED 48x48 - 4 LED - Vaux=230Vac/dc + LAMP TEST + TROP	DOMO	TYPICAL LK-x
KA1	039	ER 592 6	1	CR-M230AC4L SUPPLY 230VAC 4C/O 250V/6A LED	ABB	TYPICAL LK-x
		ER 609 8	1	CR-MH HOLDER FOR CR-M RELAY	ABB	TYPICAL LK-x
		ER 686 6	1	CR-M4SS SOCKET STANDARD X 2/4 C/O(CR-M)	ABB	TYPICAL LK-x
KA2	039	ER 592 6	1	CR-M230AC4L SUPPLY 230VAC 4C/O 250V/6A LED	ABB	TYPICAL LK-x
		ER 609 8	1	CR-MH HOLDER FOR CR-M RELAY	ABB	TYPICAL LK-x
		ER 686 6	1	CR-M4SS SOCKET STANDARD X 2/4 C/O(CR-M)	ABB	TYPICAL LK-x
KA3	039	ER 592 6	1	CR-M230AC4L SUPPLY 230VAC 4C/O 250V/6A LED	ABB	TYPICAL LK-x
		ER 609 8	1	CR-MH HOLDER FOR CR-M RELAY	ABB	TYPICAL LK-x
		ER 686 6	1	CR-M4SS SOCKET STANDARD X 2/4 C/O(CR-M)	ABB	TYPICAL LK-x
KA4	039	ER 592 6	1	CR-M230AC4L SUPPLY 230VAC 4C/O 250V/6A LED	ABB	TYPICAL LK-x
		ER 609 8	1	CR-MH HOLDER FOR CR-M RELAY	ABB	TYPICAL LK-x
		ER 686 6	1	CR-M4SS SOCKET STANDARD X 2/4 C/O(CR-M)	ABB	TYPICAL LK-x
KA5	039	ER 592 6	1	CR-M230AC4L SUPPLY 230VAC 4C/O 250V/6A LED	ABB	TYPICAL LK-x
		ER 609 8	1	CR-MH HOLDER FOR CR-M RELAY	ABB	TYPICAL LK-x
		ER 686 6	1	CR-M4SS SOCKET STANDARD X 2/4 C/O(CR-M)	ABB	TYPICAL LK-x
KA6	042	ER 592 6	1	CR-M230AC4L SUPPLY 230VAC 4C/O 250V/6A LED	ABB	TYPICAL LK-x
		ER 609 8	1	CR-MH HOLDER FOR CR-M RELAY	ABB	TYPICAL LK-x
		ER 686 6	1	CR-M4SS SOCKET STANDARD X 2/4 C/O(CR-M)	ABB	TYPICAL LK-x
KA7	042	ER 592 6	1	CR-M230AC4L SUPPLY 230VAC 4C/O 250V/6A LED	ABB	TYPICAL LK-x
		ER 609 8	1	CR-MH HOLDER FOR CR-M RELAY	ABB	TYPICAL LK-x
		ER 686 6	1	CR-M4SS SOCKET STANDARD X 2/4 C/O(CR-M)	ABB	TYPICAL LK-x
PA1	039	KW 075 2	1	MP1-10R PUSH BUTTON RED WITH BLACK RING	ABB	TYPICAL LK-x
		EO 569 7	1	MCBH-00 FIXING SUPPORT 3 CONTACTS	ABB	TYPICAL LK-x
		EO 571 3	2	MCB-01 CONTACT NC FOR PUSHBUTTOM	ABB	TYPICAL LK-x
PM1	039	KW 076 0	1	MP1-10G PUSH BUTTON GREEN WITH BLACK RING	ABB	TYPICAL LK-x
		EO 569 7	1	MCBH-00 FIXING SUPPORT 3 CONTACTS	ABB	TYPICAL LK-x
		EO 570 5	2	MCB-10 CONTACT NO FOR PUSHBUTTONS	ABB	TYPICAL LK-x
QA1	038	S550239	1	S202M C 2 AUTOMATIC CIRCUIT BREAKER 10KA 2P	ABB	TYPICAL LK-x
		A563819	1	S2-CS/H6R AUXILIARY STATE CONTACT 1CO	ABB	TYPICAL LK-x
SA1	039	KW 329 3	1	M2SS2-10B HANDLE SELECTOR 2P 90° BLACK RING BLACK	ABB	TYPICAL LK-x
		EO 569 7	1	MCBH-00 FIXING SUPPORT 3 CONTACTS	ABB	TYPICAL LK-x
		EO 570 5	2	MCB-10 CONTACT NO FOR PUSHBUTTONS	ABB	TYPICAL LK-x
		EO 571 3	2	MCB-01 CONTACT NC FOR PUSHBUTTOM	ABB	TYPICAL LK-x
U1.2	041	1SDA074173R1	1	MODUL EKIP SUPPLY 24÷48VDC	ABB	TYPICAL LK-x
U1.3	041	1SDA105166R1	1	Module Ekip Com Modbus RS485 Tmax XT	ABB	TYPICAL LK-x
U1.A	041	1SDA105203R1	1	EKIP CARTRIDGE 2SLOT FOR XT2-XT4-XT5	ABB	TYPICAL LK-x
U2.A	042	Z-PC-DINAL2-17.5	1	DIN RAIL 2SLOT WITH HEAD FOR "Z-5DI-2DO"	SENECA	TYPICAL LK-x
U2.B	042	Z-5DI-2DO	1	I/O MODUL 5DI+2DO modbus RS485 Vaux=10÷40Vdc 19÷28Vac	SENECA	TYPICAL LK-x
U2.C	042	Z-5DI-2DO	1	I/O MODUL 5DI+2DO modbus RS485 Vaux=10÷40Vdc 19÷28Vac	SENECA	TYPICAL LK-x
X1		HD100GR_	8	HMD.2/GR Two-level feed-through Terminal Block - Grey (2.5 mmq) - Spring type	Cabur	TYPICAL LK-x
		HD400GR_	17	HMD.2N/GR Two-level feed-through Terminal Block - Grey (2.5 mmq) - Spring type	Cabur	TYPICAL LK-x
			2	BT/3 End bracket	Cabur	TYPICAL LK-x
			1	HMD/PT/GR End section - Grey	Cabur	TYPICAL LK-x

ROSETTI MARINO RED LINE AS BUILT STAMP

RLMU	✖ Yes ☐ No
Description	This document represents the final as-built version incorporating the latest approved information.
Reviewed & Confirmed by	Rosetti Marino S.P.A.
Signature /Date	

Notes: Tick"Yes" only when the document reflects the final as-commissioned condition and the red-line mark-up (RLMU) has been incorporated without a new revision.
Tick "No" if the last approved revision already represents the final condition, with no redline markup required.

=	TYPICAL
+	LK-x
DWG n° :	231298/SD/31
Item n° :	PF1002983/26

ENGINEERING

ROSETTI MARINO

REV.	DATE	DRN	CHKD	APPD	DESCRIPTION
2	18/09/2024	Santinelli	Flamminio	Sigismondi	As Built (ASB)
1	10/07/2024	Santinelli	Flamminio	Sigismondi	Accepted for Construction (AFC)
0	09/05/2024	Santinelli	Flamminio	Sigismondi	Issued for review (IFR)

DE ZUCCONELLI NO MARK UP 21/03/2025

TITLE : "SG-200N1"

LV SWG FUNCTIONAL DIAGRAMS - TYPICAL FEEDERS

Functional Drawing - Typical "LK1-n" & "LK2-n"

CONTRACT NO./TITLE CW-I-WP4-2023-05/HOLLANDSE KUST NOORD WIND PARK | SCALE : NTS

A3 | DRAWING NO. 1723002197-EL-DG-00031 | SHEET 046 | REV. 02

File Name : 1723002197-EL-DG-00031 Rev. 02

Foto UNI A3: 420mmx297mm

Nome/Item	Fg/Sh	Tipo/Type	Q.ta/Q.ty	Descrizione/Description	Costruttore/Manufacturer	Quadro (descrizione)
X1		HD201GR	1	HMD.1/PT/GR End section - Grey	Cabur	TYPICAL LK-x

AS-COMMISSIONED
DAVIDE ZUCCOMELLI

NO MARK UP
21/03/2025

Nome/Item	Fg/Sh	Tipo/Type	Q.ta/Q.ty	Descrizione/Description	Costruttore/Manufacturer	Quadro (descrizione)
KM1	043	AF40400013	1	AF40-40-00-13 CONTACTOR 4P 40A 100-250VAC/DC	ABB	TYPICAL LK1-40
		CA440E	1	CA4-40E AUXILIARY FRONT CONTACT 4NO	ABB	TYPICAL LK1-40
QF1	043	1SDA068169R1	1	XT2S 160 BREAKING PART 4p F F	ABB	TYPICAL LK1-40
		1SDA100162R1	1	ELECTRONIC TRIP RELEASE Ekip Hi-Touch LSIG In=40A XT2 4p	ABB	TYPICAL LK1-40
		1SDA066431R1	1	AUX-C 1Q+1SY 250Vac/dc XT1..XT5 F/P	ABB	TYPICAL LK1-40

Nome/Item	Fg/Sh	Tipo/Type	Q.ta/Q.ty	Descrizione/Description	Costruttore/Manufacturer	Quadro (descrizione)
KM1	043	AF52400013	1	AF52-30-00-13 CONTACTOR 4P 53A(AC3) 100-250VAC/DC	ABB	TYPICAL LK1-63
		CA440E	1	CA4-40E AUXILIARY FRONT CONTACT 4NO	ABB	TYPICAL LK1-63
QF1	043	1SDA068169R1	1	XT2S 160 BREAKING PART 4p F F	ABB	TYPICAL LK1-63
		1SDA100163R1	1	ELECTRONIC TRIP RELEASE Ekip Hi-Touch LSIG In=63A XT2 4p	ABB	TYPICAL LK1-63
		1SDA066431R1	1	AUX-C 1Q+1SY 250Vac/dc XT1..XT5 F/P	ABB	TYPICAL LK1-63

Nome/Item	Fg/Sh	Tipo/Type	Q.ta/Q.ty	Descrizione/Description	Costruttore/Manufacturer	Quadro (descrizione)
KM1	043	AF80400013	1	AF80-30-00-13 CONTACTOR 4P 80A(AC3) 100-250VAC/DC	ABB	TYPICAL LK1-100
		CA440E	1	CA4-40E AUXILIARY FRONT CONTACT 4NO	ABB	TYPICAL LK1-100
QF1	043	1SDA068169R1	1	XT2S 160 BREAKING PART 4p F F	ABB	TYPICAL LK1-100
		1SDA100164R1	1	ELECTRONIC TRIP RELEASE Ekip Hi-Touch LSIG In=100A XT2 4p	ABB	TYPICAL LK1-100
		1SDA066431R1	1	AUX-C 1Q+1SY 250Vac/dc XT1..XT5 F/P	ABB	TYPICAL LK1-100

Nome/Item	Fg/Sh	Tipo/Type	Q.ta/Q.ty	Descrizione/Description	Costruttore/Manufacturer	Quadro (descrizione)
KM1	043	AF190401113	1	AF190-40-11-13 CONT 4P 190A AC3 100-250VAC/DC	ABB	TYPICAL LK2-160
		CAL1911	1	CAL19-11 CONTATTO AUSILIARIO 1NA+1NC PER AF116÷AF370	ABB	TYPICAL LK2-160
		CAL1911B	2	CAL19-11B AUXILIARY CONTACT 1NA+1NC PER AF116÷AF370	ABB	TYPICAL LK2-160
QF1	043	1SDA068179R1	1	XT4S 250 BREAKING PART 4p F F	ABB	TYPICAL LK2-160
		1SDA100334R1	1	ELECTRONIC TRIP RELEASE Ekip Hi-Touch LSIG In=160A XT4 4p	ABB	TYPICAL LK2-160
		1SDA066431R1	1	AUX-C 1Q+1SY 250Vac/dc XT1..XT5 F/P	ABB	TYPICAL LK2-160

ROSETTI MARINO **RED LINE AS BUILT STAMP**

RLMU	✖ Yes ☐ No
Description	This document represents the final as-built version incorporating the latest approved information.
Reviewed & Confirmed by	Rosetti Marino S.P.A.
Signature /Date	

Notes: Tick"Yes" only when the document reflects the final as-commissioned condition and the red-line mark-up (RLMU) has been incorporated without a new revision.
Tick "No" if the last approved revision already represents the final condition, with no redline markup required.

=	TYPICAL
+	LK-x
DWG n° :	231298/SD/31
Item n° :	PF1002983/26

ESA ENGINEERING

ROSETTI MARINO

REV.	DATE	DRN	CHKD	APPD	DESCRIPTION
2	18/09/2024	Santinelli	Flamminio	Sigismondi	As Built (ASB)
1	10/07/2024	Santinelli	Flamminio	Sigismondi	Accepted for Construction (AFC)
0	09/05/2024	Santinelli	Flamminio	Sigismondi	Issued for review (IFR)

TITLE : "SG-200N1"

LV SWG FUNCTIONAL DIAGRAMS - TYPICAL FEEDERS

Functional Drawing - Typical "LK1-n" & "LK2-n"

CONTRACT NO./TITLE CW-I-WP4-2023-05/HOLLANDSE KUST NOORD WIND PARK | SCALE : NTS

A3	DRAWING NO.	SHEET	REV.
	1723002197-EL-DG-00031	047	02


F.to UNI A3: 420mmx297mm

File Name : 1723002197-EL-DG-00031 Rev. 02

DOOR FRONT LAY-OUT

TYPICAL : LINE FEEDER "LE2-320"

AS-COMMISSIONED
DAVIDE ZUCCONELLI
NO MARK UP
21/03/2025

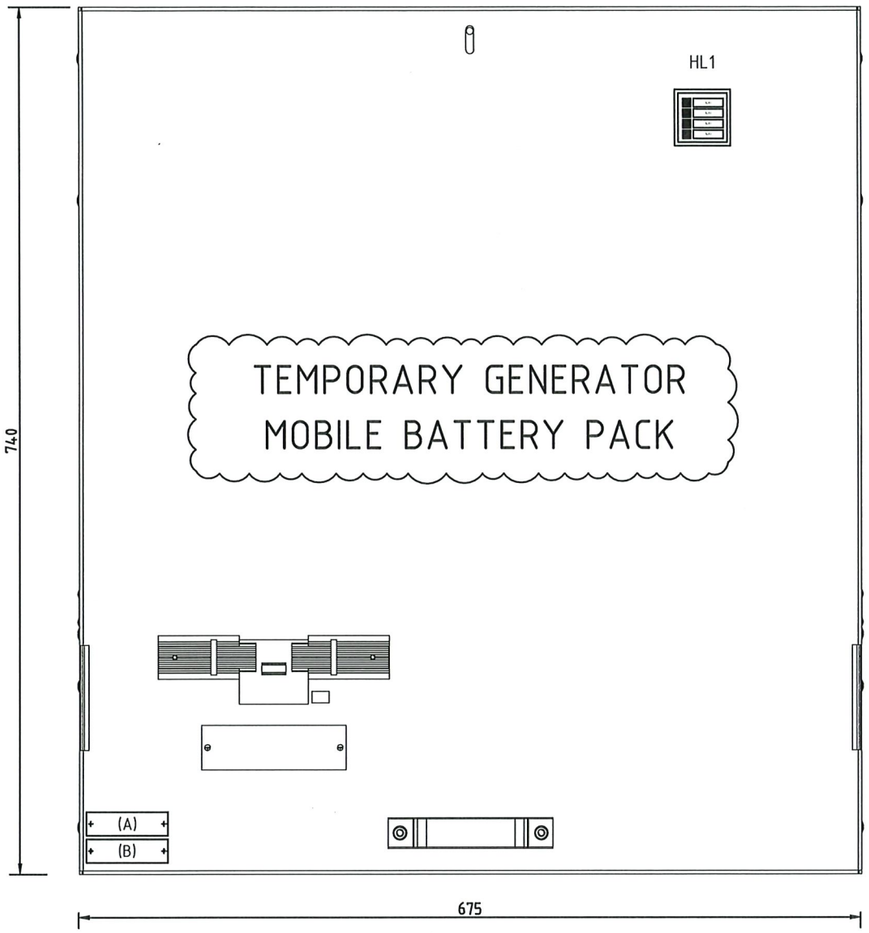



NOTE :


A) IDENTIFICATION name plate (type-1A) , with :
- Drawer position [Column / Position inside SWB]
- Typical name [reference applicability typical used]
- Power [reference applicability typical used]

B) USER name plate (type-1B), with :
- Item User [to see SLD diagrams]
- User Description [to see SLD diagrams]

DEVICES name plate			
ITEM	DESCRIPTION 1	DESCRIPTION 2	NOTE
QF1	Circuit Breaker		NO plate
HL1	Multiled	Signalling	NO plate

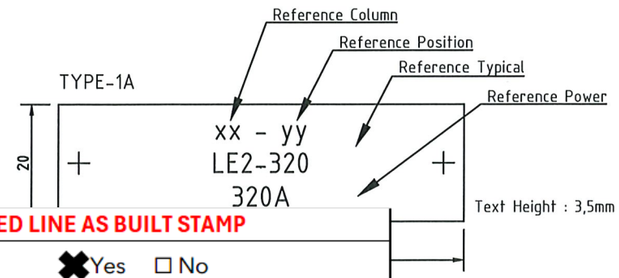

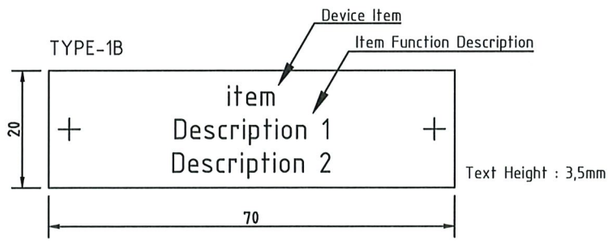

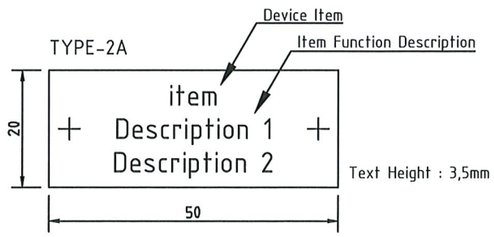

ROSETTI MARINO **RED LINE AS BUILT STAMP**

RLMU	✖ Yes ☐ No
Description	This document represents the final as-built version incorporating the latest approved information.
Reviewed & Confirmed by	Rosetti Marino S.P.A.
Signature /Date	

Notes: Tick"Yes" only when the document reflects the final as-commissioned condition and the red-line mark-up (RLMU) has been incorporated without a new revision.
Tick "No" if the last approved revision already represents the final condition, with no redline markup required.

=	TYPICAL
+	LE2-250
DWG n° :	231298/SD/31
Item n° :	PF1002983/26

ROSETTI MARINO

REV.	DATE	DRN	CHKD	APPD	DESCRIPTION
2	18/09/2024	Santinelli	Flamminio	Sigismondi	As Built (ASB)
1	10/07/2024	Santinelli	Flamminio	Sigismondi	Accepted for Construction (AFC)
0	09/05/2024	Santinelli	Flamminio	Sigismondi	Issued for review (IFR)

TITLE : "SG-200N1"
LV SWG FUNCTIONAL DIAGRAMS - TYPICAL FEEDERS
Door Front Lay-Out - Typical "LE2-320"

CONTRACT NO./TITLE CW-I-WP4-2023-05/HOLLANDSE KUST NOORD WIND PARK | SCALE : NTS

A3 | DRAWING NO. 1723002197-EL-DG-00031 | SHEET 048 | REV. 02

F.to UNI A3: 420mmx297mm

File Name : 1723002197-EL-DG-00031 Rev. 02

USERS LEGEND

TYPICAL : LINE FEEDER "LE2-320"

AS-COMMISSIONED
DAVIDE ZUCCONELLI
NO MARK UP
21/03/2025

TYPICAL APPLICABILITY					
ITEM	ITEM TAG	DESCRIPTION TAG	REFERENCE POSITION (written on name name plate "type-1A)	REFERENCE POWER (written on name name plate "type-1A)	REFERENCE TYPICAL (written on name name plate "type-1A)
1	JB-200E2	TEMPORARY GENERATOR / MOBILE BATTERY PACK	A2 / +08	138 kW	LE2-320

ROSETTI MARINO RED LINE AS BUILT STAMP

RLMU	✖Yes ☐ No
Description	This document represents the final as-built version incorporating the latest approved information.
Reviewed & Confirmed by	Rosetti Marino S.P.A.
Signature /Date	Claudia Cianchi

Notes: Tick"Yes" only when the document reflects the final as-commissioned condition and the red-line mark-up (RLMU) has been incorporated without a new revision.
Tick "No" if the last approved revision already represents the final condition, with no redline markup required.

= TYPICAL
\+ LE2-250

DWG n° : 231298/SD/31
Item n° : PF1002983/26

ROSETTI MARINO

REV.	DATE	DRN	CHKD	APPD	DESCRIPTION
2	18/09/2024	Santinelli	Flamminio	Sigismondi	As Built (ASB)
1	10/07/2024	Santinelli	Flamminio	Sigismondi	Accepted for Construction (AFC)
0	09/05/2024	Santinelli	Flamminio	Sigismondi	Issued for review (IFR)


TITLE : "SG-200N1"
LV SWG FUNCTIONAL DIAGRAMS - TYPICAL FEEDERS
Users Legend - Typical "LE2-320"

CONTRACT NO./TITLE CW-I-WP4-2023-05/HOLLANDSE KUST NOORD WIND PARK | SCALE : NTS

A3 | DRAWING NO. 1723002197-EL-DG-00031 | SHEET 049 | REV. 02

F.to UNI A3: 420mmx297mm

File Name : 1723002197-EL-DG-00031 Rev. 02

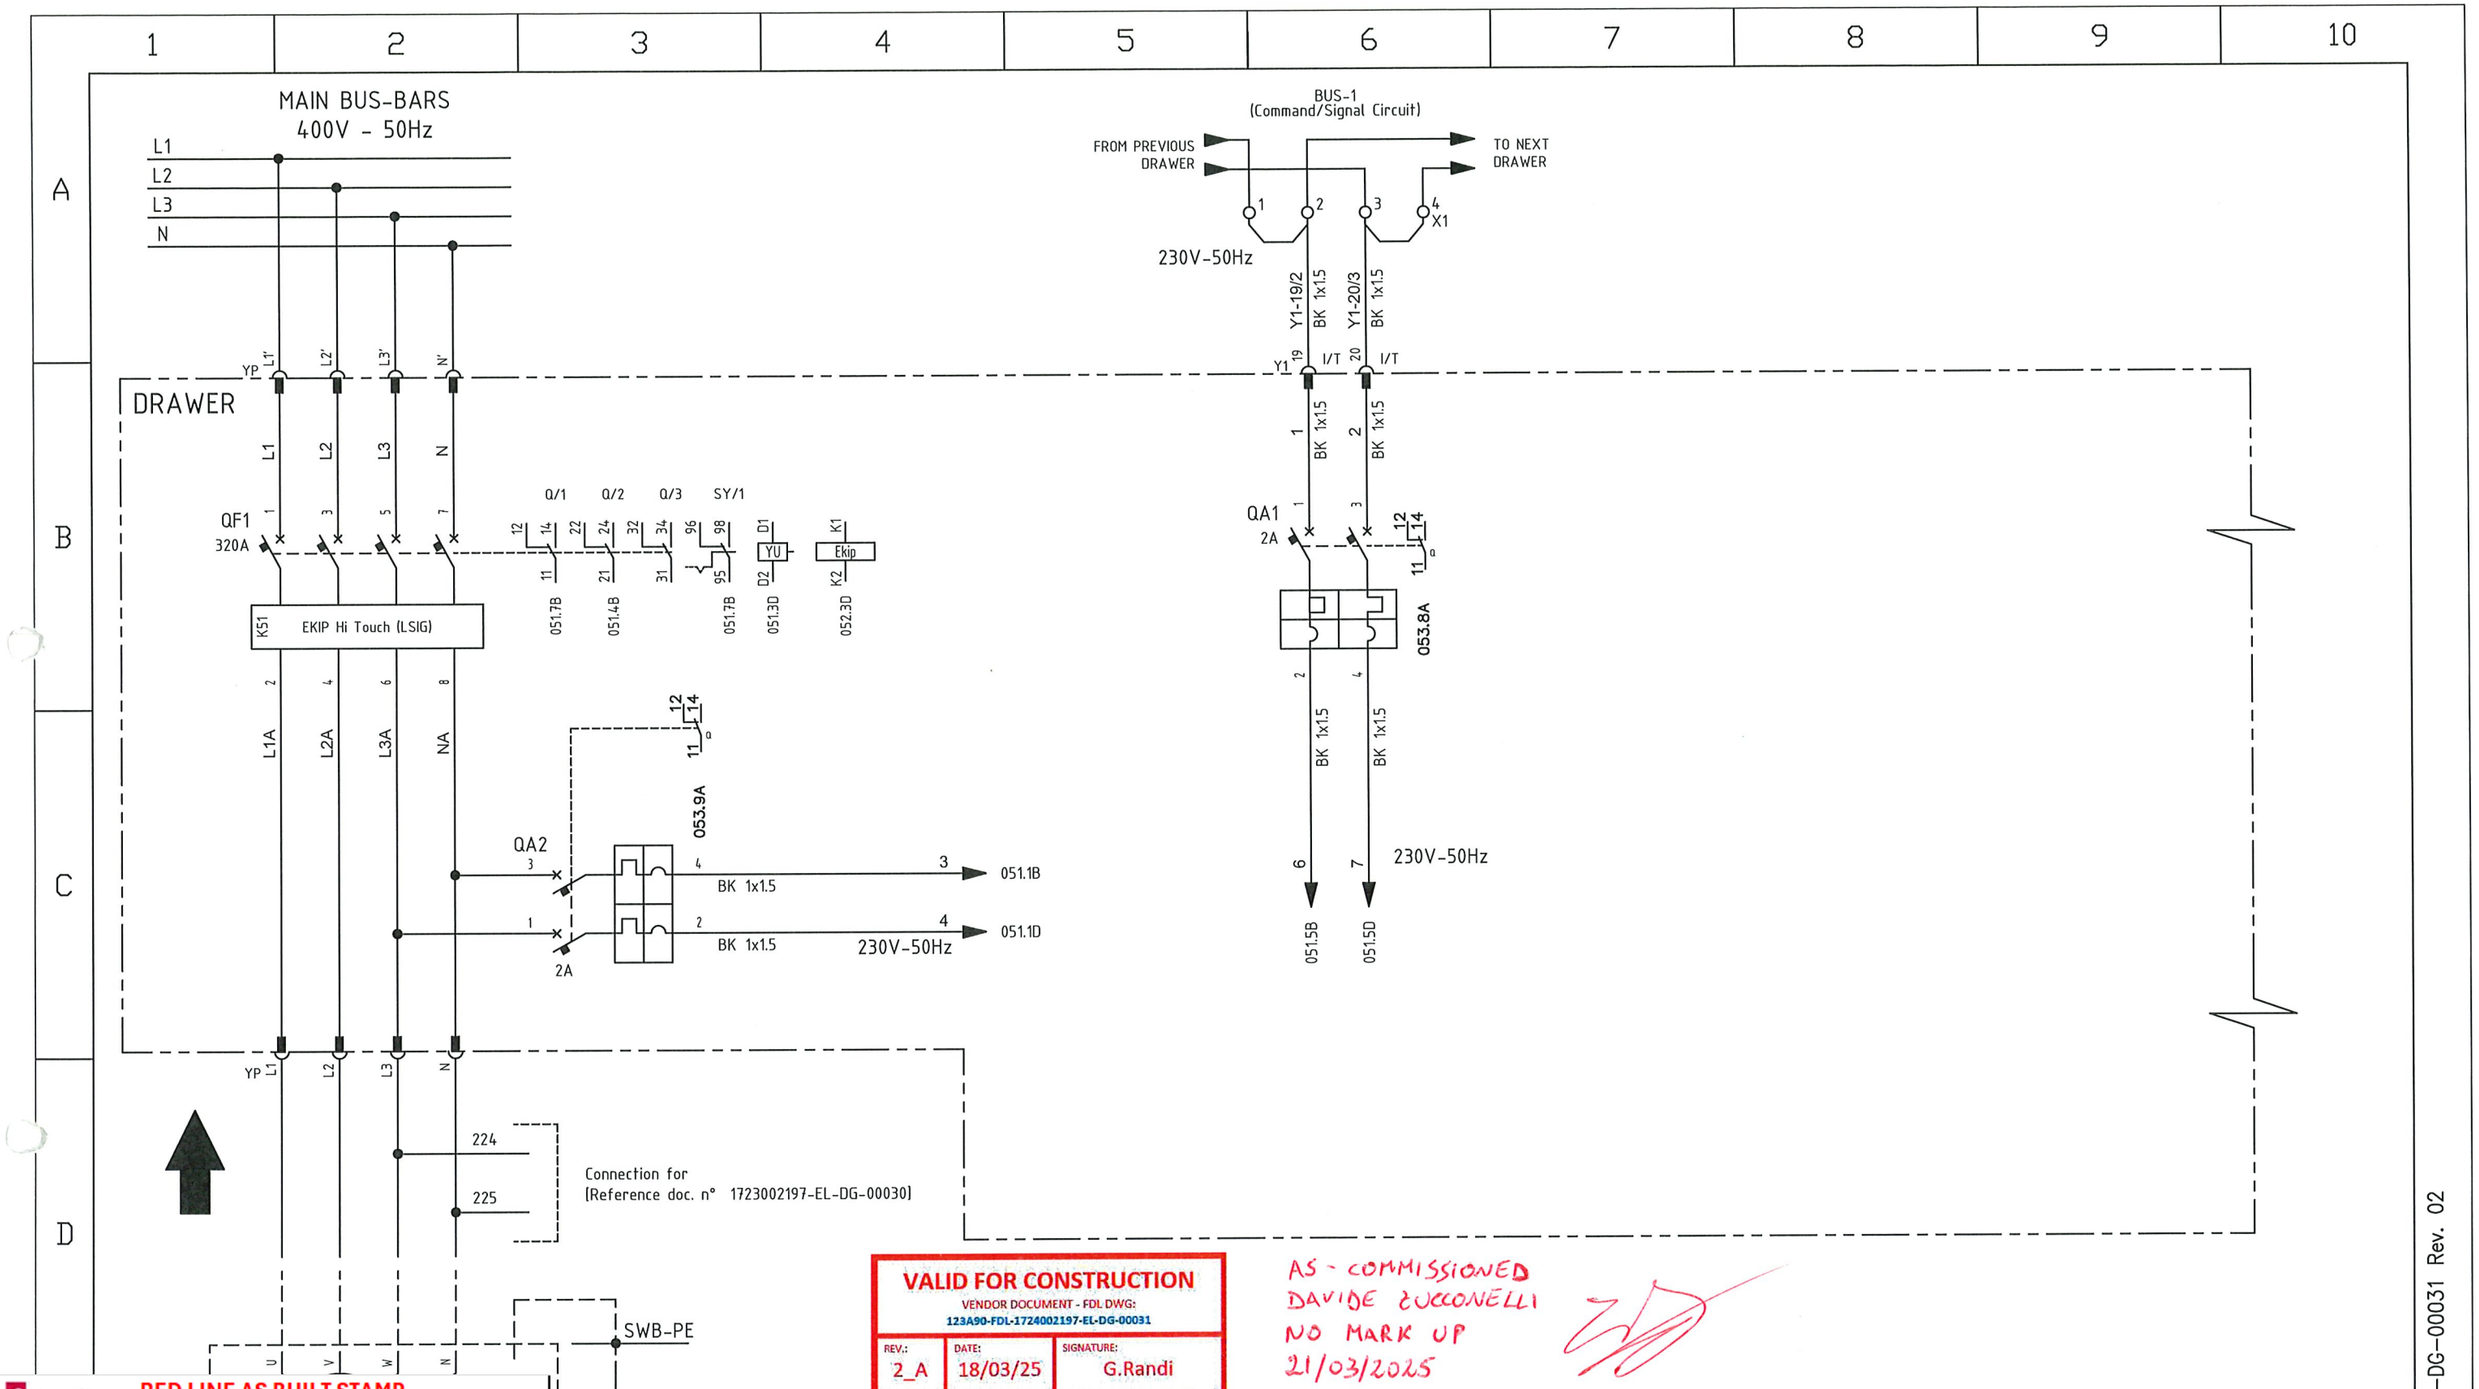

VALID FOR CONSTRUCTION
VENDOR DOCUMENT - FDL DWG:
123A90-FDL-1724002197-EL-DG-00031

REV.:	DATE:	SIGNATURE:
2_A	18/03/25	G.Randi

ROSETTI MARINO SpA

AS - COMMISSIONED
DAVIDE ZUCCONELLI
NO MARK UP
21/03/2025

ROSETTI MARINO RED LINE AS BUILT STAMP

RLMU	✖ Yes ☐ No
Description	This document represents the final as-built version incorporating the latest approved information.
Reviewed & Confirmed by	Rosetti Marino S.P.A.
Signature /Date	

Notes: Tick"Yes" only when the document reflects the final as-commissioned condition and the red-line mark-up (RLMU) has been incorporated without a new revision.
Tick "No" if the last approved revision already represents the final condition, with no redline markup required.

=	TYPICAL
+	LE2-250
DWG n° :	231298/SD/31
Item n° :	PF1002983/26

REV.	DATE	DRN	CHKD	APPD	DESCRIPTION
2	18/09/2024	Santinelli	Flamminio	Sigismondi	As Built (ASB)
1	10/07/2024	Santinelli	Flamminio	Sigismondi	Accepted for Construction (AFC)
0	09/05/2024	Santinelli	Flamminio	Sigismondi	Issued for review (IFR)

ROSETTI MARINO

TITLE : "SG-200N1"
LV SWG FUNCTIONAL DIAGRAMS - TYPICAL FEEDERS
Functional Drawing - Typical "LE2-320"

CONTRACT NO./TITLE	SCALE	
CW-I-WP4-2023-05/HOLLANDSE KUST NOORD WIND PARK	NTS	
A3	DRAWING NO. 1723002197-EL-DG-00031	SHEET 050 / REV. 02

F.to UNI A3: 420mmx297mm

File Name : 1723002197-EL-DG-00031 Rev. 02

AS-COMMISSIONED
DAVIDE ZUCCONELLI
NO MARK UP
21/03/2025

SG-200N1
INCOMING CIRCUIT-BREAKER
QG1
Q
5 X2
6 X2
230VAC
3 X2
4 X2
QG1
A1
YC
A2
CLOSING COIL

ONLY FOR REPRESENTATION
FOR DETTAILS TO SEE RELEVANT
DOCUMENT N°1723002197-EL-DG-00030

9 X1
10 X1
11 X1
12 X1
13 X1
14 X1
Y1-17/9 BK 1x1.5
Y1-18/12 BK 1x1.5
Y1-8/13 BK 1x1.5
Y1-9/14 BK 1x1.5
Y1 17 I/T
18 I/T
8 I/T
9 I/T
44 T 43 I/T
22 T 21 I/T

050.4C 3 230V-50Hz
8 BK 1x1.5
9 BK 1x1.5
QF1 050.1B
22 24 Q 21

PERMESSIVE TO CLOSE
WITH DRAWER ON
TEST/RACK-OUT POSITION
OR C.B. OPEN

050.6C 6 230V-50Hz
QF1 050.1B 12 14 Q 11
QF1 050.1B 96 98 SY 95
KA2 051.7D 11 12 14
KA3 051.7D 12 14 11

5 BK 1x1.5
10 BK 1x1.5
11 BK 1x1.5
12 BK 1x1.5
13 BK 1x1.5
14 BK 1x1.5
15 BK 1x1.5

QF1 050.1B D1 YU D2

HL1 230VAC
1 2 3 4
L1 GR
L2 RD
L3 AM
CIRCUIT BREAKER OPEN
CIRCUIT BREAKER CLOSE
FEEDER TRIPPED

050.4C 4
050.6C 7

KA1 A1 A2 DRAWER ON TEST
KA2 A1 A2 C.B. OPEN/CLOSED
KA3 A1 A2 C.B. TRIPPED

053.7A 11 12 14 22 21 24 32 31 34 42 41 44
051.9B 11 12 14 22
053.6A 21 24 32 31 34 42 41 44
051.9B 11 12 14 22
053.7A 21 24 32 31 34 42 41 44

ROSETTI MARINO **RED LINE AS BUILT STAMP**

RLMU	✖ Yes ☐ No
Description	This document represents the final as-built version incorporating the latest approved information.
Reviewed & Confirmed by	Rosetti Marino S.P.A.
Signature /Date	

Notes: Tick"Yes" only when the document reflects the final as-commissioned condition and the red-line mark-up (RLMU) has been incorporated without a new revision.
Tick "No" if the last approved revision already represents the final condition, with no redline markup required.

=	TYPICAL
+	LE2-250
DWG n° :	231298/SD/31
Item n° :	PF1002983/26

REV.	DATE	DRN	CHKD	APPD	DESCRIPTION
2	18/09/2024	Santinelli	Flamminio	Sigismondi	As Built (ASB)
1	10/07/2024	Santinelli	Flamminio	Sigismondi	Accepted for Construction (AFC)
0	09/05/2024	Santinelli	Flamminio	Sigismondi	Issued for review (IFR)

ROSETTI MARINO

TITLE : "SG-200N1"
LV SWG FUNCTIONAL DIAGRAMS - TYPICAL FEEDERS
Functional Drawing - Typical "LE2-320"


CONTRACT NO./TITLE CW-I-WP4-2023-05/HOLLANDSE KUST NOORD WIND PARK
SCALE : NTS

A3
DRAWING NO. 1723002197-EL-DG-00031
SHEET 051
REV. 02

F.to UNI A3: 420mmx297mm

File Name : 1723002197-EL-DG-00031 Rev. 02

AS - COMMISSIONED
DAVIDE ZUCCONELLI
NO MARK UP
21/03/2025

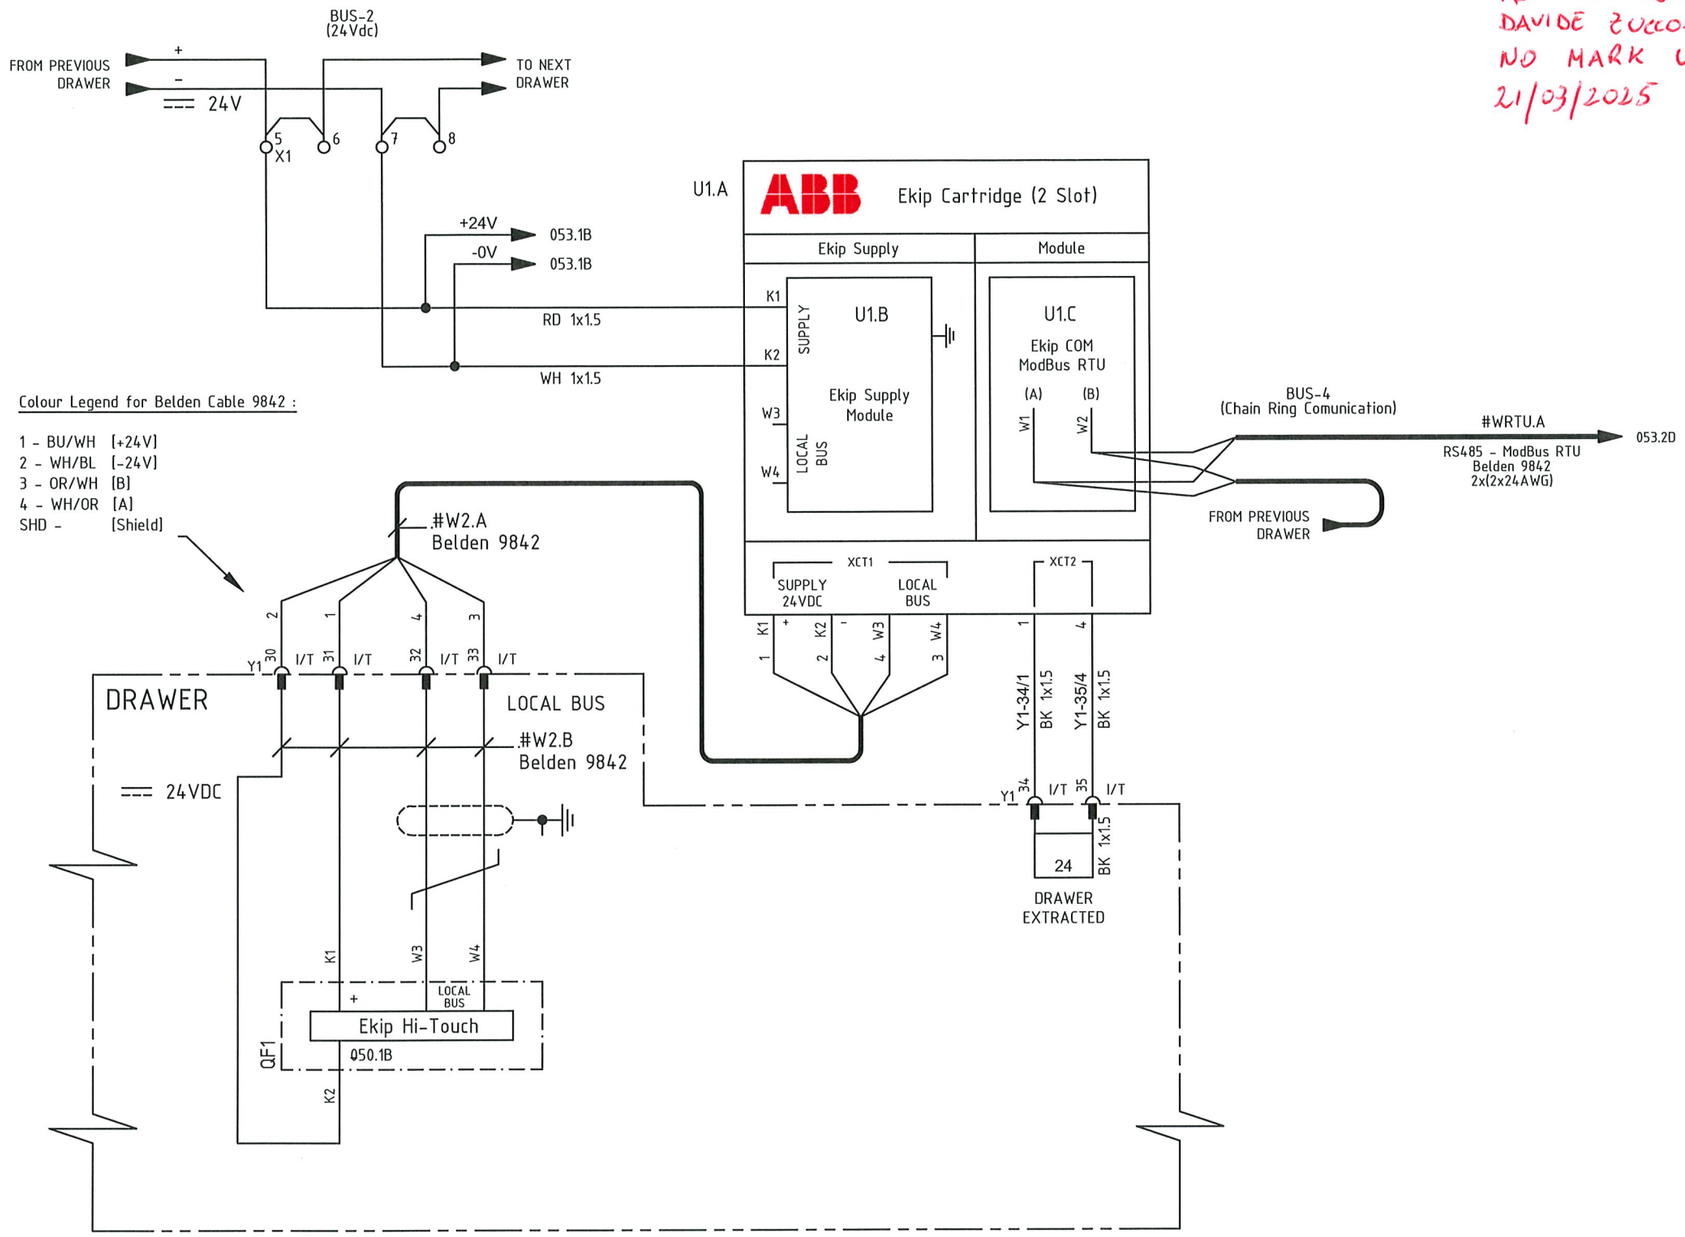

RED LINE AS BUILT STAMP	
RLMU	✖ Yes ☐ No
Description	This document represents the final as-built version incorporating the latest approved information.
Reviewed & Confirmed by	Rosetti Marino S.P.A.
Signature /Date	

Notes: Tick"Yes" only when the document reflects the final as-commissioned condition and the red-line mark-up (RLMU) has been incorporated without a new revision.
Tick "No" if the last approved revision already represents the final condition, with no redline markup required.

=	TYPICAL						
+	LE2-250						
DWG n° :	231298/SD/31						
Item n° :	PF1002983/26						
		2	18/09/2024	Santinelli	Flamminio	Sigismondi	As Built (ASB)
		1	10/07/2024	Santinelli	Flamminio	Sigismondi	Accepted for Construction (AFC)
		0	09/05/2024	Santinelli	Flamminio	Sigismondi	Issued for review (IFR)
		REV.	DATE	DRN	CHKD	APPD	DESCRIPTION

ROSETTI MARINO

TITLE : "SG-200N1"
LV SWG FUNCTIONAL DIAGRAMS - TYPICAL FEEDERS
Functional Drawing - Typical "LE2-320"


CONTRACT NO./TITLE CW-I-WP4-2023-05/HOLLANDSE KUST NOORD WIND PARK | SCALE : NTS

A3 | DRAWING NO. 1723002197-EL-DG-00031 | SHEET 052 | REV. 02

F.to UNI A3: 420mmx297mm

File Name : 1723002197-EL-DG-00031 Rev. 02

AS-COMMISSIONED
NO MARK UP
21/03/2025

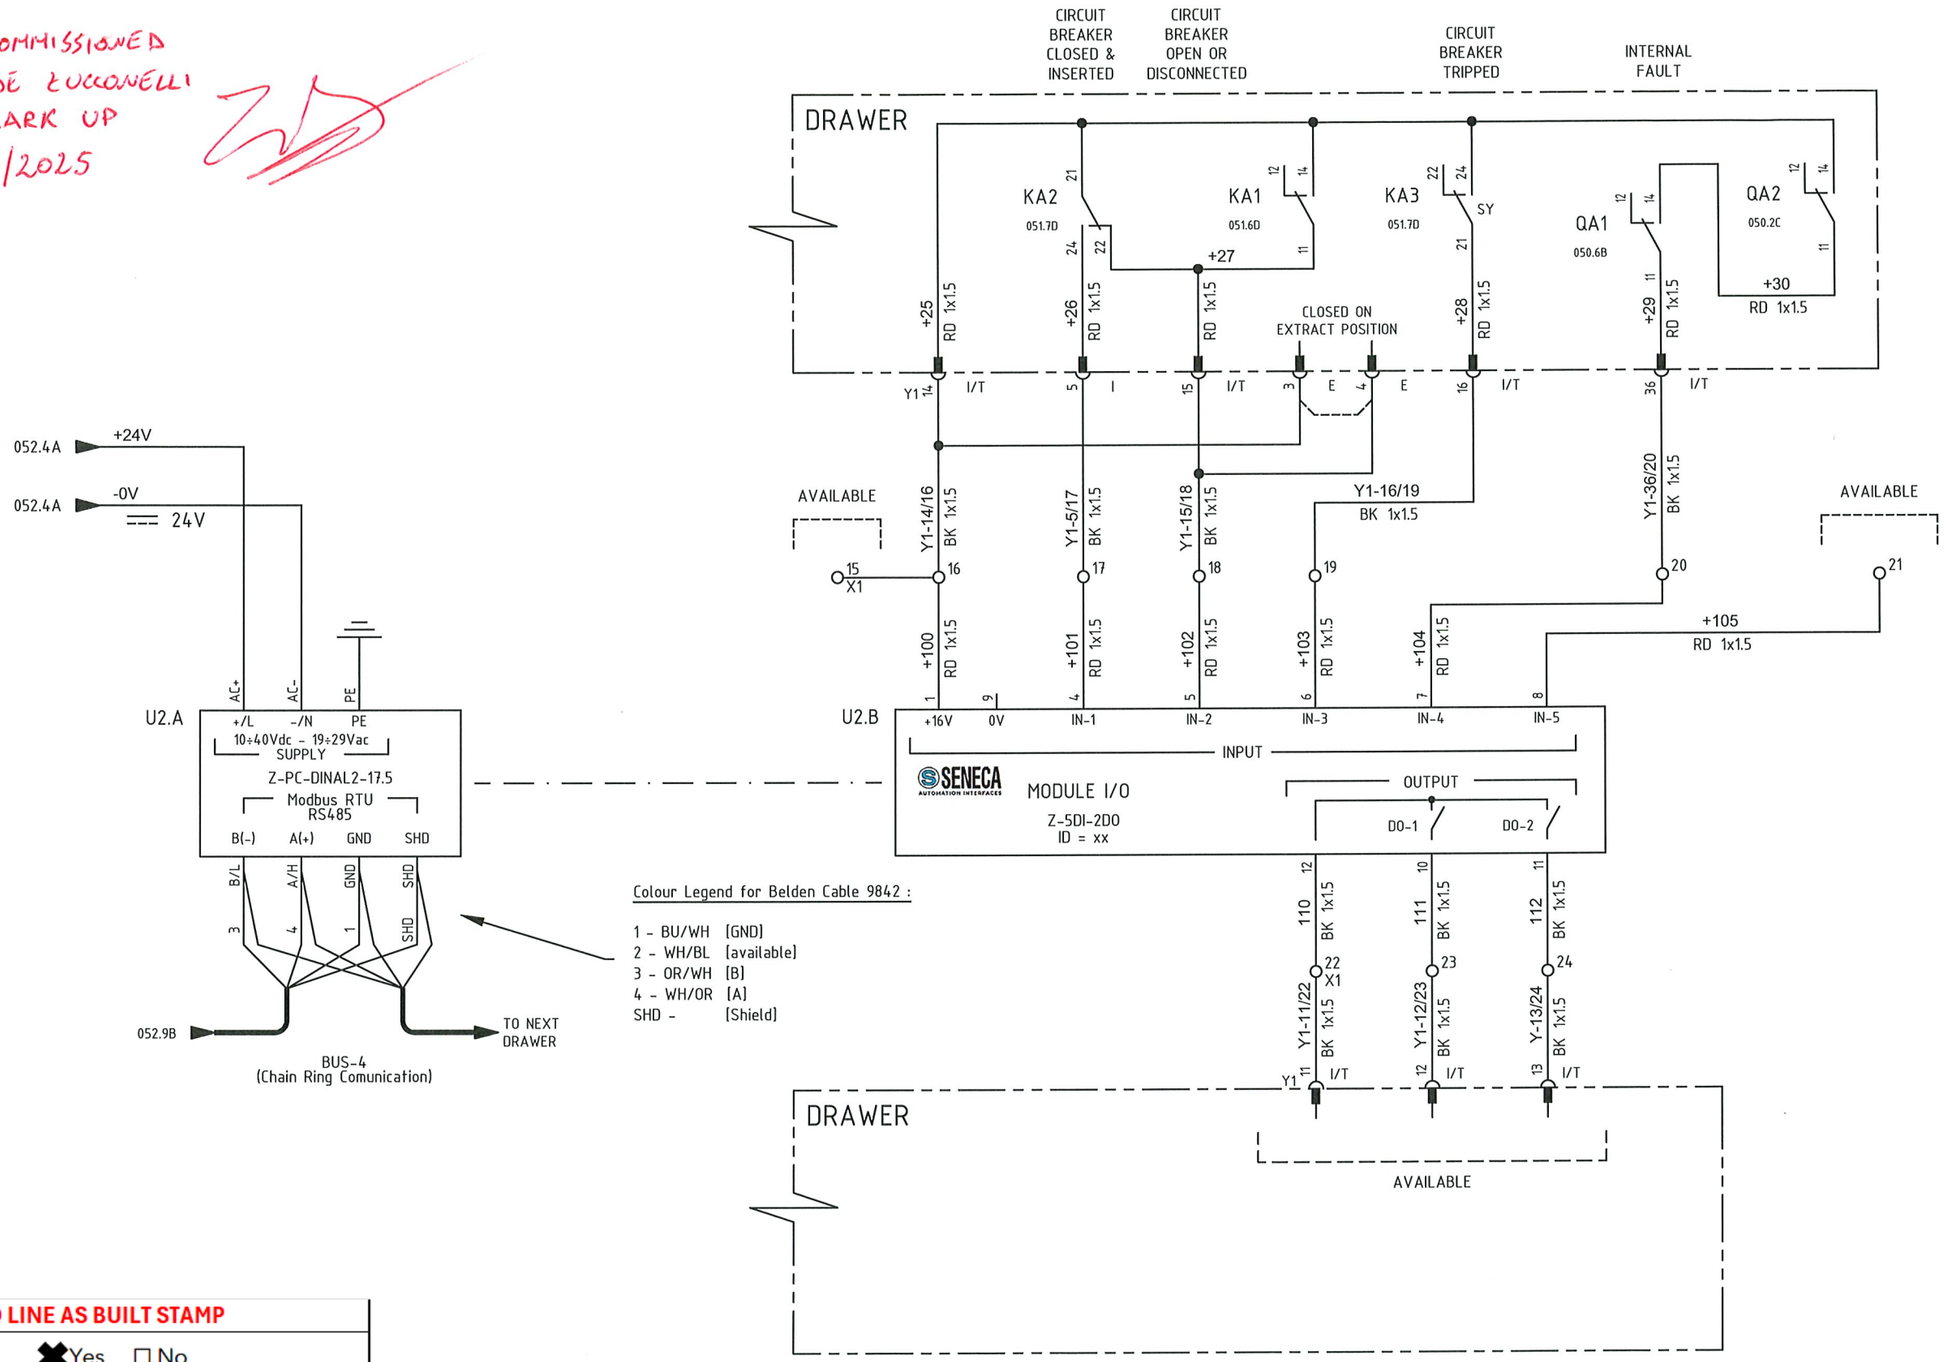

Colour Legend for Belden Cable 9842 :

1 - BU/WH [GND]
2 - WH/BL [available]
3 - OR/WH [B]
4 - WH/OR [A]
SHD - [Shield]

RED LINE AS BUILT STAMP

RLMU	✖ Yes ☐ No
Description	This document represents the final as-built version incorporating the latest approved information.
Reviewed & Confirmed by	Rosetti Marino S.P.A.
Signature /Date	

Notes: Tick"Yes" only when the document reflects the final as-commissioned condition and the red-line mark-up (RLMU) has been incorporated without a new revision.
Tick "No" if the last approved revision already represents the final condition, with no redline markup required.

=	TYPICAL
+	LE2-250
DWG n° :	231298/SD/31
Item n° :	PF1002983/26

REV.	DATE	DRN	CHKD	APPD	DESCRIPTION
2	18/09/2024	Santinelli	Flamminio	Sigismondi	As Built (ASB)
1	10/07/2024	Santinelli	Flamminio	Sigismondi	Accepted for Construction (AFC)
0	09/05/2024	Santinelli	Flamminio	Sigismondi	Issued for review (IFR)

ROSETTI MARINO

TITLE : "SG-200N1"

LV SWG FUNCTIONAL DIAGRAMS - TYPICAL FEEDERS

Functional Drawing - Typical "LE2-320"

CONTRACT NO./TITLE CW-I-WP4-2023-05/HOLLANDSE KUST NOORD WIND PARK

SCALE : NTS

A3

DRAWING NO. 1723002197-EL-DG-00031

SHEET 053

REV. 02


F.to UNI A3: 420mmx297mm

File Name : 1723002197-EL-DG-00031 Rev. 02

AUXILIARY SOCKET

136450/001 (PF – 2 pcs) + 136458/004 (PM – 2 pcs)

N° PIN	1	2	3	4	5	6	7	8	9	10	11	12	13	14	15	16	17	18	19	20	21	22	23	24	25	26	27	28	29	30	31	32	33	34	35	36	37	38	39	40	41	42	43	44
JUMP			●	●				●	●																																			
RACKED-OUT			X	X				X	X																																			
TEST								X	X	X	X	X	X	X	X	X	X	X	X	X	X	X								X	X	X	X	X	X	X	X	X	X	X	X	X	X	X
RACKED-IN					X	X	X	X	X	X	X	X	X	X	X	X	X	X	X	X	X	X					X	X	X	X	X	X	X	X	X	X	X	X	X	X	X	X	X	
PIN USED			053.6B	053.7B	053.6B			051.4B	053.8B		053.7D	053.7D	053.8D	053.5B	053.6B	053.7B	051.2B	051.3B	050.6A	050.6A	051.6B	051.6B								052.3C	052.3C	052.4C	052.4C	052.6C	052.7C							051.5B	051.4B	051.4B

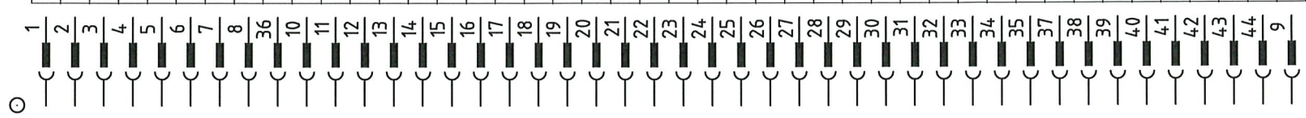

← FIELD WHIT "X" - CONTACT CLOSE WHEN DRAWER IS IN RACKED-OUT POSITION

← FIELD WHIT "X" - CONTACT CLOSE WHEN DRAWER IS IN TEST POSITION

← FIELD WHIT "X" - CONTACT CLOSE WHEN DRAWER IS IN RACKED-IN POSITION

← CROS-REFERENCE USED PIN

TYPICAL - LE2-320 - Y1

AS-COMMISSIONED
DAVIDE ZUCCONELLI
NO MARK UP
21/03/2025

ROSETTI MARINO RED LINE AS BUILT STAMP

RLMU	✖Yes ☐ No
Description	This document represents the final as-built version incorporating the latest approved information.
Reviewed & Confirmed by	Rosetti Marino S.P.A.
Signature /Date	

Notes: Tick"Yes" only when the document reflects the final as-commissioned condition and the red-line mark-up (RLMU) has been incorporated without a new revision.
Tick "No" if the last approved revision already represents the final condition, with no redline markup required.

=	TYPICAL
+	LE2-250
DWG n° :	231298/SD/31
Item n° :	PF1002983/26

REV.	DATE	DRN	CHKD	APPD	DESCRIPTION
2	18/09/2024	Santinelli	Flamminio	Sigismondi	As Built (ASB)
1	10/07/2024	Santinelli	Flamminio	Sigismondi	Accepted for Construction (AFC)
0	09/05/2024	Santinelli	Flamminio	Sigismondi	Issued for review (IFR)

ROSETTI MARINO

TITLE : "SG-200N1"

LV SWG FUNCTIONAL DIAGRAMS - TYPICAL FEEDERS

Functional Drawing - Typical "LE2-320"

CONTRACT NO./TITLE CW-I-WP4-2023-05/HOLLANDSE KUST NOORD WIND PARK

SCALE : NTS

A3

DRAWING NO. 1723002197-EL-DG-00031

SHEET 054

REV. 02

F.to UNI A3: 420mmx297mm

File Name : 1723002197-EL-DG-00031 Rev. 02

TYPICAL - LE2-320

X1

NumM	Fg.	Sez.	Tipo	Descrizione	Costruttore
			BT003	BT/3 End bracket	Cabur
1	050.5A	2.5	HD100GR_	HMD.2/GR Two-level feed-through Terminal Block - Grey (2.5 mmq) - Spring type	Cabur
2	050.6A	2.5	HD100GR_	HMD.2/GR Two-level feed-through Terminal Block - Grey (2.5 mmq) - Spring type	Cabur
3	050.6A	2.5	HD100GR_	HMD.2/GR Two-level feed-through Terminal Block - Grey (2.5 mmq) - Spring type	Cabur
4	050.6A	2.5	HD100GR_	HMD.2/GR Two-level feed-through Terminal Block - Grey (2.5 mmq) - Spring type	Cabur
5	052.3A	2.5	HD100GR_	HMD.2/GR Two-level feed-through Terminal Block - Grey (2.5 mmq) - Spring type	Cabur
6	052.3A	2.5	HD100GR_	HMD.2/GR Two-level feed-through Terminal Block - Grey (2.5 mmq) - Spring type	Cabur
7	052.4A	2.5	HD100GR_	HMD.2/GR Two-level feed-through Terminal Block - Grey (2.5 mmq) - Spring type	Cabur
8	052.4A	2.5	HD100GR_	HMD.2/GR Two-level feed-through Terminal Block - Grey (2.5 mmq) - Spring type	Cabur
			HD101GR	HMD/PT/GR End section - Grey	Cabur
9	051.2A	2.5	HD400GR_	HMD.2N/GR Two-level feed-through Terminal Block - Grey (2.5 mmq) - Spring type	Cabur
10	051.2A	2.5	HD400GR_	HMD.2N/GR Two-level feed-through Terminal Block - Grey (2.5 mmq) - Spring type	Cabur
11	051.3A	2.5	HD400GR_	HMD.2N/GR Two-level feed-through Terminal Block - Grey (2.5 mmq) - Spring type	Cabur
12	051.3A	2.5	HD400GR_	HMD.2N/GR Two-level feed-through Terminal Block - Grey (2.5 mmq) - Spring type	Cabur
13	051.4A	2.5	HD400GR_	HMD.2N/GR Two-level feed-through Terminal Block - Grey (2.5 mmq) - Spring type	Cabur
14	051.4A	2.5	HD400GR_	HMD.2N/GR Two-level feed-through Terminal Block - Grey (2.5 mmq) - Spring type	Cabur
15	053.4B	2.5	HD400GR_	HMD.2N/GR Two-level feed-through Terminal Block - Grey (2.5 mmq) - Spring type	Cabur
16	053.5B	2.5	HD400GR_	HMD.2N/GR Two-level feed-through Terminal Block - Grey (2.5 mmq) - Spring type	Cabur
17	053.6B	2.5	HD400GR_	HMD.2N/GR Two-level feed-through Terminal Block - Grey (2.5 mmq) - Spring type	Cabur
18	053.6B	2.5	HD400GR_	HMD.2N/GR Two-level feed-through Terminal Block - Grey (2.5 mmq) - Spring type	Cabur
19	053.7B	2.5	HD400GR_	HMD.2N/GR Two-level feed-through Terminal Block - Grey (2.5 mmq) - Spring type	Cabur
20	053.8B	2.5	HD400GR_	HMD.2N/GR Two-level feed-through Terminal Block - Grey (2.5 mmq) - Spring type	Cabur
21	053.9B	2.5	HD400GR_	HMD.2N/GR Two-level feed-through Terminal Block - Grey (2.5 mmq) - Spring type	Cabur
22	053.7D	2.5	HD400GR_	HMD.2N/GR Two-level feed-through Terminal Block - Grey (2.5 mmq) - Spring type	Cabur
23	053.7D	2.5	HD400GR_	HMD.2N/GR Two-level feed-through Terminal Block - Grey (2.5 mmq) - Spring type	Cabur
24	053.8D	2.5	HD400GR_	HMD.2N/GR Two-level feed-through Terminal Block - Grey (2.5 mmq) - Spring type	Cabur
			HD201GR	HMD.1/PT/GR End section - Grey	Cabur
			BT003	BT/3 End bracket	Cabur

AS-COMMISSIONED
DAVIDE ZUCCONELLI
NO MARK UP
21/03/2025

RED LINE AS BUILT STAMP

RLMU	✖ Yes ☐ No
Description	This document represents the final as-built version incorporating the latest approved information.
Reviewed & Confirmed by	Rosetti Marino S.P.A.
Signature /Date	

Notes: Tick"Yes" only when the document reflects the final as-commissioned condition and the red-line mark-up (RLMU) has been incorporated without a new revision.
Tick "No" if the last approved revision already represents the final condition, with no redline markup required.

=	TYPICAL
+	LE2-250
DWG n° :	231298/SD/31
Item n° :	PF1002983/26

ROSETTI MARINO

REV.	DATE	DRN	CHKD	APPD	DESCRIPTION
2	18/09/2024	Santinelli	Flamminio	Sigismondi	As Built (ASB)
1	10/07/2024	Santinelli	Flamminio	Sigismondi	Accepted for Construction (AFC)
0	09/05/2024	Santinelli	Flamminio	Sigismondi	Issued for review (IFR)

TITLE : "SG-200N1"

LV SWG FUNCTIONAL DIAGRAMS - TYPICAL FEEDERS

Functional Drawing - Typical "LE2-320"

CONTRACT NO./TITLE CW-I-WP4-2023-05/HOLLANDSE KUST NOORD WIND PARK

SCALE : NTS

A3

DRAWING NO. 1723002197-EL-DG-00031

SHEET 055

REV. 02

F.to UNI A3: 420mmx297mm

File Name : 1723002197-EL-DG-00031 Rev. 02

Nome/Item	Fg/Sh	Tipo/Type	Q.ta/Q.ty	Descrizione/Description	Costruttore/Manufacturer	Quadro (descrizione)
GS1	050		1	Generatore sincrono trifase indotto collegato a stella e neutro accessibile		TYPICAL LE2-320
HL1	051	ML22/483L230STLTTR	1	MULTILED 48x48 - 3 LED - Vaux=230Vac/dc + LAMP TEST + TROP	DOMO	TYPICAL LE2-320
KA1	051	ER 592 6	1	CR-M230AC4L SUPPLY 230VAC 4C/O 250V/6A LED	ABB	TYPICAL LE2-320
		ER 609 8	1	CR-MH HOLDER FOR CR-M RELAY	ABB	TYPICAL LE2-320
		ER 686 6	1	CR-M4SS SOCKET STANDARD X 2/4 C/O(CR-M)	ABB	TYPICAL LE2-320
KA2	051	ER 592 6	1	CR-M230AC4L SUPPLY 230VAC 4C/O 250V/6A LED	ABB	TYPICAL LE2-320
		ER 609 8	1	CR-MH HOLDER FOR CR-M RELAY	ABB	TYPICAL LE2-320
		ER 686 6	1	CR-M4SS SOCKET STANDARD X 2/4 C/O(CR-M)	ABB	TYPICAL LE2-320
KA3	051	ER 592 6	1	CR-M230AC4L SUPPLY 230VAC 4C/O 250V/6A LED	ABB	TYPICAL LE2-320
		ER 609 8	1	CR-MH HOLDER FOR CR-M RELAY	ABB	TYPICAL LE2-320
		ER 686 6	1	CR-M4SS SOCKET STANDARD X 2/4 C/O(CR-M)	ABB	TYPICAL LE2-320
QA1	050	S550239	1	S202M C 2 AUTOMATIC CIRCUIT BREAKER 10KA 2P	ABB	TYPICAL LE2-320
		A563819	1	S2-CS/H6R AUXILIARY STATE CONTACT 1CO	ABB	TYPICAL LE2-320
QA2	050	S550239	1	S202M C 2 AUTOMATIC CIRCUIT BREAKER 10KA 2P	ABB	TYPICAL LE2-320
		A563819	1	S2-CS/H6R AUXILIARY STATE CONTACT 1CO	ABB	TYPICAL LE2-320
QF1	050	1SDA100556R1	1	XT5S 400 BREAKING PART 4p F F	ABB	TYPICAL LE2-320
		1SDA100692R1	1	ELECTRONIC TRIP RELEASE Ekip Hi-Touch LSIG In=320A XT5 4p	ABB	TYPICAL LE2-320
		1SDA066434R1	1	AUX-C 3Q+1SY 250Vac/dc XT2..XT6 F/P	ABB	TYPICAL LE2-320
		1SDA104958R1	1	YU-C XT5 F/R 220-240Vac-220-250Vdc	ABB	TYPICAL LE2-320
U1.2	052	1SDA074173R1	1	MODUL EKIP SUPPLY 24÷48VDC	ABB	TYPICAL LE2-320
U1.3	052	1SDA105166R1	1	Module Ekip Com Modbus RS485 Tmax XT	ABB	TYPICAL LE2-320
U1.A	052	1SDA105203R1	1	EKIP CARTRIDGE 2SLOT FOR XT2-XT4-XT5	ABB	TYPICAL LE2-320
U2.A	053	Z-PC-DINAL2-17.5	1	DIN RAIL 2SLOT WITH HEAD FOR "Z-5DI-2DO"	SENECA	TYPICAL LE2-320
U2.B	053	Z-5DI-2DO	1	I/O MODUL 5DI+2DO modbus RS485 Vaux=10÷40Vdc 19÷28Vac	SENECA	TYPICAL LE2-320
X1		HD100GR_	8	HMD.2/GR Two-level feed-through Terminal Block - Grey (2.5 mmq) - Spring type	Cabur	TYPICAL LE2-320
		HD400GR_	16	HMD.2N/GR Two-level feed-through Terminal Block - Grey (2.5 mmq) - Spring type	Cabur	TYPICAL LE2-320
		BT003	2	BT/3 End bracket	Cabur	TYPICAL LE2-320
		HD101GR	1	HMD/PT/GR End section - Grey	Cabur	TYPICAL LE2-320
		HD201GR	1	HMD.1/PT/GR End section - Grey	Cabur	TYPICAL LE2-320

AS-COMMISSIONED
DAVIDE ZUCCONELLI
NO MARK UP
21/03/2025

RED LINE AS BUILT STAMP

RLMU	✖Yes ☐ No
Description	This document represents the final as-built version incorporating the latest approved information.
Reviewed & Confirmed by	Rosetti Marino S.P.A.
Signature /Date	

Notes: Tick"Yes" only when the document reflects the final as-commissioned condition and the red-line mark-up (RLMU) has been incorporated without a new revision.
Tick "No" if the last approved revision already represents the final condition, with no redline markup required.

= TYPICAL
\+ LE2-250

DWG n° : 231298/SD/31
Item n° : PF1002983/26

REV.	DATE	DRN	CHKD	APPD	DESCRIPTION
2	18/09/2024	Santinelli	Flamminio	Sigismondi	As Built (ASB)
1	10/07/2024	Santinelli	Flamminio	Sigismondi	Accepted for Construction (AFC)
0	09/05/2024	Santinelli	Flamminio	Sigismondi	Issued for review (IFR)

ROSETTI MARINO

TITLE : "SG-200N1"
LV SWG FUNCTIONAL DIAGRAMS - TYPICAL FEEDERS
Functional Drawing - Typical "LE2-320"

CONTRACT NO./TITLE CW-I-WP4-2023-05/HOLLANDSE KUST NOORD WIND PARK | SCALE : NTS

A3 | DRAWING NO. 1723002197-EL-DG-00031 | SHEET 056 | REV. 02

F.to UNI A3: 420mmx297mm

File Name : 1723002197-EL-DG-00031 Rev. 02