
CROSSWIND

ROSETTI MARINO

PROVERLIS

PROJECT **123A90 - HOLLANDSE KUST NOORD WIND PARK**
BLPH Project

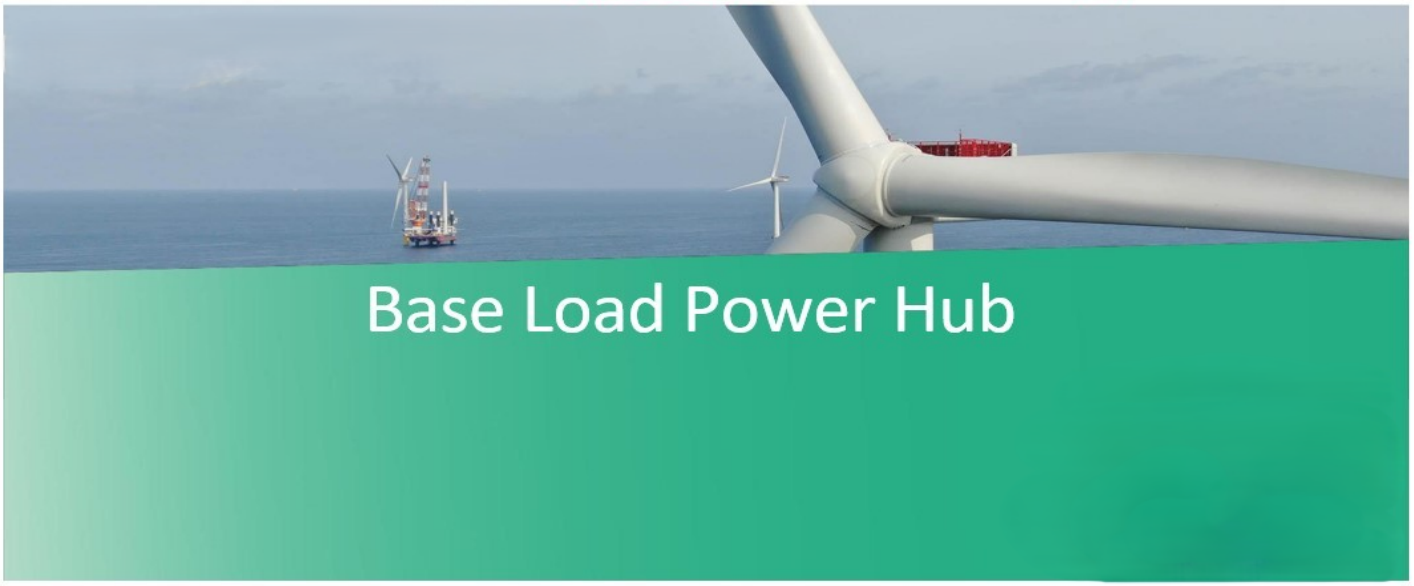

COMMISSIONING DOSSIER (ONSHORE)

SYSTEM	83 Main Power Distribution Low Voltage 440 V
SUBSYSTEM	83-60 Cathodic Protection

CROSSWIND

123A90 - HOLLANDSE KUST NOORD WIND PARK
BLPH Project

COMMISSIONING DOSSIER INDEX

ROSETTI MARINO


Sub System N°:	83-60	**Tick as appropriate**	ONSHORE	OK
Description:	Cathodic Protection		OFFSHORE	

1. *SUB-SYSTEM DEFINITION*	OK
1.1 Sub-System Description / Boundary Limit Drawings	
2. *READY FOR OPERATION CERTIFICATE*	OK
2.1 Achievement Of Ready for Operation Certificate (RFO)	
2.2 Exception Punch Lists (per discipline)	
2.3 “As-Commissioned” P&ID’s / SLD’s / D&ID’s / C&E’s	
3. *CONSOLIDATED PUNCH LISTS*	OK
3.1 Cleared and Residual Items (sorted by discipline)	
4. *FUNCTIONAL TESTS SHEETS*	OK
4.1 Electrical functional test sheets index	
4.2 Electrical “As-Commissioned” interconnection diagrams	
4.3 Instrumentation Functional Test Sheets Index	
4.4 Instrumentation “As-Commissioned” interconnection diagrams	
4.5 Telecommunication Functional Test Sheets Index	
4.6 Telecommunication “As-Commissioned” I.C.D. / TSLD’s	
5. *SITE / OPERATIONAL:*	NA
5.1 Operational Test Procedure	
5.2 Operational Test Certificates	
6. *PIPING AND VESSEL PREPARATION*	NA
6.1 Final Mechanical / Vessel Inspection Checks Index	
6.2 Leak Test / Drying / Inerting Test Sheets Index	
6.3 Chemical Loading & First Fill records Index	
6.4 Chemical Cleaning Reports and Records Index	
6.5 Lubrication Schedule	
7. *VENDORS*	OK
7.1 Vendor Package Summary Index	
7.2 SAT Procedure with associated punch list and reference (Front Page)	
7.3 Vendor Spares & Special Tools lists references	
7.4 Vendor Data / Operations / Maintenance Manuals References	
8. *LIST OF MODIFICATIONS*	NA
8.1 List of changes initiated during the WORKSITE Commissioning phase pertaining to the relevant Sub-System will be incorporated in this section with relevant references (with location and position of blinds/spades, isolation LO & LC valves, list of electrical isolation status, and remaining inhibits and overrides)	
9. *SUPPORTING DOCUMENTS*	NA
9.1 Other supporting documents (as applicable)	

	Contractor Commissioning Site Leader	Company Commissioning Site Leader
Name	Anthony Iveson	Martin Taylor
Date	2025-06-06	2025-06-10
Signature	PROVERLIS Digitaly signed by Anthony Iveson 2025-06-06T09:59:26.388Z	PROVERLIS Digitaly signed by Martin Taylor 2025-06-10T12:13:04.505Z

Section 1 SUB-SYSTEM DEFINITION

DRAWING NO. 123A90-DDL-EL-DG-20158 REV. 01

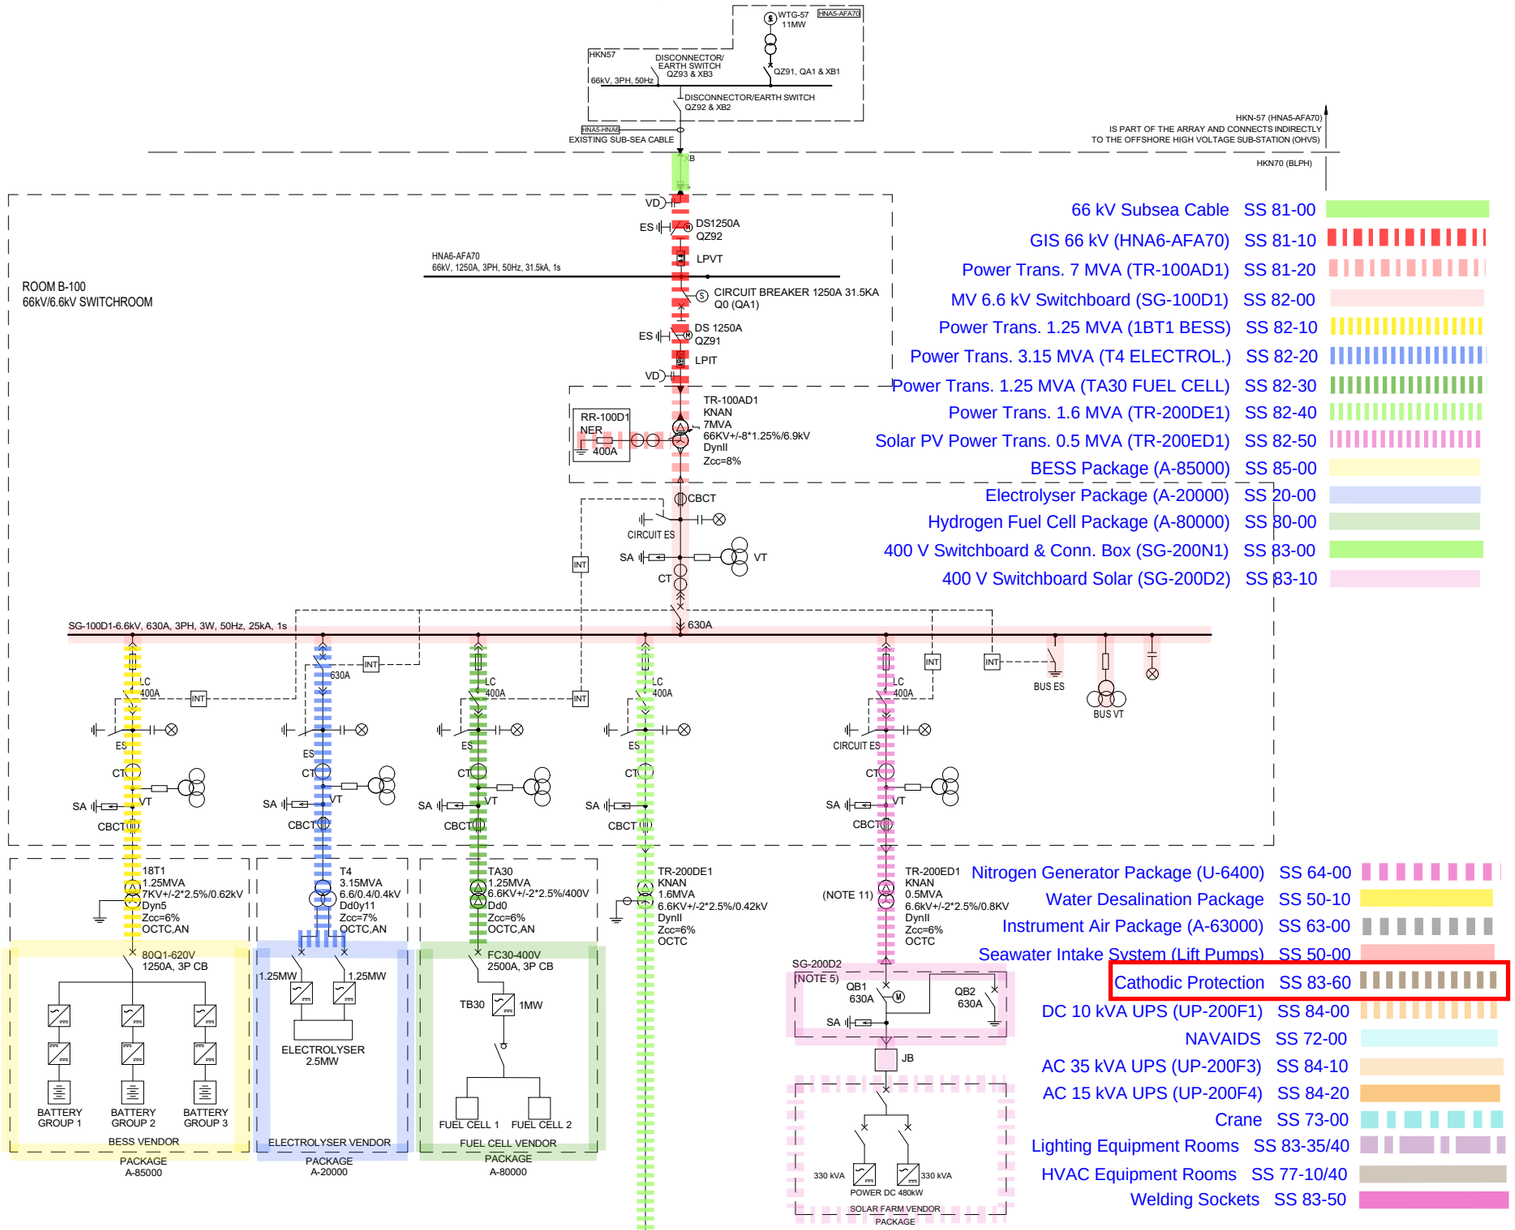

SYMBOL LEGEND:

- VOLTAGE DETECTOR
- EARTHING SWITCH DISCONNECTOR
- MOTORIZED EARTHING SWITCH
- CIRCUIT BREAKER
- FUSE
- CONTACTOR
- THREE-PHASE TRANSFORMER WITH TAP CHANGER
- THREE-PHASE TRANSFORMER
- CURRENT TRANSFORMER
- THREE-PHASE TRANSFORMER, WITH THREE WINDINGS
- NEUTRAL EARTHING RESISTOR
- SURGE ARRESTER
- CORE BALANCE CURRENT TRANSFORMER
- SURGE ARRESTOR FOR T-CONNECTOR (N.1 FOR EACH PHASE)
- VOLTAGE & CURRENT TRANSFORMER (3Ø X 2) (LPIT TYPE)
- VOLTAGE TRANSFORMER (3Ø X 2) (LPVT TYPE)
- VOLTAGE TRANSFORMER
- CABLE BOX
- T-CONNECTOR CABLE TERMINATION
- CABLE AIR TERMINATION

OLTC	= ON LOAD TAP CHANGER
OCTC	= OPEN CIRCUIT TAP CHANGER
KNAN	= NON-MINERAL OIL NATURAL AIR COOLED
AN	= AIR NATURAL
XB	= CABLE BOX
QZ	= DISCONNECT SWITCH & EARTH SWITCH
QA	= CIRCUIT BREAKER
LC	= LATCHED FUSED CONTACTOR (400A)
INT	= INTERLOCK SYSTEM
SA	= SURGE ARRESTER
CBCT	= CORE BALANCE CURRENT TRANSFORMER
ES	=EARTHING SWITCH
VD	=VOLTAGE DETECTOR
LCP	=LOCAL CONTROL PANEL
LPVT	=LOW POWER VOLTAGE TRANSFORMER
LPCT	=LOW POWER CURRENT TRANSFORMER
LPIT	=LOW POWER INSTRUMENT TRANSFORMER
JB	=JUNCTION BOX

NOTES:

1. TEMPORARY POWER SUPPLY CONNECTION BOX LOCATED ON OUTSIDE WALL OF LV SWITCHROOM / CONTAINER.
2. LOAD DEFINITION 'ESSENTIAL' / 'NON-ESSENTIAL' IS SHOWN IN THE LOAD LIST. THE CCS, EMCS AND 'SMART' SWITCHGEAR WILL OPEN / CLOSE CIRCUIT BREAKERS AS REQUIRED.
3. A COMBINED CCS/EMCS SYSTEM COMPRISES A MICROPROCESSOR BASED SYSTEM, ASSOCIATED SOFTWARE AND REQUIRED PERIPHERALS FOR MONITORING AND CONTROLLING OF ELECTRICAL POWER NETWORK. ALL ELECTRICAL EQUIPMENT AND PACKAGE UNITS SHALL BE CONNECTED TO THE CENTRAL CONTROL SYSTEM .
4. IMPRESSED CURRENT CATHODIC PROTECTION SYSTEM SUPPLIED BY COMPANY.
5. THE SOLAR FARM IN-FEED POWER CIRCUIT BREAKERS PANEL IS LOCATED INSIDE THE LV SWITCHGEAR ROOM B-200.
6. DELETED.
7. DELETED.
8. DELETED.
9. CROSSWIND SHALL BE ABLE TO CONTROL THE BLPH 66KV MOTORISED CIRCUIT BREAKER Q0 (QA1) & MOTORISED ELECTRICAL DISCONNECTOR / EARTH SWITCH (QZ92, TYPE B) USING THEIR 'HV-SCADA' SYSTEM. THIS BACK-UP / REDUNDANT CONTROL SHALL BE ADDITIONAL TO THAT PROVIDED BY THE CCS AND BE OF HIGHER PRIORITY OVER A SEPARATE FIBRE OPTIC CABLE (FOC). THE CCS OPERATOR AND 'HV-SCADA' SHALL BOTH BE KEPT FULLY AWARE OF EQUIPMENT STATUS AT ALL TIMES. INTERTRIPPING, INHIBITS & INTERLOCKING FOR BLPH 66KV EQUIPMENT SHALL BE AS PER THE WIND FARM.
10. THE LOADS IN THE LOW VOLTAGE SWITCHGEAR AND THE CURRENT VALUES OF THE CIRCUIT BREAKERS ARE ONLY INDICATIVE.
11. NEUTRAL POINT OF TR-200ED1 SHALL NOT BE GROUNDED AS REQUIRED BY SOLAR FARM SUPPLIER IN 123A90-PML-PM-TQ-00040.

REFERENCES:

1. 123A90-DDL-EL-DG-20014 ELECTRICAL CONTROL, PROTECTION AND METERING DIAGRAMS
2. 123A90-DDL-EL-DG-20015 ELECTRICAL SINGLE LINE DIAGRAM 6.6kV SYSTEMS
3. 123A90-DDL-EL-DG-20159 ELECTRICAL SINGLE LINE DIAGRAMS LV SYSTEM
4. 123A90-DDL-EL-DG-20160 ELECTRICAL SINGLE LINE DIAGRAMS AC UPS SYSTEMS
5. 123A90-DDL-EL-DG-20161 ELECTRICAL SINGLE LINE DIAGRAMS DC UPS SYSTEMS
6. 123A90-DDL-EL-DG-20185 ELECTRICAL SINGLE LINE DIAGRAM HV SYSTEMS
7. 123A90-DDL-EL-DL-20104 ELECTRICAL EQUIPMENT LAYOUT - HV SWITCHROOM
8. 123A90-DDL-EL-DL-20105 ELECTRICAL EQUIPMENT LAYOUT - LV SWITCHROOM
9. 123A90-DDL-EL-LIS-20016 ELECTRICAL LOAD LIST and BALANCE -CCS MODE CHARGING-
10. 123A90-DDL-EL-RE-20152 ELECTRICAL EQUIPMENT SIZING CCALCULATION REPORT
11. 123A90-DDL-EL-RE-20170 ELECTRICAL SYSTEM STUDY REPORT - LOAD FLOW
12. 123A90-DDL-EL-RE-20171 ELECTRICAL SYSTEM STUDY REPORT - SHORT CIRCUIT
13. 123A90-DDL-EL-RE-20172 ELECTRICAL SYSTEM STUDY REPORT - ARC FLASH ENERGY CALCULATION
14. 123A90-DDL-EL-RE-20173 ELECTRICAL SYSTEM STUDY REPORT - HARMONICS

REV.	DATE	DRN	CHKD	APPD	DESCRIPTION
01	26/03/2024	GPA	LMA/AMA	LMA/MDO	ISSUE FOR REVIEW (IFR)
00	02/11/2023	DSF	CB/AMA	OYFO/MDO	ISSUE FOR REVIEW (IFR)

CROSSWIND

ROSETTI MARINO


TITLE :

OVERALL/KEY SINGLE LINE DIAGRAM

CONTRACT NO./TITLE CW-I-WP4-2023-05/HOLLANDSE KUST NOORD WIND PARK			SCALE N/A
DRAWN GPA	CHECKED LMA/AMA	APPROVED LMA/MDO	DATE 26/03/2023
A1	DRAWING NO. 123A90-DDL-EL-DG-20158	SHEET 001	REV. 01

01

File Name : 123A90-DDL-EL-DG-20158_REV01.dwg

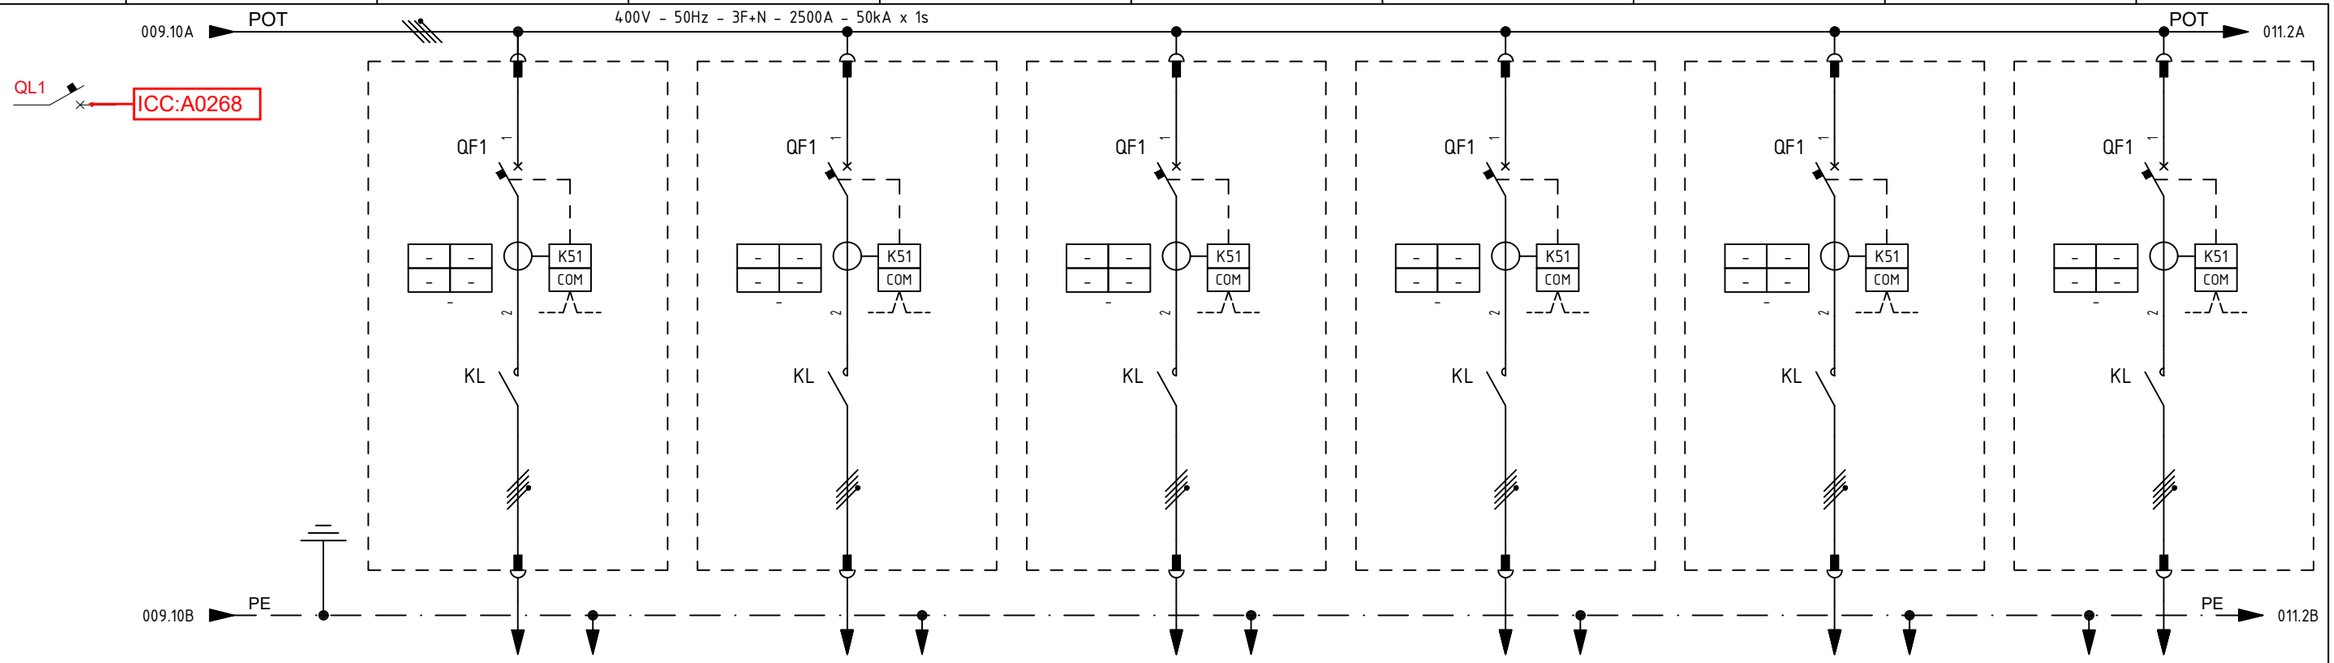

ITEM			1	SPARE		B200-HSB-001		B300-HSB-001		B400-HSB-001		CN-200N1		SPARE	
UTILITY			2	SPARE		HVAC PANELS - LV ROOM		HVAC PANELS - UPS ROOM		HVAC PANELS - ITER		IMPRESSED CURR. CATHODIC PROTECTION (ICCP) SYSTEM		SPARE	
COLUMN/CUBICLE			3	A5 / +01		A5 / +02		A5 / +03		A5 / +04		A5 / +05		A5 / +06	
RATED POWER | RATED CURRENT			4/5	15 kW	24.0 A	18 kW	34.1 A	35,75 kW	61 A	35,75 kW	61 A	14 kVA	23.8 A	- kW	- A
TYPICAL FUNCTIONAL			6	LK1-40		LK1-40		LK1-63		LK1-63		LK1-40		LK1-40	
CIRCUIT BREAKER (ABB)	TYPE		7	XT2S - 160		XT2S - 160		XT2S - 160		XT2S - 160		XT2S - 160		XT2S - 160	
	VERSION		8	4P - FIXED		4P - FIXED		4P - FIXED		4P - FIXED		4P - FIXED		4P - FIXED	
	TRIP UNITS		9	EKIP HI TOUCH LSIG (In = 40A)		EKIP HI TOUCH LSIG (In = 40A)		EKIP HI TOUCH LSIG (In = 63A)		EKIP HI TOUCH LSIG (In = 63A)		EKIP HI TOUCH LSIG (In = 40A)		EKIP HI TOUCH LSIG (In = 40A)	
	Icu	KA	10	50 kA		50 kA		50 kA		50 kA		50 kA		50 kA	
OVERLOAD	L	Range A	11	(0.4 - 1) x In		(0.4 - 1) x In		(0.4 - 1) x In		(0.4 - 1) x In		(0.4 - 1) x In		(0.4 - 1) x In	
		Range t	12	k/I^2		k/I^2		k/I^2		k/I^2		k/I^2		k/I^2	
SEL. SHORT-CIRCUIT	S	Range A	13	(0.6 - 10) x In		(0.6 - 10) x In		(0.6 - 10) x In		(0.6 - 10) x In		(0.6 - 10) x In		(0.6 - 10) x In	
		Range t	14	0.05 - 0,4 sec / k/I^2		0.05 - 0,4 sec / k/I^2		0.05 - 0,4 sec / k/I^2		0.05 - 0,4 sec / k/I^2		0.05 - 0,4 sec / k/I^2		0.05 - 0,4 sec / k/I^2	
INST. SHORT-CIRCUIT	I	Range A	15	(1.5 - 15) x In		(1.5 - 15) x In		(1.5 - 15) x In		(1.5 - 15) x In		(1.5 - 15) x In		(1.5 - 15) x In	
		Range t	16	instantaneous		instantaneous		instantaneous		instantaneous		instantaneous		instantaneous	
EARTH FAULT PROTECTION	G	Range A	17	(0.1 - 1) x In		(0.1 - 1) x In		(0.1 - 1) x In		(0.1 - 1) x In		(0.1 - 1) x In		(0.1 - 1) x In	
		Range t	18	t=k / t=k/I^2		t=k / t=k/I^2		t=k / t=k/I^2		t=k / t=k/I^2		t=k / t=k/I^2		t=k / t=k/I^2	
CONTACTOR (ABB)			19	AF40-40-00-13 (70A-AC1); 100-250VAC/DC		AF40-40-00-13 (70A-AC1); 100-250VAC/DC		AF52-40-00-13 (100A-AC1); 100-250VAC/DC		AF52-40-00-13 (100A-AC1); 100-250VAC/DC		AF40-40-00-13 (70A-AC1); 100-250VAC/DC		AF40-40-00-13 (70A-AC1); 100-250VAC/DC	
THERMAL OVERLOAD RELAY (ABB)			20	-		-		-		-		-		-	
SURGE ARRESTER (DEHN)			21	-		-		-		-		-		-	
TOROIDAL CURRENT TRANSFORMER (FRER)			22	-		-		-		-		-		-	
FUSE HOLDER (ITALWEBER)			23	SUBSISTEM 83.00		SUBSISTEM 77.20		SUBSISTEM 77.30		SUBSISTEM 77.40		SUBSISTEM 83.60		SUBSISTEM 83.00	
INDIRECT PROTECTION (ABB)			24												
VOLTMETER			25												
CURRENT TRANSFORMER FOR MEASURE (FRER)	TYPE		26	-		-		-		-		-		-	
	PERFORMANCE/CLASS		27	-		-		-		-		-		-	
VOLTAGE TRANSFORMER FOR MEASURE (FRER)	TYPE		28	-		-		-		-		-		-	
	PERFORMANCE/CLASS		29	-		-		-		-		-		-	
LOCK-OUT RELAY (-)			30	-		-		-		-		-		-	
POWER CONDUCTOR		mmq	31	-		5G16		5G16		5G16		5G16		-	

REV.	DATE	DRN	CHKD	APPD	DESCRIPTION
3	08/07/2024	Santinelli	Flamminio	Sigismondi	Accepted for Construction (AFC)
2	03/05/2024	Santinelli	Flamminio	Sigismondi	Issued for review (IFR)
1	28/03/2024	Santinelli	Flamminio	Sigismondi	Issued for review (IFR)
0	15/02/2024	Santinelli	Flamminio	Sigismondi	Issued for review (IFR)

DWG n° : 231298/SD/11
Item n° : PF1002983/26

TITLE : "SG-200N1"
SINGLE LINE DIAGRAM
Single Line Drawing

CONTRACT NO./TITLE CW-I-WP4-2023-05/HOLLANDSE KUST NOORD WIND PARK | SCALE : NTS

A3 | DRAWING NO. 1723002197-EL-DG-00011 | SHEET 010 | REV. 03

F.to UNI A3: 420mmx297mm

File Name : 1723002197-EL-DG-00011 Rev. 03

Section 2 READY FOR OPERATION

Section 2.1 Achievement Of Ready for Operation Certificate (RFO)

ROSETTI MARINO

123A90 - HOLLANDSE KUST NOORD WIND PARK
BLPH Project

CROSSWIND

Ready For Operation (RFO) Certificate

COMPLETE	●	PARTIAL	

Revision:	1		Issued on:	2025-05-28	

System:	83	/	Main Power Distribution Low Voltage 440 V

SubSystem:	83-60	/	Cathodic Protection

We hereby confirm that all Mechanical Completion (MC) and Pre-Commissioning/Commissioning (Pre-Comm./Comm.) activities for the above-mentioned System/Sub-System have been successfully completed in accordance with project specifications, relevant standards and contractual requirements. The System/Sub-System has been tested and verified to ensure readiness for operation. Issuance of this Certificate shall not release CONTRACTOR from any of his obligations, responsibilities or liabilities under the CONTRACT.

- **Mechanical Completion:** All required MC activities have been completed and approved
- **Pre-Commissioning & Commissioning:** All required Pre-Comm. and Comm. activities and OTPs have been completed and approved (Status Index attached)
- **Punch List:** All Punch items categorized as A and B have been cleared (PL report attached)
- **Documentation:** As-built documentation and Commissioning dossier has been completed, reviewed and approved

PUNCH LIST	PENDING POINTS
Note: All Category "A" and "B" Items must be cleared prior to issuance of the Ready For Operation (RFO) Certificate	B '0

REMARKS:

	CONTRACTOR Commissioning Manager	**COMPANY** Commissioning Lead
Name	Anthony Iveson	Martin Taylor
Date	2025-05-29	2025-06-05
Signature	PROVERLIS Digitaly signed by Anthony Iveson 2025-05-29T08:57:26.843Z	PROVERLIS Digitaly signed by Martin Taylor 2025-06-05T08:26:59.266Z

Project CROSSWIND

STATUS INDEX DETAIL

Filtered on subsystem: 83-60 & process: COMM

Electrical	83-60 Cathodic Protection						
ITEM		TASK					
Code	Description	Location	Code	Form	Progress	Date	Certificate
A5/+05-QF1	PROTECTION CATHODIC SYSTEM (ICCP) - A5/+05-QF1	ONSHORE	C10002961	FP00	100	2025-03-21	RFO 1
		ONSHORE	C10002962	FTR-2	100	2024-10-02	RFO 1
		ONSHORE	C10002963	FTR-6	100	2024-10-03	RFO 1
		ONSHORE	C10003028	FTR-5	100	2025-05-15	RFO 1

CROSSWIND

ROSETTI MARINO

Project CROSSWIND

PUNCH LIST REPORT

SYSTEM	83	Main Power Distribution Low Voltage 440 V
SUBSYSTEM	83-60	Cathodic Protection

Electrical

CODE	CAT	ITEM	DEFECT DESCRIPTION	CORRECTIVE ACTION	PERFORMED ACTION	ISSUED	CARRIED	CHECKED	APPROVED
C30000260	B	83027-CEL C10000552	Wrong core identification tag on both cable's termination	-		Gtangianu 2024-10-24	2025-01-31	Gtangianu 2025-01-31	2025-01-31
C30004038	B	5W2.1 C10001799	Missing cores identification tag. Cabinet side CN-200N1 . (see document 123A90-DDL-EL-DD-20092 sh.7-8)	.		APolo 2025-02-20	2025-03-26	Gtangianu 2025-03-26	2025-03-26
C30004039	B	5W2.1 C10001799	Missing cables tag , inside cabinet CN-200N1	.		APolo 2025-02-20	2025-03-07	JKrizanic 2025-03-07	2025-03-07
C30004040	B	6W2.1 C10001800	Missing cores identification tag. inside CN-200N1 . (see document 123A90-DDL-EL-DD-20092 sh.7-8)	.		APolo 2025-02-20	2025-04-08	Gtangianu 2025-04-08	2025-04-08
C30004041	B	6W2.1 C10001800	Missing cables tag , cabinet inside CN-200N1	.		APolo 2025-02-20	2025-03-07	JKrizanic 2025-03-07	2025-03-07
C30004042	B	7WD3 C10001801	Missing core identification tag. Cabinet inside CN-200N1 . (see document 123A90-DDL-EL-DD-20092 sh.7-8)	.		APolo 2025-02-20	2025-04-07	Gtangianu 2025-04-07	2025-04-07
C30004043	B	7WD3 C10001801	Missing cables tag , cabinet inside CN-200N1	.		APolo 2025-02-20	2025-03-07	JKrizanic 2025-03-07	2025-03-07
C30004044	B	7WD6.1 C10001802	Missing cores identification tag. Cabinet inside CN-200N1 . (see document 123A90-DDL-EL-DD-20092 sh.7-8)	.		APolo 2025-02-20	2025-03-26	Gtangianu 2025-03-26	2025-03-26
C30004045	B	7WD6.1 C10001802	Missing cable tag , cabinet inside CN-200N1	.		APolo 2025-02-20	2025-03-07	JKrizanic 2025-03-07	2025-03-07


Section 2.2 Exception Punch Lists (per discipline)

Project CROSSWIND

PUNCH LIST REPORT

NO DATA AVAILABLE

Section 2.3 “As-Commissioned” P&ID's / SLD's / D&ID's / C&E's

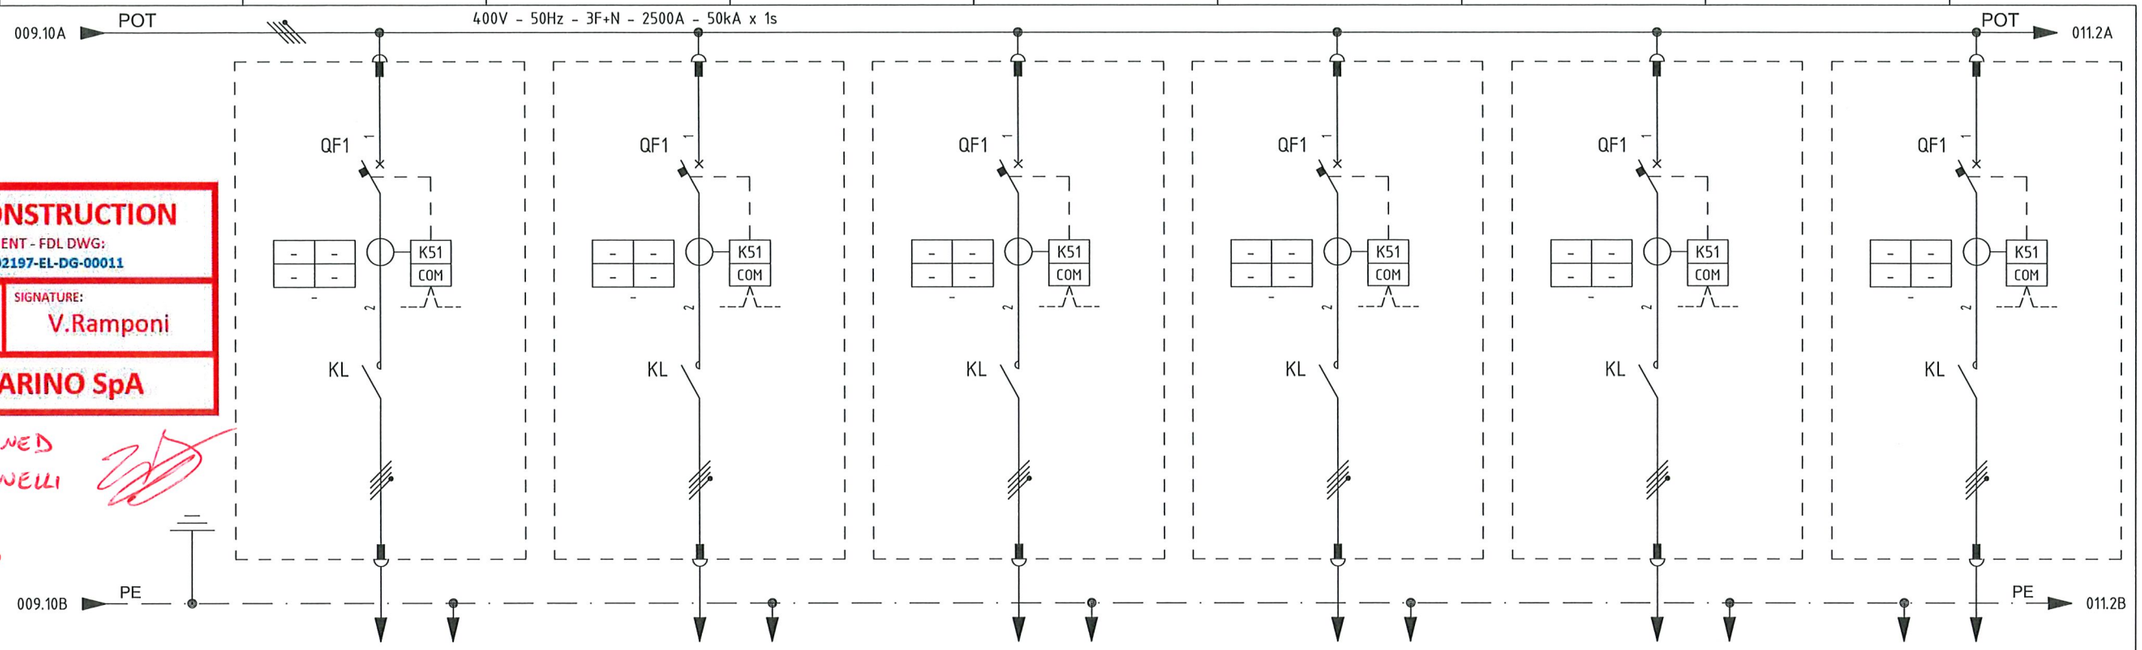

VALID FOR CONSTRUCTION

VENDOR DOCUMENT - FDL DWG:
123A90-FDL-1723002197-EL-DG-00011

REV.:	DATE:	SIGNATURE:
4_A	18/12/24	V.Ramponi

ROSETTI MARINO SpA

AS-COMMISSIONED
DAVIDE ZUCCONELLI
20/03/2025
NO MARK UP

ITEM			1	SPARE	B200-HSB-001	B300-HSB-001	B400-HSB-001	CN-200N1	SPARE
UTILITY			2	SPARE	HVAC PANELS - LV ROOM	HVAC PANELS - UPS ROOM	HVAC PANELS - ITER	IMPRESSED CURR. CATHODIC PROTECTION (ICCP) SYSTEM	SPARE
COLUMN/CUBICLE			3	A5 / +01	A5 / +02	A5 / +03	A5 / +04	A5 / +05	A5 / +06
RATED POWER | RATED CURRENT			4/5	15 kW | 24.0 A	18 kW | 34.1 A	35,75 kW | 61 A	35,75 kW | 61 A	14 kVA | 23.8 A	- kW | - A
TYPICAL FUNCTIONAL			6	LK1-40	LK1-40	LK1-63	LK1-63	LK1-40	LK1-40
CIRCUIT BREAKER (ABB)	TYPE		7	XT2S - 160	XT2S - 160	XT2S - 160	XT2S - 160	XT2S - 160	XT2S - 160
	VERSION		8	4P - FIXED	4P - FIXED	4P - FIXED	4P - FIXED	4P - FIXED	4P - FIXED
	TRIP UNITS		9	EKIP HI TOUCH LSIG (In = 40A)	EKIP HI TOUCH LSIG (In = 40A)	EKIP HI TOUCH LSIG (In = 63A)	EKIP HI TOUCH LSIG (In = 63A)	EKIP HI TOUCH LSIG (In = 40A)	EKIP HI TOUCH LSIG (In = 40A)
	Icu	KA	10	50 kA	50 kA	50 kA	50 kA	50 kA	50 kA
OVERLOAD	L	Range A	11	(0.4 - 1) x In	(0.4 - 1) x In	(0.4 - 1) x In	(0.4 - 1) x In	(0.4 - 1) x In	(0.4 - 1) x In
		Range t	12	k/I^2	k/I^2	k/I^2	k/I^2	k/I^2	k/I^2
SEL. SHORT-CIRCUIT	S	Range A	13	(0.6 - 10) x In	(0.6 - 10) x In	(0.6 - 10) x In	(0.6 - 10) x In	(0.6 - 10) x In	(0.6 - 10) x In
		Range t	14	0.05 - 0,4 sec / k/I^2	0.05 - 0,4 sec / k/I^2	0.05 - 0,4 sec / k/I^2	0.05 - 0,4 sec / k/I^2	0.05 - 0,4 sec / k/I^2	0.05 - 0,4 sec / k/I^2
INST. SHORT-CIRCUIT	I	Range A	15	(1.5 - 15) x In	(1.5 - 15) x In	(1.5 - 15) x In	(1.5 - 15) x In	(1.5 - 15) x In	(1.5 - 15) x In
		Range t	16	instantaneous	instantaneous	instantaneous	instantaneous	instantaneous	instantaneous
EARTH FAULT PROTECTION	G	Range A	17	(0.1 - 1) x In	(0.1 - 1) x In	(0.1 - 1) x In	(0.1 - 1) x In	(0.1 - 1) x In	(0.1 - 1) x In
		Range t	18	t=k / t=k/I^2	t=k / t=k/I^2	t=k / t=k/I^2	t=k / t=k/I^2	t=k / t=k/I^2	t=k / t=k/I^2
CONTACTOR (ABB)			19	AF40-40-00-13 (70A-AC1); 100-250VAC/DC	AF40-40-00-13 (70A-AC1); 100-250VAC/DC	AF52-40-00-13 (100A-AC1); 100-250VAC/DC	AF52-40-00-13 (100A-AC1); 100-250VAC/DC	AF40-40-00-13 (70A-AC1); 100-250VAC/DC	AF40-40-00-13 (70A-AC1); 100-250VAC/DC
THERMAL OVERLOAD RELAY (ABB)			20	-	-	-	-	-	-
SURGE ARRESTER (DEHN)			21	-	-	-	-	-	-
TOROIDAL CURRENT TRANSFORMER (FRER)			22	-	-	-	-	-	-
FUSE HOLDER (ITALWEBER)			23	-	-	-	-	-	-
INDIRECT PROTECTION (ABB)			24	-	-	-	-	-	-
VOLTMETER			25	-	-	-	-	-	-
CURRENT TRANSFORMER FOR MEASURE (FRER)	TYPE		26	-	-	-	-	-	-
	PERFORMANCE/CLASS		27	-	-	-	-	-	-
VOLTAGE TRANSFORMER FOR MEASURE (FRER)	TYPE		28	-	-	-	-	-	-
	PERFORMANCE/CLASS		29	-	-	-	-	-	-
LOCK-OUT RELAY (-)			30	-	-	-	-	-	-
POWER CONDUCTOR		mmq	31	-	5G16	5G16	5G16	5G16	-

=
+

DWG n° : 231298/SD/11
Item n° : PF1002983/26

IMESA ELECTRICAL ENGINEERING

CROSSWIND

ROSETTI MARINO

REV.	DATE	DRN	CHKD	APPD	DESCRIPTION
4	28/08/2024	Santinelli	Flamminio	Sigismondi	As Built (ASB)
3	08/07/2024	Santinelli	Flamminio	Sigismondi	Accepted for Construction (AFC)
2	03/05/2024	Santinelli	Flamminio	Sigismondi	Issued for review (IFR)
1	28/03/2024	Santinelli	Flamminio	Sigismondi	Issued for review (IFR)
0	15/02/2024	Santinelli	Flamminio	Sigismondi	Issued for review (IFR)

TITLE : "SG-200N1"

SINGLE LINE DIAGRAM

Single Line Drawing

CONTRACT NO./TITLE CW-I-WP4-2023-05/HOLLANDSE KUST NOORD WIND PARK

SCALE : NTS

A3

DRAWING NO. 1723002197-EL-DG-00011

SHEET 010

REV. 04

F.to UNI A3: 420mmx297mm

File Name : 1723002197-EL-DG-00011 Rev. 04

Section 3 CONSOLIDATED PUNCH LISTS

CROSSWIND

ROSETTI MARINO

Project CROSSWIND

PUNCH LIST REPORT

SYSTEM	83	Main Power Distribution Low Voltage 440 V
SUBSYSTEM	83-60	Cathodic Protection

Electrical

CODE	CAT	ITEM	DEFECT DESCRIPTION	CORRECTIVE ACTION	PERFORMED ACTION	ISSUED	CARRIED	CHECKED	APPROVED
C30000260	B	83027-CEL C10000552	Wrong core identification tag on both cable's termination	-		Gtangianu 2024-10-24	2025-01-31	Gtangianu 2025-01-31	2025-01-31
C30004038	B	5W2.1 C10001799	Missing cores identification tag. Cabinet side CN-200N1 . (see document 123A90-DDL-EL-DD-20092 sh.7-8)	.		APolo 2025-02-20	2025-03-26	Gtangianu 2025-03-26	2025-03-26
C30004039	B	5W2.1 C10001799	Missing cables tag , inside cabinet CN-200N1	.		APolo 2025-02-20	2025-03-07	JKrizanic 2025-03-07	2025-03-07
C30004040	B	6W2.1 C10001800	Missing cores identification tag. inside CN-200N1 . (see document 123A90-DDL-EL-DD-20092 sh.7-8)	.		APolo 2025-02-20	2025-04-08	Gtangianu 2025-04-08	2025-04-08
C30004041	B	6W2.1 C10001800	Missing cables tag , cabinet inside CN-200N1	.		APolo 2025-02-20	2025-03-07	JKrizanic 2025-03-07	2025-03-07
C30004042	B	7WD3 C10001801	Missing core identification tag. Cabinet inside CN-200N1 . (see document 123A90-DDL-EL-DD-20092 sh.7-8)	.		APolo 2025-02-20	2025-04-07	Gtangianu 2025-04-07	2025-04-07
C30004043	B	7WD3 C10001801	Missing cables tag , cabinet inside CN-200N1	.		APolo 2025-02-20	2025-03-07	JKrizanic 2025-03-07	2025-03-07
C30004044	B	7WD6.1 C10001802	Missing cores identification tag. Cabinet inside CN-200N1 . (see document 123A90-DDL-EL-DD-20092 sh.7-8)	.		APolo 2025-02-20	2025-03-26	Gtangianu 2025-03-26	2025-03-26
C30004045	B	7WD6.1 C10001802	Missing cable tag , cabinet inside CN-200N1	.		APolo 2025-02-20	2025-03-07	JKrizanic 2025-03-07	2025-03-07

ROSETTI MARINO
CROSSWIND

PUNCH ITEM ENTRY / CLEARANCE FORM

C30004038

PROVERLIS

1 -ELEMENT IDENTIFICATION

1.1 Task	C10001799	1.4 Discipline	Electrical
1.2 Item	5W2.1		Impressed Current Cathodic Protection (ICCP) System / ICCP JB EXTERNAL
1.3 Subsystem	83-60		Cathodic Protection

2 - OBSERVATION

Missing cores identification tag. Cabinet side CN-200N1 . (see document 123A90-DDL-EL-DD-20092 sh.7-8)

Name: Alessio Polo
Date: 2025-02-20
Signature:

3 - DEFECT ASSESSMENT

.

3.1 Corrective action proposal

3.2 Material required

3.3 Priority	B PL B	Name	Alessio Polo
3.4 Activity code	MC Mechanical Completion	Date	2025-02-20
3.5 Action by	RM_CONSTR RM	Signature	

4 - PERFORMED ACTION

Name:
Date:
Signature:

5 - CLEARANCE CHECK

Installed

Name: Giovanni Tangianu
Date: 2025-03-26
Signature:

6- CLEARANCE APPROVAL

Name:
Date:
Signature:

123
122
121
293
291
193
191
N
L3
L2
L1
PE
L1/X0/L1
L2/X0/L2
L3/X0/L3
N/X0/N

ROSETTI MARINO
CROSSWIND

PUNCH ITEM ENTRY / CLEARANCE FORM

C30004039

PROVERLIS

1 -ELEMENT IDENTIFICATION

1.1 Task	C10001799	1.4 Discipline	Electrical
1.2 Item	5W2.1		Impressed Current Cathodic Protection (ICCP) System / ICCP JB EXTERNAL
1.3 Subsystem	83-60		Cathodic Protection

2 - OBSERVATION

Missing cables tag , inside cabinet CN-200N1

Name: Alessio Polo

Date: 2025-02-20

Signature:

3 - DEFECT ASSESSMENT

.

3.1 Corrective action proposal

3.2 Material required

3.3 Priority	B PL B	Name	Alessio Polo
3.4 Activity code	MC Mechanical Completion	Date	2025-02-20
3.5 Action by	RM_CONSTR RM	Signature	

4 - PERFORMED ACTION

Name:

Date:

Signature:

5 - CLEARANCE CHECK

DONE

Name: Josip Krizanic

Date: 2025-03-07

Signature:

6- CLEARANCE APPROVAL

Name:

Date:

Signature:

ROSETTI MARINO
CROSSWIND

PUNCH ITEM ENTRY / CLEARANCE FORM

C30004040

PROVERLIS

1 -ELEMENT IDENTIFICATION

1.1 Task	C10001800	1.4 Discipline	Electrical
1.2 Item	6W2.1		Impressed Current Cathodic Protection (ICCP) System / ICCP JB INTERNAL
1.3 Subsystem	83-60		Cathodic Protection

2 - OBSERVATION

Missing cores identification tag. inside CN-200N1 . (see document 123A90-DDL-EL-DD-20092 sh.7-8)

Name: Alessio Polo
Date: 2025-02-20
Signature:

3 - DEFECT ASSESSMENT

.

3.1 Corrective action proposal

3.2 Material required

3.3 Priority	B PL B	Name	Alessio Polo
3.4 Activity code	MC Mechanical Completion	Date	2025-02-20
3.5 Action by	PRE-COMM	Signature	

4 - PERFORMED ACTION

Name:
Date: 08/04/2025
Signature:

5 - CLEARANCE CHECK

Installed.

Name: Giovanni Tangianu
Date: 2025-04-08
Signature:

6- CLEARANCE APPROVAL

Name:
Date: 2025-04-08
Signature:

123
122
121
293
291
193
191
N
L3
L2
L1
PE
L1/X0/L1
L2/X0/L2
L3/X0/L3
N/X0/N

ROSETTI MARINO
CROSSWIND

PUNCH ITEM ENTRY / CLEARANCE FORM

C30004041

PROVERLIS

1 -ELEMENT IDENTIFICATION

1.1 Task	C10001800	1.4 Discipline	Electrical
1.2 Item	6W2.1		Impressed Current Cathodic Protection (ICCP) System / ICCP JB INTERNAL
1.3 Subsystem	83-60		Cathodic Protection

2 - OBSERVATION

Missing cables tag , cabinet inside CN-200N1

Name: Alessio Polo

Date: 2025-02-20

Signature:

3 - DEFECT ASSESSMENT

.

3.1 Corrective action proposal

3.2 Material required

3.3 Priority	B PL B	Name	Alessio Polo
3.4 Activity code	MC Mechanical Completion	Date	2025-02-20
3.5 Action by	RM_CONSTR RM	Signature	

4 - PERFORMED ACTION

Name:

Date:

Signature:

5 - CLEARANCE CHECK

DONE

Name: Josip Krizanic

Date: 2025-03-07

Signature:

6- CLEARANCE APPROVAL

Name:

Date:

Signature:

ROSETTI MARINO
CROSSWIND

PUNCH ITEM ENTRY / CLEARANCE FORM

C30004042

PROVERLIS

1 -ELEMENT IDENTIFICATION

1.1 Task	C10001801	1.4 Discipline	Electrical
1.2 Item	7WD3		Impressed Current Cathodic Protection (ICCP) System / ICCP JB EXTERNAL
1.3 Subsystem	83-60		Cathodic Protection

2 - OBSERVATION

Missing core identification tag. Cabinet inside CN-200N1 . (see document 123A90-DDL-EL-DD-20092 sh.7-8)

Name: Alessio Polo
Date: 2025-02-20
Signature:

3 - DEFECT ASSESSMENT

.

3.1 Corrective action proposal

3.2 Material required

3.3 Priority	B PL B	Name	Alessio Polo
3.4 Activity code	MC Mechanical Completion	Date	2025-02-20
3.5 Action by	PRE-COMM	Signature	

4 - PERFORMED ACTION

Name:
Date: 2025-04-07
Signature:

5 - CLEARANCE CHECK

Installed.

Name: Giovanni Tangianu
Date: 2025-04-07
Signature:

6- CLEARANCE APPROVAL

Name:
Date: 2025-04-07
Signature:


-7T13
-7T16
302
Silica gel
Meets MIL-D-3464
DO NOT EAT
D&F techniek
www.dftechniek.nl

ROSETTI MARINO
CROSSWIND

PUNCH ITEM ENTRY / CLEARANCE FORM

C30004043

PROVERLIS

1 -ELEMENT IDENTIFICATION

1.1 Task	C10001801	1.4 Discipline	Electrical
1.2 Item	7WD3		Impressed Current Cathodic Protection (ICCP) System / ICCP JB EXTERNAL
1.3 Subsystem	83-60		Cathodic Protection

2 - OBSERVATION

Missing cables tag , cabinet inside CN-200N1

Name: Alessio Polo

Date: 2025-02-20

Signature:

3 - DEFECT ASSESSMENT

.

3.1 Corrective action proposal

3.2 Material required

3.3 Priority	B PL B	Name	Alessio Polo
3.4 Activity code	MC Mechanical Completion	Date	2025-02-20
3.5 Action by	RM_CONSTR RM	Signature	

4 - PERFORMED ACTION

Name:

Date:

Signature:

5 - CLEARANCE CHECK

DONE

Name: Josip Krizanic

Date: 2025-03-07

Signature:

6- CLEARANCE APPROVAL

Name:

Date:

Signature:


-7T13
-7T16
302
Silica gel
Meets MIL-D-3464
DO NOT EAT
D&F techniek
www.dftechniek.nl

ROSETTI MARINO
CROSSWIND

PUNCH ITEM ENTRY / CLEARANCE FORM

C30004044

PROVERLIS

1 -ELEMENT IDENTIFICATION

1.1 Task	C10001802	1.4 Discipline	Electrical
1.2 Item	7WD6.1		Impressed Current Cathodic Protection (ICCP) System / ICCP JB INTERNAL
1.3 Subsystem	83-60		Cathodic Protection

2 - OBSERVATION

Missing cores identification tag. Cabinet inside CN-200N1 . (see document 123A90-DDL-EL-DD-20092 sh.7-8)

Name: Alessio Polo
Date: 2025-02-20
Signature:

3 - DEFECT ASSESSMENT

.

3.1 Corrective action proposal

3.2 Material required

3.3 Priority	B PL B	Name	Alessio Polo
3.4 Activity code	MC Mechanical Completion	Date	2025-02-20
3.5 Action by	RM_CONSTR RM	Signature	

4 - PERFORMED ACTION

Name:
Date:
Signature:

5 - CLEARANCE CHECK

Installed

Name: Giovanni Tangianu
Date: 2025-03-26
Signature:

6- CLEARANCE APPROVAL

Name:
Date:
Signature:


-7T13
-7T16
302
Silica gel
Meets MIL-D-3464
DO NOT EAT
D&F techniek
www.dftechniek.nl

ROSETTI MARINO
CROSSWIND

PUNCH ITEM ENTRY / CLEARANCE FORM

C30004045

PROVERLIS

1 -ELEMENT IDENTIFICATION

1.1 Task	C10001802	1.4 Discipline	Electrical
1.2 Item	7WD6.1		Impressed Current Cathodic Protection (ICCP) System / ICCP JB INTERNAL
1.3 Subsystem	83-60		Cathodic Protection

2 - OBSERVATION

Missing cable tag , cabinet inside CN-200N1

Name: Alessio Polo

Date: 2025-02-20

Signature:

3 - DEFECT ASSESSMENT

.

3.1 Corrective action proposal

3.2 Material required

3.3 Priority	B PL B	Name	Alessio Polo
3.4 Activity code	MC Mechanical Completion	Date	2025-02-20
3.5 Action by	RM_CONSTR RM	Signature	

4 - PERFORMED ACTION

Name:

Date:

Signature:

5 - CLEARANCE CHECK

DONE

Name: Josip Krizanic

Date: 2025-03-07

Signature:

6- CLEARANCE APPROVAL

Name:

Date:

Signature:


-7T13
-7T16
302
Silica gel
Meets MIL-D-3464
DO NOT EAT
D&F techniek
www.dftechniek.nl

ROSETTI MARINO
CROSSWIND

PUNCH ITEM ENTRY / CLEARANCE FORM

C30000260

PROVERLIS

1 -ELEMENT IDENTIFICATION

1.1 Task	C10000552	1.4 Discipline	Electrical
1.2 Item	83027-CEL		LV Switchgear / Impressed Current Cathodic Protection (ICCP) System
1.3 Subsystem	83-60		Cathodic Protection

2 - OBSERVATION

Wrong core identification tag on both cable's termination

Name: Giovanni Tangianu

Date: 2024-10-24

Signature:

3 - DEFECT ASSESSMENT

-

3.1 Corrective action proposal

3.2 Material required

3.3 Priority	B PL B	Name	Giovanni Tangianu
3.4 Activity code	MC Mechanical Completion	Date	2024-10-24
3.5 Action by	RM_CONSTR RM	Signature	

4 - PERFORMED ACTION

Name:

Date:

Signature:

5 - CLEARANCE CHECK

Done.

Name: Giovanni Tangianu

Date: 2025-01-31

Signature:

6- CLEARANCE APPROVAL

Name:

Date:

Signature:

Section 4 FUNCTIONAL TESTS SHEETS

Section 4.1 Electrical functional test sheets index

CROSSWIND

ROSETTI MARINO

Project CROSSWIND

STATUS INDEX DETAIL

Filtered on subsystem: 83-60 & process: COMM & discipline : E

Electrical	83-60 Cathodic Protection						
ITEM		TASK					
Code	Description	Location	Code	Form	Progress	Date	Certificate
A5/+05-QF1	PROTECTION CATHODIC SYSTEM (ICCP) - A5/+05-QF1	ONSHORE	C10002961	FP00	100	2025-03-21	RFO 1
		ONSHORE	C10002962	FTR-2	100	2024-10-02	RFO 1
		ONSHORE	C10002963	FTR-6	100	2024-10-03	RFO 1
		ONSHORE	C10003028	FTR-5	100	2025-05-15	RFO 1

ROSETTI MARINO | PROVERLIS | CROSSWIND

ITEM	Tag	A5/+05-QF1	: PROTECTION CATHODIC SYSTEM (ICCP) - A5/+05-QF1			Dwg	1723002197-EL-DG-00011
	S/Sys	83-60	: Cathodic Protection			Module	
TASK	code	C10002961	Location	Onshore Activities		User	Rosetti Marino Quality Control
FORM	Process	PRE-COMM	Activity	FTS	Discipline	Electrical	Form	FP00		Miscellaneous electrical Consumer

DATA

Switchboard	SG-200N1	Circuit ref:	A5/+05-QF1
Breaker rating (A)	40A	Nominal current (A)	23.8A

FUNCTION TEST REQUIREMENT

1	Check pre-commissioning activities have been carried out				OK
2	Check equipment for cleaness				OK
3	Measure I/R value of equipment and feeder cable at 1000V (Min value: 10 Mohm)	>1000	MΩ		OK
4	Energise control of equipment feeder				OK
5	Full test feeder breaker operation in test position				OK
6	Check protection setting				OK
7	Test interface trips and signals (remote alarms & status). Check the relevant ITR presence in the system				OK
8	Test control and safety functions according to manufacturer's procedure.				OK
9	Energize				OK
10	Measure Voltage and Current values at feeder breaker	422	V	0.2 A	OK
11	Attach test procedure, if any				NA

FUNCTION TEST REQUIREMENT	RESULT

Testing & measurement instruments used

Type	Serial n°	Calibration certificate	Validity
FLUKE 1663	5380144	7727/24	10/07/2025
FLUKE 376	A1711003	7710/24	10/07/2025

Comments:

Page 1/1	Performed by	☐ WITNESS ☑ REVIEW	☐ WITNESS ☐ REVIEW
Company	RM COMM	RM COMM	CPY NOT PRESENT
Name	Davide Zucconelli	Kristian Castellani	Witness waived
Date	2025-03-19	2025-03-21	2025-03-21
Signature	Digitaly signed by Davide Zucconelli 2025-03-19T09:33:22.239Z	Digitaly signed by Kristian Castellani 2025-03-21T10:01:40.592Z	Digitaly signed by Witness waived 2025-03-21T16:57:20.775Z

ITEMS ACRONYM

TYPICAL : LINE FEEDER "LK1-n" "LK2-n"

Composition of Typical :

LK-x = Common Parts
LK1-"nn" or LK2-"nn"= Specific Parts

Example for Composition of LK1-63:
- to take "LK-x" plus "LK1-63"

Example for Composition of LK2-160:
- to take "LK-x" plus "LK2-160"

	ACRONYM ITEMS [Comun parts]	ACRONYM ITEMS [Specific parts]					
	LK-x	LK1-40 [In=40A] [Current Trip Unit]	LK1-63 [In=63A] [Current Trip Unit]	LK1-100 [In=100A] [Current Trip Unit]	LK2-160 [In=160A] [Current Trip Unit]		
ASSOCIATED TYPICAL	This Item include all devices that are comun for both "Specific Parts" Items	This Items include only devices that are detail for "Specific Parts" Items					
LK1-40	X	X					
LK1-63	X		X				
LK1-100	X			X			
LK2-160	X				X		
-							

=	TYPICAL					
+	LK-x					
2	18/09/2024	Santinelli	Flamminio	Sigismondi	As Built (ASB)	
1	10/07/2024	Santinelli	Flamminio	Sigismondi	Accepted for Construction (AFC)	
0	09/05/2024	Santinelli	Flamminio	Sigismondi	Issued for review (IFR)	
REV.	DATE	DRN	CHKD	APPD	DESCRIPTION	

DWG n° : 231298/SD/31
Item n° : PF1002983/26

CROSSWIND

ROSETTI MARINO


TITLE : "SG-200N1"
LV SWG FUNCTIONAL DIAGRAMS - TYPICAL FEEDERS
Items Acronym - Typical "LK1-n" & "LK2-n"

CONTRACT NO./TITLE CW-I-WP4-2023-05/HOLLANDSE KUST NOORD WIND PARK | SCALE : NTS

A3 | DRAWING NO. 1723002197-EL-DG-00031 | SHEET 037 | REV. 02

F.to UNI A3: 420mmx297mm

File Name : 1723002197-EL-DG-00031 Rev. 02

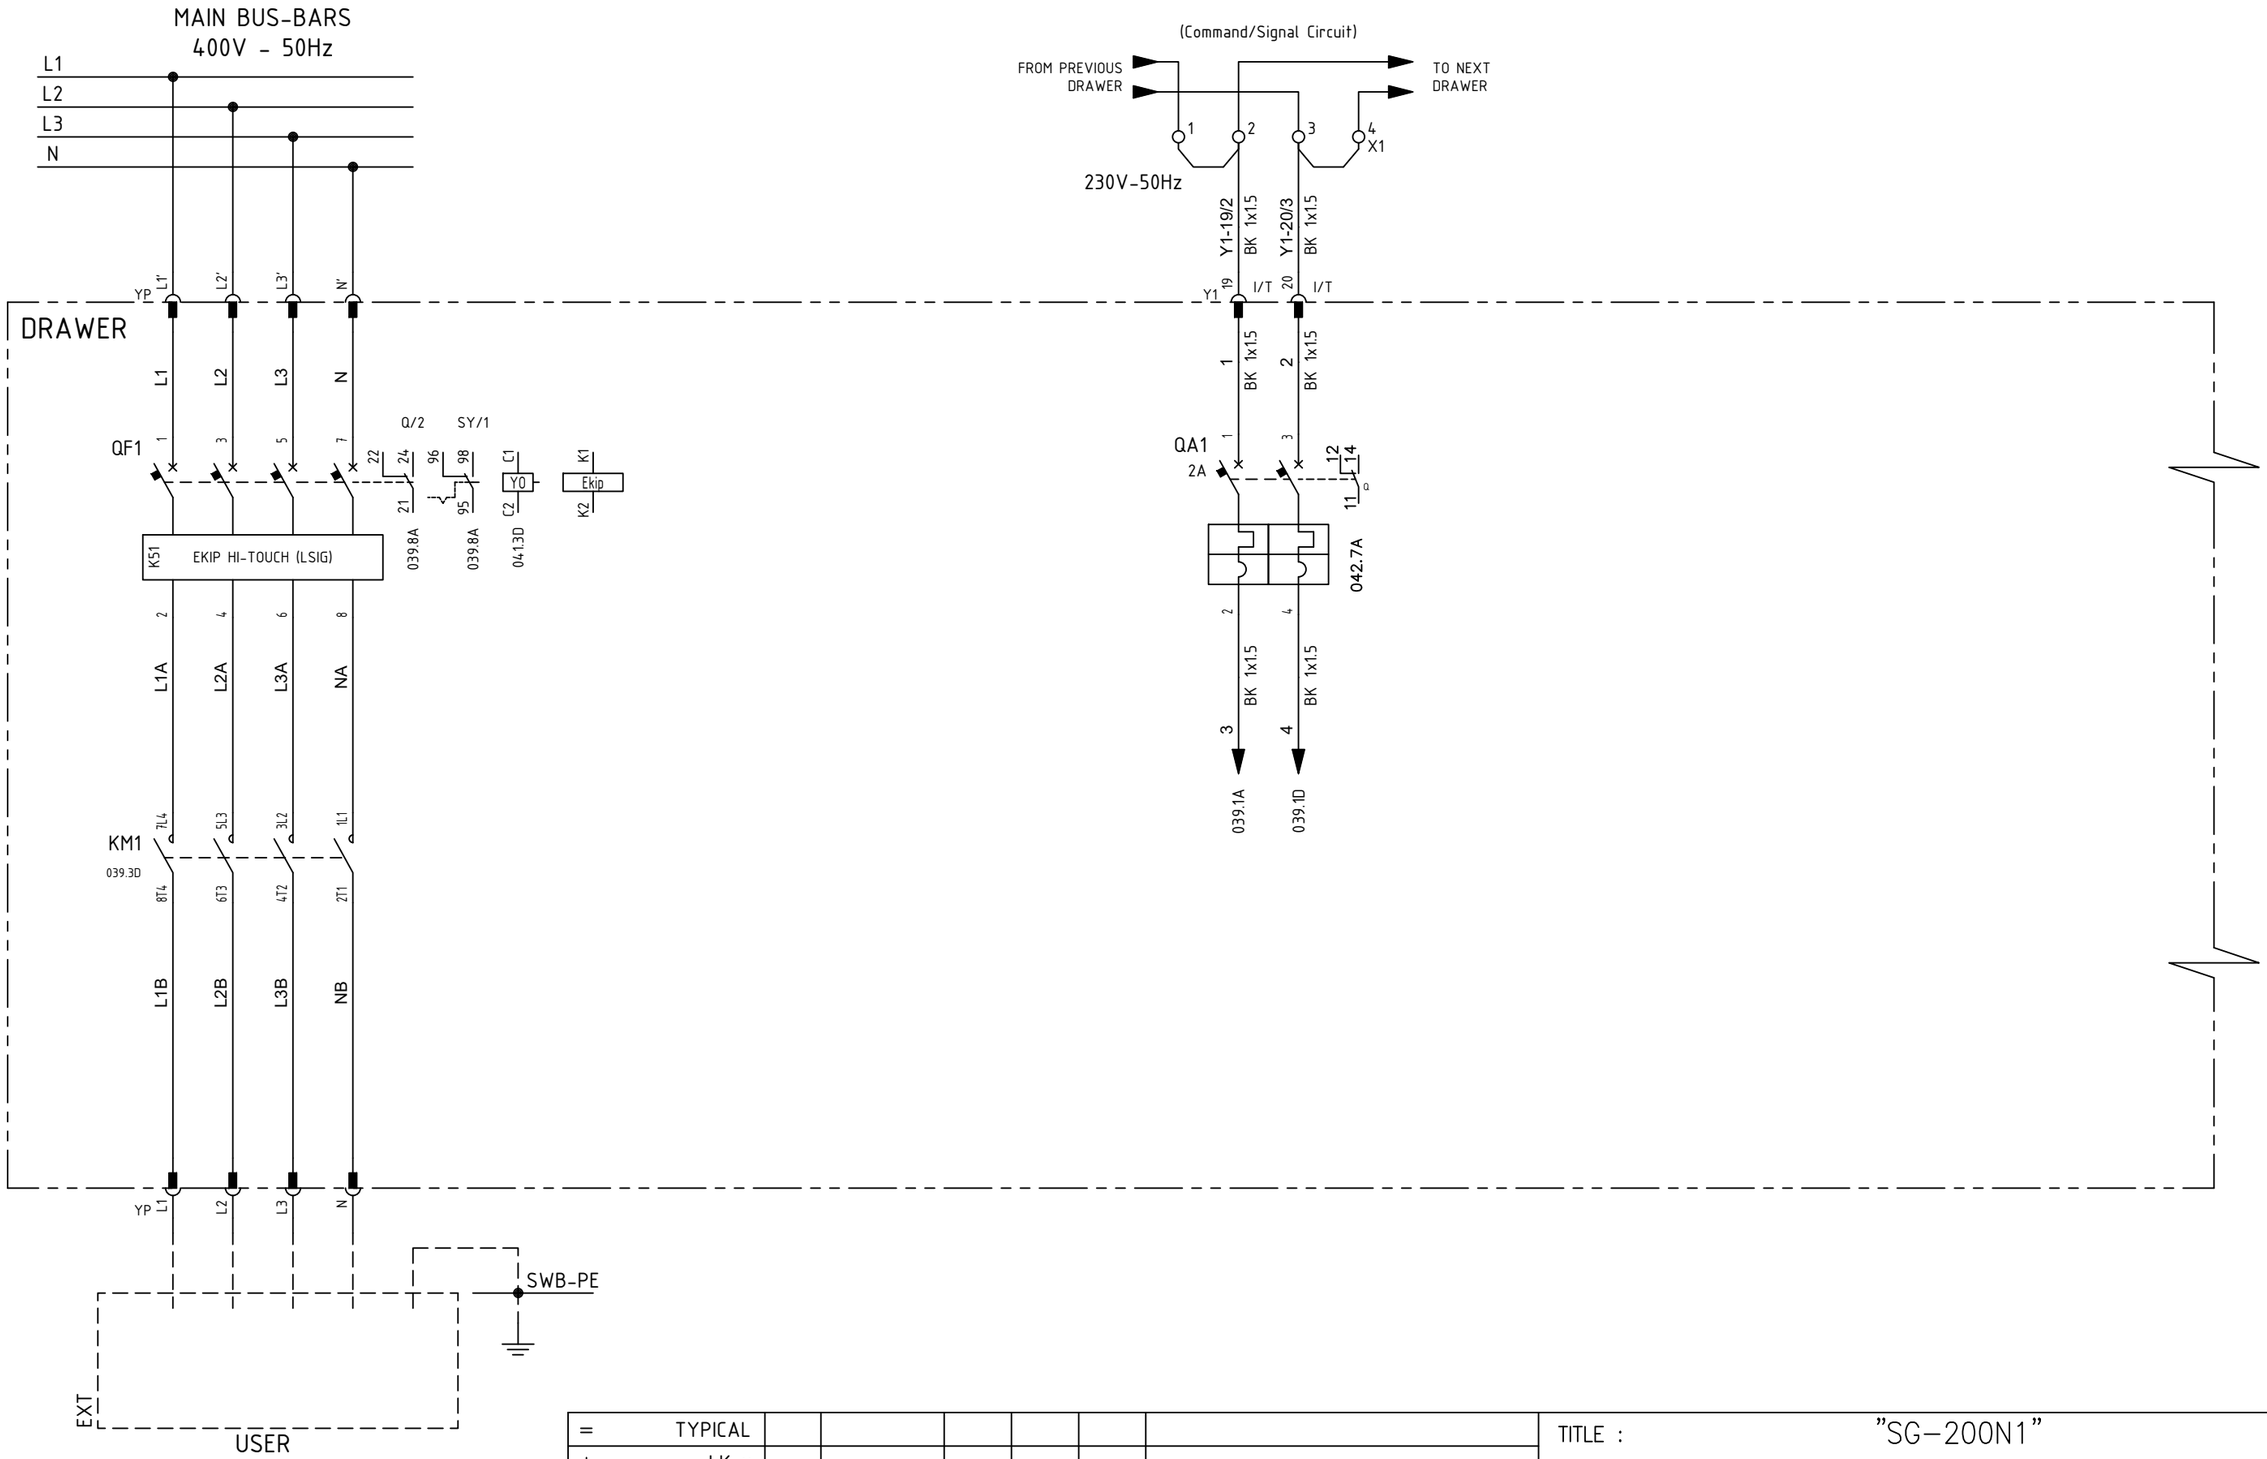

=	TYPICAL
+	LK-x

DWG n° : 231298/SD/31

Item n° : PF1002983/26

REV.	DATE	DRN	CHKD	APPD	DESCRIPTION
2	18/09/2024	Santinelli	Flamminio	Sigismondi	As Built (ASB)
1	10/07/2024	Santinelli	Flamminio	Sigismondi	Accepted for Construction (AFC)
0	09/05/2024	Santinelli	Flamminio	Sigismondi	Issued for review (IFR)

TITLE : "SG-200N1"

LV SWG FUNCTIONAL DIAGRAMS - TYPICAL FEEDERS

Functional Drawing - Typical "LK1-n" & "LK2-n"

CONTRACT NO./TITLE CW-I-WP4-2023-05/HOLLANDSE KUST NOORD WIND PARK

SCALE : NTS

A3


DRAWING NO. 1723002197-EL-DG-00031

SHEET 038

REV. 02

F.to UNI A3: 420mmx297mm

File Name : 1723002197-EL-DG-00031 Rev. 02

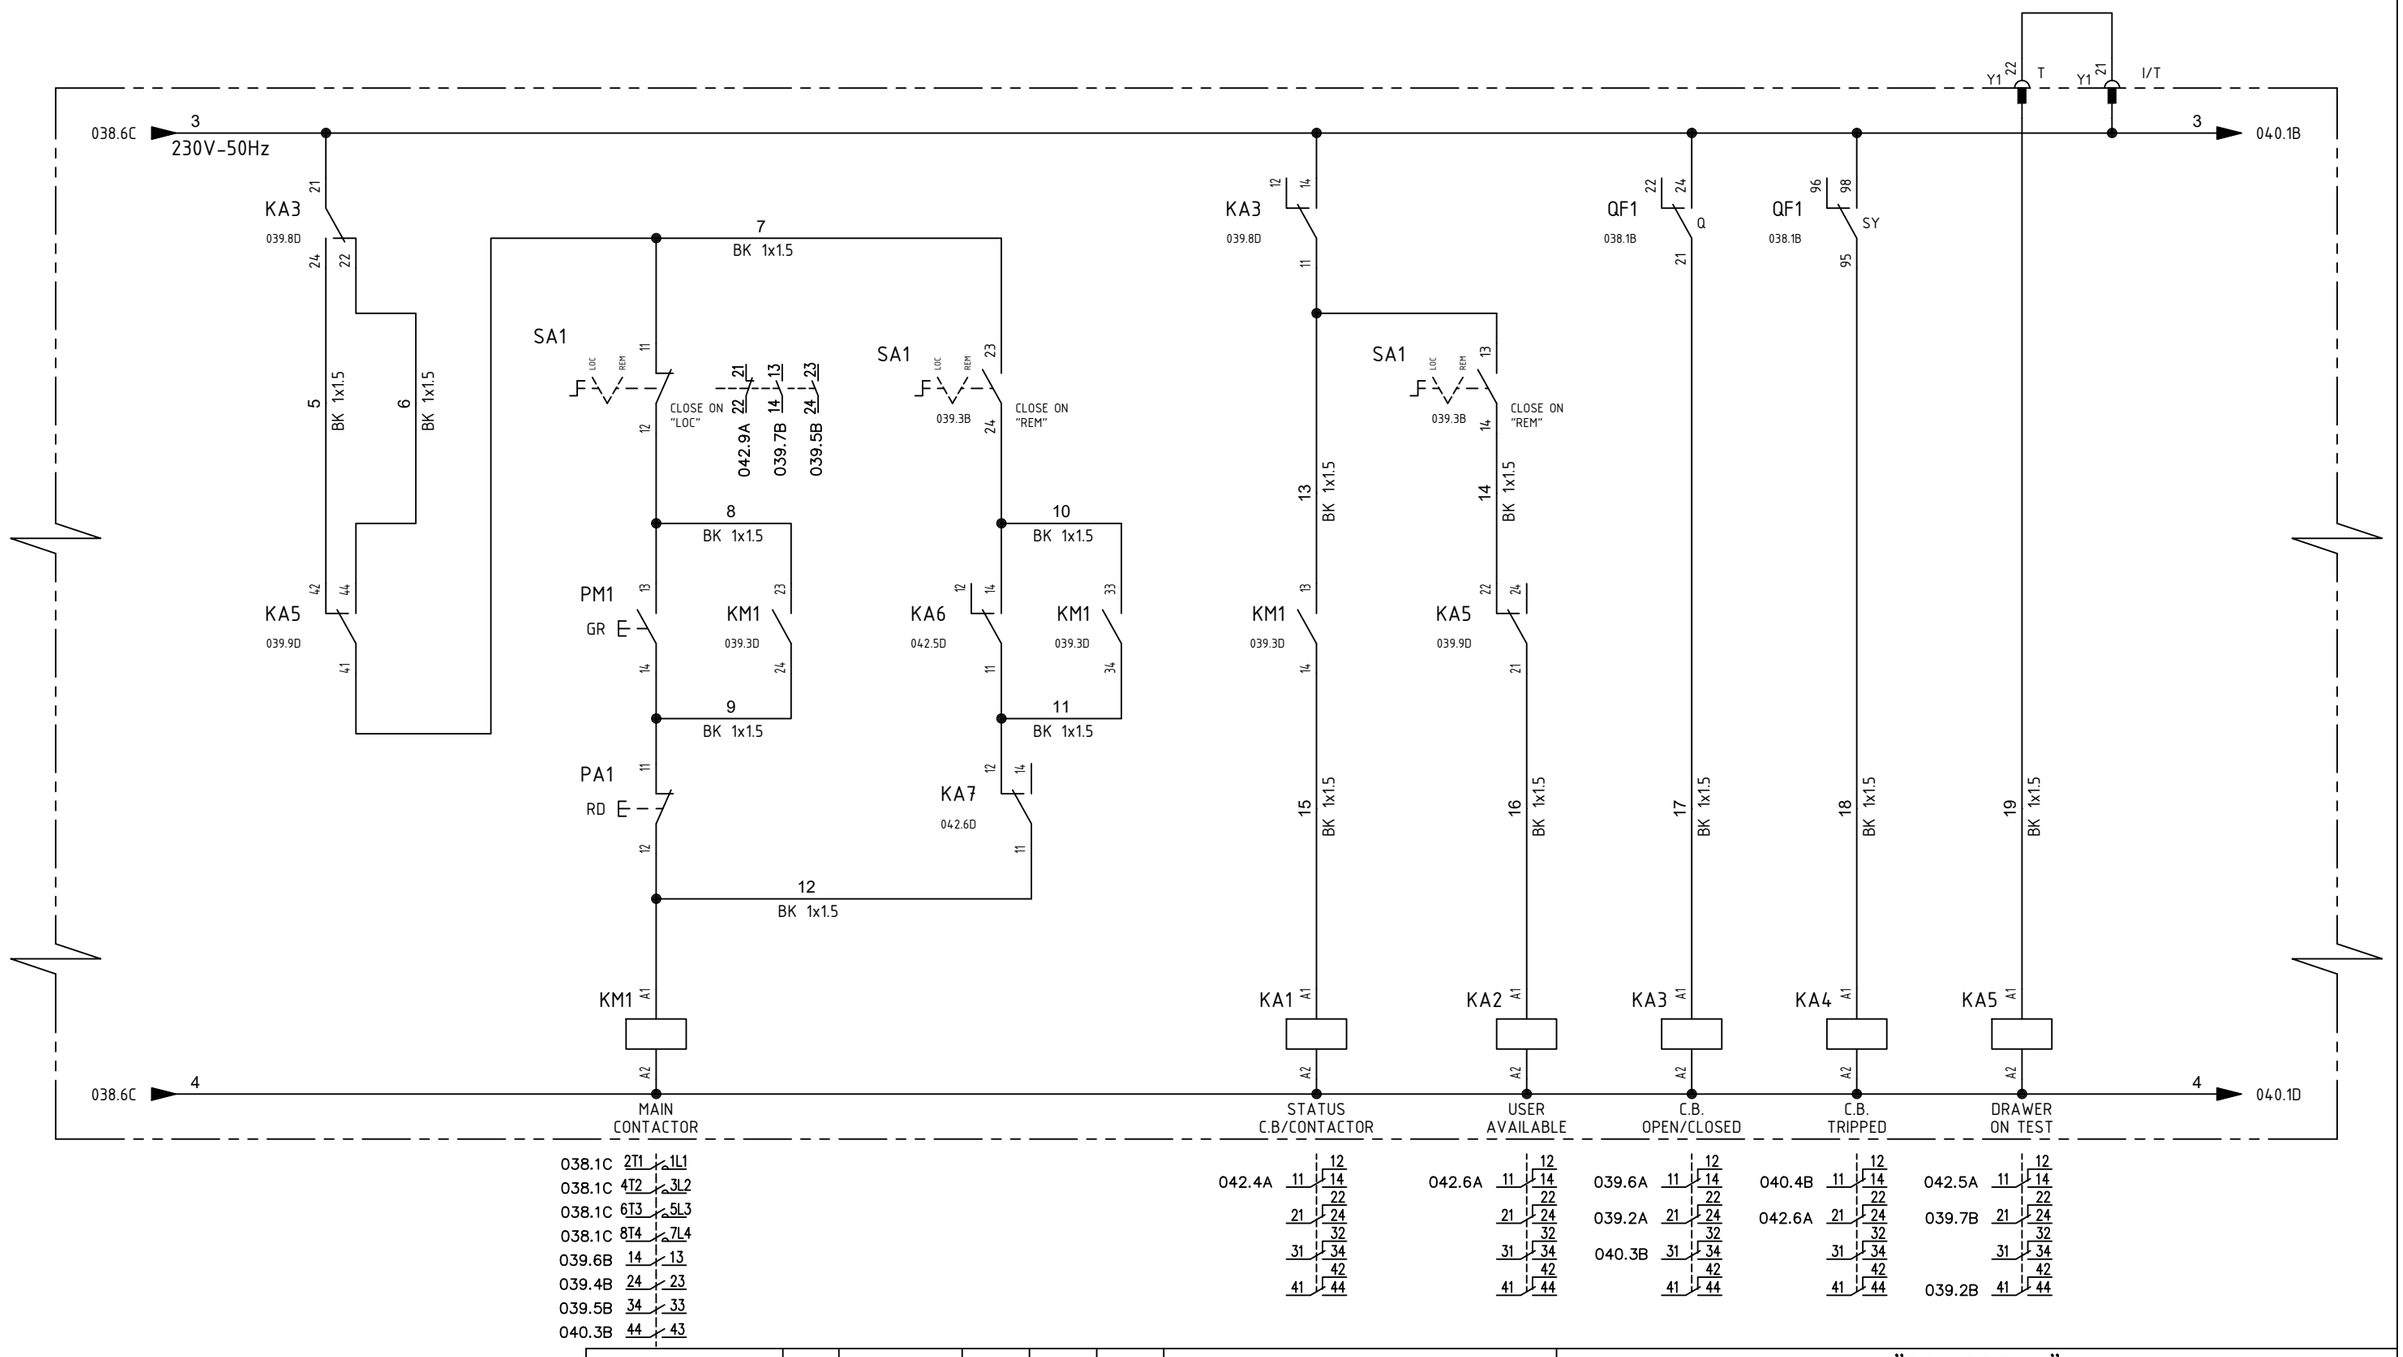

=	TYPICAL
+	LK-x

DWG n° : 231298/SD/31

Item n° : PF1002983/26

REV.	DATE	DRN	CHKD	APPD	DESCRIPTION
2	18/09/2024	Santinelli	Flamminio	Sigismondi	As Built (ASB)
1	10/07/2024	Santinelli	Flamminio	Sigismondi	Accepted for Construction (AFC)
0	09/05/2024	Santinelli	Flamminio	Sigismondi	Issued for review (IFR)

CROSSWIND

IMESA ELECTRICAL ENGINEERING

ROSETTI MARINO

TITLE : "SG-200N1"

LV SWG FUNCTIONAL DIAGRAMS - TYPICAL FEEDERS

Functional Drawing - Typical "LK1-n" & "LK2-n"

CONTRACT NO./TITLE CW-I-WP4-2023-05/HOLLANDSE KUST NOORD WIND PARK

SCALE : NTS

A3


DRAWING NO. 1723002197-EL-DG-00031

SHEET 039

REV. 02

F.to UNI A3: 420mmx297mm

File Name : 1723002197-EL-DG-00031 Rev. 02

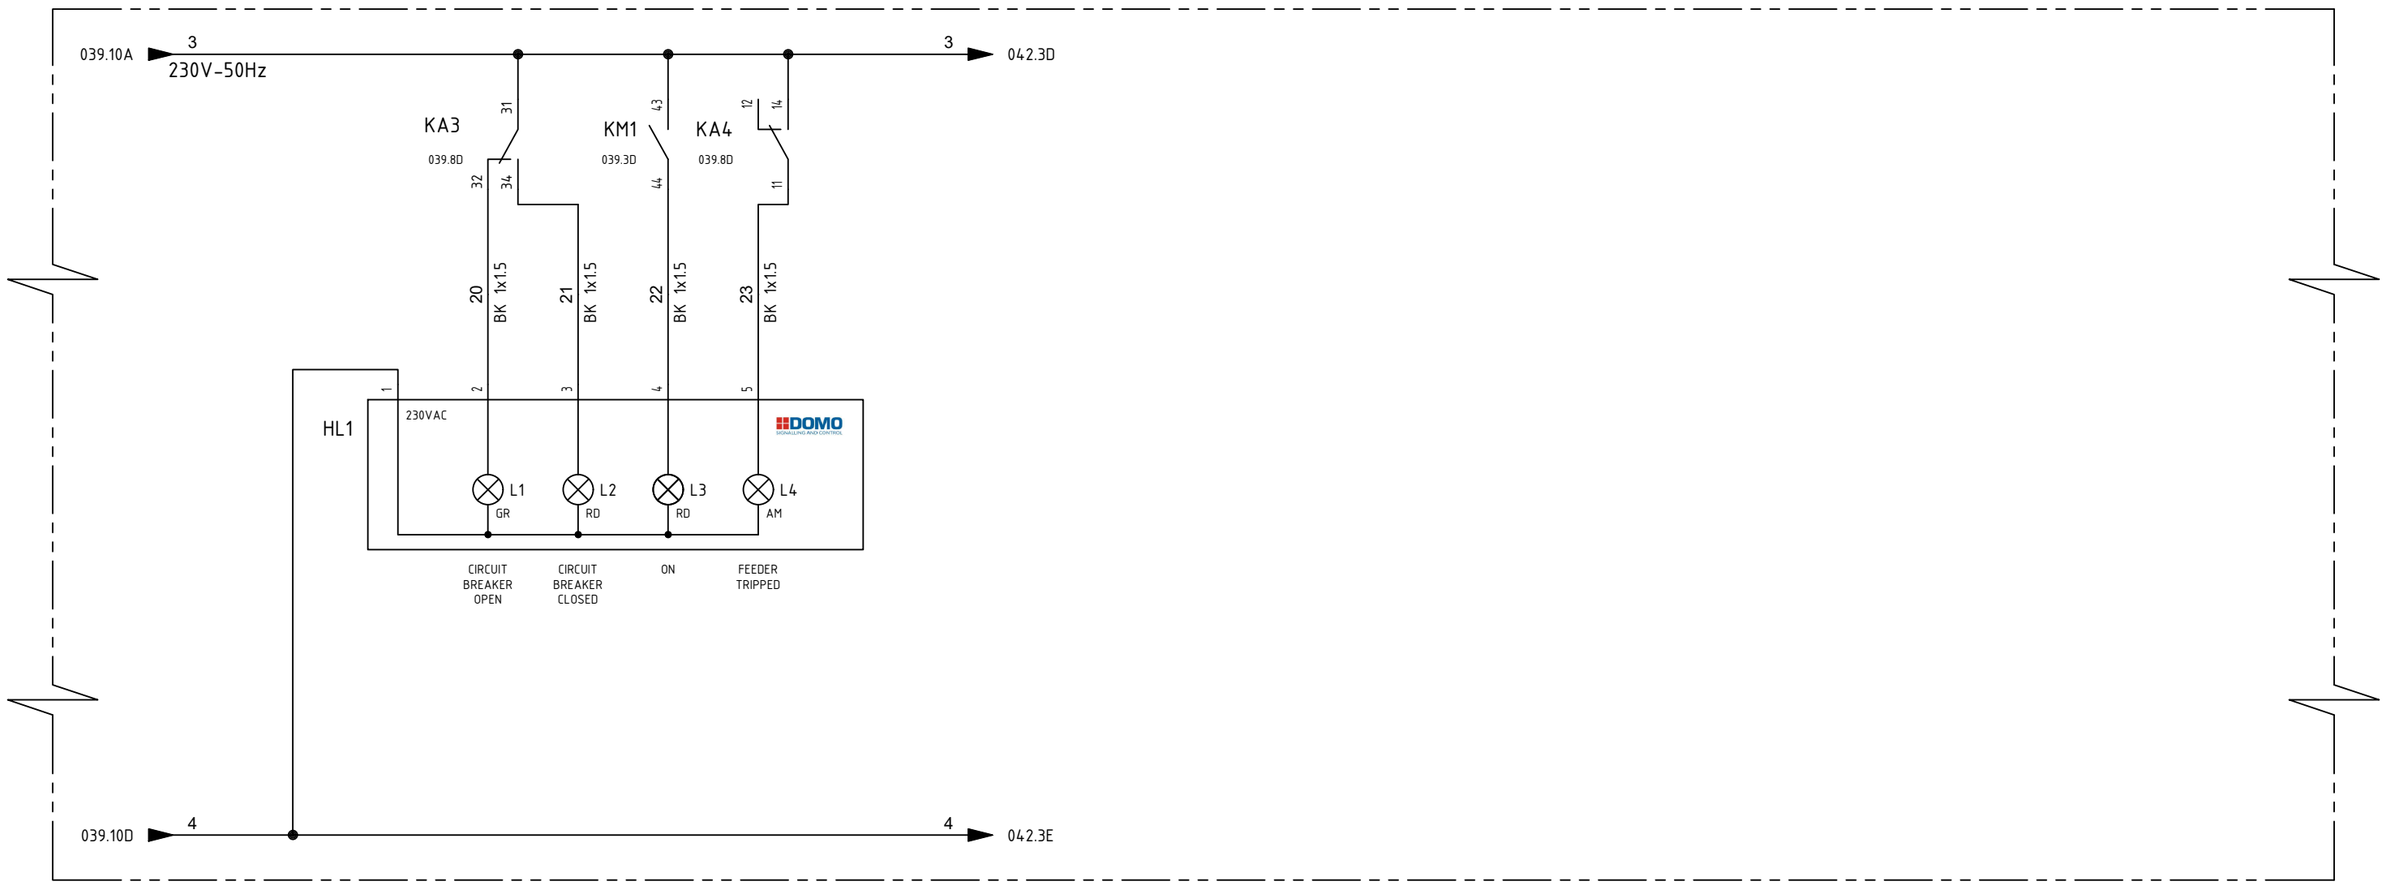

=	TYPICAL						
+	LK-x						
DWG n° : 231298/SD/31							
Item n° : PF1002983/26							
		2	18/09/2024	Santinelli	Flamminio	Sigismondi	As Built (ASB)
		1	10/07/2024	Santinelli	Flamminio	Sigismondi	Accepted for Construction (AFC)
		0	09/05/2024	Santinelli	Flamminio	Sigismondi	Issued for review (IFR)
		REV.	DATE	DRN	CHKD	APPD	DESCRIPTION

IMESA ELECTRICAL ENGINEERING

CROSSWIND

ROSETTI MARINO

TITLE : "SG-200N1"

LV SWG FUNCTIONAL DIAGRAMS - TYPICAL FEEDERS

Functional Drawing - Typical "LK1-n" & "LK2-n"

CONTRACT NO./TITLE CW-I-WP4-2023-05/HOLLANDSE KUST NOORD WIND PARK

SCALE : NTS

A3


DRAWING NO. 1723002197-EL-DG-00031

SHEET 040

REV. 02

F.to UNI A3: 420mmx297mm

File Name : 1723002197-EL-DG-00031 Rev. 02

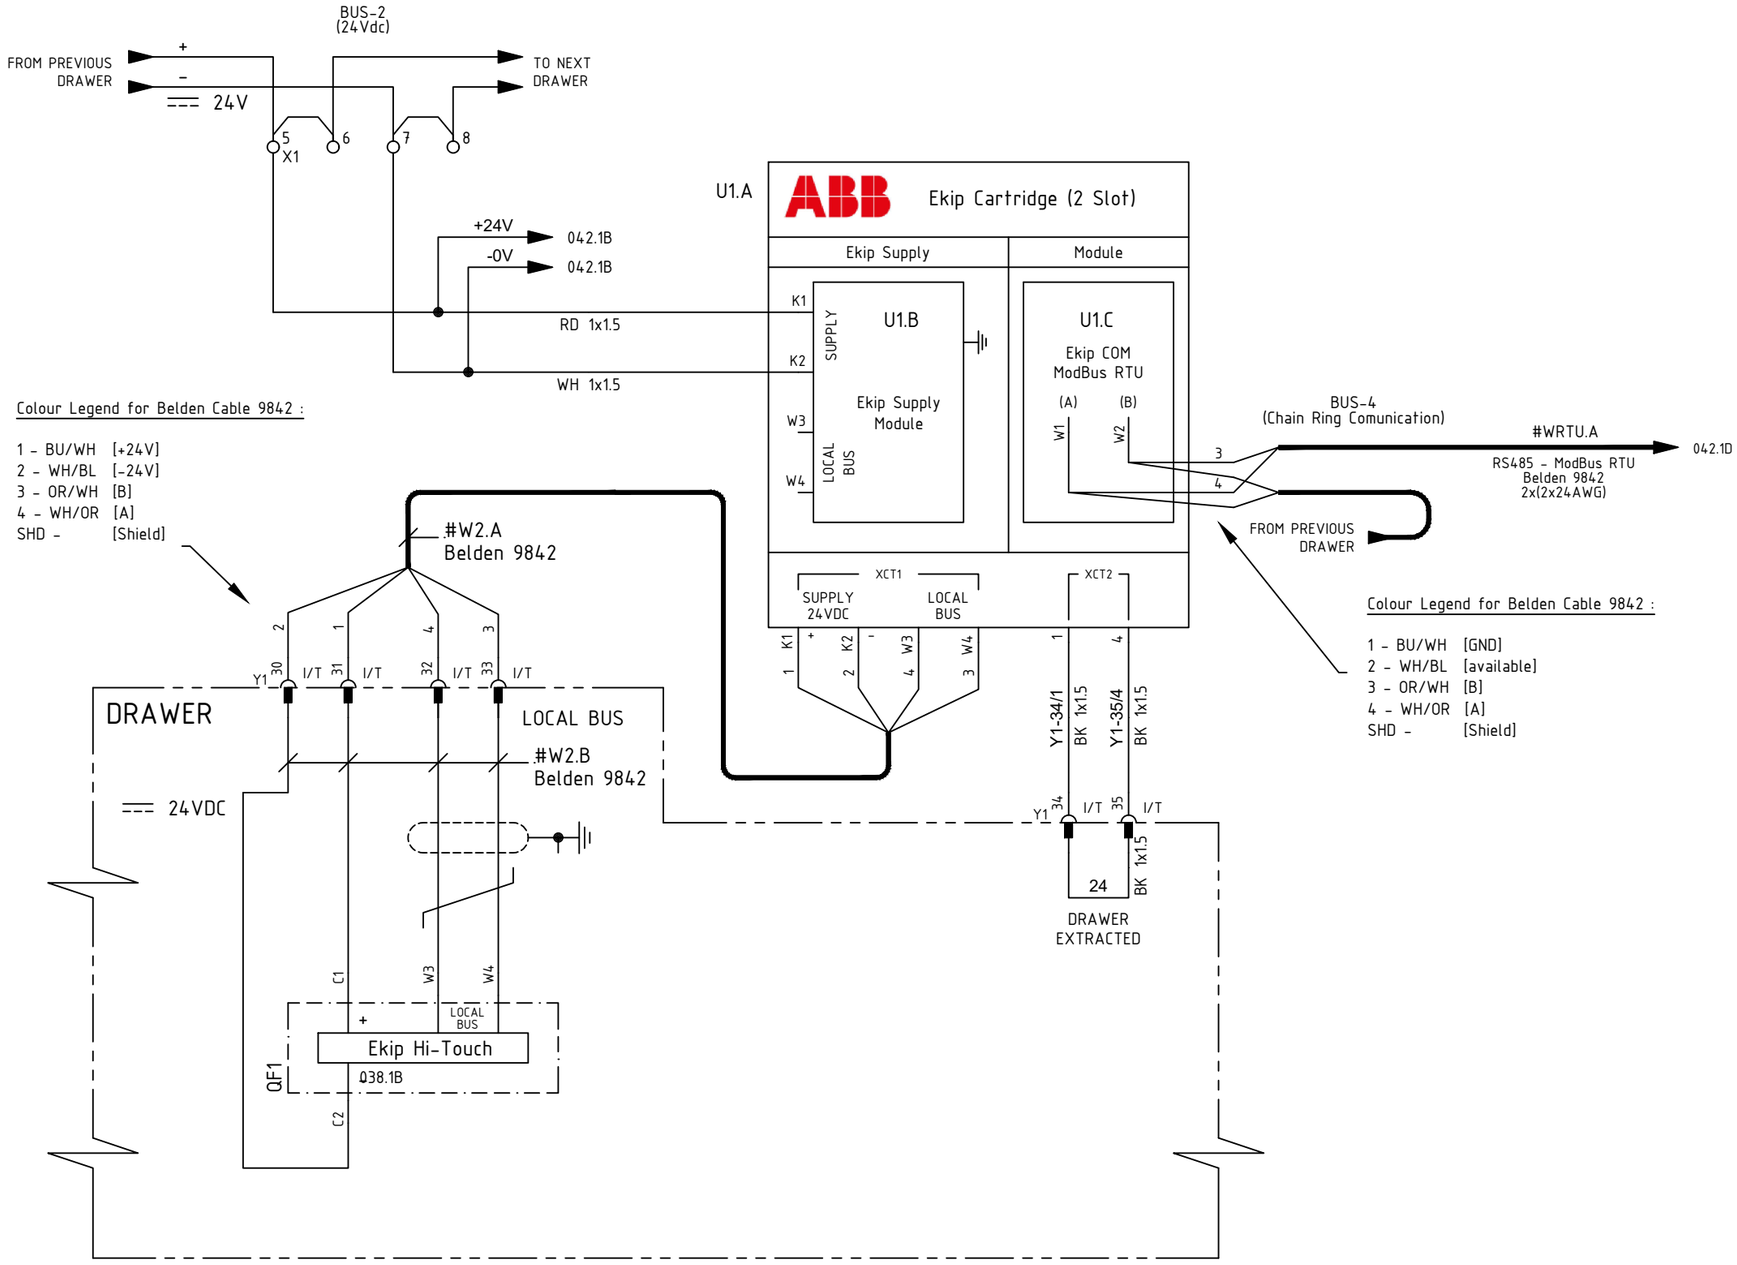

=	TYPICAL						
+	LK-x						
DWG n° : 231298/SD/31							
Item n° : PF1002983/26		2	18/09/2024	Santinelli	Flamminio	Sigismondi	As Built (ASB)
		1	10/07/2024	Santinelli	Flamminio	Sigismondi	Accepted for Construction (AFC)
		0	09/05/2024	Santinelli	Flamminio	Sigismondi	Issued for review (IFR)
		REV.	DATE	DRN	CHKD	APPD	DESCRIPTION

IMESA ELECTRICAL ENGINEERING

CROSSWIND

ROSETTI MARINO

TITLE : "SG-200N1"

LV SWG FUNCTIONAL DIAGRAMS - TYPICAL FEEDERS

Functional Drawing - Typical "LK1-n" & "LK2-n"

CONTRACT NO./TITLE CW-I-WP4-2023-05/HOLLANDSE KUST NOORD WIND PARK

SCALE : NTS

A3


DRAWING NO. 1723002197-EL-DG-00031

SHEET 041

REV. 02

F.to UNI A3: 420mmx297mm

File Name : 1723002197-EL-DG-00031 Rev. 02

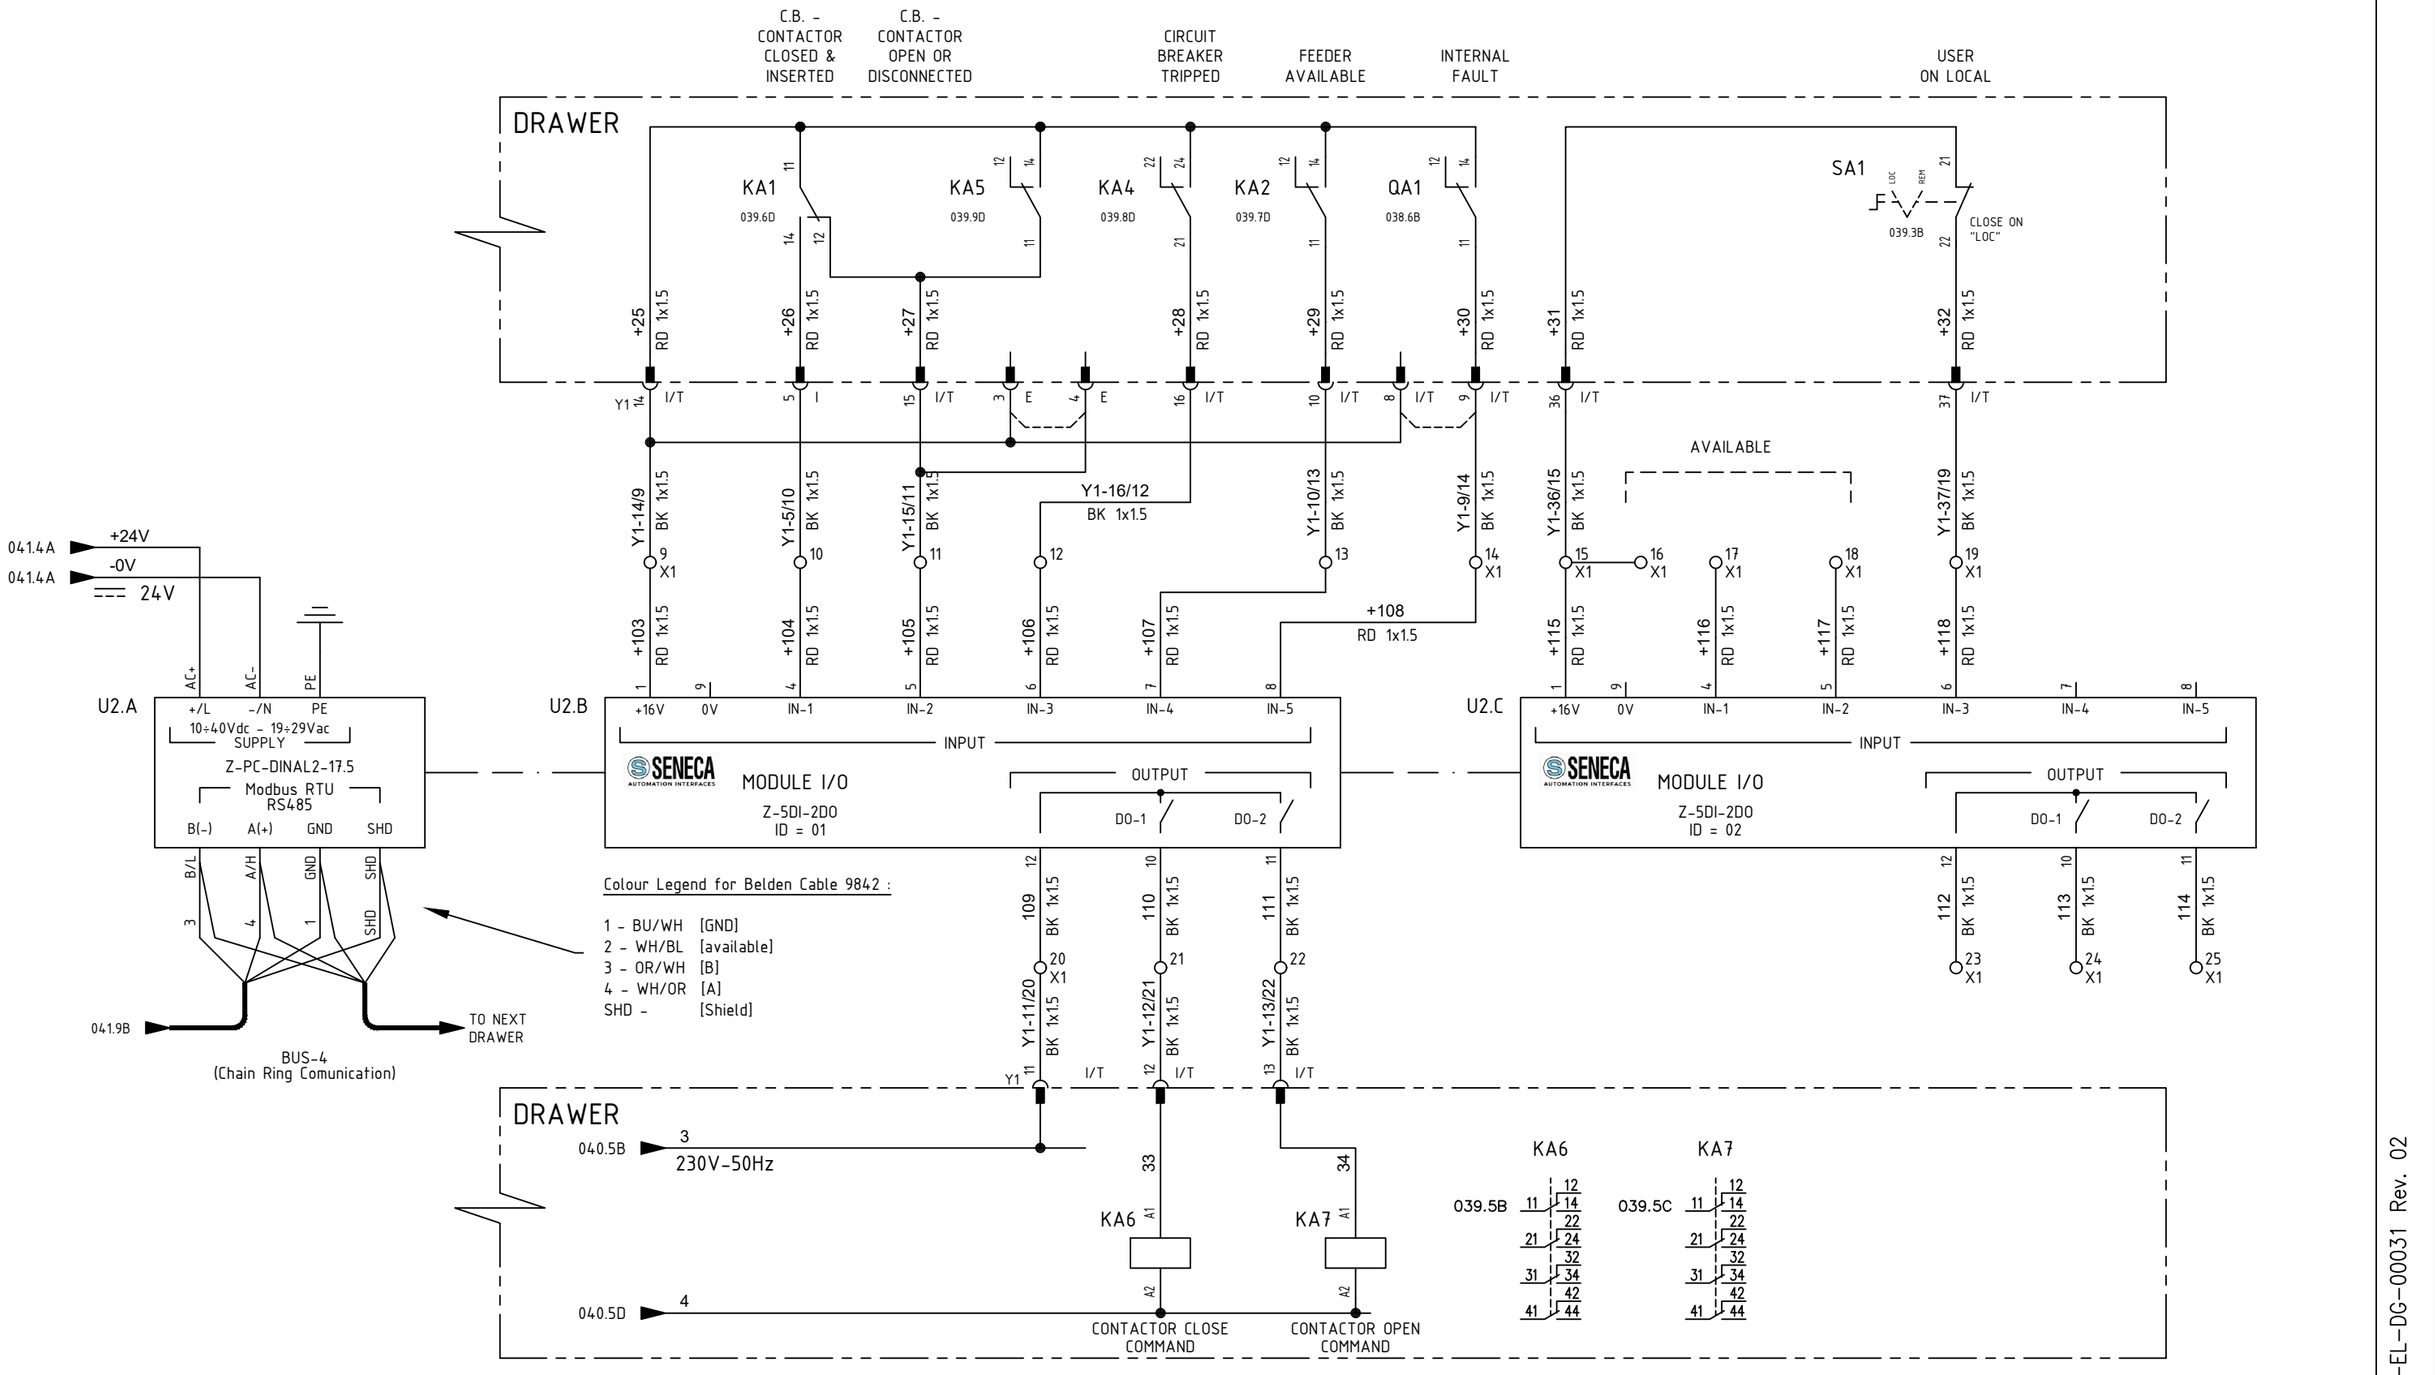

=	TYPICAL					
+	LK-x					
DWG n° : 231298/SD/31						
Item n° : PF1002983/26						
	2	18/09/2024	Santinelli	Flamminio	Sigismondi	As Built (ASB)
	1	10/07/2024	Santinelli	Flamminio	Sigismondi	Accepted for Construction (AFC)
	0	09/05/2024	Santinelli	Flamminio	Sigismondi	Issued for review (IFR)
	REV.	DATE	DRN	CHKD	APPD	DESCRIPTION

CROSSWIND

IMESA ELECTRICAL ENGINEERING

ROSETTI MARINO

TITLE : "SG-200N1"

LV SWG FUNCTIONAL DIAGRAMS - TYPICAL FEEDERS

Functional Drawing - Typical "LK1-n" & "LK2-n"

CONTRACT NO./TITLE CW-I-WP4-2023-05/HOLLANDSE KUST NOORD WIND PARK

SCALE : NTS

A3

DRAWING NO. 1723002197-EL-DG-00031

SHEET 042


REV. 02

F.to UNI A3: 420mmx297mm

File Name : 1723002197-EL-DG-00031 Rev. 02

SPECIFIC PARTS

TYPICAL : LINE FEEDER "LK1-n" "LK2-n"

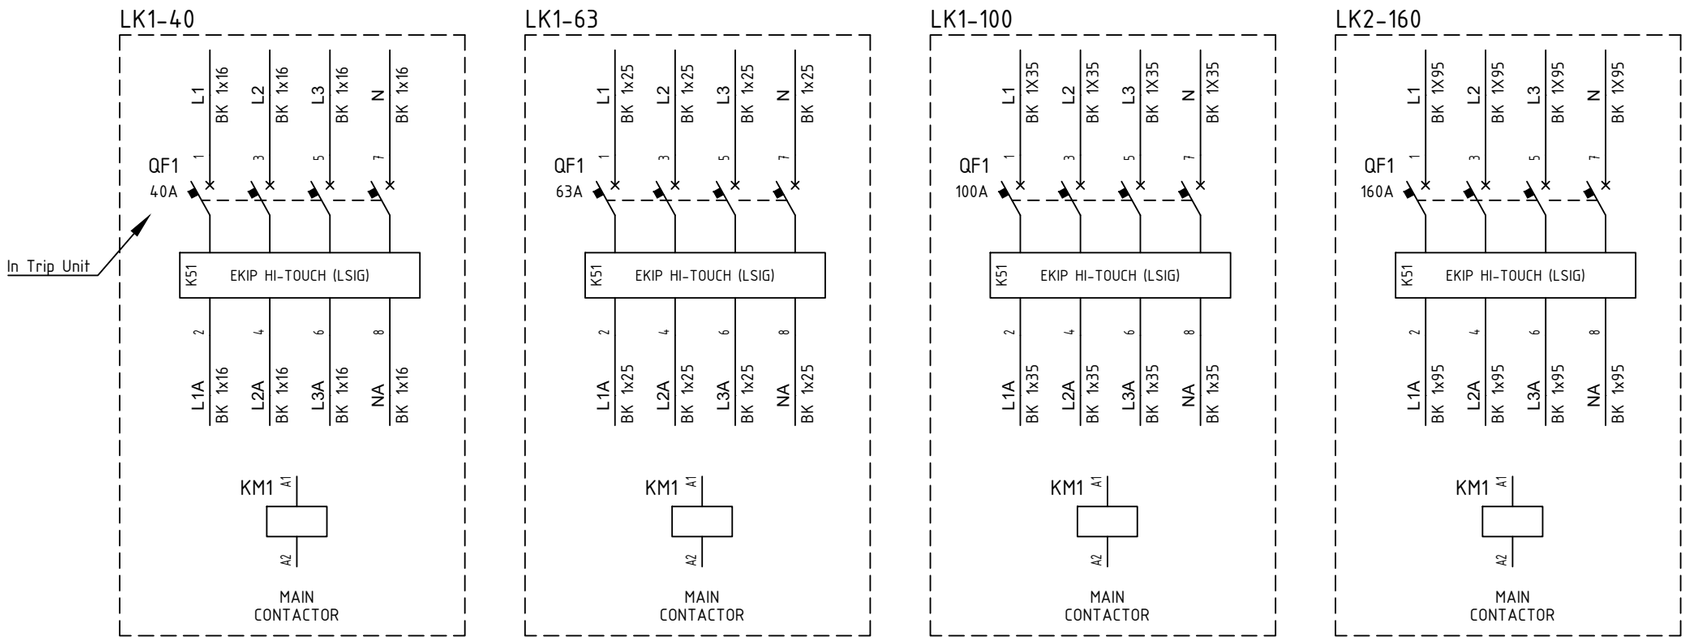

=	TYPICAL						
+	LK-x						
DWG n° : 231298/SD/31							
Item n° : PF1002983/26		2	18/09/2024	Santinelli	Flamminio	Sigismondi	As Built (ASB)
		1	10/07/2024	Santinelli	Flamminio	Sigismondi	Accepted for Construction (AFC)
		0	09/05/2024	Santinelli	Flamminio	Sigismondi	Issued for review (IFR)
		REV.	DATE	DRN	CHKD	APPD	DESCRIPTION

IMESA ELECTRICAL ENGINEERING

CROSSWIND

ROSETTI MARINO

TITLE : "SG-200N1"

LV SWG FUNCTIONAL DIAGRAMS - TYPICAL FEEDERS

Functional Drawing - Typical "LK1-n" & "LK2-n"

CONTRACT NO./TITLE CW-I-WP4-2023-05/HOLLANDSE KUST NOORD WIND PARK

SCALE : NTS

A3

DRAWING NO. 1723002197-EL-DG-00031

SHEET 043

REV. 02


F.to UNI A3: 420mmx297mm

File Name : 1723002197-EL-DG-00031 Rev. 02

TYPICAL - LK-x - Y1

AUXILIARY SOCKET
136450/001 (PF – 2 pcs) + 136458/004 (PM – 2 pcs)

N° PIN	1	2	3	4	5	6	7	8	9	10	11	12	13	14	15	16	17	18	19	20	21	22	23	24	25	26	27	28	29	30	31	32	33	34	35	36	37	38	39	40	41	42	43	44
JUMP			●	●				●	●																																			
RACKED-OUT			✕	✕				✕	✕																																			
TEST								X	X	X	X	X	X	X	X	X	X	X	X	X	X	X								X	X	X	X	X	X	X	X	X	X	X	X	X	X	X
RACKED-IN					X	X	X	X	X	X	X	X	X	X	X	X	X	X	X	X	X	X					X	X	X	X	X	X	X	X	X	X	X	X	X	X	X	X	X	
PIN USED			042.5B	042.5B	042.4B			042.6B	042.7B	042.6B	042.5D	042.5D	042.6D	042.3B	042.4B	042.6B			038.6A	038.6A	039.9A	039.9A					041.3C	041.3C	041.4C	041.4C	041.6C	041.7C	042.7B	042.9B									

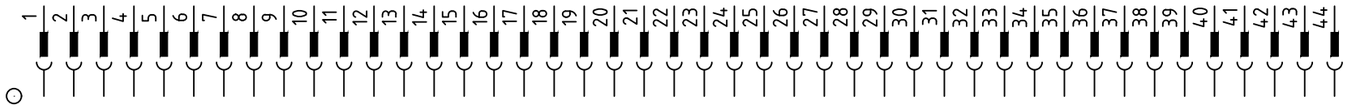

← FIELD WHIT "X" - CONTACT CLOSE WHEN DRAWER IS IN RACKED-OUT POSITION
← FIELD WHIT "X" - CONTACT CLOSE WHEN DRAWER IS IN TEST POSITION
← FIELD WHIT "X" - CONTACT CLOSE WHEN DRAWER IS IN RACKED-IN POSITION

← CROS-REFERENCE USED PIN

=	TYPICAL
+	LK-x

DWG n° : 231298/SD/31
Item n° : PF1002983/26

REV.	DATE	DRN	CHKD	APPD	DESCRIPTION
2	18/09/2024	Santinelli	Flamminio	Sigismondi	As Built (ASB)
1	10/07/2024	Santinelli	Flamminio	Sigismondi	Accepted for Construction (AFC)
0	09/05/2024	Santinelli	Flamminio	Sigismondi	Issued for review (IFR)

CROSSWIND

ROSETTI MARINO

TITLE : "SG-200N1"
LV SWG FUNCTIONAL DIAGRAMS - TYPICAL FEEDERS
Functional Drawing - Typical "LK1-n" & "LK2-n"

CONTRACT NO./TITLE CW-I-WP4-2023-05/HOLLANDSE KUST NOORD WIND PARK | SCALE : NTS

A3 | DRAWING NO. 1723002197-EL-DG-00031 | SHEET 044 | REV. 02

F.to UNI A3: 420mmx297mm

File Name : 1723002197-EL-DG-00031 Rev. 02

TYPICAL - LK-x

X1

NumM	Fg.	Sez.	Tipo	Descrizione	Costruttore
			BT003	BT/3 End bracket	Cabur
1	038.5A	2.5	HD100GR__	HMD.2/GR Two-level feed-through Terminal Block - Grey (2.5 mmq) - Spring type	Cabur
2	038.6A	2.5	HD100GR__	HMD.2/GR Two-level feed-through Terminal Block - Grey (2.5 mmq) - Spring type	Cabur
3	038.6A	2.5	HD100GR__	HMD.2/GR Two-level feed-through Terminal Block - Grey (2.5 mmq) - Spring type	Cabur
4	038.6A	2.5	HD100GR__	HMD.2/GR Two-level feed-through Terminal Block - Grey (2.5 mmq) - Spring type	Cabur
5	041.3A	2.5	HD100GR__	HMD.2/GR Two-level feed-through Terminal Block - Grey (2.5 mmq) - Spring type	Cabur
6	041.3A	2.5	HD100GR__	HMD.2/GR Two-level feed-through Terminal Block - Grey (2.5 mmq) - Spring type	Cabur
7	041.4A	2.5	HD100GR__	HMD.2/GR Two-level feed-through Terminal Block - Grey (2.5 mmq) - Spring type	Cabur
8	041.4A	2.5	HD100GR__	HMD.2/GR Two-level feed-through Terminal Block - Grey (2.5 mmq) - Spring type	Cabur
			HD101GR	HMD/PT/GR End section - Grey	Cabur
9	042.3B	2.5	HD400GR__	HMD.2N/GR Two-level feed-through Terminal Block - Grey (2.5 mmq) - Spring type	Cabur
10	042.4B	2.5	HD400GR__	HMD.2N/GR Two-level feed-through Terminal Block - Grey (2.5 mmq) - Spring type	Cabur
11	042.4B	2.5	HD400GR__	HMD.2N/GR Two-level feed-through Terminal Block - Grey (2.5 mmq) - Spring type	Cabur
12	042.5B	2.5	HD400GR__	HMD.2N/GR Two-level feed-through Terminal Block - Grey (2.5 mmq) - Spring type	Cabur
13	042.6B	2.5	HD400GR__	HMD.2N/GR Two-level feed-through Terminal Block - Grey (2.5 mmq) - Spring type	Cabur
14	042.7B	2.5	HD400GR__	HMD.2N/GR Two-level feed-through Terminal Block - Grey (2.5 mmq) - Spring type	Cabur
15	042.7B	2.5	HD400GR__	HMD.2N/GR Two-level feed-through Terminal Block - Grey (2.5 mmq) - Spring type	Cabur
16	042.7B	2.5	HD400GR__	HMD.2N/GR Two-level feed-through Terminal Block - Grey (2.5 mmq) - Spring type	Cabur
17	042.8B	2.5	HD400GR__	HMD.2N/GR Two-level feed-through Terminal Block - Grey (2.5 mmq) - Spring type	Cabur
18	042.8B	2.5	HD400GR__	HMD.2N/GR Two-level feed-through Terminal Block - Grey (2.5 mmq) - Spring type	Cabur
19	042.9B	2.5	HD400GR__	HMD.2N/GR Two-level feed-through Terminal Block - Grey (2.5 mmq) - Spring type	Cabur
20	042.5C	2.5	HD400GR__	HMD.2N/GR Two-level feed-through Terminal Block - Grey (2.5 mmq) - Spring type	Cabur
21	042.5C	2.5	HD400GR__	HMD.2N/GR Two-level feed-through Terminal Block - Grey (2.5 mmq) - Spring type	Cabur
22	042.6C	2.5	HD400GR__	HMD.2N/GR Two-level feed-through Terminal Block - Grey (2.5 mmq) - Spring type	Cabur
23	042.9C	2.5	HD400GR__	HMD.2N/GR Two-level feed-through Terminal Block - Grey (2.5 mmq) - Spring type	Cabur
24	042.9C	2.5	HD400GR__	HMD.2N/GR Two-level feed-through Terminal Block - Grey (2.5 mmq) - Spring type	Cabur
25	042.10C	2.5	HD400GR__	HMD.2N/GR Two-level feed-through Terminal Block - Grey (2.5 mmq) - Spring type	Cabur
			HD201GR	HMD.1/PT/GR End section - Grey	Cabur
			BT003	BT/3 End bracket	Cabur

= TYPICAL

\+ LK-x

DWG n° : 231298/SD/31

Item n° : PF1002983/26

REV.	DATE	DRN	CHKD	APPD	DESCRIPTION
2	18/09/2024	Santinelli	Flamminio	Sigismondi	As Built (ASB)
1	10/07/2024	Santinelli	Flamminio	Sigismondi	Accepted for Construction (AFC)
0	09/05/2024	Santinelli	Flamminio	Sigismondi	Issued for review (IFR)

CROSSWIND

ROSETTI MARINO

TITLE : "SG-200N1"

LV SWG FUNCTIONAL DIAGRAMS - TYPICAL FEEDERS

Functional Drawing - Typical "LK1-n" & "LK2-n"

CONTRACT NO./TITLE CW-I-WP4-2023-05/HOLLANDSE KUST NOORD WIND PARK

SCALE : NTS

A3

DRAWING NO. 1723002197-EL-DG-00031

SHEET 045

REV. 02

F.to UNI A3: 420mmx297mm

File Name : 1723002197-EL-DG-00031 Rev. 02

Nome/Item	Fg/Sh	Tipo/Type	Q.ta/Q.ty	Descrizione/Description	Costruttore/Manufacturer	Quadro (descrizione)
HL1	040	ML22/484L230STLTTR	1	MULTILED 48x48 - 4 LED - Vaux=230Vac/dc + LAMP TEST + TROP	DOMO	TYPICAL LK-x
KA1	039	ER 592 6	1	CR-M230AC4L SUPPLY 230VAC 4C/O 250V/6A LED	ABB	TYPICAL LK-x
		ER 609 8	1	CR-MH HOLDER FOR CR-M RELAY	ABB	TYPICAL LK-x
		ER 686 6	1	CR-M4SS SOCKET STANDARD X 2/4 C/O(CR-M)	ABB	TYPICAL LK-x
KA2	039	ER 592 6	1	CR-M230AC4L SUPPLY 230VAC 4C/O 250V/6A LED	ABB	TYPICAL LK-x
		ER 609 8	1	CR-MH HOLDER FOR CR-M RELAY	ABB	TYPICAL LK-x
		ER 686 6	1	CR-M4SS SOCKET STANDARD X 2/4 C/O(CR-M)	ABB	TYPICAL LK-x
KA3	039	ER 592 6	1	CR-M230AC4L SUPPLY 230VAC 4C/O 250V/6A LED	ABB	TYPICAL LK-x
		ER 609 8	1	CR-MH HOLDER FOR CR-M RELAY	ABB	TYPICAL LK-x
		ER 686 6	1	CR-M4SS SOCKET STANDARD X 2/4 C/O(CR-M)	ABB	TYPICAL LK-x
KA4	039	ER 592 6	1	CR-M230AC4L SUPPLY 230VAC 4C/O 250V/6A LED	ABB	TYPICAL LK-x
		ER 609 8	1	CR-MH HOLDER FOR CR-M RELAY	ABB	TYPICAL LK-x
		ER 686 6	1	CR-M4SS SOCKET STANDARD X 2/4 C/O(CR-M)	ABB	TYPICAL LK-x
KA5	039	ER 592 6	1	CR-M230AC4L SUPPLY 230VAC 4C/O 250V/6A LED	ABB	TYPICAL LK-x
		ER 609 8	1	CR-MH HOLDER FOR CR-M RELAY	ABB	TYPICAL LK-x
		ER 686 6	1	CR-M4SS SOCKET STANDARD X 2/4 C/O(CR-M)	ABB	TYPICAL LK-x
KA6	042	ER 592 6	1	CR-M230AC4L SUPPLY 230VAC 4C/O 250V/6A LED	ABB	TYPICAL LK-x
		ER 609 8	1	CR-MH HOLDER FOR CR-M RELAY	ABB	TYPICAL LK-x
		ER 686 6	1	CR-M4SS SOCKET STANDARD X 2/4 C/O(CR-M)	ABB	TYPICAL LK-x
KA7	042	ER 592 6	1	CR-M230AC4L SUPPLY 230VAC 4C/O 250V/6A LED	ABB	TYPICAL LK-x
		ER 609 8	1	CR-MH HOLDER FOR CR-M RELAY	ABB	TYPICAL LK-x
		ER 686 6	1	CR-M4SS SOCKET STANDARD X 2/4 C/O(CR-M)	ABB	TYPICAL LK-x
PA1	039	KW 075 2	1	MP1-10R PUSH BUTTON RED WITH BLACK RING	ABB	TYPICAL LK-x
		EO 569 7	1	MCBH-00 FIXING SUPPORT 3 CONTACTS	ABB	TYPICAL LK-x
		EO 571 3	2	MCB-01 CONTACT NC FOR PUSHBUTTOM	ABB	TYPICAL LK-x
PM1	039	KW 076 0	1	MP1-10G PUSH BUTTON GREEN WITH BLACK RING	ABB	TYPICAL LK-x
		EO 569 7	1	MCBH-00 FIXING SUPPORT 3 CONTACTS	ABB	TYPICAL LK-x
		EO 570 5	2	MCB-10 CONTACT NO FOR PUSHBUTTONS	ABB	TYPICAL LK-x
QA1	038	S550239	1	S202M C 2 AUTOMATIC CIRCUIT BREAKER 10KA 2P	ABB	TYPICAL LK-x
		A563819	1	S2-CS/H6R AUXILIARY STATE CONTACT 1CO	ABB	TYPICAL LK-x
SA1	039	KW 329 3	1	M2SS2-10B HANDLE SELECTOR 2P 90° BLACK RING BLACK	ABB	TYPICAL LK-x
		EO 569 7	1	MCBH-00 FIXING SUPPORT 3 CONTACTS	ABB	TYPICAL LK-x
		EO 570 5	2	MCB-10 CONTACT NO FOR PUSHBUTTONS	ABB	TYPICAL LK-x
		EO 571 3	2	MCB-01 CONTACT NC FOR PUSHBUTTOM	ABB	TYPICAL LK-x
U1.2	041	1SDA074173R1	1	MODUL EKIP SUPPLY 24÷48VDC	ABB	TYPICAL LK-x
U1.3	041	1SDA105166R1	1	Module Ekip Com Modbus RS485 Tmax XT	ABB	TYPICAL LK-x
U1.A	041	1SDA105203R1	1	EKIP CARTRIDGE 2SLOT FOR XT2-XT4-XT5	ABB	TYPICAL LK-x
U2.A	042	Z-PC-DINAL2-17.5	1	DIN RAIL 2SLOT WITH HEAD FOR "Z-5DI-2DO"	SENECA	TYPICAL LK-x
U2.B	042	Z-5DI-2DO	1	I/O MODUL 5DI+2DO modbus RS485 Vaux=10÷40Vdc 19÷28Vac	SENECA	TYPICAL LK-x
U2.C	042	Z-5DI-2DO	1	I/O MODUL 5DI+2DO modbus RS485 Vaux=10÷40Vdc 19÷28Vac	SENECA	TYPICAL LK-x
X1		HD100GR__	8	HMD.2/GR Two-level feed-through Terminal Block - Grey (2.5 mmq) - Spring type	Cabur	TYPICAL LK-x
		HD400GR__	17	HMD.2N/GR Two-level feed-through Terminal Block - Grey (2.5 mmq) - Spring type	Cabur	TYPICAL LK-x
		BT003	2	BT/3 End bracket	Cabur	TYPICAL LK-x
		HD101GR	1	HMD/PT/GR End section - Grey	Cabur	TYPICAL LK-x

= TYPICAL
\+ LK-x

DWG n° : 231298/SD/31
Item n° : PF1002983/26

REV.	DATE	DRN	CHKD	APPD	DESCRIPTION
2	18/09/2024	Santinelli	Flamminio	Sigismondi	As Built (ASB)
1	10/07/2024	Santinelli	Flamminio	Sigismondi	Accepted for Construction (AFC)
0	09/05/2024	Santinelli	Flamminio	Sigismondi	Issued for review (IFR)

CROSSWIND

ROSETTI MARINO

TITLE : "SG-200N1"

LV SWG FUNCTIONAL DIAGRAMS - TYPICAL FEEDERS

Functional Drawing - Typical "LK1-n" & "LK2-n"

CONTRACT NO./TITLE CW-I-WP4-2023-05/HOLLANDSE KUST NOORD WIND PARK | SCALE : NTS

A3 | DRAWING NO. 1723002197-EL-DG-00031 | SHEET 046 | REV. 02

F.to UNI A3: 420mmx297mm

File Name : 1723002197-EL-DG-00031 Rev. 02

Nome/Item	Fg/Sh	Tipo/Type	Q.ta/Q.ty	Descrizione/Description	Costruttore/Manufacturer	Quadro (descrizione)
X1		HD201GR	1	HMD.1/PT/GR End section - Grey	Cabur	TYPICAL LK-x

Nome/Item	Fg/Sh	Tipo/Type	Q.ta/Q.ty	Descrizione/Description	Costruttore/Manufacturer	Quadro (descrizione)
KM1	043	AF40400013	1	AF40-40-00-13 CONTACTOR 4P 40A 100-250VAC/DC	ABB	TYPICAL LK1-40
		CA440E	1	CA4-40E AUXILIARY FRONT CONTACT 4NO	ABB	TYPICAL LK1-40
QF1	043	1SDA068169R1	1	XT2S 160 BREAKING PART 4p F F	ABB	TYPICAL LK1-40
		1SDA100162R1	1	ELECTRONIC TRIP RELEASE Ekip Hi-Touch LSIG In=40A XT2 4p	ABB	TYPICAL LK1-40
		1SDA066431R1	1	AUX-C 1Q+1SY 250Vac/dc XT1..XT5 F/P	ABB	TYPICAL LK1-40

Nome/Item	Fg/Sh	Tipo/Type	Q.ta/Q.ty	Descrizione/Description	Costruttore/Manufacturer	Quadro (descrizione)
KM1	043	AF52400013	1	AF52-30-00-13 CONTACTOR 4P 53A(AC3) 100-250VAC/DC	ABB	TYPICAL LK1-63
		CA440E	1	CA4-40E AUXILIARY FRONT CONTACT 4NO	ABB	TYPICAL LK1-63
QF1	043	1SDA068169R1	1	XT2S 160 BREAKING PART 4p F F	ABB	TYPICAL LK1-63
		1SDA100163R1	1	ELECTRONIC TRIP RELEASE Ekip Hi-Touch LSIG In=63A XT2 4p	ABB	TYPICAL LK1-63
		1SDA066431R1	1	AUX-C 1Q+1SY 250Vac/dc XT1..XT5 F/P	ABB	TYPICAL LK1-63

Nome/Item	Fg/Sh	Tipo/Type	Q.ta/Q.ty	Descrizione/Description	Costruttore/Manufacturer	Quadro (descrizione)
KM1	043	AF80400013	1	AF80-30-00-13 CONTACTOR 4P 80A(AC3) 100-250VAC/DC	ABB	TYPICAL LK1-100
		CA440E	1	CA4-40E AUXILIARY FRONT CONTACT 4NO	ABB	TYPICAL LK1-100
QF1	043	1SDA068169R1	1	XT2S 160 BREAKING PART 4p F F	ABB	TYPICAL LK1-100
		1SDA100164R1	1	ELECTRONIC TRIP RELEASE Ekip Hi-Touch LSIG In=100A XT2 4p	ABB	TYPICAL LK1-100
		1SDA066431R1	1	AUX-C 1Q+1SY 250Vac/dc XT1..XT5 F/P	ABB	TYPICAL LK1-100

Nome/Item	Fg/Sh	Tipo/Type	Q.ta/Q.ty	Descrizione/Description	Costruttore/Manufacturer	Quadro (descrizione)
KM1	043	AF190401113	1	AF190-40-11-13 CONT 4P 190A AC3 100-250VAC/DC	ABB	TYPICAL LK2-160
		CAL1911	1	CAL19-11 CONTATTO AUSILIARIO 1NA+1NC PER AF116÷AF370	ABB	TYPICAL LK2-160
		CAL1911B	2	CAL19-11B AUXILIARY CONTACT 1NA+1NC PER AF116÷AF370	ABB	TYPICAL LK2-160
QF1	043	1SDA068179R1	1	XT4S 250 BREAKING PART 4p F F	ABB	TYPICAL LK2-160
		1SDA100334R1	1	ELECTRONIC TRIP RELEASE Ekip Hi-Touch LSIG In=160A XT4 4p	ABB	TYPICAL LK2-160
		1SDA066431R1	1	AUX-C 1Q+1SY 250Vac/dc XT1..XT5 F/P	ABB	TYPICAL LK2-160

= TYPICAL
+ LK-x

DWG n° : 231298/SD/31
Item n° : PF1002983/26

REV.	DATE	DRN	CHKD	APPD	DESCRIPTION
2	18/09/2024	Santinelli	Flamminio	Sigismondi	As Built (ASB)
1	10/07/2024	Santinelli	Flamminio	Sigismondi	Accepted for Construction (AFC)
0	09/05/2024	Santinelli	Flamminio	Sigismondi	Issued for review (IFR)

TITLE : "SG-200N1"

LV SWG FUNCTIONAL DIAGRAMS - TYPICAL FEEDERS


Functional Drawing - Typical "LK1-n" & "LK2-n"

CONTRACT NO./TITLE CW-I-WP4-2023-05/HOLLANDSE KUST NOORD WIND PARK | SCALE : NTS

A3 | DRAWING NO. 1723002197-EL-DG-00031 | SHEET 047 | REV. 02

F.to UNI A3: 420mmx297mm

File Name : 1723002197-EL-DG-00031 Rev. 02

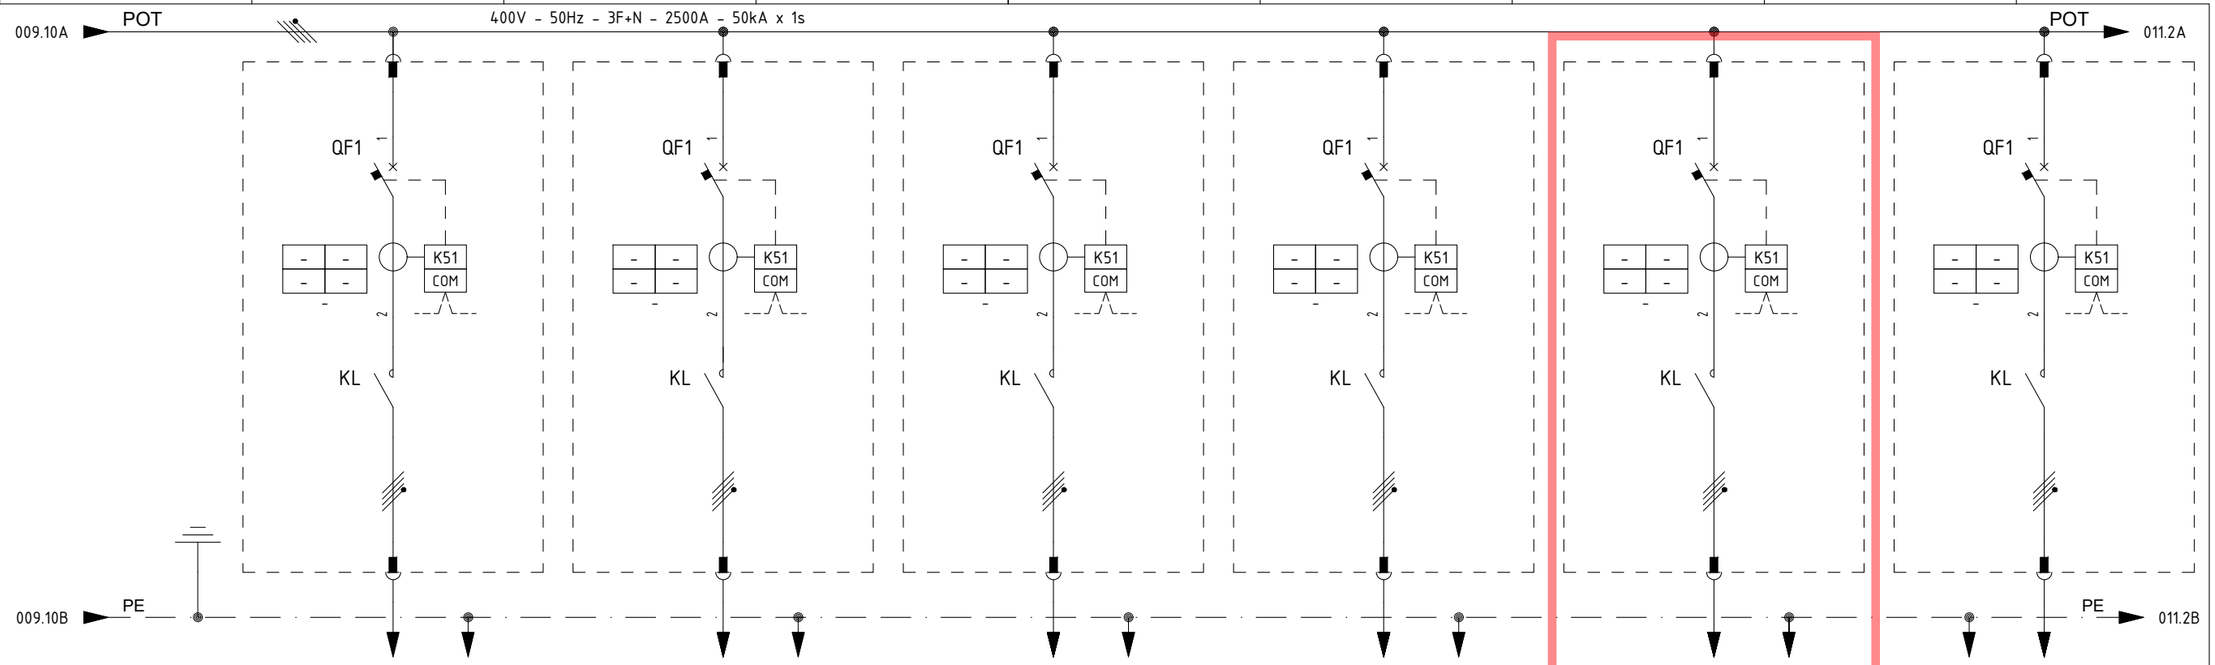

ITEM			1	SPARE	B200-HSB-001	B300-HSB-001	B400-HSB-001	CN-200N1	SPARE
UTILITY			2	SPARE	HVAC PANELS - LV ROOM	HVAC PANELS - UPS ROOM	HVAC PANELS - ITER	IMPRESSED CURR. CATHODIC PROTECTION (ICCP) SYSTEM	SPARE
COLUMN/CUBICLE			3	A5 / +01	A5 / +02	A5 / +03	A5 / +04	A5 / +05	A5 / +06
RATED POWER | RATED CURRENT			4/5	15 kW | 24.0 A	18 kW | 34.1 A	35,75 kW | 61 A	35,75 kW | 61 A	14 kVA | 23.8 A	- kW | - A
TYPICAL FUNCTIONAL			6	LK1-40	LK1-40	LK1-63	LK1-63	LK1-40	LK1-40
CIRCUIT BREAKER (ABB)	TYPE		7	XT2S - 160	XT2S - 160	XT2S - 160	XT2S - 160	XT2S - 160	XT2S - 160
	VERSION		8	4P - FIXED	4P - FIXED	4P - FIXED	4P - FIXED	4P - FIXED	4P - FIXED
	TRIP UNITS		9	EKIP HI TOUCH LSIG (In = 40A)	EKIP HI TOUCH LSIG (In = 40A)	EKIP HI TOUCH LSIG (In = 63A)	EKIP HI TOUCH LSIG (In = 63A)	EKIP HI TOUCH LSIG (In = 40A)	EKIP HI TOUCH LSIG (In = 40A)
	Icu	KA	10	50 kA	50 kA	50 kA	50 kA	50 kA	50 kA
OVERLOAD	L	Range A	11	(0.4 - 1) x In	(0.4 - 1) x In	(0.4 - 1) x In	(0.4 - 1) x In	(0.4 - 1) x In	(0.4 - 1) x In
		Range t	12	k/I^2	k/I^2	k/I^2	k/I^2	k/I^2	k/I^2
SEL. SHORT-CIRCUIT	S	Range A	13	(0.6 - 10) x In	(0.6 - 10) x In	(0.6 - 10) x In	(0.6 - 10) x In	(0.6 - 10) x In	(0.6 - 10) x In
		Range t	14	0.05 - 0,4 sec / k/I^2	0.05 - 0,4 sec / k/I^2	0.05 - 0,4 sec / k/I^2	0.05 - 0,4 sec / k/I^2	0.05 - 0,4 sec / k/I^2	0.05 - 0,4 sec / k/I^2
INST. SHORT-CIRCUIT	I	Range A	15	(1.5 - 15) x In	(1.5 - 15) x In	(1.5 - 15) x In	(1.5 - 15) x In	(1.5 - 15) x In	(1.5 - 15) x In
		Range t	16	instantaneous	instantaneous	instantaneous	instantaneous	instantaneous	instantaneous
EARTH FAULT PROTECTION	G	Range A	17	(0.1 - 1) x In	(0.1 - 1) x In	(0.1 - 1) x In	(0.1 - 1) x In	(0.1 - 1) x In	(0.1 - 1) x In
		Range t	18	t=k / t=k/I^2	t=k / t=k/I^2	t=k / t=k/I^2	t=k / t=k/I^2	t=k / t=k/I^2	t=k / t=k/I^2
CONTACTOR (ABB)			19	AF40-40-00-13 (70A-AC1); 100-250VAC/DC	AF40-40-00-13 (70A-AC1); 100-250VAC/DC	AF52-40-00-13 (100A-AC1); 100-250VAC/DC	AF52-40-00-13 (100A-AC1); 100-250VAC/DC	AF40-40-00-13 (70A-AC1); 100-250VAC/DC	AF40-40-00-13 (70A-AC1); 100-250VAC/DC
THERMAL OVERLOAD RELAY (ABB)			20	-	-	-	-	-	-
SURGE ARRESTER (DEHN)			21	-	-	-	-	-	-
TOROIDAL CURRENT TRANSFORMER (FRER)			22	-	-	-	-	-	-
FUSE HOLDER (ITALWEBER)			23	-	-	-	-	-	-
INDIRECT PROTECTION (ABB)			24	-	-	-	-	-	-
VOLTMETER			25	-	-	-	-	-	-
CURRENT TRANSFORMER FOR MEASURE (FRER)	TYPE		26	-	-	-	-	-	-
	PERFORMANCE/CLASS		27	-	-	-	-	-	-
VOLTAGE TRANSFORMER FOR MEASURE (FRER)	TYPE		28	-	-	-	-	-	-
	PERFORMANCE/CLASS		29	-	-	-	-	-	-
LOCK-OUT RELAY (-)			30	-	-	-	-	-	-
POWER CONDUCTOR		mmq	31	-	5G16	5G16	5G16	5G16	-

REV.	DATE	DRN	CHKD	APPD	DESCRIPTION
=					
+					
4	28/08/2024	Santinelli	Flamminio	Sigismondi	As Built (ASB)
3	08/07/2024	Santinelli	Flamminio	Sigismondi	Accepted for Construction (AFC)
2	03/05/2024	Santinelli	Flamminio	Sigismondi	Issued for review (IFR)
1	28/03/2024	Santinelli	Flamminio	Sigismondi	Issued for review (IFR)
0	15/02/2024	Santinelli	Flamminio	Sigismondi	Issued for review (IFR)

DWG n° : 231298/SD/11
Item n° : PF1002983/26

IMESA ELECTRICAL ENGINEERING

CROSSWIND

ROSETTI MARINO

TITLE : "SG-200N1"

SINGLE LINE DIAGRAM

Single Line Drawing

CONTRACT NO./TITLE CW-I-WP4-2023-05/HOLLANDSE KUST NOORD WIND PARK

SCALE : NTS

A3

DRAWING NO. 1723002197-EL-DG-00011

SHEET 010

REV. 04

F.to UNI A3: 420mmx297mm

File Name : 1723002197-EL-DG-00011 Rev. 04

ITEM	Tag	A5/+05-QF1	: PROTECTION CATHODIC SYSTEM (ICCP) - A5/+05-QF1		Dwg	1723002197-EL-DG-00011	
	S/Sys	83-60	: Cathodic Protection		Module		
TASK	code	C10002962	Location	Onshore Activities	User	Rosetti Marino Quality Control	
FORM	Process	PRE-COMM	Activity FTS	Discipline Electrical	Form	FTR-2	Protection Relay

FTR2 - Protection relay
Record sheet

RELAY DATA

Manufacturer:	ABB	Serial N°:	EH7000153690N000	Relay type:	EKIP HI TOUCH LSIG
Auxiliary supply:	24Vdc	Location:	B200	Cubicle:	A5/+05
Switchboard:	SG-200N1				

Current transformers

Tag	Number of	Ratio	Location

Voltage transformers

Tag	Number of	Ratio	Location

Test result (refer to manufacturer's procedure)

ANSI function	Setting	Injection	Trip value	Time delay Setting	Time delay Trip value
L	26A	120A		3s	1300ms
S	120A	200A		0.1s	104ms
I	240A	400A		INSTANT	26ms
G	8A			0.1s	

Testing & measurement instruments used


Type	Serial n°	Calibration certificate	Validity
ABB EKIP T&P	E34013804410W050		

Comments: See the attchments for full tests.

Page 1/1	Performed by	☐ WITNESS ☉ REVIEW	☐ WITNESS ☐ REVIEW
Company	RM COMM	RM COMM	CPY NOT PRESENT
Name	Mattia Girotti	Kristian Castellani	Witness waived
Date	2024-10-01	2024-10-01	2024-10-02
Signature	PROVERLIS Digitaly signed by Mattia Girotti 2024-10-01T11:07:59.431Z	PROVERLIS Digitaly signed by Kristian Castellani 2024-10-01T14:46:23.028Z	PROVERLIS Digitaly signed by Witness waived 2024-10-02T06:37:04.248Z

Page Name	Group Name	Variable Name	Variable Value	Variable Unit
Settings A				
	Overload Protection (L - ANSI 49)			
		PU nominal current In	40	
		Status	Enabled	
		Function	t=k/i^2	
		Prealarm I1	90	% I1
		Threshold I1	0.650	In
		Time t1 std	3.00	s
		Thermal memory (TM)	Disabled	
		TM Algorithm	RMS-independent	
		TM Time	Automatic	
		TM custom time	830	s
	Time-delayed overcurrent protection (S - ANSI 50 TD/68/51)			
		Status	Enabled	
		Trip enable	Enabled	
		BlockOnStartUp	--------	
		BlockOnOutOfFrequency	--------	
		BlockOnProgStatusA	--------	
		BlockOnProgStatusB	--------	
		BlockOnProgStatusC	--------	
		BlockOnProgStatusD	--------	
		Function	t=k	
		Threshold I2 (t=k)	3.00	In
		Time t2 (t=k) IEC - UL489	0.10	s
		Startup enable	Disabled	
		Startup time	0.10	s
		Startup threshold	0.60	In
		Set Startup th. on ProgStatusD	--------	
		Thermal memory status	Disabled	
		Zone Selectivity status	Disabled	
		Zone Selectivity time	0.04	s
		Zone Selectivity Type	Logic and Hardware	
	Second time-delayed overcurrent protection (S2 - ANSI 50 TD)			
		Status	Disabled	
		Trip enable	Enabled	
		BlockOnStartUp	--------	
		BlockOnOutOfFrequency	--------	
		BlockOnProgStatusA	--------	
		BlockOnProgStatusB	--------	
		BlockOnProgStatusC	--------	
		BlockOnProgStatusD	--------	
		Threshold I5 (t=k)	2.00	In
		Time t5 (t=k)	0.05	s
		Startup enable	Disabled	
		Startup time	0.10	s
		Startup threshold	2.00	In
		Set Startup th. on ProgStatusD	--------	
		Zone Selectivity status	Disabled	
		Zone Selectivity time	0.04	s
		Zone Selectivity Type	Logic and Hardware	
	Instantaneous overcurrent protection (I - ANSI 50)			
		Status	Enabled	
		Threshold I3	6.00	In
		Startup enable	Disabled	
		Startup time	0.10	s
		Startup threshold	1.50	In
		Set Startup th. on ProgStatusD	--------	
		BlockOnStartUp	--------	
		BlockOnOutOfFrequency	--------	
		BlockOnProgStatusA	--------	
		BlockOnProgStatusB	--------	
		BlockOnProgStatusC	--------	
		BlockOnProgStatusD	--------	
		Zone Selectivity status	Disabled	
		Zone Selectivity Type	Logic and Hardware	
	Second I			
		Prot Second I	---	
		Status	Disabled	
		Threshold I31	1.50	In
		Zone Selectivity status	Disabled	
		Zone Selectivity Type	Logic and Hardware	
		Second I Mode	Function Dependent	
		Function	Disabled	
		Delay On	0.00	s
		Delay Off	15.00	s
	Earth fault protection (G - ANSI 50N TD/68/51N)			
		Status	Enabled	
		Trip enable	Enabled	
		BlockOnStartUp	--------	
		BlockOnOutOfFrequency	--------	
		BlockOnProgStatusA	--------	
		BlockOnProgStatusB	--------	
		BlockOnProgStatusC	--------	
		BlockOnProgStatusD	--------	
		Function	t=k	
		Prealarm I4	90	% I4
		Threshold I4 (t=k)	0.200	In
		Time t4 (t=k) IEC - UL489	0.10	s

		Startup enable	Disabled	
		Startup time	0.10	s
		Startup threshold	0.20	In
		Set Startup th. on ProgStatusD	--------	
		Zone selectivity status	Disabled	
		Zone selectivity time	0.04	s
		Zone Selectivity Type	Logic and Hardware	
	Closing on short-circuit protection (MCR)			
		Status	Disabled	
		BlockOnOutOfFrequency	--------	
		BlockOnProgStatusA	--------	
		BlockOnProgStatusB	--------	
		BlockOnProgStatusC	--------	
		BlockOnProgStatusD	--------	
		Threshold I3	6.00	In
		Time t3	0.04	s
		Zone Selectivity status	Disabled	
		Zone Selectivity Type	Logic and Hardware	
	Over Temperature (T)			
		Trip enable	Disabled	

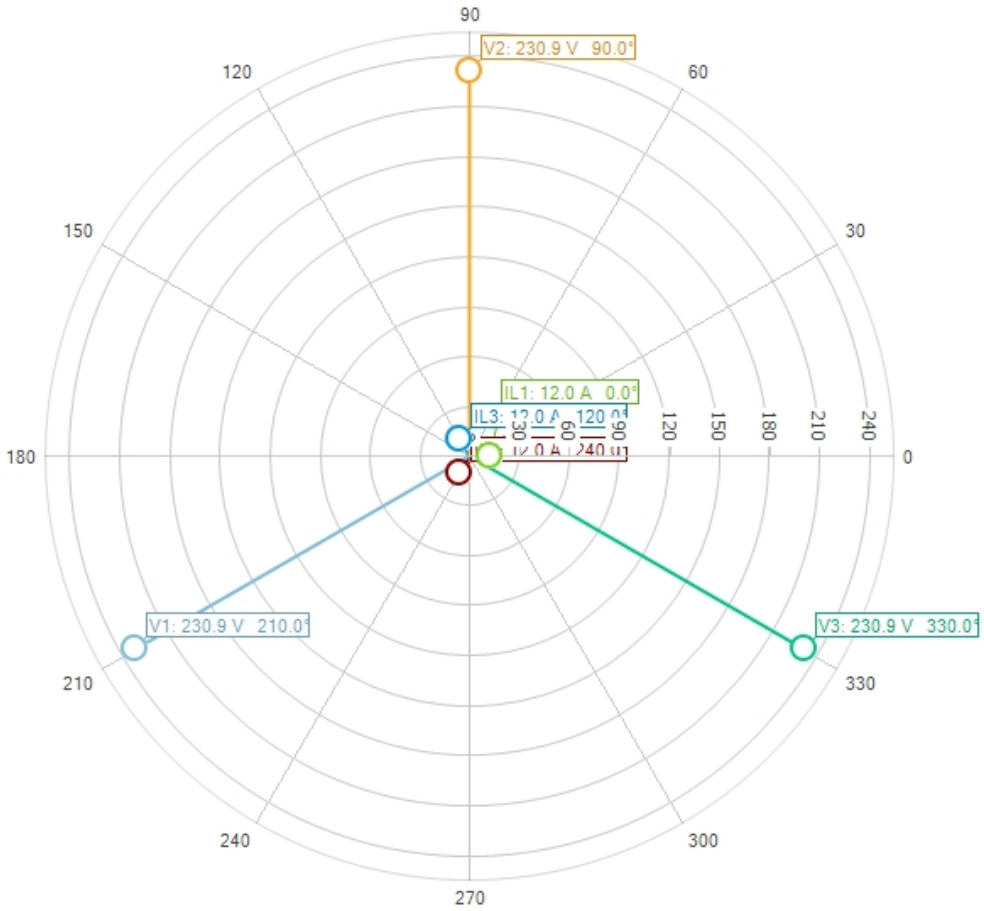

Test


Name	Automatic test 1
Session	Default session
Customer	
Location	
Operator	

Device

Tag name	A5/+05
Relay Serial Number	EH7000153690N000
Circuit Breaker Serial Number	CE81021103
	XT2/4
Device settings	In = 40 A Un = 400 V fn = 50 Hz
Protection Settings	Protection = L Curve type = t=k/i^2 Threshold = 0.650 In Time = 3.00 s Protection = S Curve type = t=k Threshold = 3.00 In Time = 0.10 s Protection = I Threshold = 6.00 In Protection = G Curve type = t=k Threshold = 0.200 In Time = 0.10 s
Preconditions	All preconditions satisfied.

Test result

⚠ Test completed without any trip in 3000 ms.

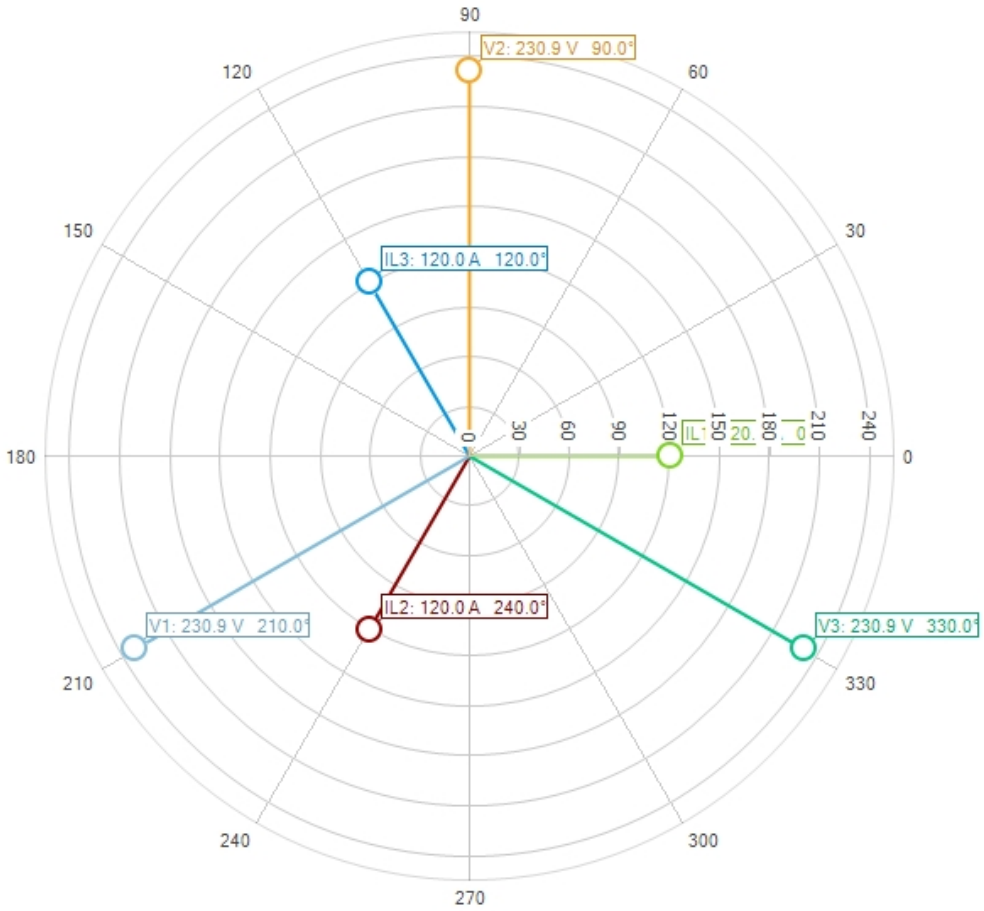

Test

Name	Automatic test 2
Session	Default session
Customer	
Location	
Operator	


Device

Tag name	A5/+05
Relay Serial Number	EH7000153690N000
Circuit Breaker Serial Number	CE81021103
	XT2/4
Device settings	In = 40 A Un = 400 V fn = 50 Hz
Protection Settings	Protection = L Curve type = t=k/i^2 Threshold = 0.650 In Time = 3.00 s Protection = S Curve type = t=k Threshold = 3.00 In Time = 0.10 s Protection = I Threshold = 6.00 In Protection = G Curve type = t=k Threshold = 0.200 In Time = 0.10 s
Preconditions	

Test result

⚠ Test completed with trip but out of time. Protection L tripped in 1300 ms.
Trip time must be between 0 ms and 1000 ms

Trip time must be between 0 ms and 1000 ms.

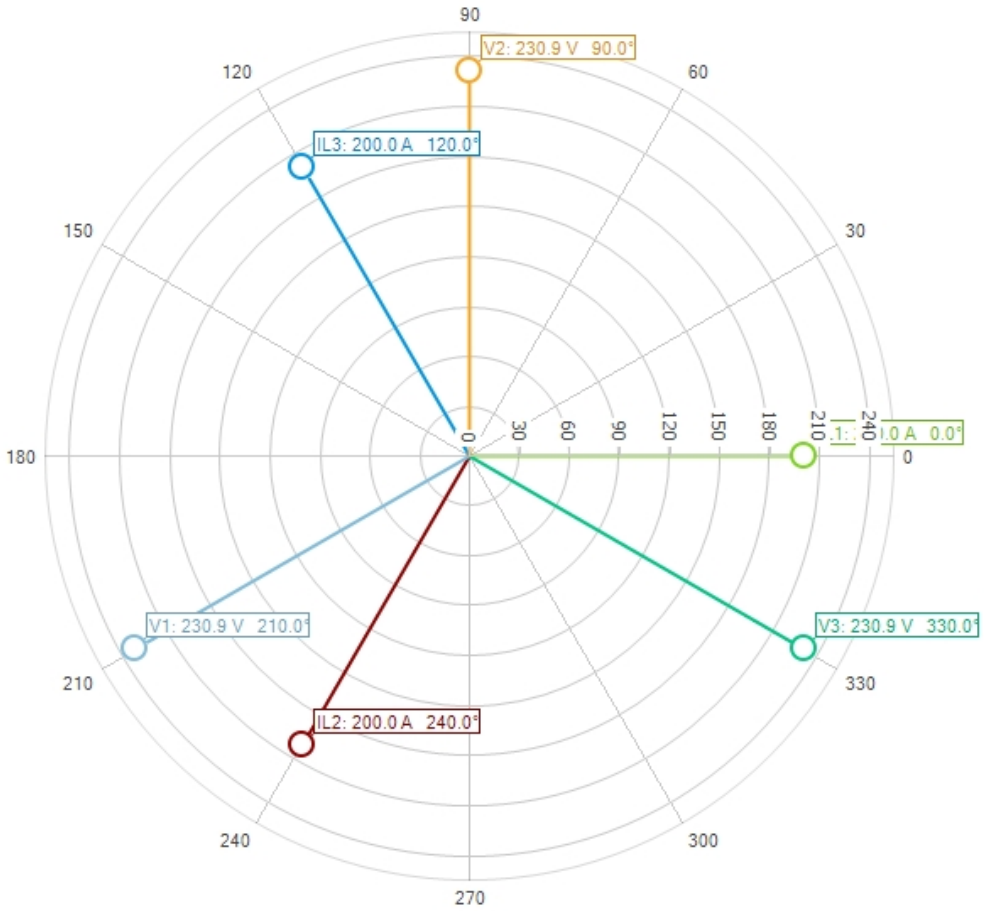

Test

Name	Automatic test 3
Session	Default session
Customer	
Location	
Operator	


Device

Tag name	A5/+05
Relay Serial Number	EH7000153690N000
Circuit Breaker Serial Number	CE81021103
	XT2/4
Device settings	In = 40 A Un = 400 V fn = 50 Hz
Protection Settings	Protection = L Curve type = t=k/i^2 Threshold = 0.650 In Time = 3.00 s Protection = S Curve type = t=k Threshold = 3.00 In Time = 0.10 s Protection = I Threshold = 6.00 In Protection = G Curve type = t=k Threshold = 0.200 In Time = 0.10 s
Preconditions	All preconditions satisfied.

Test result

Test completed with trip. Protection S tripped in 104 ms.
Trip time must be between 0 ms and 1000 ms

Trip time must be between 0 ms and 1000 ms.

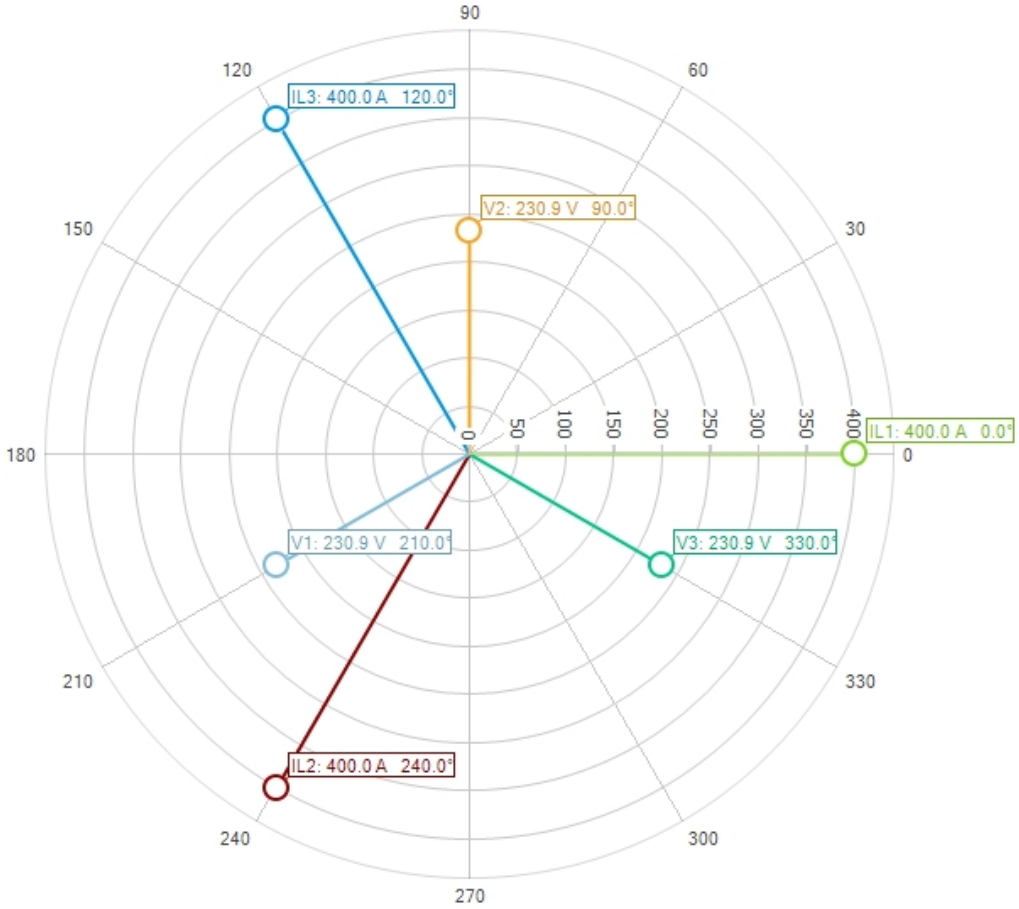

Test

Name	Automatic test 4
Session	Default session
Customer	
Location	
Operator	


Device

Tag name	A5/+05
Relay Serial Number	EH7000153690N000
Circuit Breaker Serial Number	CE81021103
	XT2/4
Device settings	In = 40 A Un = 400 V fn = 50 Hz
Protection Settings	Protection = L Curve type = t=k/i^2 Threshold = 0.650 In Time = 3.00 s Protection = S Curve type = t=k Threshold = 3.00 In Time = 0.10 s Protection = I Threshold = 6.00 In Protection = G Curve type = t=k Threshold = 0.200 In Time = 0.10 s
Preconditions	

Test result

Test completed with trip. Protection I tripped in 26 ms.
Trip time must be between 0 ms and 1000 ms

Trip time must be between 0 ms and 1000 ms.

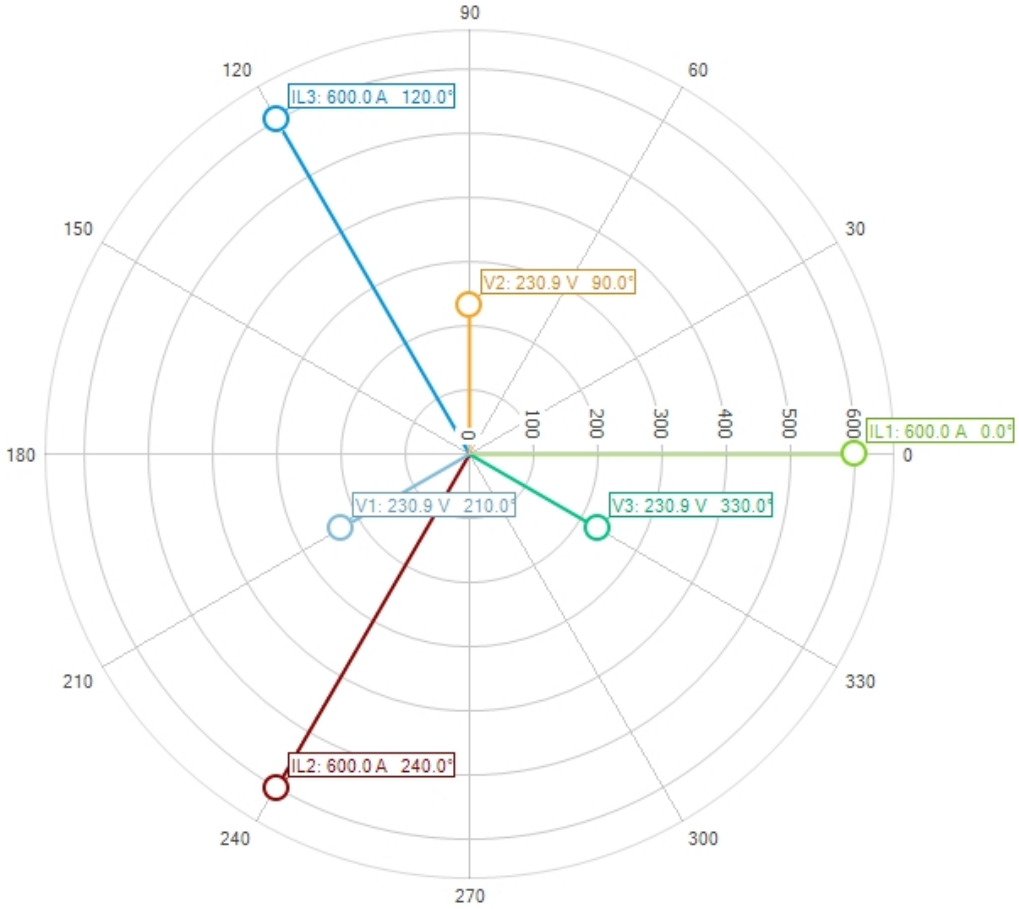

Test

Name	Automatic test 5
Session	Default session
Customer	
Location	
Operator	

Device

Tag name	A5/+05
Relay Serial Number	EH7000153690N000
Circuit Breaker Serial Number	CE81021103
	XT2/4
Device settings	In = 40 A Un = 400 V fn = 50 Hz
Protection Settings	Protection = L Curve type = t=k/i^2 Threshold = 0.650 In Time = 3.00 s Protection = S Curve type = t=k Threshold = 3.00 In Time = 0.10 s Protection = I Threshold = 6.00 In Protection = G Curve type = t=k Threshold = 0.200 In Time = 0.10 s
Preconditions	

Test result

Test completed with trip. Protection I tripped in 25 ms.
Trip time must be between 0 ms and 1000 ms

Trip time must be between 0 ms and 1000 ms.

ITEM	Tag	A5/+05-QF1	: PROTECTION CATHODIC SYSTEM (ICCP) - A5/+05-QF1			Dwg	1723002197-EL-DG-00011
	S/Sys	83-60	: Cathodic Protection			Module	
TASK	code	C10002963		Location	Onshore Activities	User	Rosetti Marino Quality Control
FORM	Process	PRE-COMM	Activity FTS	Discipline	Electrical	Form	FTR-6 Electrical IO

FTR 6 - Electrical I/O check record sheet

Equipment Tag:	PROTEECTION CATHODIC (ICCP)	Instrument Type / Serial N° :	FLUKE 175_17140769
Cubicle N°:	A5/+05	Calibration certificate date:	7715/24_10/07/2025

Link Type:	●	Hardwired	Communication	(strike through unapplicable type)
I/O Type:	●	Digital	Analogic	(strike through unapplicable type)

DIGITAL

Item	Signal description	Link Type (Hardwired/ Communication)	I/O Type (Digital/Analogic)	Point of Origin (From)	Point of Receival (to)	Text Labelling Display Satisfactory (Y/N)	Blinking/Static Display Satisfactory (Y/N)	Color Coding Satisfactory (Y/N)	Status Check			Time Stamping Satisfactory (Y/N)	Refresh Time (if >1s)	Appearing in all applicable display (Y/N)
									Event (Y/N)	Alarm (Y/N)	Fault (Y/N)			
1	CB CLOSED & INSERTED	HW	DI	A5/+05 - KA1/11-14	A5/+05 - X1/9-10	N/A	N/A	N/A	Y	N/A	N/A	N/A	N/A	N/A
2	CB OPEN OR DISCONNECTED	HW	DI	A5/+05 - KA1/11-12	A5/+05 - X1/9-11	N/A	N/A	N/A	Y	N/A	N/A	N/A	N/A	N/A
3	DRAWER ON TEST	HW	DI	A5/+05 - KA5/11-14	A5/+05 - X1/9-11	N/A	N/A	N/A	Y	N/A	N/A	N/A	N/A	N/A
4	CB TRIPPED	HW	DI	A5/+05 - KA4/21-24	A5/+05 - X1/9-12	N/A	N/A	N/A	N/A	N/A	Y	N/A	N/A	N/A
5	FEEDER AVAILABLE	HW	DI	A5/+05 - KA2/11-14	A5/+05 - X1/9-13	N/A	N/A	N/A	Y	N/A	N/A	N/A	N/A	N/A
6	INTERNAL FAULT	HW	DI	A5/+05 - QA1/11-14	A5/+05 - X1/9-14	N/A	N/A	N/A	N/A	N/A	Y	N/A	N/A	N/A
7	USER ON LOCAL	HW	DI	A5/+05 - SA1/21-22	A5/+05 - X1/15-19	N/A	N/A	N/A	Y	N/A	N/A	N/A	N/A	N/A
8														

ANALOGIC

Item	Signal description	Link Type (Hardwired/ Communication)	I/O Type (Digital/Analogic)	Point of Origin (From)	Point of Receival (to)	Min value sent	Min value received	Max value sent	Max value received	Intermediate value sent	Intermediate value received	Out of scale test (OK, Not OK)	Refresh time (if >2s)	Appearing in all applicable display (Y/N)
1														
2														
3														

Comments:

Page 1/1	Performed by	☐ WITNESS ☑ REVIEW	☐ WITNESS ☐ REVIEW
Company	RM COMM	RM COMM	CPY NOT PRESENT
Name	Davide Zucconelli	Kristian Castellani	Witness waived
Date	2024-10-02	2024-10-03	2024-10-03
Signature	Digitaly signed by Davide Zucconelli 2024-10-02T10:55:19.253Z	Digitaly signed by Kristian Castellani 2024-10-03T07:14:52.117Z	Digitaly signed by Witness waived 2024-10-03T14:33:13.296Z

ITEM	Tag	A5/+05-QF1	: PROTECTION CATHODIC SYSTEM (ICCP) - A5/+05-QF1			Dwg	1723002197-EL-DG-00011
	S/Sys	83-60	: Cathodic Protection			Module	
TASK	code	C10003028		Location	Onshore Activities	User	Rosetti Marino Quality Control
FORM	Process	COMM	Activity FTS	Discipline	Electrical	Form	FTR-5 Remote Signalling

FTR5 - Remote signalling
Record sheet

DATA

Switchboard:	SG-200N1	Cubicle N°:	A5/+05

FUNCTION TEST

	Order/Inputs				Status/Output											
	Start order		Stop order		Run		Fault		Stop Signalisation		Available/Ready to start		TRIP		CB OPEN/CLOSED	
UCP																
ECS																
SSS																
PSS																
PCS	●	●	●	●	●	●	●	●			●	●	●	●	●	●
Control Station																
Control Panel																
HVAC Panel																
MCC	●	●	●	●	●	●							●	●	●	●

Column 1 (To check) to be filled during commissioning preparation stage - black if the check is asked
Column 2 (Checked) to be filled black if check is Ok

Comments: During the test, we tested all the Analog Input with success: Current "L1",Current "L2",Current "L3", Voltage "L1-L2", Voltage "L2-L3", Voltage "L1-L3", Frequency, Apparent Power, Real Power, Reactive Power and Power Factor.

	Performed by	☐ WITNESS ☉ REVIEW	☐ WITNESS ☐ REVIEW
Company	RM COMM	RM COMM	
Name	Davide Zucconelli	Kristian Castellani	Martin Taylor
Date	2025-05-12	2025-05-12	2025-05-15
Signature	PROVERLIS Digitaly signed by Davide Zucconelli 2025-05-12T09:23:22.756Z	PROVERLIS Digitaly signed by Kristian Castellani 2025-05-12T11:29:38.419Z	PROVERLIS Digitaly signed by Martin Taylor 2025-05-15T04:29:33.522Z

Section 4.2 Electrical
“As-Commissioned” interconnection diagrams

FROM	TO

DESCRIPTION: IMPRESSED CURRENT CATHODIC PROTECTION (ICCP) SYSTEM
TAG NUMBER: CN-200N1

-X0

L	191	BN
N	193	BU

5W2.1
2C X 2.5 mm²

-X0

L	291	BN
N	293	BU

6W2.1
2C X 2.5 mm²

-X1:1

	2	BK

7WD3
1C X 70 mm²

-X1:2

	2	BK

7WD6.1
1C X 70 mm²

NO MARK UP
MARCO MORETTO
21/3/25

DESCRIPTION: ASSEMBLE JUNCTION BOX EXTERNAL SYSTEM
TAG NUMBER: EAJ-200-02

-X1

BN	1	L
BU	2	N

DESCRIPTION: ASSEMBLE JUNCTION BOX INTERNAL SYSTEM
TAG NUMBER: EAJ-200-01

-X3

BN	1	L
BU	2	N

DESCRIPTION: ASSEMBLE JUNCTION BOX EXTERNAL SYSTEM
TAG NUMBER: EAJ-200-02

-X2:1

BK	2	

DESCRIPTION: ASSEMBLE JUNCTION BOX INTERNAL SYSTEM
TAG NUMBER: EAJ-200-01

-X4:1

BK	2	

VALID FOR CONSTRUCTION
FDL DWG: 123A90-FDL-EL-DG-20149

REV.:	DATE:	SIGNATURE:
2_F	09/01/25	G.Randi

ROSETTI MARINO SpA

CROSSWIND

ROSETTI MARINO

REV.	DATE	DRN	CHKD	APPD	DESCRIPTION
02	19/11/24	SAI	FMA/AMA	FPA/DLO	ACCEPTED FOR CONSTRUCTION (AFC)
01	16/10/24	SAI	FMA/AMA	FPA/DLO	ACCEPTED FOR CONSTRUCTION (AFC)
00	08/07/24	SAI	FMA/AMA	FPA/DLO	ISSUE FOR REVIEW (IFR)

TITLE : BASE LOAD POWER HUB (BLPH)
ELECTRICAL INTERCONNECTING WIRING DIAGRAM
IMPRESSED CURRENT CATHODIC PROTECTION SYSTEM

CONTRACT NO./TITLE CW-I-WP4-2023-05/HOLLANDSE KUST NOORD WIND PARK | SCALE : 1:X

A3 | DRAWING NO. 123A90-DDL-EL-DG-20149 | SHEET 060 | REV. 02


F.to UNI A3: 420mmx297mm

File Name : 123A90-DDL-EL-DG-20149 Rev. 02

FROM	TO

DESCRIPTION: LV Switchgear
TAG NUMBER: SG-200N1


COLUMN/CUBIC.: A5/+05

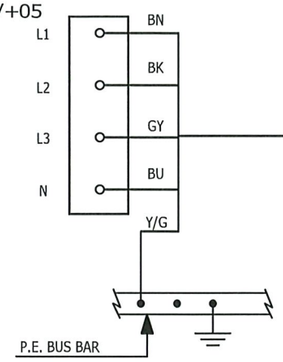


83027-CEL
5G16 mm²

NO MARK UP
MARCO MORETTO
20/3/25

DESCRIPTION: IMPRESSED CURRENT CATHODIC PROTECTION (ICCP) SYSTEM
TAG NUMBER: CN-200N1

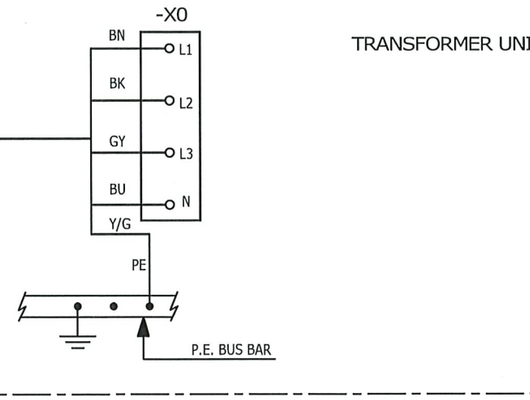


COLUMN/CUBIC.: A3/+01

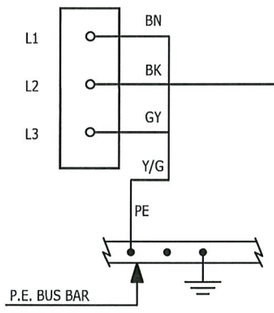


83028-CEL
4G35 mm²

MARCO MORETTO
20/3/25

DESCRIPTION: AC UPS PAS - 30MIN - LINE A
TAG NUMBER: UP-200F3 BY PASS

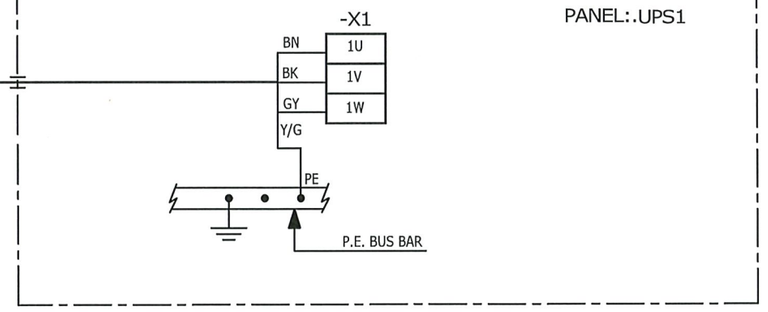

COLUMN/CUBIC.: A4/+01

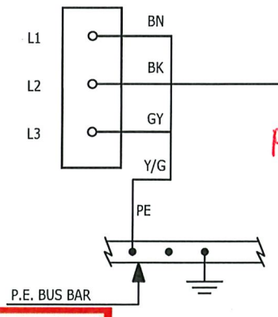


83029-CEL
4G35 mm²

AS COMMISSIONED: NATWA GIRGIL

MARCO MORETTO
20/3/25

DESCRIPTION: AC UPS PAS - 30MIN - LINE B
TAG NUMBER: UP-200F3 BY PASS

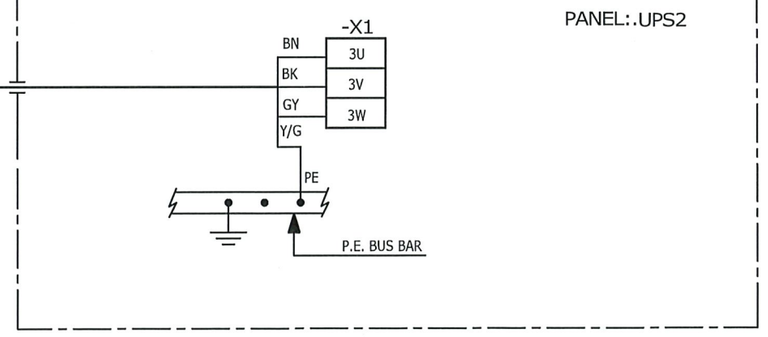

VALID FOR CONSTRUCTION
FDL DWG: 123A90-FDL-EL-DG-20149

REV.:	DATE:	SIGNATURE:
2_F	09/01/25	G.Randi

ROSETTI MARINO SpA

CROSSWIND

ROSETTI MARINO

REV.	DATE	DRN	CHKD	APPD	DESCRIPTION
02	19/11/24	SAI	FMA/AMA	FPA/DLO	ACCEPTED FOR CONSTRUCTION (AFC)
01	16/10/24	SAI	FMA/AMA	FPA/DLO	ACCEPTED FOR CONSTRUCTION (AFC)
00	08/07/24	SAI	FMA/AMA	FPA/DLO	ISSUE FOR REVIEW (IFR)

TITLE : BASE LOAD POWER HUB (BLPH)
ELECTRICAL INTERCONNECTING WIRING DIAGRAM
LV SWITCHGEAR SG-200N1

CONTRACT NO./TITLE CW-I-WP4-2023-05/HOLLANDSE KUST NOORD WIND PARK

SCALE : 1:X

A3	DRAWING NO.	SHEET	REV.
	123A90-DDL-EL-DG-20149	027	02

F.to UNI A3: 420mmx297mm

File Name : 123A90-DDL-EL-DG-20149 Rev. 02

Section 4.3 Instrumentation functional test sheets index

NOT APPLICABLE

Section 4.4 Instrumentation “As-Commissioned” interconnection diagrams

NOT APPLICABLE

Section 4.5 Telecommunication functional test sheets index

NOT APPLICABLE

Section 4.6 Telecommunication
“As-Commissioned” I.C.D. / TSLD's

NOT APPLICABLE

Section 5 SITE / OPERATIONAL

Section 5.1 Operational Test Procedure

Section 5.2 Operational Test Certificates

NOT APPLICABLE

Section 6 PIPING AND VESSEL PREPARATION

Section 6.1 Final Mechanical / Vessel Inspection Checks Index

NOT APPLICABLE

Section 6.2 Leak Test / Drying / Inerting Test Sheets Index

NOT APPLICABLE

Section 6.3 Chemical Loading & First Fill records Index

NOT APPLICABLE

Section 6.4 Chemical Cleaning Reports and Records Index

NOT APPLICABLE

Section 6.5 Lubrication Schedule

NOT APPLICABLE

Section 7 VENDOR

Section 7.1 Vendor Package Summary Index

NOT APPLICABLE

Section 7.2 SAT Procedure with associated punch list and reference (Front Page)

NOT APPLICABLE


Section 7.3 Vendor Spares & Special Tools lists references

NOT APPLICABLE

Section 7.4 Vendor Data / Operations / Maintenance Manuals References

DOOR FRONT LAY-OUT

TYPICAL : LINE FEEDER "LK1-n"

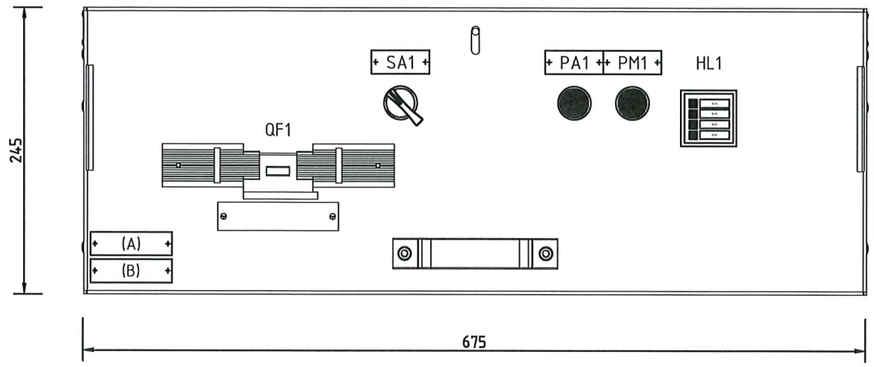



NOTE :


A) IDENTIFICATION name plate (type-1A) , with :
- Drawer position [Column / Position inside SWB]
- Typical name [reference applicability typical used]
- Power [reference applicability typical used]

B) USER name plate (type-1B), with :
- Item User [to see SLD diagrams]
- User Description [to see SLD diagrams]

DEVICES name plate			
ITEM	DESCRIPTION 1	DESCRIPTION 2	NOTE
QF1	Circuit Breaker		NO plate
SA1	LOC-REM	SELECTOR	Type-2A
PA1	STOP	MOTOR	Type-2A
PM1	RUN	MOTOR	Type-2A
HL1	Multiled	Signalling	NO plate

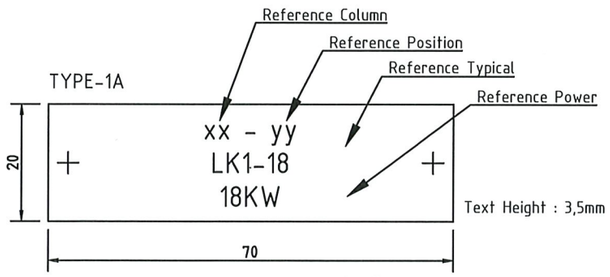

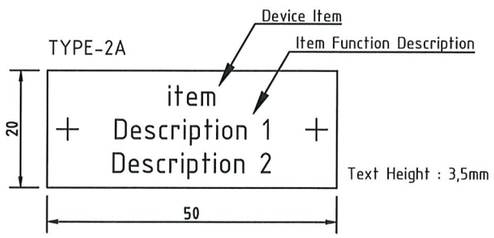

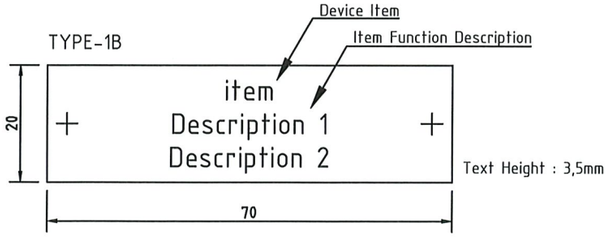

AS COMMISSIONED : NAOWA GIROW
26/3/25
NO MARK UP

VALID FOR CONSTRUCTION
VENDOR DOCUMENT - FDL DWG:
123A90-FDL-1724002197-EL-DG-00031
REV.: 2_A | DATE: 18/03/25 | SIGNATURE: G.Randi
ROSETTI MARINO SpA

CROSSWIND

IMESA ELECTRICAL ENGINEERING

ROSETTI MARINO

= TYPICAL
+ LK-x
DWG n° : 231298/SD/31
Item n° : PF1002983/26

REV.	DATE	DRN	CHKD	APPD	DESCRIPTION
2	18/09/2024	Santinelli	Flamminio	Sigismondi	As Built (ASB)
1	10/07/2024	Santinelli	Flamminio	Sigismondi	Accepted for Construction (AFC)
0	09/05/2024	Santinelli	Flamminio	Sigismondi	Issued for review (IFR)

TITLE : "SG-200N1"
LV SWG FUNCTIONAL DIAGRAMS - TYPICAL FEEDERS
Door Front Lay-Out - Typical "LK1-n" & "LK2-n"

CONTRACT NO./TITLE CW-I-WP4-2023-05/HOLLANDSE KUST NOORD WIND PARK | SCALE : NTS


A3 | DRAWING NO. 1723002197-EL-DG-00031 | SHEET 034 | REV. 02


F.to UNI A3: 420mmx297mm


File Name : 1723002197-EL-DG-00031 Rev. 02


DOOR FRONT LAY-OUT

TYPICAL : LINE FEEDER "LK2-n"

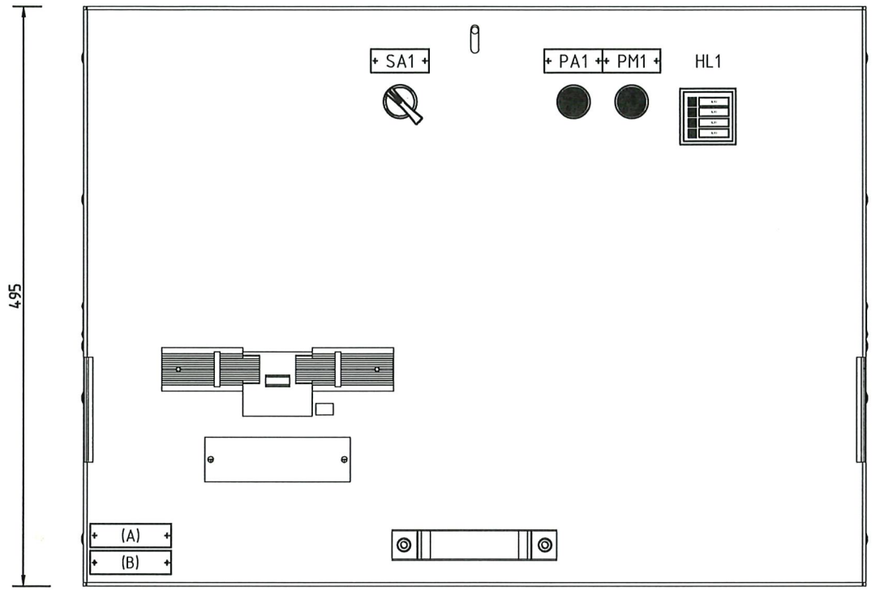

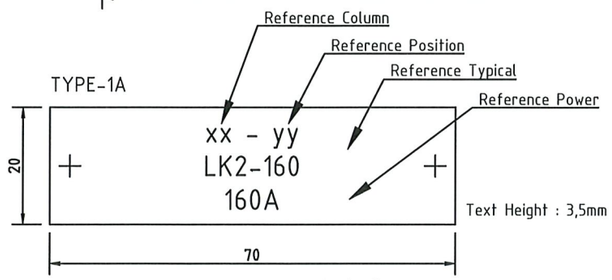

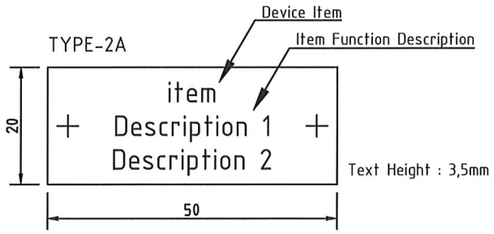

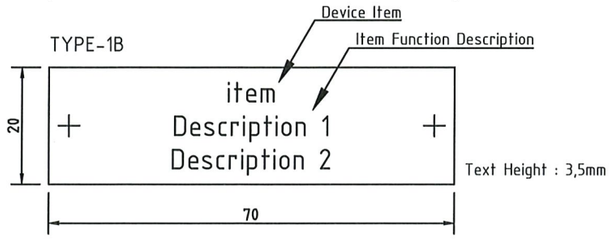

NOTE :

A) IDENTIFICATION name plate (type-1A) , with :
- Drawer position [Column / Position inside SWB]
- Typical name [reference applicability typical used]
- Power [reference applicability typical used]

B) USER name plate (type-1B), with :
- Item User [to see SLD diagrams]
- User Description [to see SLD diagrams]

DEVICES name plate			
ITEM	DESCRIPTION 1	DESCRIPTION 2	NOTE
QF1	Circuit Breaker		NO plate
SA1	LOC-REM	SELECTOR	Type-2A
PA1	STOP	MOTOR	Type-2A
PM1	RUN	MOTOR	Type-2A
HL1	Multiled	Signalling	NO plate

AS COMMISSIONED: MARCIA GIROTTI
24/3/25
NO MARK UP

VALID FOR CONSTRUCTION
VENDOR DOCUMENT - FDL DWG:
123A90-FDL-1724002197-EL-DG-00031
REV.: 2_A | DATE: 18/03/25 | SIGNATURE: G.Randi
ROSETTI MARINO SpA

CROSSWIND

IMESA ELECTRICAL ENGINEERING

ROSETTI MARINO

= TYPICAL
+ LK-x
DWG n° : 231298/SD/31
Item n° : PF1002983/26

REV.	DATE	DRN	CHKD	APPD	DESCRIPTION
2	18/09/2024	Santinelli	Flamminio	Sigismondi	As Built (ASB)
1	10/07/2024	Santinelli	Flamminio	Sigismondi	Accepted for Construction (AFC)
0	09/05/2024	Santinelli	Flamminio	Sigismondi	Issued for review (IFR)

TITLE : "SG-200N1"
LV SWG FUNCTIONAL DIAGRAMS - TYPICAL FEEDERS
Door Front Lay-Out - Typical "LK1-n" & "LK2-n"

CONTRACT NO./TITLE CW-I-WP4-2023-05/HOLLANDSE KUST NOORD WIND PARK | SCALE : NTS

A3 | DRAWING NO. 1723002197-EL-DG-00031 | SHEET 035 | REV. 02

File Name : 1723002197-EL-DG-00031 Rev. 02

F.to UNI A3: 420mmx297mm

USERS LEGEND

TYPICAL : LINE FEEDER "LK1-n" "LK2-n"

TYPICAL APPLICABILITY					
ITEM	ITEM TAG	DESCRIPTION TAG	REFERENCE POSITION (written on name name plate "type-1A)	REFERENCE NOMINAL CURRENT C.B. TRIP UNIT (written on name name plate "type-1A)	REFERENCE TYPICAL (written on name name plate "type-1A)
1	SPARE	SPARE	A2 / +05	40A	LK1-40
2	SPARE	SPARE	A3 / +02	40A	LK1-40
3	DP-200N1	DB-LIGHTING & SMALL POWER BoP	A3 / +03	100A	LK1-100
4	JB-200E3	CRANE	A3 / +04	63A	LK1-63
5	SPARE	SPARE	A3 / +05	40A	LK1-40
6	JB-500E8	WATER PACKAGE	A3 / +08	160A	LK2-160
7	B100-HSB-001	HVAC PANELS HV ROOM	A4 / +02	40A	LK1-40
8	A-80000	FUELL CELL AUXIALIRY LOAD	A4 / +03	63A	LK1-63
9	CP-850F03	BESS PCS CABINET	A4 / +04	40A	LK1-40
10	SPARE	SPARE	A4 / +05	40A	LK1-40
11	SPARE	SPARE	A4 / +06	40A	LK1-40
12	K-63001-A	INSTRUMENTS AIR PACKAGE 01A	A4 / +08	160A	LK2-160
13	SPARE	SPARE	A5 / +01	40A	LK1-40
14	B200-HSB-001	HVAC PANELS - LV ROOM	A5 / +02	40A	LK1-40
15	B300-HSB-001	HVAC PANELS - UPS ROOM	A5 / +03	63A	LK1-63
16	B400-HSB-001	HVAC PANELS - ITER	A5 / +04	63A	LK1-63
17	CN-200N1	IMPRESSED CURR. CATHODIC PROTECTION (ICCP) SYSTEM	A5 / +05	40A	LK1-40
18	SPARE	SPARE	A5 / +06	40A	LK1-40
19	K-63001-B	INSTRUMENTS AIR PACKAGE 01B	A5 / +08	160A	LK2-160
20	CP-850E1	BESS LV1 CABINAT (+DISTR 1)	A6 / +02	40A	LK1-40
21	CP-850E2	BESS LV2 CABINAT (+DISTR 2)	A6 / +03	40A	LK1-40
22	SPARE	SPARE	A6 / +04	40A	LK1-40

AS COMMISSIONED: NATALIA GINOLI
24/3/25
NO MARK UP

VALID FOR CONSTRUCTION
VENDOR DOCUMENT - FDL DWG:
123A90-FDL-1724002197-EL-DG-00031
REV.: 2_A | DATE: 18/03/25 | SIGNATURE: G.Randi
ROSETTI MARINO SpA

CROSSWIND

IMESA ELECTRICAL ENGINEERING

ROSETTI MARINO

= TYPICAL
+ LK-x
DWG n° : 231298/SD/31
Item n° : PF1002983/26

REV.	DATE	DRN	CHKD	APPD	DESCRIPTION
2	18/09/2024	Santinelli	Flamminio	Sigismondi	As Built (ASB)
1	10/07/2024	Santinelli	Flamminio	Sigismondi	Accepted for Construction (AFC)
0	09/05/2024	Santinelli	Flamminio	Sigismondi	Issued for review (IFR)

TITLE : "SG-200N1"
LV SWG FUNCTIONAL DIAGRAMS - TYPICAL FEEDERS
Users Legend - Typical "LK1-n" & "LK2-n"

CONTRACT NO./TITLE CW-I-WP4-2023-05/HOLLANDSE KUST NOORD WIND PARK | SCALE : NTS

A3 | DRAWING NO. 1723002197-EL-DG-00031 | SHEET 036 | REV. 02

F.to UNI A3: 420mmx297mm

File Name : 1723002197-EL-DG-00031 Rev. 02

ITEMS ACRONYM

TYPICAL : LINE FEEDER "LK1-n" "LK2-n"

Composition of Typical :

LK-x = Common Parts
LK1-"nn" or LK2-"nn"= Specific Parts

Example for Composition of LK1-63:
- to take "LK-x" plus "LK1-63"

Example for Composition of LK2-160:
- to take "LK-x" plus "LK2-160"

	ACRONYM ITEMS (Comun parts)	ACRONYM ITEMS (Specific parts)					
	LK-x	LK1-40 (In=40A) (Current Trip Unit)	LK1-63 (In=63A) (Current Trip Unit)	LK1-100 (In=100A) (Current Trip Unit)	LK2-160 (In=160A) (Current Trip Unit)		
ASSOCIATED TYPICAL	This Item include all devices that are comun for both "Specific Parts" Items	This Items include only devices that are detail for "Specific Parts" Items					
LK1-40	X	X					
LK1-63	X		X				
LK1-100	X			X			
LK2-160	X				X		
-							

AS COMMISSIONED: NATWA GIRGIN
24/3/25
NO MARK UP

VALID FOR CONSTRUCTION
VENDOR DOCUMENT - FDL DWG:
123A90-FDL-1724002197-EL-DG-00031

REV.:	DATE:	SIGNATURE:
2_A	18/03/25	G.Randi

ROSETTI MARINO SpA

CROSSWIND

IMESA ELECTRICAL ENGINEERING

ROSETTI MARINO

= TYPICAL
+ LK-x

DWG n° : 231298/SD/31
Item n° : PF1002983/26

REV.	DATE	DRN	CHKD	APPD	DESCRIPTION
2	18/09/2024	Santinelli	Flamminio	Sigismondi	As Built (ASB)
1	10/07/2024	Santinelli	Flamminio	Sigismondi	Accepted for Construction (AFC)
0	09/05/2024	Santinelli	Flamminio	Sigismondi	Issued for review (IFR)


TITLE : "SG-200N1"
LV SWG FUNCTIONAL DIAGRAMS - TYPICAL FEEDERS
Items Acronym - Typical "LK1-n" & "LK2-n"

CONTRACT NO./TITLE CW-I-WP4-2023-05/HOLLANDSE KUST NOORD WIND PARK | SCALE : NTS

A3 | DRAWING NO. 1723002197-EL-DG-00031 | SHEET 037 | REV. 02

F.to UNI A3: 420mmx297mm

File Name : 1723002197-EL-DG-00031 Rev. 02

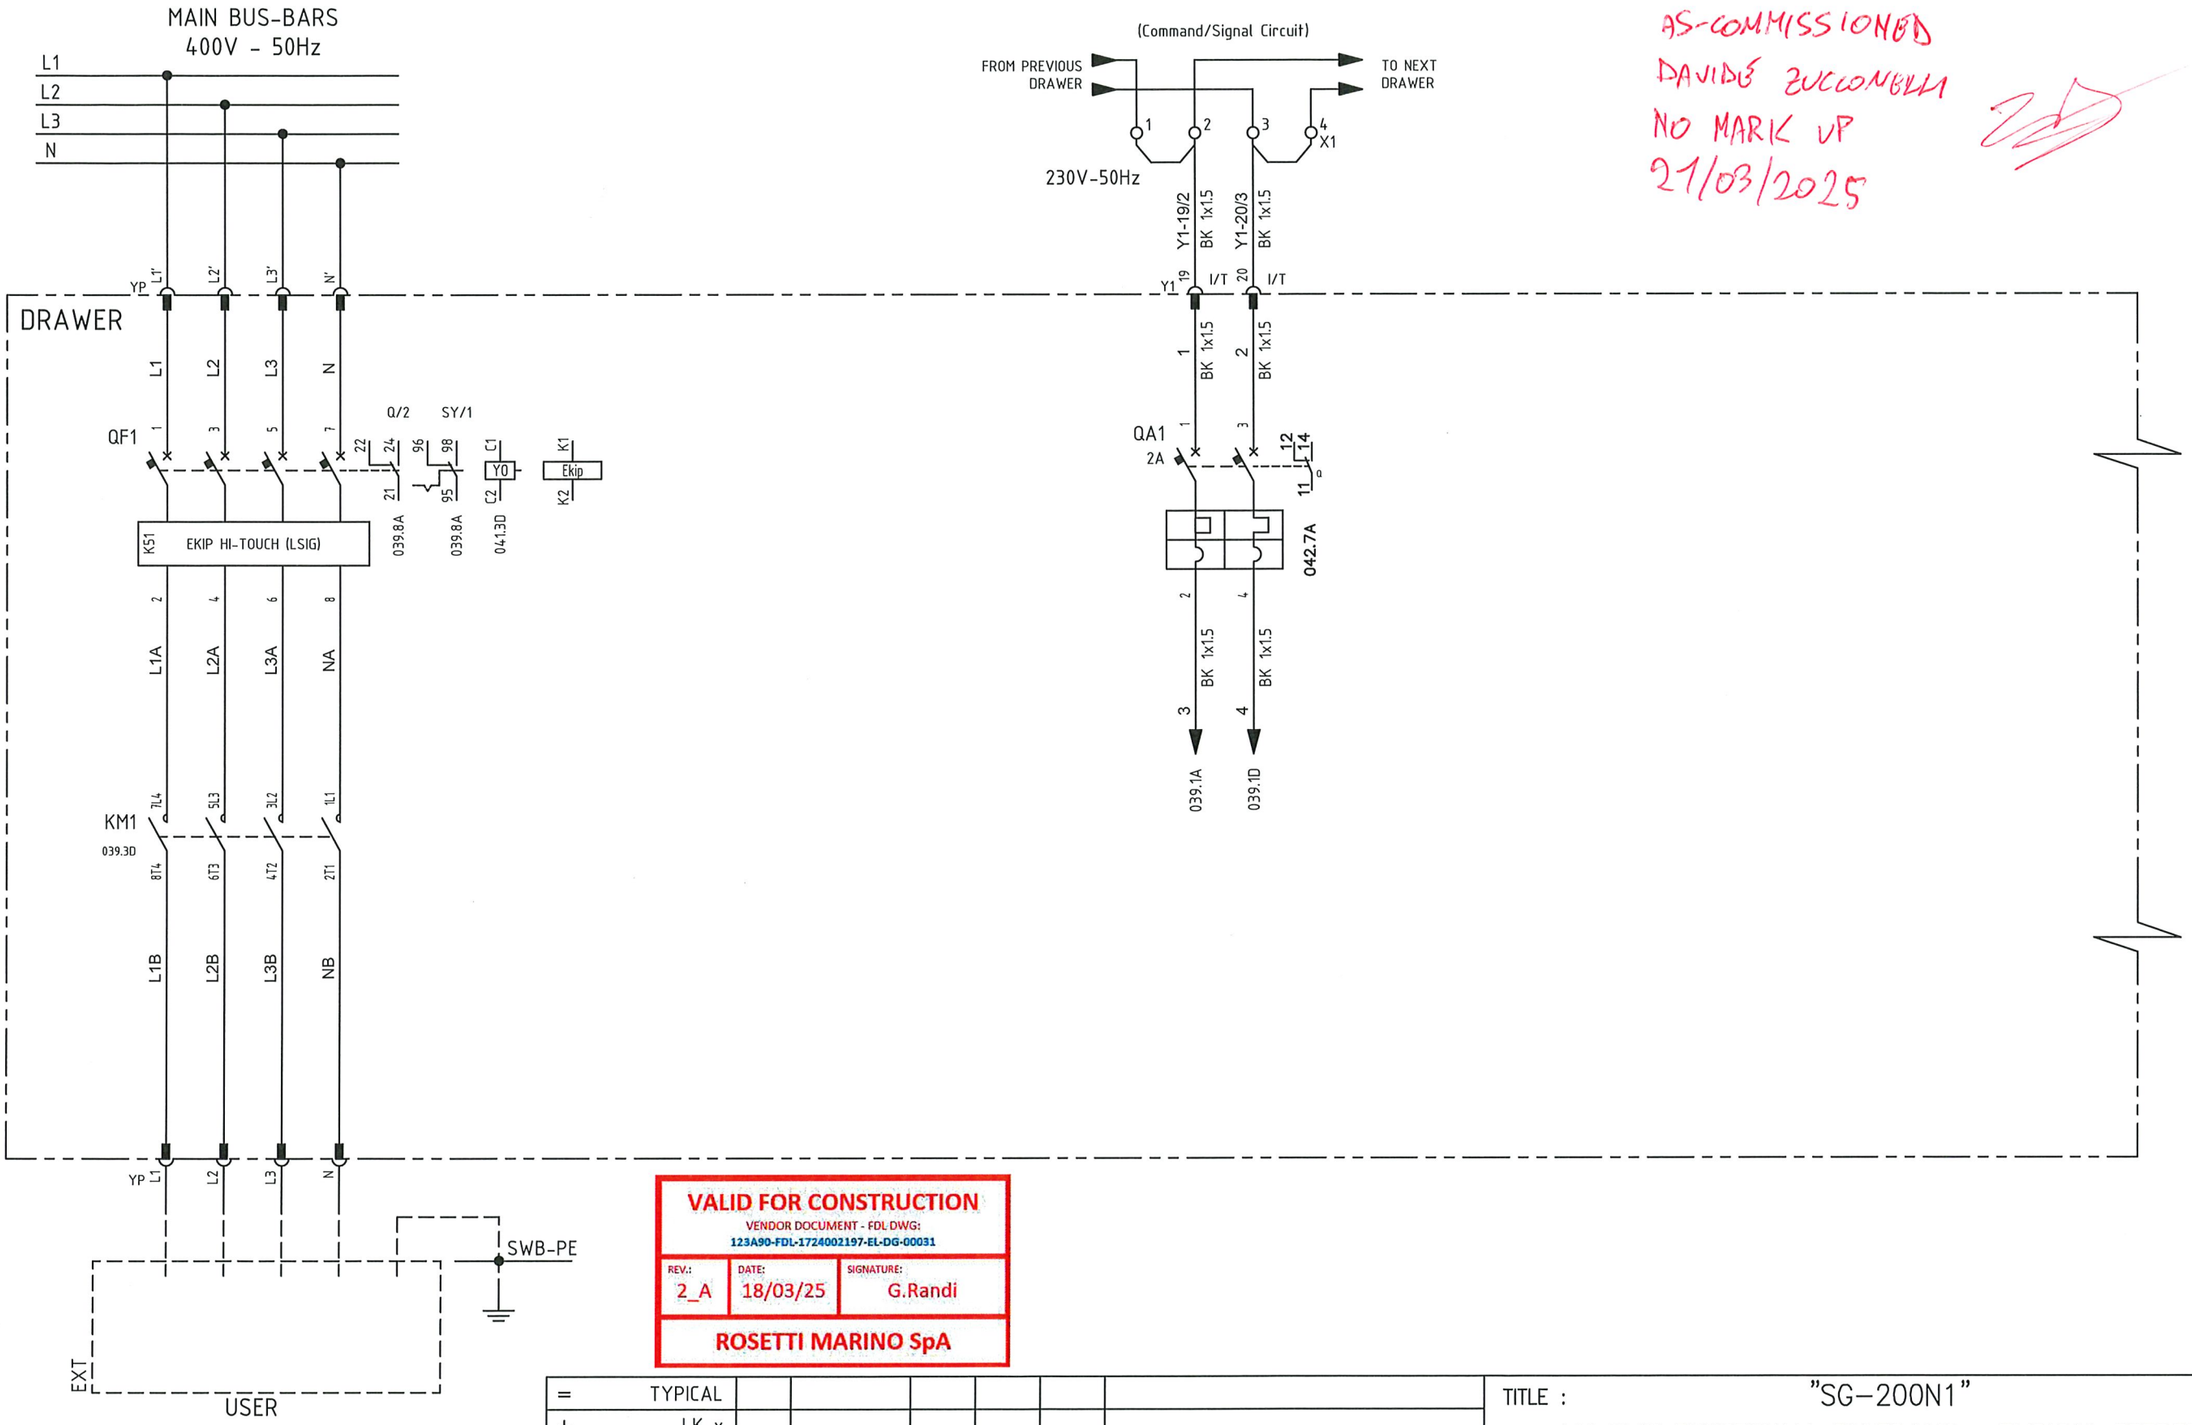

AS-COMMISSIONED
DAVIDE ZUCCONELLI
NO MARK UP
21/03/2025

VALID FOR CONSTRUCTION
VENDOR DOCUMENT - FDL DWG:
123A90-FDL-1724002197-EL-DG-00031

REV.:	DATE:	SIGNATURE:
2_A	18/03/25	G.Randi

ROSETTI MARINO SpA

=	TYPICAL
+	LK-x

DWG n° : 231298/SD/31
Item n° : PF1002983/26

REV.	DATE	DRN	CHKD	APPD	DESCRIPTION
2	18/09/2024	Santinelli	Flamminio	Sigismondi	As Built (ASB)
1	10/07/2024	Santinelli	Flamminio	Sigismondi	Accepted for Construction (AFC)
0	09/05/2024	Santinelli	Flamminio	Sigismondi	Issued for review (IFR)

IMESA ELECTRICAL ENGINEERING

CROSSWIND

ROSETTI MARINO

TITLE : "SG-200N1"
LV SWG FUNCTIONAL DIAGRAMS - TYPICAL FEEDERS
Functional Drawing - Typical "LK1-n" & "LK2-n"

CONTRACT NO./TITLE CW-I-WP4-2023-05/HOLLANDSE KUST NOORD WIND PARK

SCALE : NTS

A3


DRAWING NO. 1723002197-EL-DG-00031

SHEET 038

REV. 02

F.to UNI A3: 420mmx297mm

File Name : 1723002197-EL-DG-00031 Rev. 02

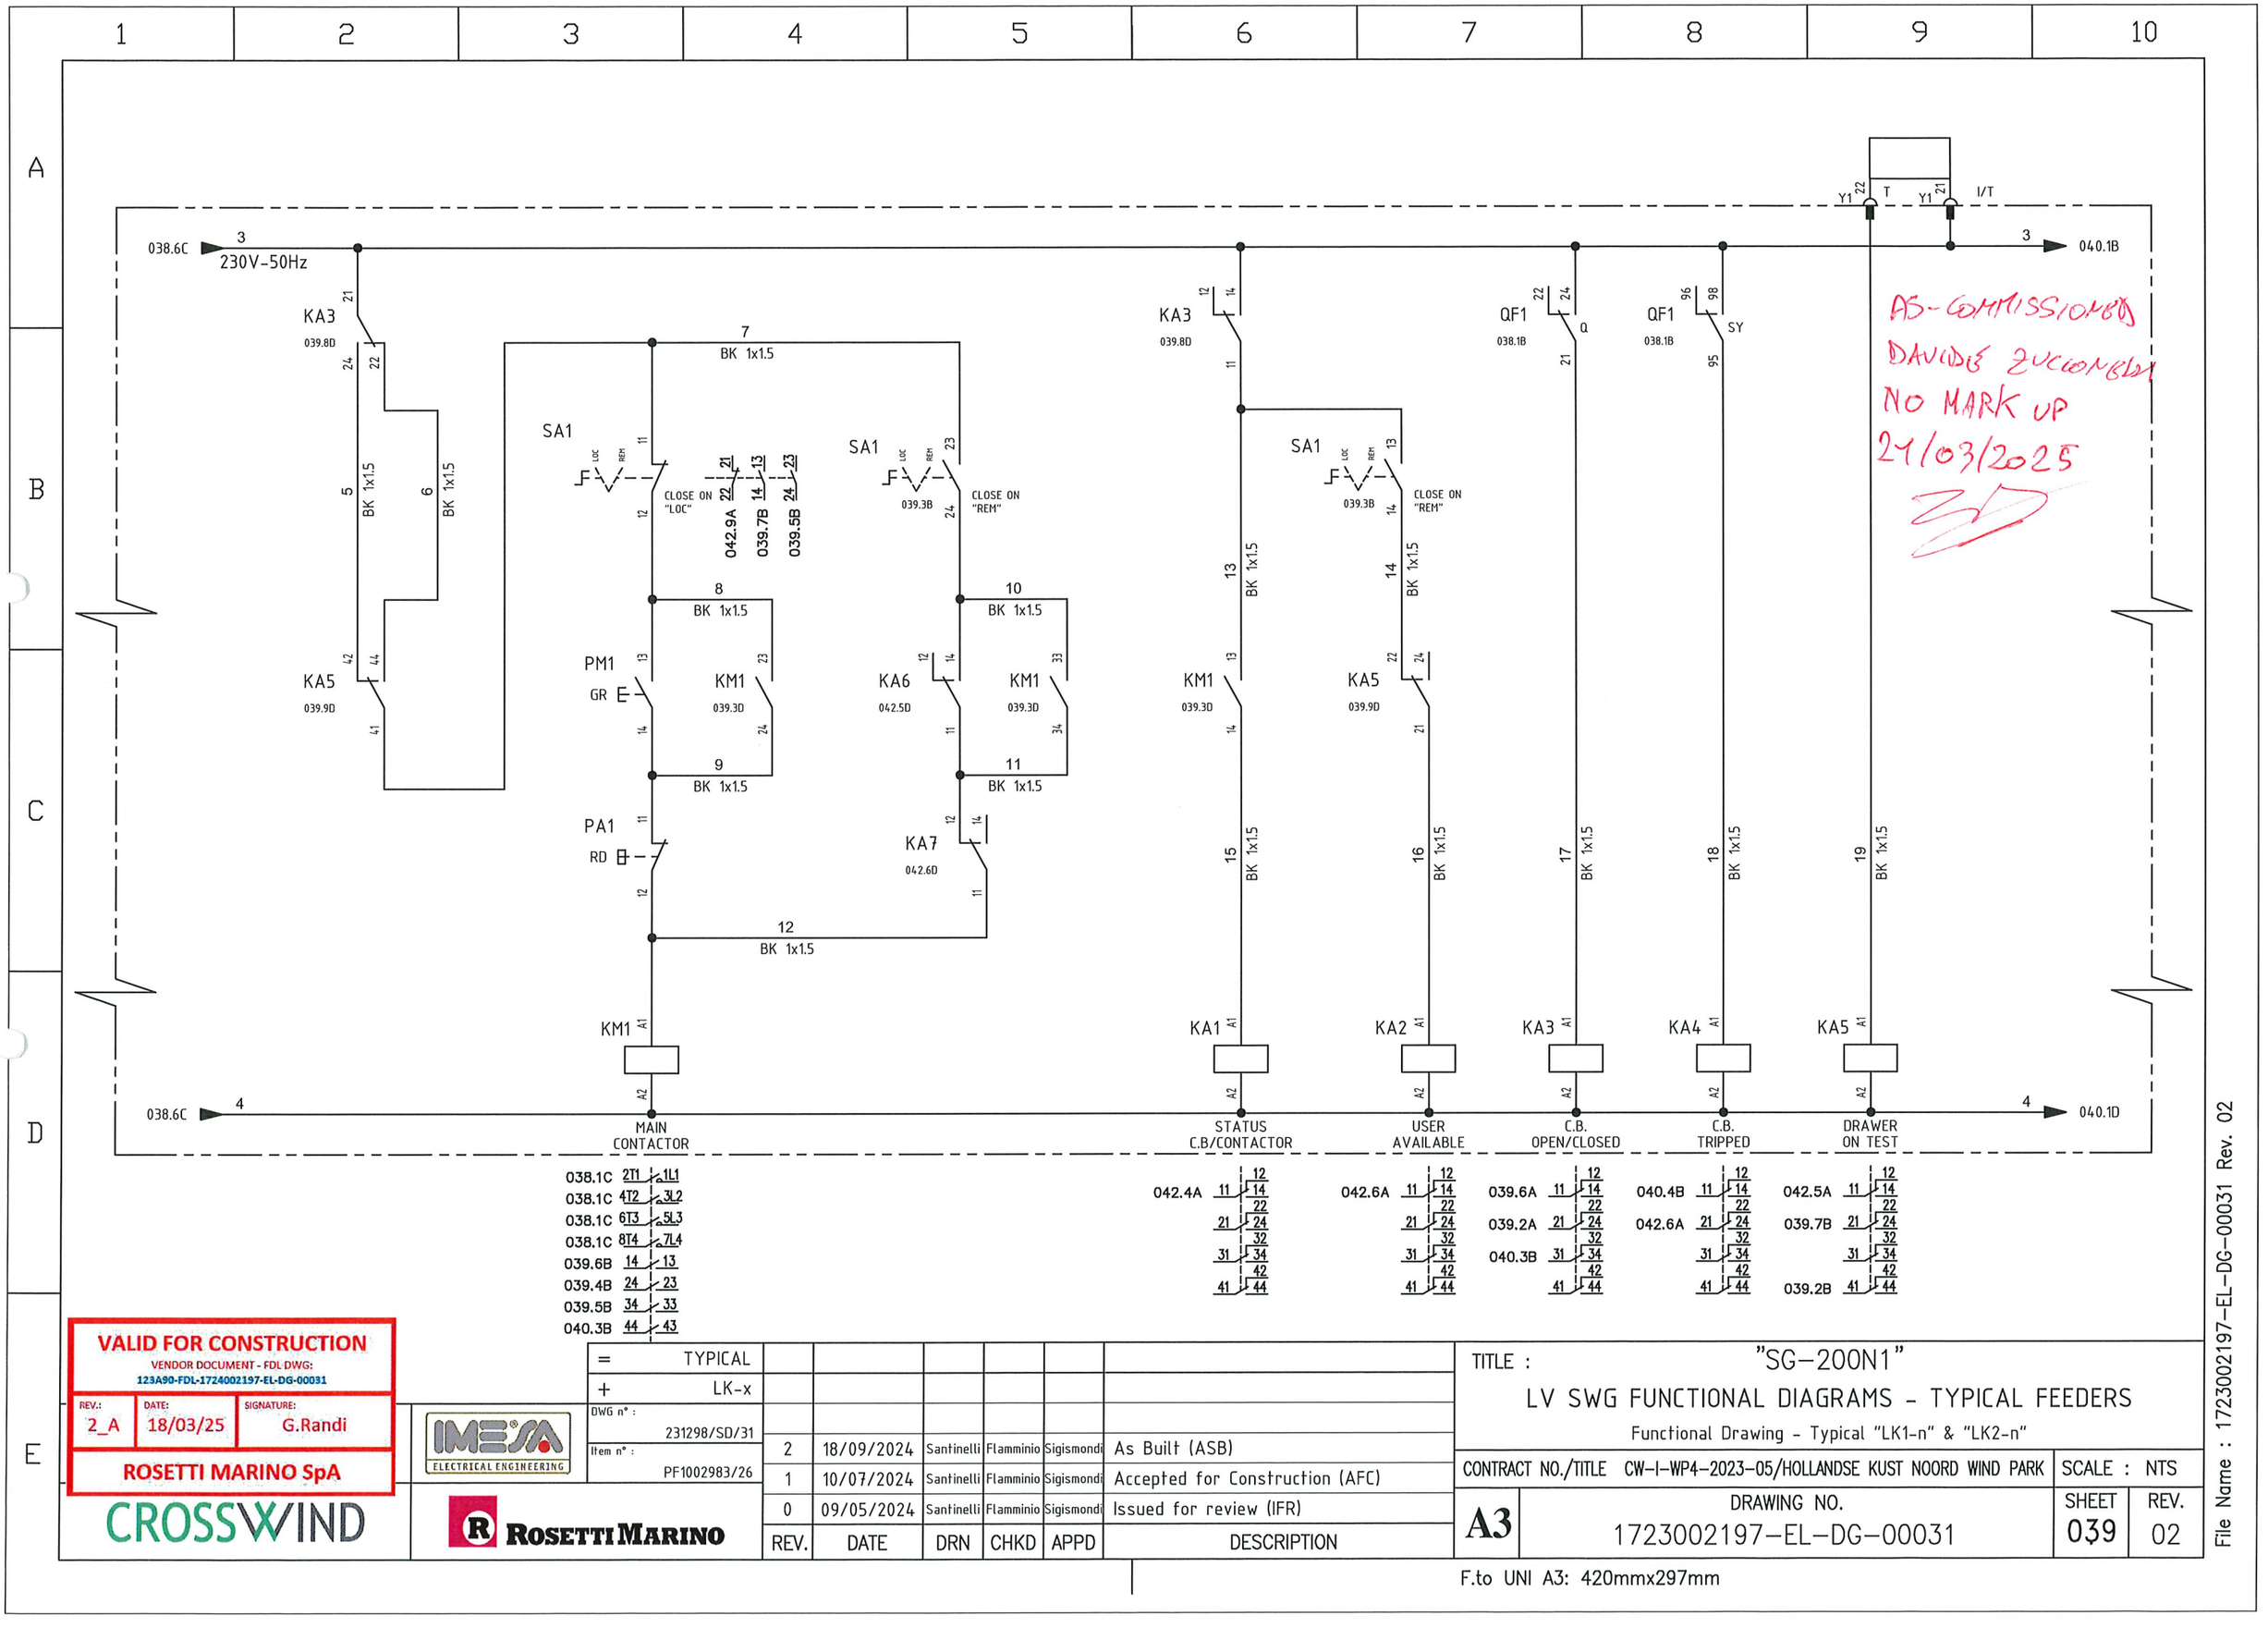

VALID FOR CONSTRUCTION
VENDOR DOCUMENT - FDL DWG:
123A90-FDL-1724002197-EL-DG-00031

REV.:	DATE:	SIGNATURE:
2_A	18/03/25	G.Randi

ROSETTI MARINO SpA

CROSSWIND

IMESA ELECTRICAL ENGINEERING

ROSETTI MARINO

= TYPICAL
+ LK-x
DWG n° : 231298/SD/31
Item n° : PF1002983/26

REV.	DATE	DRN	CHKD	APPD	DESCRIPTION
2	18/09/2024	Santinelli	Flamminio	Sigismondi	As Built (ASB)
1	10/07/2024	Santinelli	Flamminio	Sigismondi	Accepted for Construction (AFC)
0	09/05/2024	Santinelli	Flamminio	Sigismondi	Issued for review (IFR)

TITLE : "SG-200N1"
LV SWG FUNCTIONAL DIAGRAMS - TYPICAL FEEDERS
Functional Drawing - Typical "LK1-n" & "LK2-n"


CONTRACT NO./TITLE CW-I-WP4-2023-05/HOLLANDSE KUST NOORD WIND PARK | SCALE : NTS

A3 | DRAWING NO. 1723002197-EL-DG-00031 | SHEET 039 | REV. 02

F.to UNI A3: 420mmx297mm

File Name : 1723002197-EL-DG-00031 Rev. 02

AS-COMMISSIONED
DAVIDE ZUCCONELLI
NO MARK UP
27/03/2025

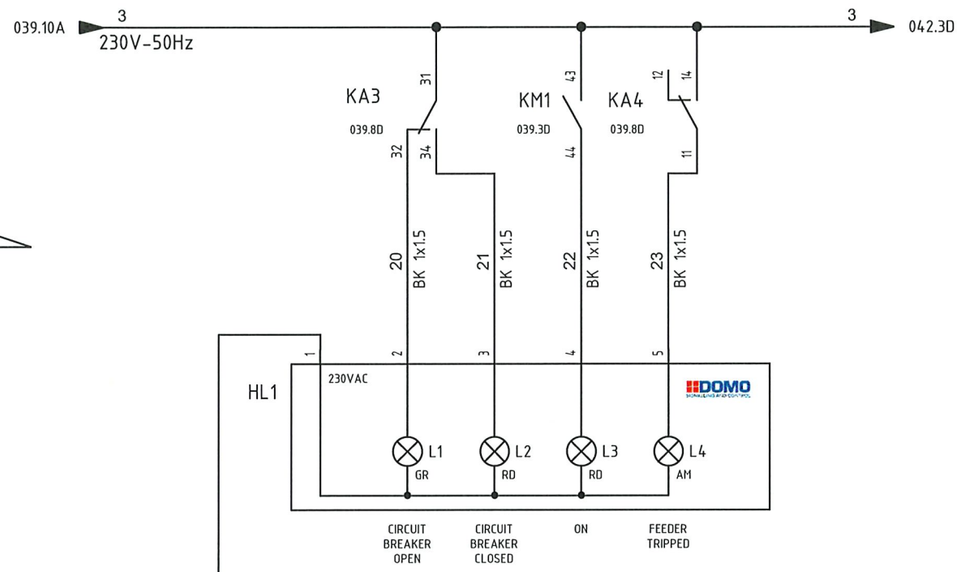

VALID FOR CONSTRUCTION
VENDOR DOCUMENT - FDL DWG:
123A90-FDL-1724002197-EL-DG-00031

REV.:	DATE:	SIGNATURE:
2_A	18/03/25	G.Randi

ROSETTI MARINO SpA

CROSSWIND

IMESA ELECTRICAL ENGINEERING

ROSETTI MARINO

=	TYPICAL
+	LK-x
DWG n° :	231298/SD/31
Item n° :	PF1002983/26

REV.	DATE	DRN	CHKD	APPD	DESCRIPTION
2	18/09/2024	Santinelli	Flamminio	Sigismondi	As Built (ASB)
1	10/07/2024	Santinelli	Flamminio	Sigismondi	Accepted for Construction (AFC)
0	09/05/2024	Santinelli	Flamminio	Sigismondi	Issued for review (IFR)

TITLE : "SG-200N1"
LV SWG FUNCTIONAL DIAGRAMS - TYPICAL FEEDERS
Functional Drawing - Typical "LK1-n" & "LK2-n"


CONTRACT NO./TITLE CW-I-WP4-2023-05/HOLLANDSE KUST NOORD WIND PARK | SCALE : NTS

A3 | DRAWING NO. 1723002197-EL-DG-00031 | SHEET 040 | REV. 02

F.to UNI A3: 420mmx297mm

File Name : 1723002197-EL-DG-00031 Rev. 02

AS-COMMISSIONED
DAVIDE ZUCCONELLI
NO MARK UP
21/03/2025

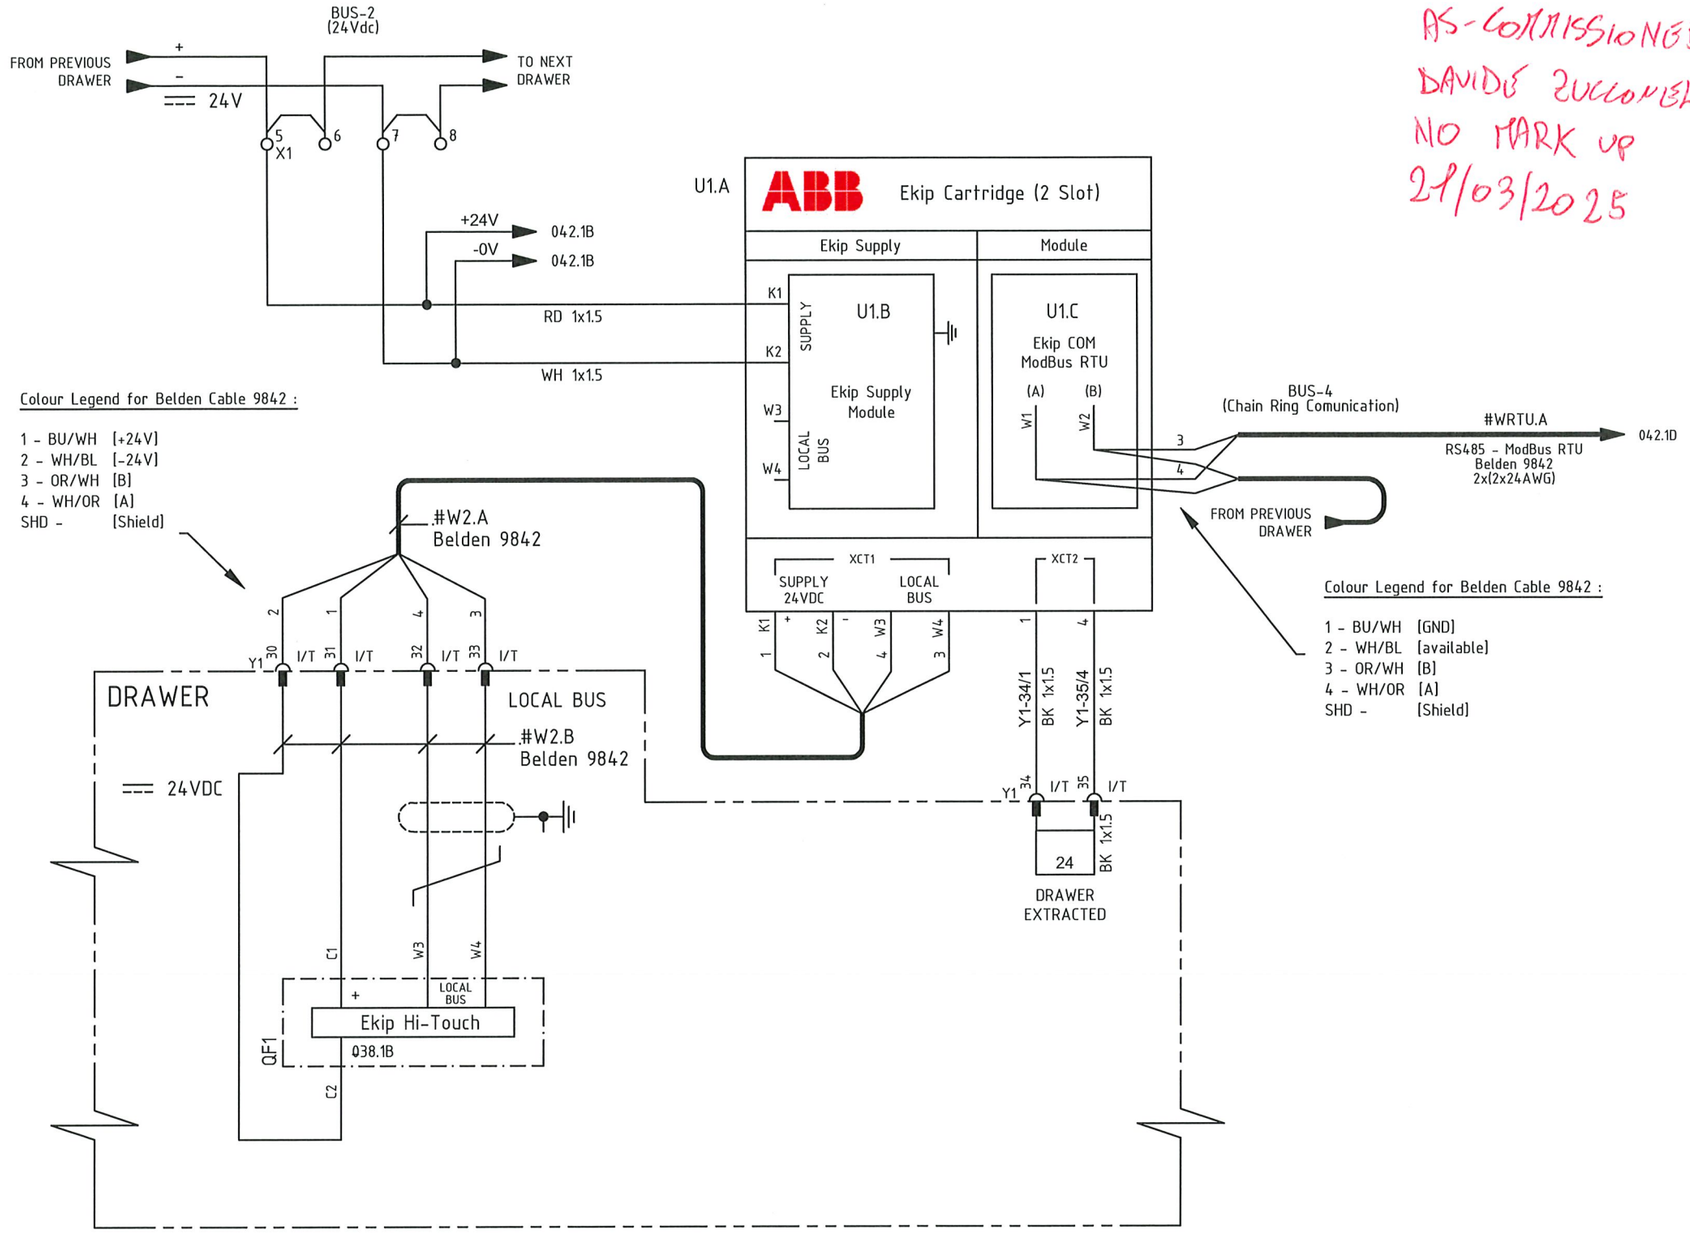

VALID FOR CONSTRUCTION
VENDOR DOCUMENT - FDL DWG:
123A90-FDL-1724002197-EL-DG-00031
REV.: 2_A | DATE: 18/03/25 | SIGNATURE: G.Randi
ROSETTI MARINO SpA

CROSSWIND

IMESA ELECTRICAL ENGINEERING

ROSETTI MARINO

=	TYPICAL						
+	LK-x						
DWG n° :	231298/SD/31						
Item n° :	PF1002983/26						
2	18/09/2024	Santinelli	Flamminio	Sigismondi	As Built (ASB)		
1	10/07/2024	Santinelli	Flamminio	Sigismondi	Accepted for Construction (AFC)		
0	09/05/2024	Santinelli	Flamminio	Sigismondi	Issued for review (IFR)		
REV.	DATE	DRN	CHKD	APPD	DESCRIPTION		

TITLE : "SG-200N1"
LV SWG FUNCTIONAL DIAGRAMS - TYPICAL FEEDERS
Functional Drawing - Typical "LK1-n" & "LK2-n"

CONTRACT NO./TITLE CW-I-WP4-2023-05/HOLLANDSE KUST NOORD WIND PARK | SCALE : NTS

A3 | DRAWING NO. 1723002197-EL-DG-00031 | SHEET 041 | REV. 02

F.to UNI A3: 420mmx297mm

File Name : 1723002197-EL-DG-00031 Rev. 02

AS-COMMISSIONED
DAVIDE ZUCCOMELLI
NO MARK UP
21/03/2025

DRAWER

C.B. - CONTACTOR CLOSED & INSERTED
C.B. - CONTACTOR OPEN OR DISCONNECTED
CIRCUIT BREAKER TRIPPED
FEEDER AVAILABLE
INTERNAL FAULT
USER ON LOCAL

KA1 039.6D
KA5 039.9D
KA4 039.8D
KA2 039.7D
QA1 038.6B
SA1 039.3B
CLOSE ON "LOC"

+25 RD 1x1.5 · +26 RD 1x1.5 · +27 RD 1x1.5 · +28 RD 1x1.5 · +29 RD 1x1.5 · +30 RD 1x1.5 · +31 RD 1x1.5 · +32 RD 1x1.5

Y1 14 I/T · 5 I · 15 I/T · 3 E · 4 E · 16 I/T · 10 I/T · 8 I/T · 9 I/T · 36 I/T · 37 I/T

Y1-14/9 BK 1x1.5 · Y1-5/10 BK 1x1.5 · Y1-15/11 BK 1x1.5 · Y1-16/12 BK 1x1.5 · Y1-10/13 BK 1x1.5 · Y1-9/14 BK 1x1.5 · Y1-36/15 BK 1x1.5 · Y1-37/19 BK 1x1.5

AVAILABLE

+103 RD 1x1.5 · +104 RD 1x1.5 · +105 RD 1x1.5 · +106 RD 1x1.5 · +107 RD 1x1.5 · +108 RD 1x1.5 · +115 RD 1x1.5 · +116 RD 1x1.5 · +117 RD 1x1.5 · +118 RD 1x1.5

041.4A +24V
041.4A -0V
=== 24V

U2.A
AC+ AC- PE
+/L -/N PE
10÷40Vdc - 19÷29Vac SUPPLY
Z-PC-DINAL2-17.5
Modbus RTU RS485
B(-) A(+) GND SHD
B/L A/H GND SHD
3 4 1 SHD
041.9B
TO NEXT DRAWER
BUS-4 (Chain Ring Comunication)

U2.B
+16V 0V IN-1 IN-2 IN-3 IN-4 IN-5
INPUT
SENECA AUTOMATION INTERFACES
MODULE I/O
Z-5DI-2DO
ID = 01
OUTPUT
DO-1 DO-2

U2.C
+16V 0V IN-1 IN-2 IN-3 IN-4 IN-5
INPUT
SENECA AUTOMATION INTERFACES
MODULE I/O
Z-5DI-2DO
ID = 02
OUTPUT
DO-1 DO-2

Colour Legend for Belden Cable 9842 :

1 - BU/WH [GND]
2 - WH/BL [available]
3 - OR/WH [B]
4 - WH/OR [A]
SHD - [Shield]

109 BK 1x1.5 · 110 BK 1x1.5 · 111 BK 1x1.5 · 112 BK 1x1.5 · 113 BK 1x1.5 · 114 BK 1x1.5

Y1-11/20 BK 1x1.5 · Y1-12/21 BK 1x1.5 · Y1-13/22 BK 1x1.5

Y1 11 I/T · 12 I/T · 13 I/T

DRAWER

040.5B 3 230V-50Hz

KA6 A1 33 · KA7 A1 34

040.5D 4

KA6 A2 CONTACTOR CLOSE COMMAND
KA7 A2 CONTACTOR OPEN COMMAND

KA6 039.5B · KA7 039.5C

VALID FOR CONSTRUCTION
VENDOR DOCUMENT - FDL DWG:
123A90-FDL-1724002197-EL-DG-00031
REV.: 2_A | DATE: 18/03/25 | SIGNATURE: G.Randi
ROSETTI MARINO SpA

CROSSWIND

IMESA ELECTRICAL ENGINEERING

ROSETTI MARINO

= TYPICAL
+ LK-x
DWG n° : 231298/SD/31
Item n° : PF1002983/26

REV.	DATE	DRN	CHKD	APPD	DESCRIPTION
2	18/09/2024	Santinelli	Flamminio	Sigismondi	As Built (ASB)
1	10/07/2024	Santinelli	Flamminio	Sigismondi	Accepted for Construction (AFC)
0	09/05/2024	Santinelli	Flamminio	Sigismondi	Issued for review (IFR)

TITLE : "SG-200N1"
LV SWG FUNCTIONAL DIAGRAMS - TYPICAL FEEDERS
Functional Drawing - Typical "LK1-n" & "LK2-n"

CONTRACT NO./TITLE CW-I-WP4-2023-05/HOLLANDSE KUST NOORD WIND PARK
SCALE : NTS
A3
DRAWING NO. 1723002197-EL-DG-00031
SHEET 042
REV. 02


F.to UNI A3: 420mmx297mm

File Name : 1723002197-EL-DG-00031 Rev. 02

SPECIFIC PARTS

TYPICAL : LINE FEEDER "LK1-n" "LK2-n"

AS-COMMISSIONED
DAVIDE ZUCCONELLI
NO MARK UP
21/03/2025

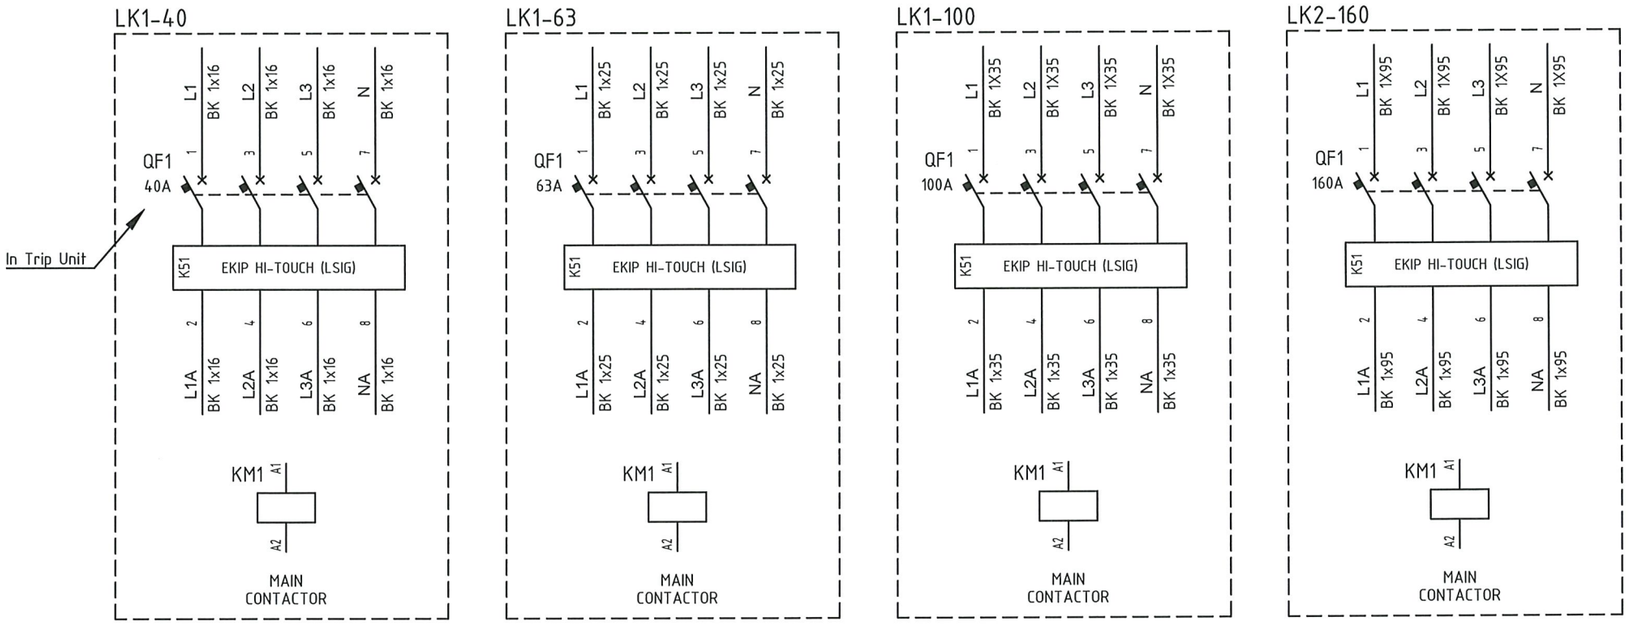

VALID FOR CONSTRUCTION
VENDOR DOCUMENT - FDL DWG:
123A90-FDL-1724002197-EL-DG-00031
REV.: 2_A | DATE: 18/03/25 | SIGNATURE: G.Randi
ROSETTI MARINO SpA

CROSSWIND

IMESA ELECTRICAL ENGINEERING

ROSETTI MARINO

= TYPICAL
+ LK-x
DWG n° : 231298/SD/31
Item n° : PF1002983/26

REV.	DATE	DRN	CHKD	APPD	DESCRIPTION
2	18/09/2024	Santinelli	Flamminio	Sigismondi	As Built (ASB)
1	10/07/2024	Santinelli	Flamminio	Sigismondi	Accepted for Construction (AFC)
0	09/05/2024	Santinelli	Flamminio	Sigismondi	Issued for review (IFR)

TITLE : "SG-200N1"
LV SWG FUNCTIONAL DIAGRAMS - TYPICAL FEEDERS
Functional Drawing - Typical "LK1-n" & "LK2-n"

CONTRACT NO./TITLE CW-I-WP4-2023-05/HOLLANDSE KUST NOORD WIND PARK | SCALE : NTS

A3 | DRAWING NO. 1723002197-EL-DG-00031 | SHEET 043 | REV. 02

F.to UNI A3: 420mmx297mm

File Name : 1723002197-EL-DG-00031 Rev. 02

TYPICAL - LK-x - Y1

AUXILIARY SOCKET
136450/001 (PF – 2 pcs) + 136458/004 (PM – 2 pcs)

N° PIN	1	2	3	4	5	6	7	8	9	10	11	12	13	14	15	16	17	18	19	20	21	22	23	24	25	26	27	28	29	30	31	32	33	34	35	36	37	38	39	40	41	42	43	44
JUMP			●	●				●	●																																			
RACKED-OUT			✕	✕				✕	✕																																			
TEST								X	X	X	X	X	X	X	X	X	X	X	X	X	X	X								X	X	X	X	X	X	X	X	X	X	X	X	X	X	X
RACKED-IN					X	X	X	X	X	X	X	X	X	X	X	X	X	X	X	X	X	X					X	X	X	X	X	X	X	X	X	X	X	X	X	X	X	X	X	
PIN USED			042.5B	042.5B	042.4B			042.6B	042.7B	042.6B	042.5D	042.5D	042.6D	042.3B	042.4B	042.6B			038.6A	038.6A	039.9A	039.9A								041.3C	041.3C	041.4C	041.4C	041.6C	041.7C	042.7B	042.9B							

← FIELD WHIT "X" - CONTACT CLOSE WHEN DRAWER IS IN RACKED-OUT POSITION
← FIELD WHIT "X" - CONTACT CLOSE WHEN DRAWER IS IN TEST POSITION
← FIELD WHIT "X" - CONTACT CLOSE WHEN DRAWER IS IN RACKED-IN POSITION

← CROS-REFERENCE USED PIN

AS COMMISSIONED
DAVIDE ZUCCONELLI
NO MARK UP
21/03/2025

VALID FOR CONSTRUCTION
VENDOR DOCUMENT - FDL DWG:
123A90-FDL-1724002197-EL-DG-00031
REV.: 2_A | DATE: 18/03/25 | SIGNATURE: G.Randi
ROSETTI MARINO SpA

CROSSWIND

IMESA ELECTRICAL ENGINEERING

ROSETTI MARINO

= TYPICAL
+ LK-x
DWG n° : 231298/SD/31
Item n° : PF1002983/26

REV.	DATE	DRN	CHKD	APPD	DESCRIPTION
2	18/09/2024	Santinelli	Flamminio	Sigismondi	As Built (ASB)
1	10/07/2024	Santinelli	Flamminio	Sigismondi	Accepted for Construction (AFC)
0	09/05/2024	Santinelli	Flamminio	Sigismondi	Issued for review (IFR)

TITLE : "SG-200N1"
LV SWG FUNCTIONAL DIAGRAMS - TYPICAL FEEDERS
Functional Drawing - Typical "LK1-n" & "LK2-n"

CONTRACT NO./TITLE CW-I-WP4-2023-05/HOLLANDSE KUST NOORD WIND PARK | SCALE : NTS

A3 | DRAWING NO. 1723002197-EL-DG-00031 | SHEET 044 | REV. 02

F.to UNI A3: 420mmx297mm

File Name : 1723002197-EL-DG-00031 Rev. 02

TYPICAL - LK-x X1					
NumM	Fg.	Sez.	Tipo	Descrizione	Costruttore
			BT003	BT/3 End bracket	Cabur
1	038.5A	2.5	HD100GR_	HMD.2/GR Two-level feed-through Terminal Block - Grey (2.5 mmq) - Spring type	Cabur
2	038.6A	2.5	HD100GR_	HMD.2/GR Two-level feed-through Terminal Block - Grey (2.5 mmq) - Spring type	Cabur
3	038.6A	2.5	HD100GR_	HMD.2/GR Two-level feed-through Terminal Block - Grey (2.5 mmq) - Spring type	Cabur
4	038.6A	2.5	HD100GR_	HMD.2/GR Two-level feed-through Terminal Block - Grey (2.5 mmq) - Spring type	Cabur
5	041.3A	2.5	HD100GR_	HMD.2/GR Two-level feed-through Terminal Block - Grey (2.5 mmq) - Spring type	Cabur
6	041.3A	2.5	HD100GR_	HMD.2/GR Two-level feed-through Terminal Block - Grey (2.5 mmq) - Spring type	Cabur
7	041.4A	2.5	HD100GR_	HMD.2/GR Two-level feed-through Terminal Block - Grey (2.5 mmq) - Spring type	Cabur
8	041.4A	2.5	HD100GR_	HMD.2/GR Two-level feed-through Terminal Block - Grey (2.5 mmq) - Spring type	Cabur
			HD101GR	HMD/PT/GR End section - Grey	Cabur
9	042.3B	2.5	HD400GR_	HMD.2N/GR Two-level feed-through Terminal Block - Grey (2.5 mmq) - Spring type	Cabur
10	042.4B	2.5	HD400GR_	HMD.2N/GR Two-level feed-through Terminal Block - Grey (2.5 mmq) - Spring type	Cabur
11	042.4B	2.5	HD400GR_	HMD.2N/GR Two-level feed-through Terminal Block - Grey (2.5 mmq) - Spring type	Cabur
12	042.5B	2.5	HD400GR_	HMD.2N/GR Two-level feed-through Terminal Block - Grey (2.5 mmq) - Spring type	Cabur
13	042.6B	2.5	HD400GR_	HMD.2N/GR Two-level feed-through Terminal Block - Grey (2.5 mmq) - Spring type	Cabur
14	042.7B	2.5	HD400GR_	HMD.2N/GR Two-level feed-through Terminal Block - Grey (2.5 mmq) - Spring type	Cabur
15	042.7B	2.5	HD400GR_	HMD.2N/GR Two-level feed-through Terminal Block - Grey (2.5 mmq) - Spring type	Cabur
16	042.7B	2.5	HD400GR_	HMD.2N/GR Two-level feed-through Terminal Block - Grey (2.5 mmq) - Spring type	Cabur
17	042.8B	2.5	HD400GR_	HMD.2N/GR Two-level feed-through Terminal Block - Grey (2.5 mmq) - Spring type	Cabur
18	042.8B	2.5	HD400GR_	HMD.2N/GR Two-level feed-through Terminal Block - Grey (2.5 mmq) - Spring type	Cabur
19	042.9B	2.5	HD400GR_	HMD.2N/GR Two-level feed-through Terminal Block - Grey (2.5 mmq) - Spring type	Cabur
20	042.5C	2.5	HD400GR_	HMD.2N/GR Two-level feed-through Terminal Block - Grey (2.5 mmq) - Spring type	Cabur
21	042.5C	2.5	HD400GR_	HMD.2N/GR Two-level feed-through Terminal Block - Grey (2.5 mmq) - Spring type	Cabur
22	042.6C	2.5	HD400GR_	HMD.2N/GR Two-level feed-through Terminal Block - Grey (2.5 mmq) - Spring type	Cabur
23	042.9C	2.5	HD400GR_	HMD.2N/GR Two-level feed-through Terminal Block - Grey (2.5 mmq) - Spring type	Cabur
24	042.9C	2.5	HD400GR_	HMD.2N/GR Two-level feed-through Terminal Block - Grey (2.5 mmq) - Spring type	Cabur
25	042.10C	2.5	HD400GR_	HMD.2N/GR Two-level feed-through Terminal Block - Grey (2.5 mmq) - Spring type	Cabur
			HD201GR	HMD.1/PT/GR End section - Grey	Cabur
			BT003	BT/3 End bracket	Cabur

AS-COMMISSIONED
DAVIDE ZUCCHINELLI
NO MARK UP
21/03/2025

VALID FOR CONSTRUCTION
VENDOR DOCUMENT - FDL DWG:
123A90-FDL-1724002197-EL-DG-00031
REV.: 2_A | DATE: 18/03/25 | SIGNATURE: G.Randi
ROSETTI MARINO SpA

CROSSWIND

IMESA ELECTRICAL ENGINEERING

ROSETTI MARINO

= TYPICAL
+ LK-x
DWG n° : 231298/SD/31
Item n° : PF1002983/26

REV.	DATE	DRN	CHKD	APPD	DESCRIPTION
2	18/09/2024	Santinelli	Flamminio	Sigismondi	As Built (ASB)
1	10/07/2024	Santinelli	Flamminio	Sigismondi	Accepted for Construction (AFC)
0	09/05/2024	Santinelli	Flamminio	Sigismondi	Issued for review (IFR)

TITLE : "SG-200N1"
LV SWG FUNCTIONAL DIAGRAMS - TYPICAL FEEDERS
Functional Drawing - Typical "LK1-n" & "LK2-n"

CONTRACT NO./TITLE CW-I-WP4-2023-05/HOLLANDSE KUST NOORD WIND PARK | SCALE : NTS

A3 | DRAWING NO. 1723002197-EL-DG-00031 | SHEET 045 | REV. 02

F.to UNI A3: 420mmx297mm

File Name : 1723002197-EL-DG-00031 Rev. 02

Nome/Item	Fg/Sh	Tipo/Type	Q.ta/Q.ty	Descrizione/Description	Costruttore/Manufacturer	Quadro (descrizione)
HL1	040	ML22/484L230STLTTR	1	MULTILED 48x48 - 4 LED - Vaux=230Vac/dc + LAMP TEST + TROP	DOMO	TYPICAL LK-x
KA1	039	ER 592 6	1	CR-M230AC4L SUPPLY 230VAC 4C/O 250V/6A LED	ABB	TYPICAL LK-x
		ER 609 8	1	CR-MH HOLDER FOR CR-M RELAY	ABB	TYPICAL LK-x
		ER 686 6	1	CR-M4SS SOCKET STANDARD X 2/4 C/O(CR-M)	ABB	TYPICAL LK-x
KA2	039	ER 592 6	1	CR-M230AC4L SUPPLY 230VAC 4C/O 250V/6A LED	ABB	TYPICAL LK-x
		ER 609 8	1	CR-MH HOLDER FOR CR-M RELAY	ABB	TYPICAL LK-x
		ER 686 6	1	CR-M4SS SOCKET STANDARD X 2/4 C/O(CR-M)	ABB	TYPICAL LK-x
KA3	039	ER 592 6	1	CR-M230AC4L SUPPLY 230VAC 4C/O 250V/6A LED	ABB	TYPICAL LK-x
		ER 609 8	1	CR-MH HOLDER FOR CR-M RELAY	ABB	TYPICAL LK-x
		ER 686 6	1	CR-M4SS SOCKET STANDARD X 2/4 C/O(CR-M)	ABB	TYPICAL LK-x
KA4	039	ER 592 6	1	CR-M230AC4L SUPPLY 230VAC 4C/O 250V/6A LED	ABB	TYPICAL LK-x
		ER 609 8	1	CR-MH HOLDER FOR CR-M RELAY	ABB	TYPICAL LK-x
		ER 686 6	1	CR-M4SS SOCKET STANDARD X 2/4 C/O(CR-M)	ABB	TYPICAL LK-x
KA5	039	ER 592 6	1	CR-M230AC4L SUPPLY 230VAC 4C/O 250V/6A LED	ABB	TYPICAL LK-x
		ER 609 8	1	CR-MH HOLDER FOR CR-M RELAY	ABB	TYPICAL LK-x
		ER 686 6	1	CR-M4SS SOCKET STANDARD X 2/4 C/O(CR-M)	ABB	TYPICAL LK-x
KA6	042	ER 592 6	1	CR-M230AC4L SUPPLY 230VAC 4C/O 250V/6A LED	ABB	TYPICAL LK-x
		ER 609 8	1	CR-MH HOLDER FOR CR-M RELAY	ABB	TYPICAL LK-x
		ER 686 6	1	CR-M4SS SOCKET STANDARD X 2/4 C/O(CR-M)	ABB	TYPICAL LK-x
KA7	042	ER 592 6	1	CR-M230AC4L SUPPLY 230VAC 4C/O 250V/6A LED	ABB	TYPICAL LK-x
		ER 609 8	1	CR-MH HOLDER FOR CR-M RELAY	ABB	TYPICAL LK-x
		ER 686 6	1	CR-M4SS SOCKET STANDARD X 2/4 C/O(CR-M)	ABB	TYPICAL LK-x
PA1	039	KW 075 2	1	MP1-10R PUSH BUTTON RED WITH BLACK RING	ABB	TYPICAL LK-x
		EO 569 7	1	MCBH-00 FIXING SUPPORT 3 CONTACTS	ABB	TYPICAL LK-x
		EO 571 3	2	MCB-01 CONTACT NC FOR PUSHBUTTOM	ABB	TYPICAL LK-x
PM1	039	KW 076 0	1	MP1-10G PUSH BUTTON GREEN WITH BLACK RING	ABB	TYPICAL LK-x
		EO 569 7	1	MCBH-00 FIXING SUPPORT 3 CONTACTS	ABB	TYPICAL LK-x
		EO 570 5	2	MCB-10 CONTACT NO FOR PUSHBUTTONS	ABB	TYPICAL LK-x
QA1	038	S550239	1	S202M C 2 AUTOMATIC CIRCUIT BREAKER 10KA 2P	ABB	TYPICAL LK-x
		A563819	1	S2-CS/H6R AUXILIARY STATE CONTACT 1CO	ABB	TYPICAL LK-x
SA1	039	KW 329 3	1	M2SS2-10B HANDLE SELECTOR 2P 90° BLACK RING BLACK	ABB	TYPICAL LK-x
		EO 569 7	1	MCBH-00 FIXING SUPPORT 3 CONTACTS	ABB	TYPICAL LK-x
		EO 570 5	2	MCB-10 CONTACT NO FOR PUSHBUTTONS	ABB	TYPICAL LK-x
		EO 571 3	2	MCB-01 CONTACT NC FOR PUSHBUTTOM	ABB	TYPICAL LK-x
U1.2	041	1SDA074173R1	1	MODUL EKIP SUPPLY 24÷48VDC	ABB	TYPICAL LK-x
U1.3	041	1SDA105166R1	1	Module Ekip Com Modbus RS485 Tmax XT	ABB	TYPICAL LK-x
U1.A	041	1SDA105203R1	1	EKIP CARTRIDGE 2SLOT FOR XT2-XT4-XT5	ABB	TYPICAL LK-x
U2.A	042	Z-PC-DINAL2-17.5	1	DIN RAIL 2SLOT WITH HEAD FOR "Z-5DI-2DO"	SENECA	TYPICAL LK-x
U2.B	042	Z-5DI-2DO	1	I/O MODUL 5DI+2DO modbus RS485 Vaux=10÷40Vdc 19÷28Vac	SENECA	TYPICAL LK-x
U2.C	042	Z-5DI-2DO	1	I/O MODUL 5DI+2DO modbus RS485 Vaux=10÷40Vdc 19÷28Vac	SENECA	TYPICAL LK-x
X1		HD100GR_	8	HMD.2/GR Two-level feed-through Terminal Block - Grey (2.5 mmq) - Spring type	Cabur	TYPICAL LK-x
		HD400GR_	17	HMD.2N/GR Two-level feed-through Terminal Block - Grey (2.5 mmq) - Spring type	Cabur	TYPICAL LK-x
		BT003	2	BT/3 End bracket	Cabur	TYPICAL LK-x
		HD101GR	1	HMD/PT/GR End section - Grey	Cabur	TYPICAL LK-x

VALID FOR CONSTRUCTION
VENDOR DOCUMENT - FDL DWG:
123A90-FDL-1724002197-EL-DG-00031
REV.: 2_A | DATE: 18/03/25 | SIGNATURE: G.Randi
ROSETTI MARINO SpA

CROSSWIND

IMESA ELECTRICAL ENGINEERING

ROSETTI MARINO

= TYPICAL
+ LK-x
DWG n° : 231298/SD/31
Item n° : PF1002983/26

REV.	DATE	DRN	CHKD	APPD	DESCRIPTION
2	18/09/2024	Santinelli	Flamminio	Sigismondi	As Built (ASB)
1	10/07/2024	Santinelli	Flamminio	Sigismondi	Accepted for Construction (AFC)
0	09/05/2024	Santinelli	Flamminio	Sigismondi	Issued for review (IFR)

TITLE : "SG-200N1"
LV SWG FUNCTIONAL DIAGRAMS - TYPICAL FEEDERS
Functional Drawing - Typical "LK1-n" & "LK2-n"

CONTRACT NO./TITLE CW-I-WP4-2023-05/HOLLANDSE KUST NOORD WIND PARK | SCALE : NTS

A3 | DRAWING NO. 1723002197-EL-DG-00031 | SHEET 046 | REV. 02

File Name : 1723002197-EL-DG-00031 Rev. 02

AS-COMMISSIONED DAVIDE ZUCCONELLI NO MARK UP 21/03/2025

Fito UNI A3: 420mmx297mm

Nome/Item	Fg/Sh	Tipo/Type	Q.ta/Q.ty	Descrizione/Description	Costruttore/Manufacturer	Quadro (descrizione)
X1		HD201GR	1	HMD.1/PT/GR End section - Grey	Cabur	TYPICAL LK-x

AS-COMMISSIONED
DAVIDE ZUCCOMELLI

NO MARK UP
21/03/2025

Nome/Item	Fg/Sh	Tipo/Type	Q.ta/Q.ty	Descrizione/Description	Costruttore/Manufacturer	Quadro (descrizione)
KM1	043	AF40400013	1	AF40-40-00-13 CONTACTOR 4P 40A 100-250VAC/DC	ABB	TYPICAL LK1-40
		CA440E	1	CA4-40E AUXILIARY FRONT CONTACT 4NO	ABB	TYPICAL LK1-40
QF1	043	1SDA068169R1	1	XT2S 160 BREAKING PART 4p F F	ABB	TYPICAL LK1-40
		1SDA100162R1	1	ELECTRONIC TRIP RELEASE Ekip Hi-Touch LSIG In=40A XT2 4p	ABB	TYPICAL LK1-40
		1SDA066431R1	1	AUX-C 1Q+1SY 250Vac/dc XT1..XT5 F/P	ABB	TYPICAL LK1-40

Nome/Item	Fg/Sh	Tipo/Type	Q.ta/Q.ty	Descrizione/Description	Costruttore/Manufacturer	Quadro (descrizione)
KM1	043	AF52400013	1	AF52-30-00-13 CONTACTOR 4P 53A(AC3) 100-250VAC/DC	ABB	TYPICAL LK1-63
		CA440E	1	CA4-40E AUXILIARY FRONT CONTACT 4NO	ABB	TYPICAL LK1-63
QF1	043	1SDA068169R1	1	XT2S 160 BREAKING PART 4p F F	ABB	TYPICAL LK1-63
		1SDA100163R1	1	ELECTRONIC TRIP RELEASE Ekip Hi-Touch LSIG In=63A XT2 4p	ABB	TYPICAL LK1-63
		1SDA066431R1	1	AUX-C 1Q+1SY 250Vac/dc XT1..XT5 F/P	ABB	TYPICAL LK1-63

Nome/Item	Fg/Sh	Tipo/Type	Q.ta/Q.ty	Descrizione/Description	Costruttore/Manufacturer	Quadro (descrizione)
KM1	043	AF80400013	1	AF80-30-00-13 CONTACTOR 4P 80A(AC3) 100-250VAC/DC	ABB	TYPICAL LK1-100
		CA440E	1	CA4-40E AUXILIARY FRONT CONTACT 4NO	ABB	TYPICAL LK1-100
QF1	043	1SDA068169R1	1	XT2S 160 BREAKING PART 4p F F	ABB	TYPICAL LK1-100
		1SDA100164R1	1	ELECTRONIC TRIP RELEASE Ekip Hi-Touch LSIG In=100A XT2 4p	ABB	TYPICAL LK1-100
		1SDA066431R1	1	AUX-C 1Q+1SY 250Vac/dc XT1..XT5 F/P	ABB	TYPICAL LK1-100

Nome/Item	Fg/Sh	Tipo/Type	Q.ta/Q.ty	Descrizione/Description	Costruttore/Manufacturer	Quadro (descrizione)
KM1	043	AF190401113	1	AF190-40-11-13 CONT 4P 190A AC3 100-250VAC/DC	ABB	TYPICAL LK2-160
		CAL1911	1	CAL19-11 CONTATTO AUSILIARIO 1NA+1NC PER AF116÷AF370	ABB	TYPICAL LK2-160
		CAL1911B	2	CAL19-11B AUXILIARY CONTACT 1NA+1NC PER AF116÷AF370	ABB	TYPICAL LK2-160
QF1	043	1SDA068179R1	1	XT4S 250 BREAKING PART 4p F F	ABB	TYPICAL LK2-160
		1SDA100334R1	1	ELECTRONIC TRIP RELEASE Ekip Hi-Touch LSIG In=160A XT4 4p	ABB	TYPICAL LK2-160
		1SDA066431R1	1	AUX-C 1Q+1SY 250Vac/dc XT1..XT5 F/P	ABB	TYPICAL LK2-160

VALID FOR CONSTRUCTION
VENDOR DOCUMENT - FDL DWG:
123A90-FDL-1724002197-EL-DG-00031

REV.:	DATE:	SIGNATURE:
2_A	18/03/25	G.Randi

ROSETTI MARINO SpA

CROSSWIND

IMESA ELECTRICAL ENGINEERING

ROSETTI MARINO

=	TYPICAL
+	LK-x
DWG n° :	231298/SD/31
Item n° :	PF1002983/26

REV.	DATE	DRN	CHKD	APPD	DESCRIPTION
2	18/09/2024	Santinelli	Flamminio	Sigismondi	As Built (ASB)
1	10/07/2024	Santinelli	Flamminio	Sigismondi	Accepted for Construction (AFC)
0	09/05/2024	Santinelli	Flamminio	Sigismondi	Issued for review (IFR)

TITLE : "SG-200N1"

LV SWG FUNCTIONAL DIAGRAMS - TYPICAL FEEDERS

Functional Drawing - Typical "LK1-n" & "LK2-n"

CONTRACT NO./TITLE CW-I-WP4-2023-05/HOLLANDSE KUST NOORD WIND PARK | SCALE : NTS

A3 | DRAWING NO. 1723002197-EL-DG-00031 | SHEET 047 | REV. 02

F.to UNI A3: 420mmx297mm

File Name : 1723002197-EL-DG-00031 Rev. 02

Section 8 LIST OF MODIFICATIONS

NOT APPLICABLE

Section 8.1 List of changes

NOT APPLICABLE

Section 9 SUPPORTING DOCUMENTS

NOT APPLICABLE